A/P _____

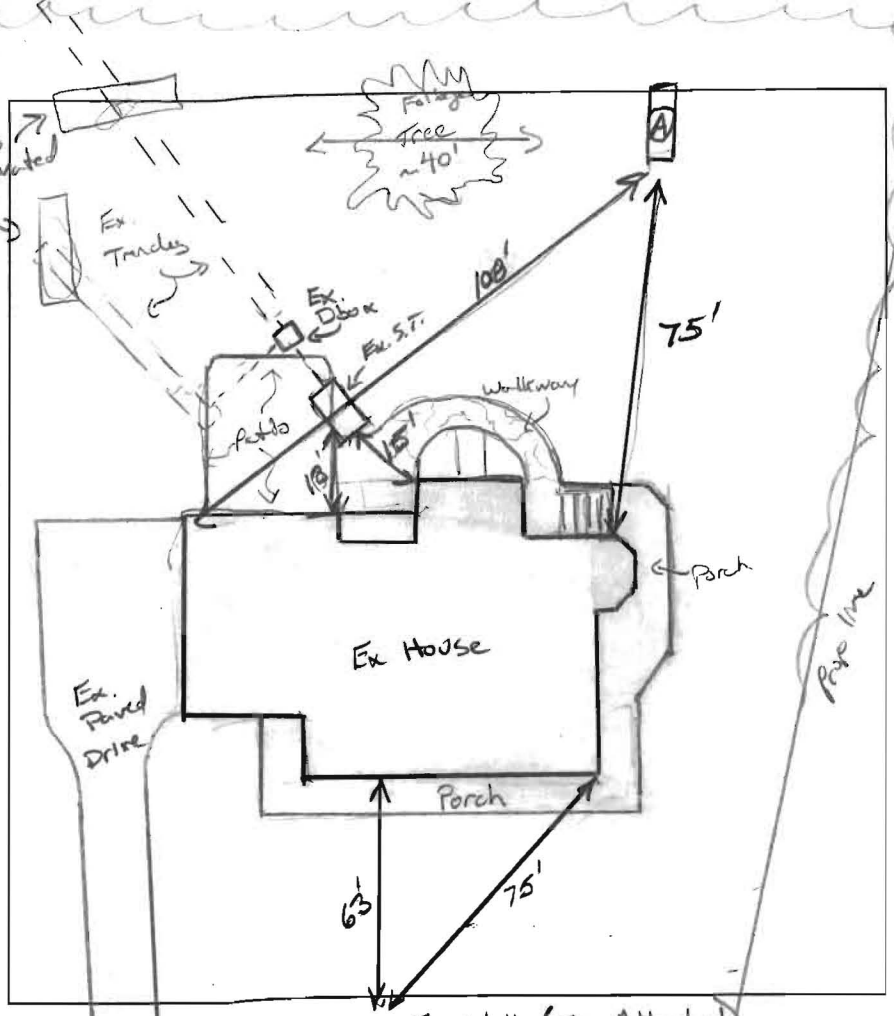

DATE	TEST #	DEPTH	START	BREAK 1" DROP	STOP 2" DROP	TIME OF 2ND INCH	P/F/H
11/15/13	A	5'3"/14'3"	00:00	07:35	16:00	9	P

(A)

10" OM, MSBK, 2K BC, Dry

Br/Y/R L, Friable roots, weak, chunky

5' Dry.

Light Br/Y FSL, Friable, few mica, 10% chunks consistent,

↓ same structure Does not change

14'3"

System dug up. Lower trench failing close to middle, upper trench end dug up. Nothing failed but only ~30' in length.

REMARKS _____

SANITARIAN K. Wolf BACKHOE Ronnie Hogan's OTHERS Helpers

TEST HOLES USED IN SDA 1 AVG. PERC TIME 9 SQ. FT/BR 0.8

TRENCH WIDTH 2 INLET DEPTH 4 MAX. BOT DEPTH 10 EFFECTIVE S/W 6'-10' (4)

$150(4) = \frac{600}{0.8} = 750 \div 2 = 375\ (.36) = 135\ LF$