A/P _____

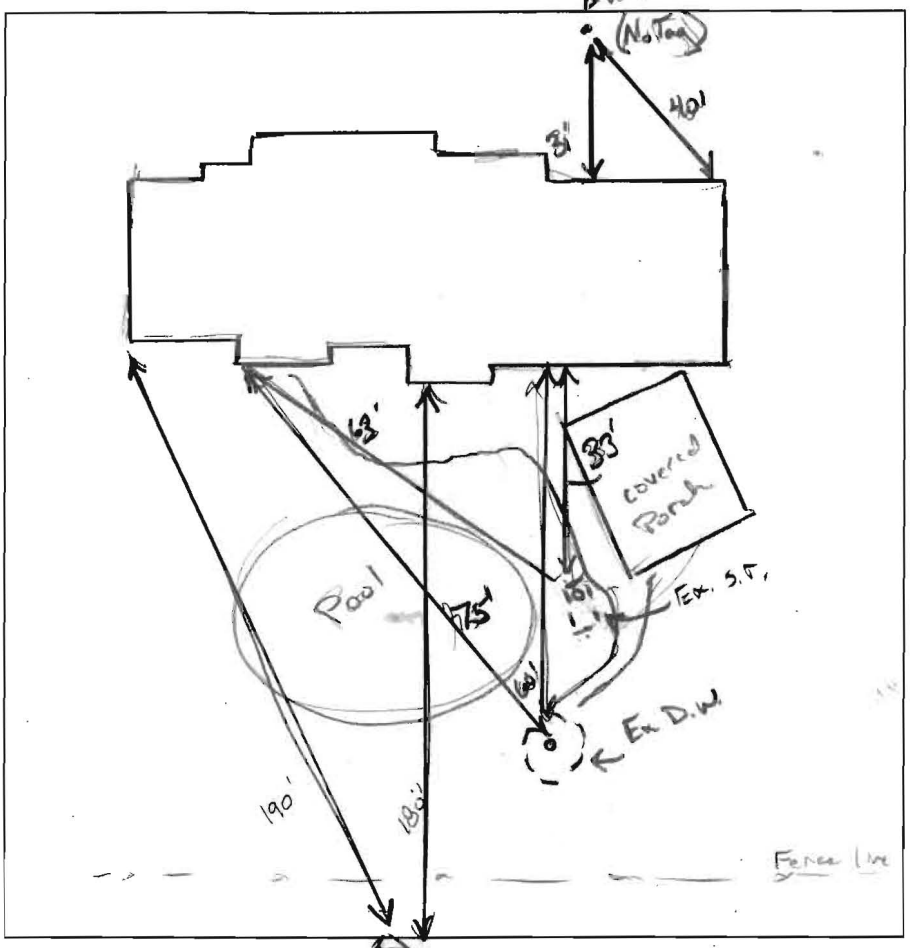

10"
2'
5'
6'
14'

MSBK, CL, Drk Rd/Br. cast, wk Br/Rd. Cl, few mica. Trace rx, saprolite roots, soil moist

Br/Y L, Highly micaceous 10-15% schist saprolite.

Loose Br/R/Y FSL, Highly micaceous

DATE	TEST #	DEPTH	START	BREAK 1" DROP	STOP 2" DROP	TIME OF 2ND INCH	P/F/H
4/18/14	(A)	4'8"/14'w	00:00	3/4" movement in 15 min			OK
		6'6"	00:27	00:30	00:34	4	(P)

→ Bton Stone

REMARKS _____

SANITARIAN K. Wolf BACKHOE Ronnie Hepes OTHERS owner

TEST HOLES USED IN SDA 1 AVG. PERC TIME 4 SQ. FT/BR _____

TRENCH WIDTH 2 INLET DEPTH 8 MAX. BOT DEPTH 8 EFFECTIVE S/W 5.5-8 .5

HBR $\frac{600}{1.2}$ = 500 ÷ 2 = 250 (.50) = 125 LF