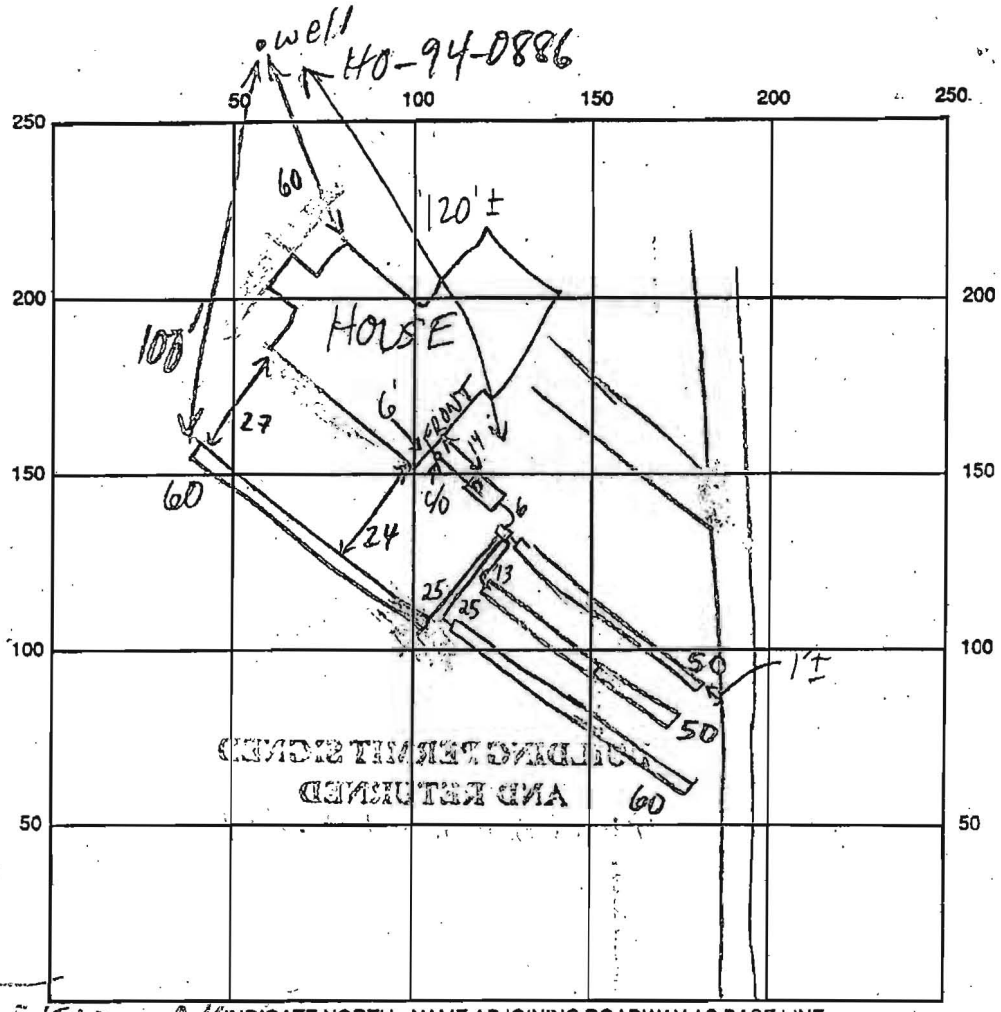

BAKLEY FIELD WAY INDICATE NORTH - NAME ADJOINING ROADWAY AS BASE LINE

SEPTIC TANK LEVEL 1250 GAL - OK CLEANOUTS INLINE & S.T. - 8" OK

DISTRIBUTION BOX LEVEL OK - BAFFLE IN

DRAIN FIELD/TITLE DEPTH 5 FT. TRENCH WIDTH 3 FT. INLET DEPTH 3 FT.

EFFECTIVE GRAVEL DEPTH 2 FT. TOTAL LENGTH 2 @ 60 2 @ 50 FT.

NUMBER OF TRENCHES 4 ~~ONE SIDEWALL~~ BOTTOM AREA 2 @ 180 2 @ 150 SQ. FT.

DRYWALL INSIDE DIAMETER — FT. EFFECTIVE DEPTH BELOW INLET — FT.

ABSORBENT AREA 1660 SQ. FT.

REMARKS: 4/27/98 Preconstruction site insp - Minimum 50' trench length in 1st maybe 2nd trench not possible - install as much as will fit even if <50' in length of 4/28/98 OK TO COVER ALL (MR)
5·26·98 WPI ok to cover, line sleeved P.A. 4.0' below grade, casing 2.0' above grade, has 2 piece cap KM

DATE SYSTEM APPROVED 4/28/98 INSPECTOR M. Ripkin

Feb-17-98 01:44P cfs

Total linear feet of trench required 240 feet

Width of trench(es) 3 feet

Depth of trench(es) 5 feet
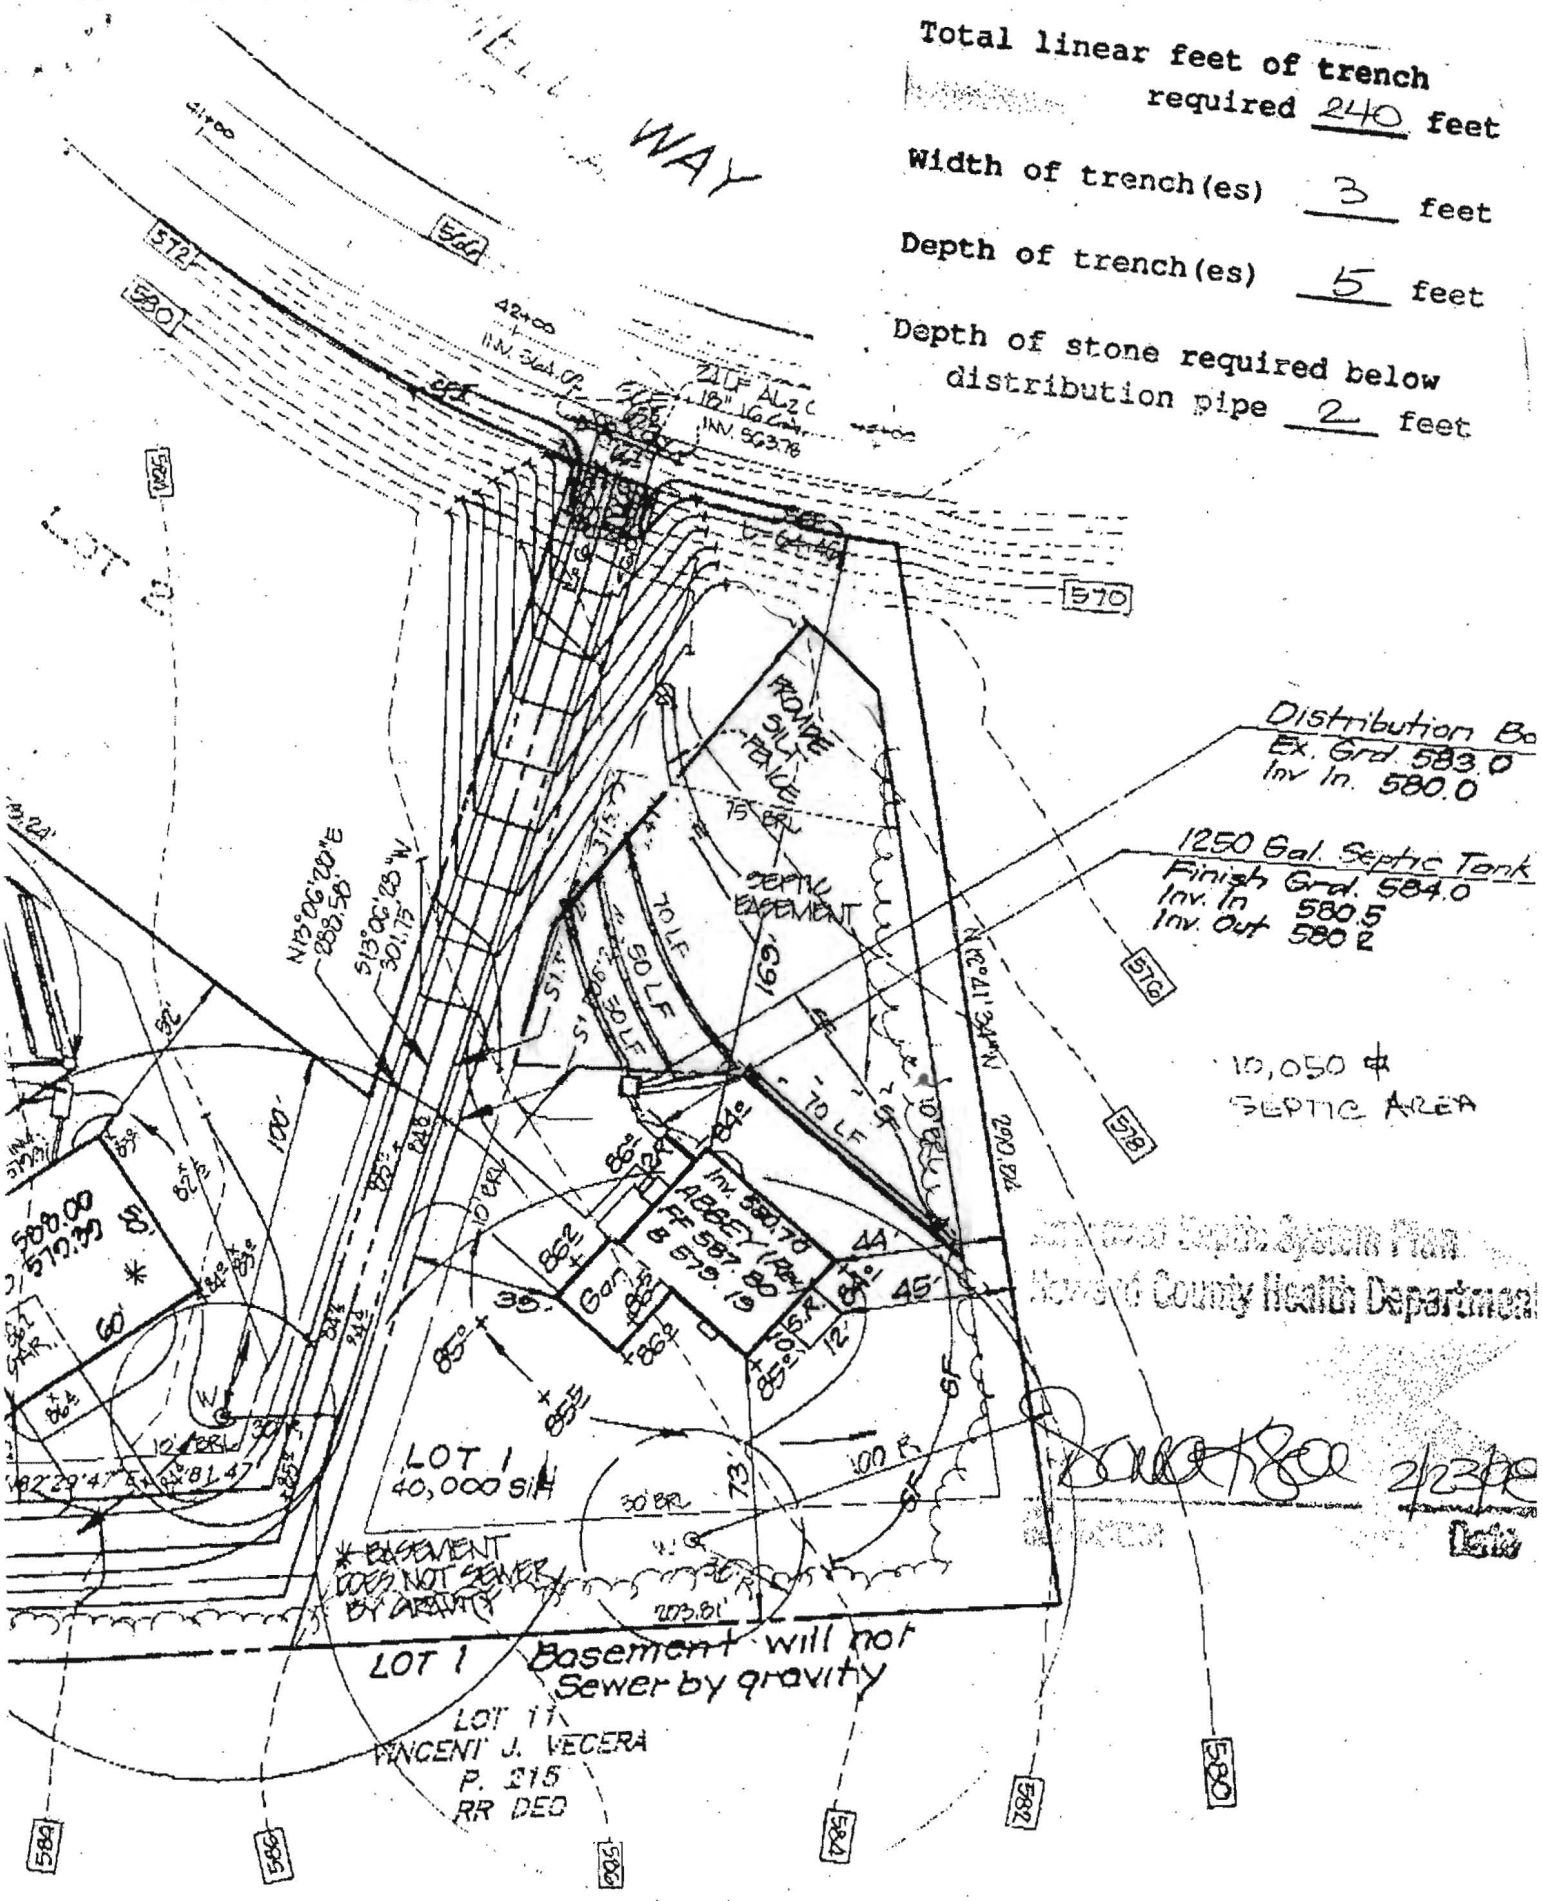
Depth of stone required below distribution pipe 2 feet