MARYLAND DEPARTMENT OF THE ENVIRONMENT, WATER MANAGEMENT ADMINISTRATION
1800 Washington Blvd., Baltimore, Maryland 21230 (410) 537-3784

****

WATER WELL ABANDONMENT-SEALING REPORT FORM

****

SUBMIT COPIES OF COMPLETED FORM TO:

* COUNTY ENVIRONMENT AGENCY (contact MDE, WMA if address needed)
* WELL OWNER
* MDE, WATER MANAGEMENT ADMINISTRATION, WELL PROGRAM

OK 9/14/16 SC

DATE WELL ABANDONED: APRIL 22 2011 (month/day/year)

* PERMIT NUMBER OF ABANDONED WELL (if any) N/A — —

* PERMIT NUMBER OF REPLACEMENT WELL N/A — —

* PERSON ABANDONING WELL: RALPH E MAYNE

WELL DRILLERS LICENSE NUMBER: 117

CIRCLE: MWD/MSD/MGD

* OWNER'S NAME: MARTINEZ CYNTHIA GUTIERREZ

* WELL LOCATION:
COUNTY: HOWARD
NEAREST TOWN: ELLICOTT CITY
TAX MAP 37 BLOCK _____ PARCEL 210
SUBDIVISION: _____
SECTION: _____ LOT: _____
NEAREST ROAD: 6166 MONTGOMERY RD

SITE LOCATION MAP

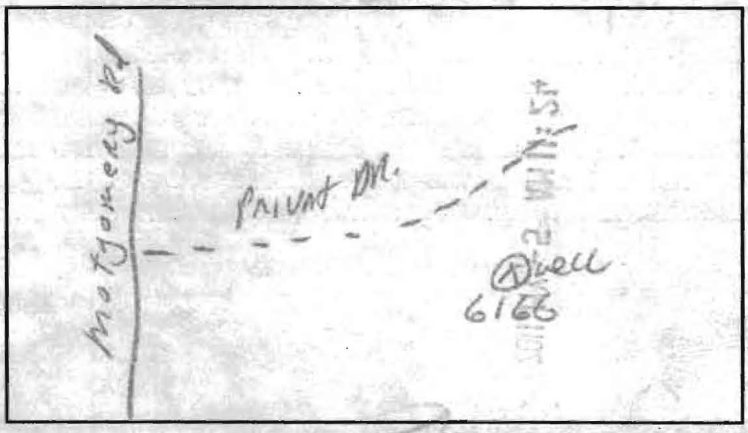

* TYPE OF WELL BEING ABANDONED:

✓ DRILLED _____ JETTED
_____ BORED/AUGERED _____ HAND DUG
_____ OTHER (specify) _____

* USE CODE:

✓ DOMESTIC _____ MUNICIPAL/PUBLIC
_____ IRRIGATION _____ INDUSTRIAL
_____ TEST/OBSERVATION _____ GEOTHERMAL

* TYPE OF CASING:

✓ STEEL _____ PLASTIC
_____ CONCRETE _____ OTHER (specify)
_____

* SIZE OF CASING: 6" INCHES IN DIAMETER

* DEPTH OF WELL: 104 FEET DEEP

* WAS ANY CASING REMOVED? ___ YES ✓ NO
if yes, length removed, in feet: _____

* WAS CASING RIPPED OR PERFORATED? ___ YES ✓ NO

LOG OF SEALING MATERIAL

MATERIAL	FEET	
	FROM	TO
STONE	104	25
Cement	25	5
Top Soil	5	0

VOLUME OF MATERIAL USED

ONE TON STONE
10 BAGS CEMENT

Ralph E Mayne 117 MWD/MSD/MGD 4/22/11

SIGNATURE-MASTER WELL DRILLER OR SUPERVISING SANITARIAN LICENSE # CIRCLE ONE DATE

DENV 828 JULY 1997 2) COUNTY ENVIRONMENTAL AGENCY