4BR proposed

More than 5BR Possible 6

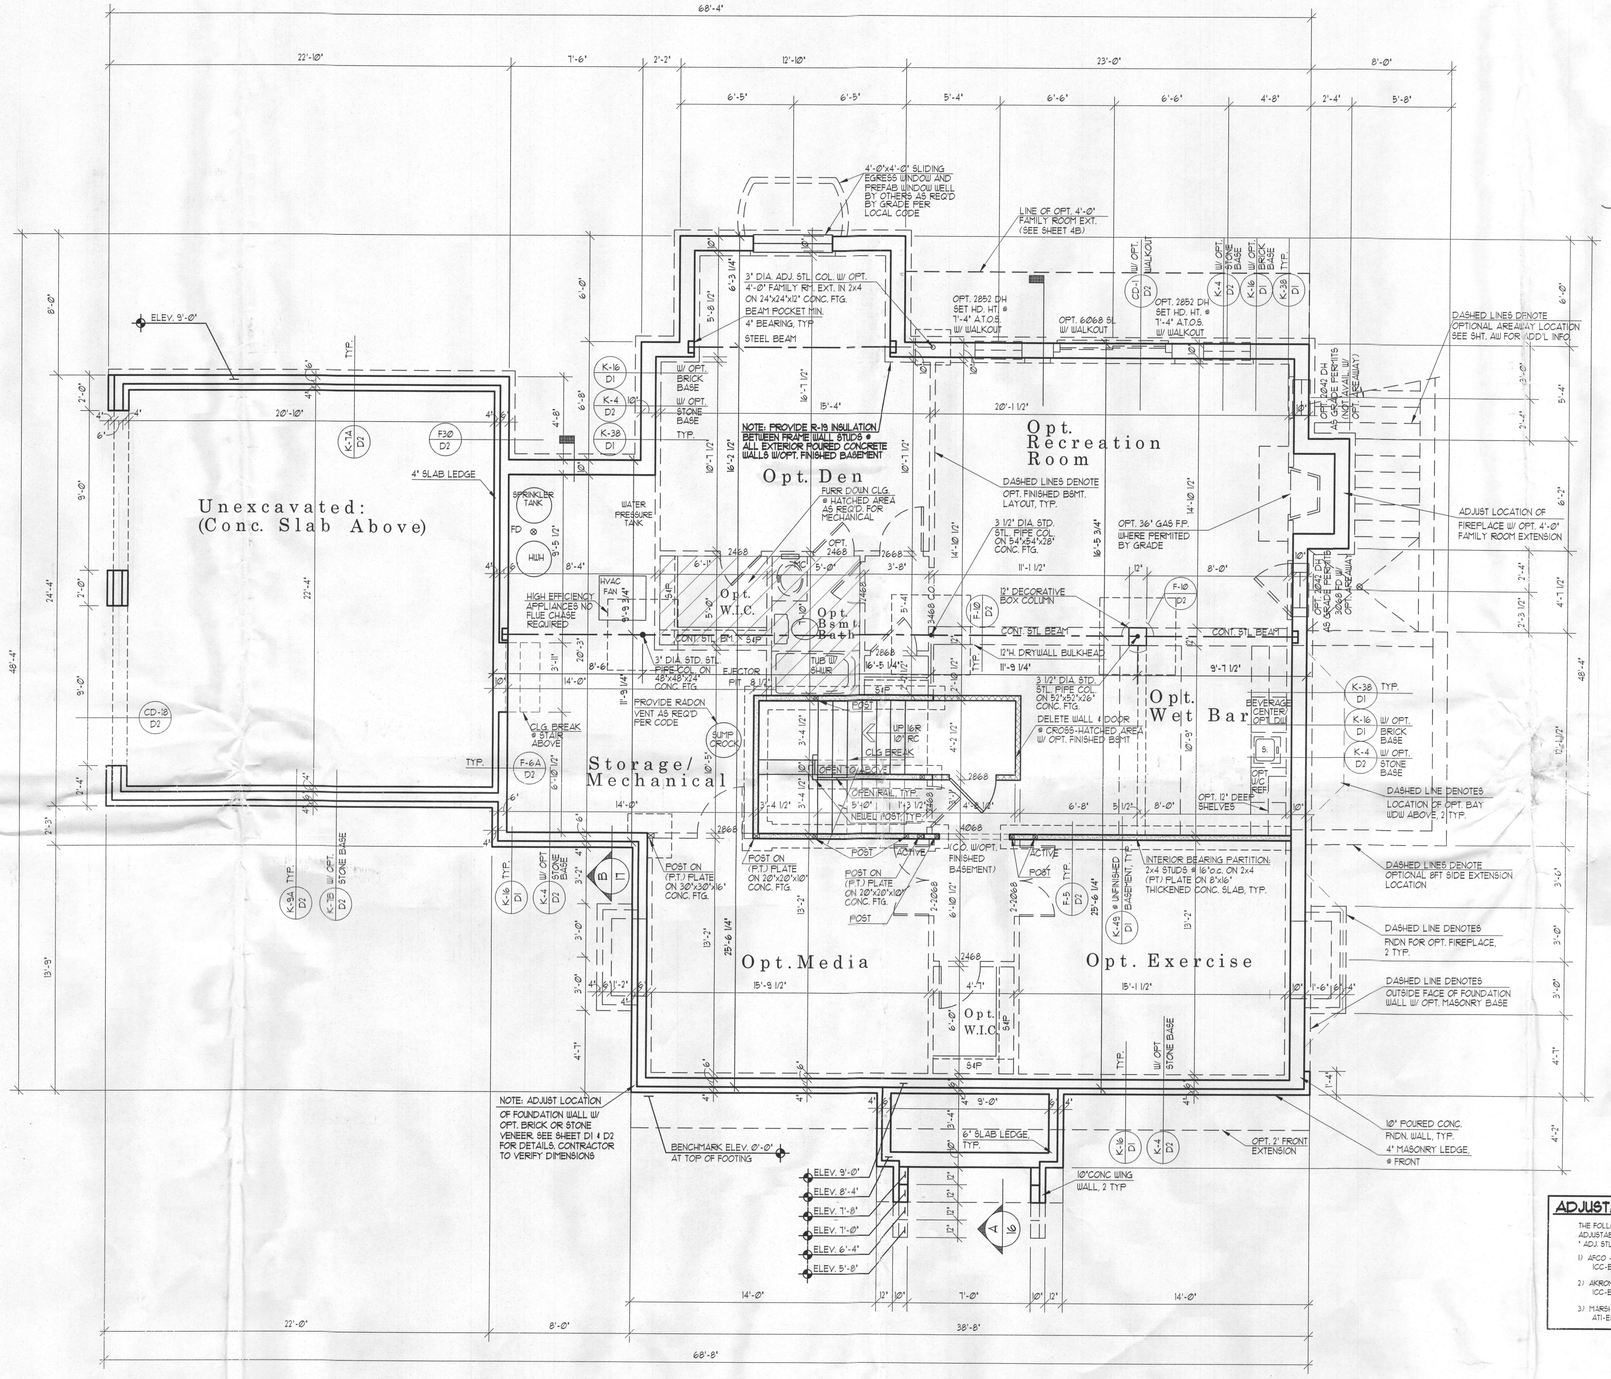

ADJUSTABLE STEEL COLUMNS

THE FOLLOWING ARE APPROVED 11 GAUGE (.120 in.) ADJUSTABLE STEEL COLUMNS FOR USE AS SPECIFIED AS "ADJ. STL. COL." IN THESE CONSTRUCTION DRAWINGS:

1) APCO - "ZIP" ADJUSTABLE COLUMN
ICC-ES REPORT: ESR-2452

2) AKRON - FIXED & ADJUSTABLE COLUMNS
ICC-ES REPORT: ESR-1767

3) MARSHALL - EXTEND-O-COLUMN
ATI-ES CODE COMPLIANCE REPORT: CCRR-0145

FOUNDATION/BASEMENT PLAN

W/ELEVATION "A"

1/4" = 1'-0"

UNLESS OTHERWISE NOTED ALL INTERIOR PARTITIONS TO BE 3 1/2"
UNLESS OTHERWISE NOTED WINDOW HEAD HEIGHT TO BE 8'-8" A.T.O.S.

Date	
A.C. 10/15/07 DGB	REV. 01/20/12 JG — REV. 03/13/15 JR
A.C. 11/10/10 JH	REV. 01/20/12 JG — REV. 01/15/16 JH
A.C. 12/01/10 JH	REV. 01/17/12 JG
P.S. 12/3/10 JH	REV. 04/3/12 JG
C.S. 01/13/11 JH/JCS	P.S. 05/29/13 JG
REV. 01/29/11 JH/JCS	P.S. 06/13/13 JG
REV. 03/18/11 DG	REV. 1/26/13 JB
	REV. 10/29/14 JR

Project Number: 0102

HAWTHORNE
MITCHELL BEST HOMES

Architect

SUTTON YANTIS ASSOCIATES ARCHITECTS
8300 Boone Blvd. Tel. 703.734.0723
Vienna, VA 22182 Fax 703.847.9171
www.syaa.com

Sheet Number 2