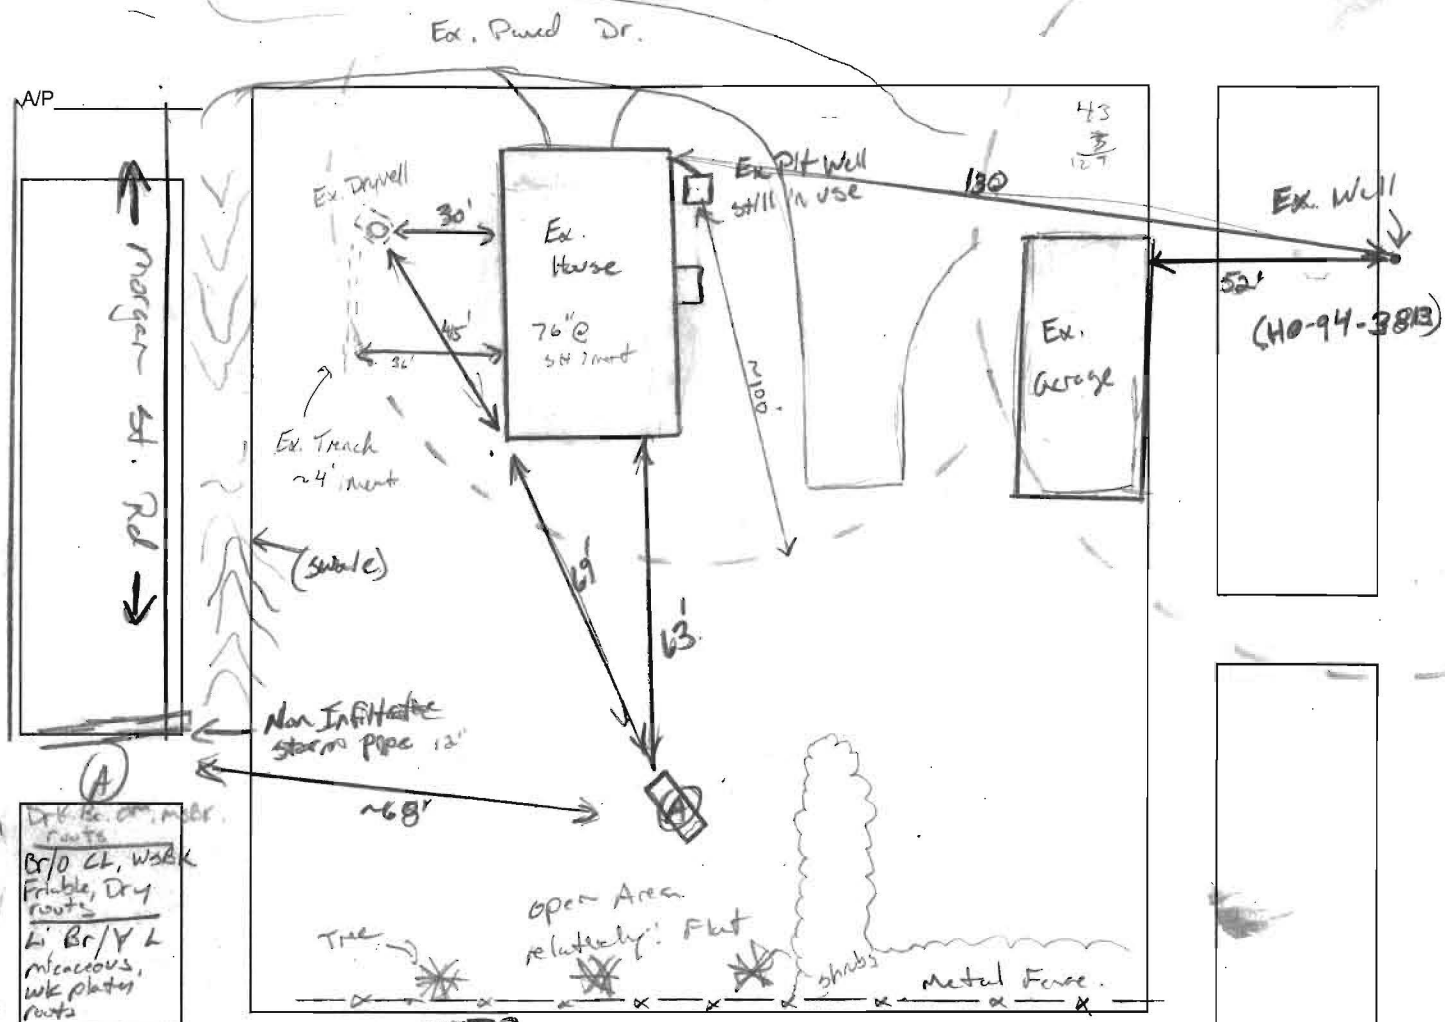

10"	Dk. Br. OR, mbr. roots
2'-3'	Br/O CL, WSBK Friable, Dry roots
4'	Li Br/Y L micaceous, wk platy roots
9'	Li Br/Y/R, FSL Highly micaceous somewhat platy w/ Friable, wsbk
14'	Br/Y/R, VFSL wk sproltle shale encountered ~20% Friable. Highly micaceous platy.

← F70 →

DATE	TEST #	DEPTH	START	BREAK 1" DROP	STOP 2" DROP	TIME OF 2ND INCH	P/F/H
6/24/14	A	5'/14"	11:50	11:52	11:57	5	P

House under rehab. Met w/ current owner/builder. New con well HO-94-3813

REMARKS in use. Old pit well @ house in use. A/B switch for wells.

SANITARIAN K. Wolf BACKHOE Jake: Fagles OTHERS Builder/owner

TEST HOLES USED IN SDA 1 AVG. PERC TIME 5 SQ. FT/BR

TRENCH WIDTH 3' INLET DEPTH 3' MAX. BOT DEPTH 5' EFFECTIVE S/W 4

3BR: 450gpd. ÷ 1.2 = 375 ÷ 125 (.80) = 100 LF