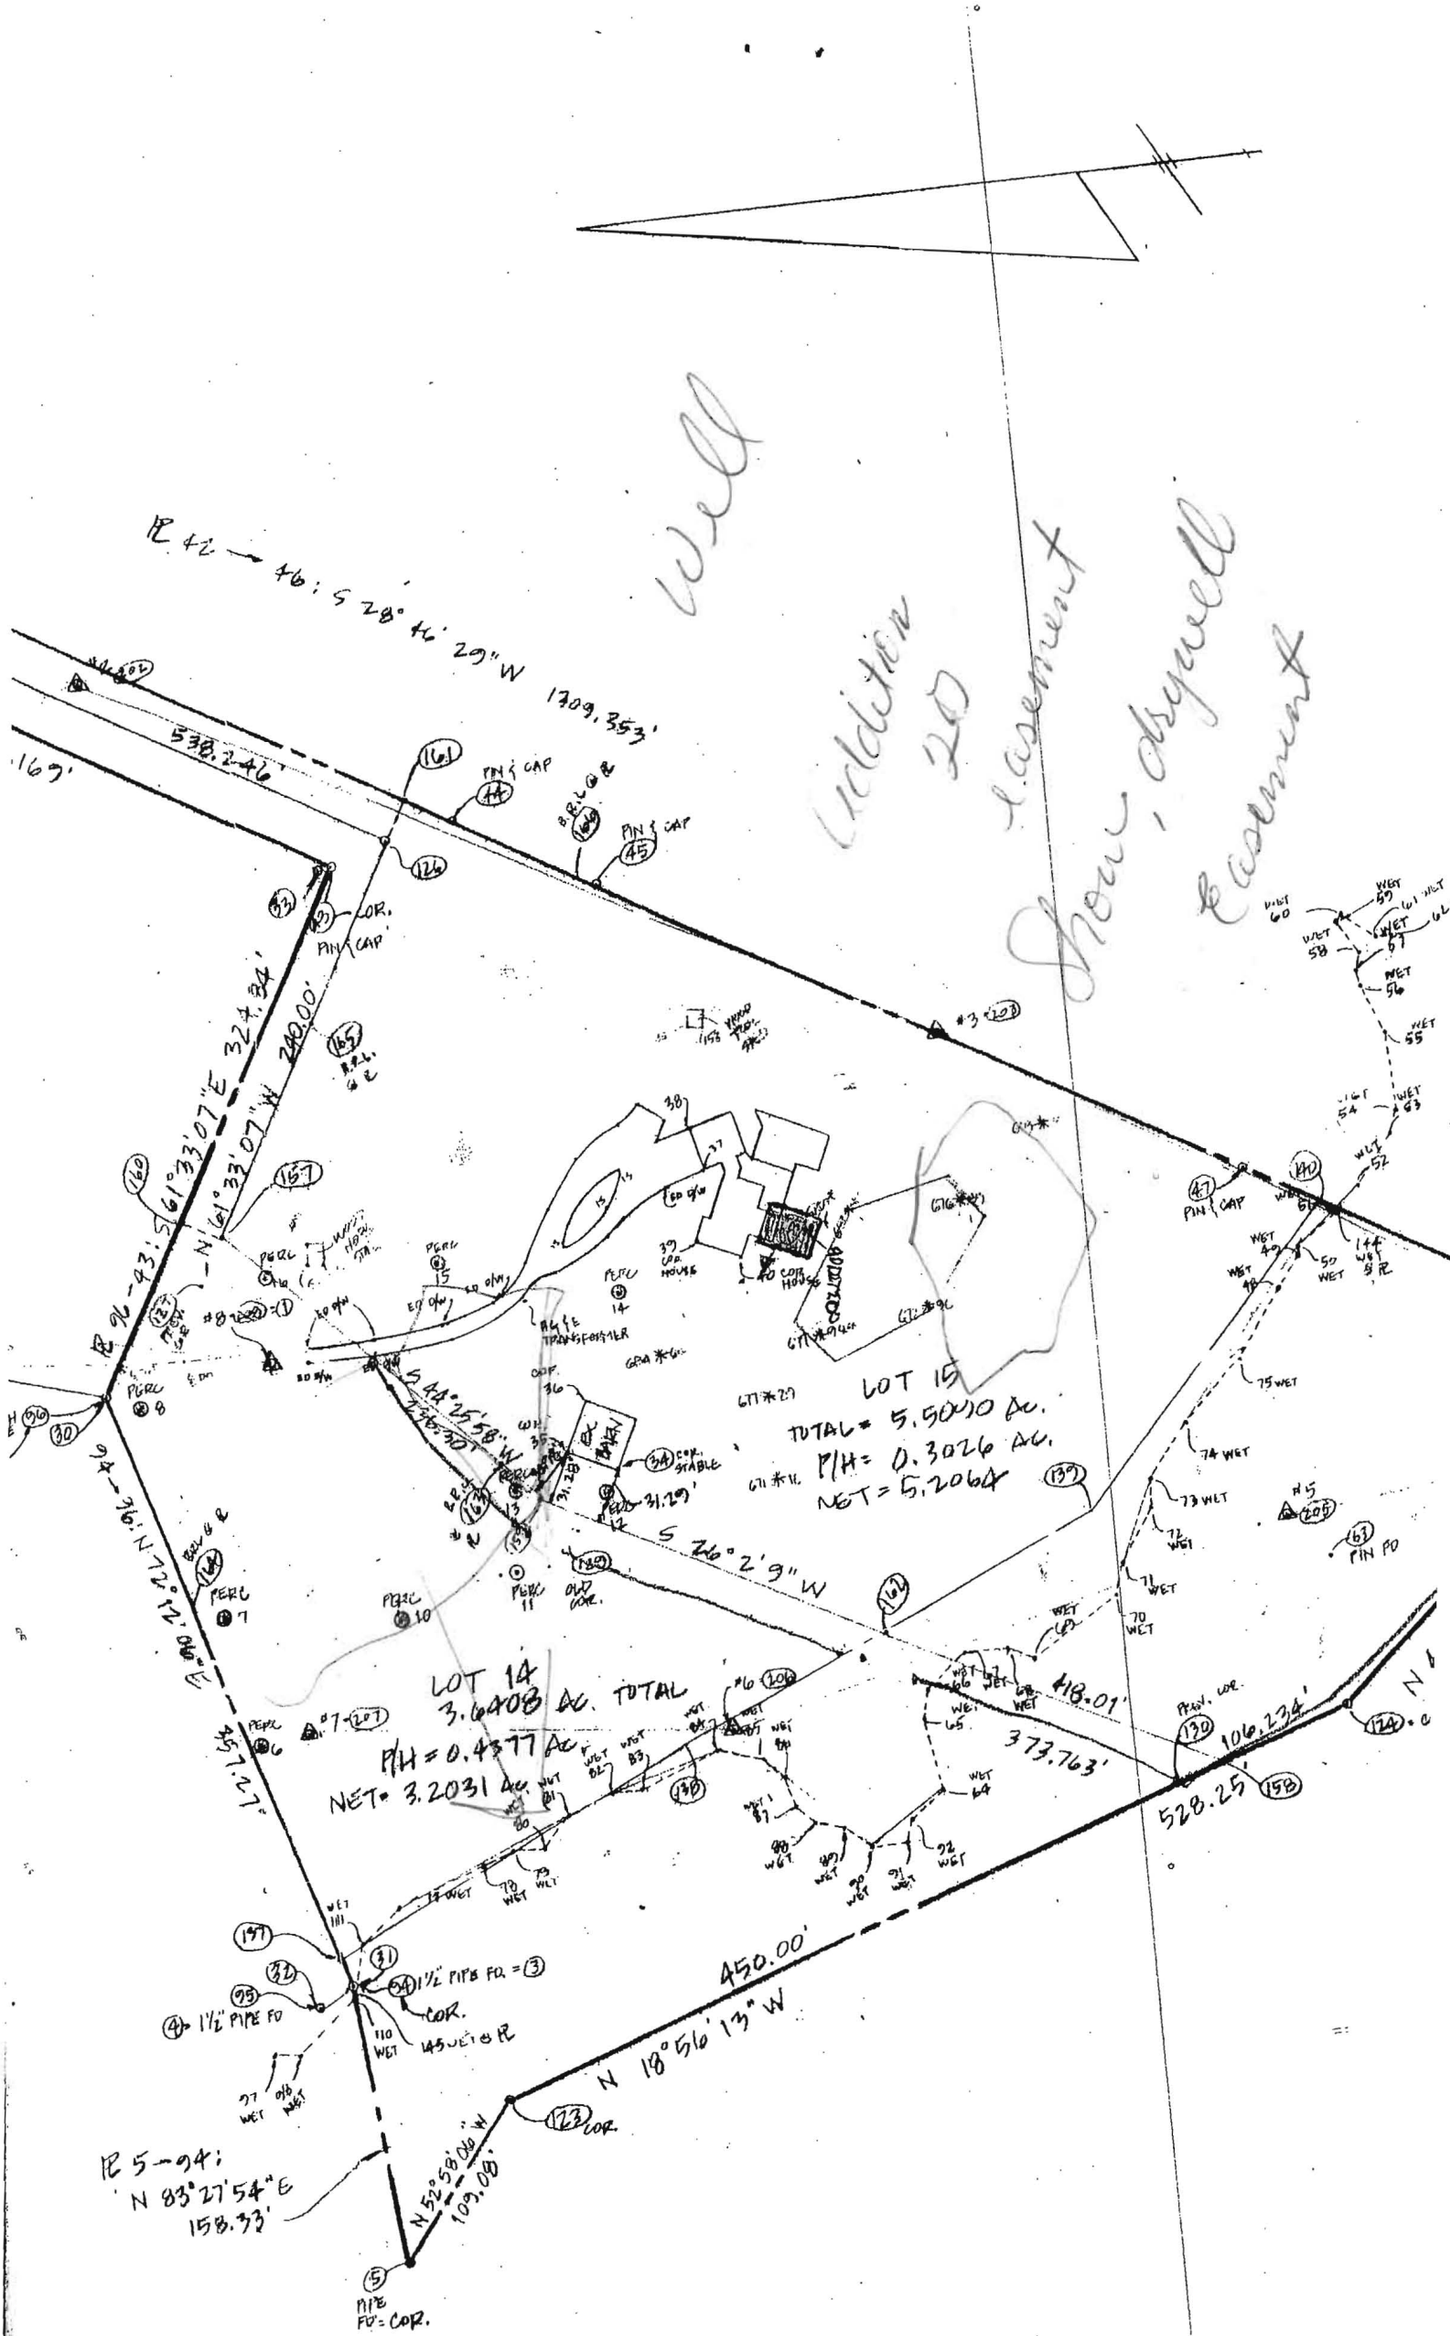
Well
addition
20
easement
Show, drywell
easement
R 42 → 46: S 28° 46' 29" W 1709.353'
538.246'
169'
PIN & CAP
BRL & R
COR.
PIN & CAP
R 96-93: S 61°33'07" E 327.34'
N 61°33'07" W 240.00'
R 96-36: N 72°12'06" E
457.27'
S 44°25'58" W
LOT 15
TOTAL = 5.5010 AC.
P/H = 0.3026 AC.
NET = 5.2064
S 26° 2' 9" W
LOT 14
3.6408 AC. TOTAL
P/H = 0.4377 AC
NET = 3.2031 AC.
418.01'
373.763'
106.234'
528.25'
450.00'
N 18°56' 13" W
1½ PIPE FD. = (3)
COR.
1½ PIPE FD
R 5-94:
N 83°27'54" E
158.33'
N 52°58'06" W
109.08'
PIPE FD = COR.
PIN FD
PROV. COR.
OLD COR.
COR. HOUSE
COR. STABLE
TRANSFORMER
PERC
WET