

REENE PROPERTY
LOT 1
PLAT 5208
ZONED RR-DEO

N87°31'23"E

100 Year Floodplain,
Drainage & Utility Easement
Plot #12949

Forest Conservation
Area - 0.3 Ac
Plot #12949

LOT 4
5.67 Ac.

N02°10'39"W

ZONED RR-DEO



894.93'

N02°10'39"W

S02°11'07"E

VANT HOFF PROF
LOT 2
PLAT 12949
ZONED RR-DI

36

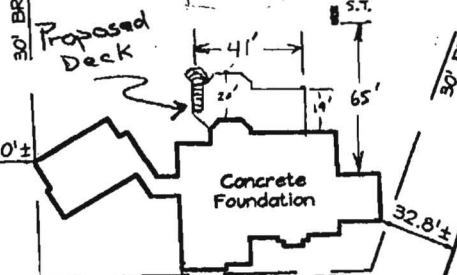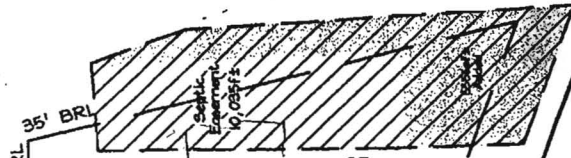

Well #HO-94-3893

M127°26'41"W

9/7/05
well check ok
APPROVED
WALK-THRU BUILDING PERMIT
BP# 807001455 A# DATE: 9/25/07
APP. SAN [Signature] EXCEL Deck
DESC. OF WORK: CONSTRUCT 800 FT - total
AS SHOWN - APPROX.

PLAN VIEW

SCALE: 1"=60'