C1 5963 — SEQUENCE NO. (OEP USE ONLY)
(THIS NUMBER IS TO BE PUNCHED IN COLS. 1-6 ON ALL CARDS)

STATE OF MARYLAND
WELL COMPLETION REPORT
FILL IN THIS FORM COMPLETELY
PLEASE PRINT OR TYPE

THIS REPORT MUST BE SUBMITTED WITHIN 45 DAYS AFTER WELL IS COMPLETED.

COUNTY NUMBER A 36320

DATE Received: 8 – 13

DATE WELL COMPLETED: 07 06 89 (15–20)

Depth of Well: 265 (22–26) (TO NEAREST FOOT)

PERMIT NO. FROM "PERMIT TO DRILL WELL": H0-81-2161 (28–37)

OWNER: GRESWELL (last name) BRUCE (first name)

STREET OR RFD: RR 216 TOWN: SCAGGSVILLE

SUBDIVISION: GRESWELL ESTATES SECTION: LOT: OLD 16 (HOUSE)

WELL LOG
Not required for driven wells

STATE THE KIND OF FORMATIONS PENETRATED, THEIR COLOR, DEPTH, THICKNESS AND IF WATER BEARING

DESCRIPTION (Use additional sheets if needed)	FEET FROM	FEET TO	Check if water bearing
SAND	0	47	
GRAY MICA Rock	47	265	✓

Dry well 400' Filled in with cement + Drilling Materials

GROUTING RECORD
WELL HAS BEEN GROUTED (Circle Appropriate Box) yes Y (44) no N (44)

TYPE OF GROUTING MATERIAL

CEMENT CM (45–46) BENTONITE CLAY BC (45–46)

NO. OF BAGS 11 NO. OF POUNDS 1034

GALLONS OF WATER 66

DEPTH OF GROUT SEAL (to nearest foot)

from 6 (48) ft. TOP (52) to 45 (54) ft. BOTTOM (58)

(enter 0 if from surface)

CASING RECORD
casing types insert appropriate code below

ST STEEL, CO CONCRETE, PL PLASTIC, OT OTHER

MAIN CASING TYPE	Nominal diameter top (main) casing (nearest inch)	Total depth of main casing (nearest foot)
ST (60–61)	6 (63–64)	55 (66–70)

OTHER CASING (if used)

EACH CASING	diameter inch	depth (feet) from	to

SCREEN RECORD
screen type or open hole — insert appropriate code below

ST STEEL, BR BRASS BRONZE, HO OPEN HOLE, PL PLASTIC, OT OTHER

C2

EACH SCREEN		DEPTH (nearest ft.)	
1	HO (8–9)	59 (11–15)	265 (17–21)
2	(23–24)	(26–30)	(32–36)
3	(38–39)	(41–45)	(47–51)

SLOT SIZE 1 ____ 2 ____ 3 ____

DIAMETER OF SCREEN ____ (56–60) (NEAREST INCH)

GRAVEL PACK from ____ to ____

IF WELL DRILLED WAS FLOWING WELL INSERT F IN BOX 68 (68)

OEP USE ONLY (NOT TO BE FILLED IN BY DRILLER)

T (70) TELESCOPE CASING; (E.R.O.S.) (72) LOG INDICATOR; W Q (74–76) OTHER DATA

C3

PUMPING TEST
HOURS PUMPED (nearest hour) 3 (8–9)

PUMPING RATE (gal. per min. to nearest gal.) 4 (11–15)

METHOD USED TO MEASURE PUMPING RATE Bucket

WATER LEVEL (distance from land surface)

BEFORE PUMPING 40 (17–20)

WHEN PUMPING 111 (22–25)

TYPE OF PUMP USED (for test)

A air (27), P piston (27), T turbine (27), C centrifugal (27), R rotary (27), O other (describe below) (27), J jet (27), S submersible (27)

PUMP INSTALLED
DRILLER WILL INSTALL PUMP (CIRCLE) (YES or NO) YES NO

IF DRILLER INSTALLS PUMP, THIS SECTION MUST BE COMPLETED FOR ALL WELLS EXCEPT HOME USE

TYPE OF PUMP INSTALLED PLACE (A,C,J,P,R,S,T,O) IN BOX - SEE ABOVE: (29)

CAPACITY: GALLONS PER MINUTE (to nearest gallon) (31–35)

PUMP HORSE POWER (37–41)

PUMP COLUMN LENGTH (nearest ft.) (43–47)

CASING HEIGHT (circle appropriate box and enter casing height)

+ above (49) / – below (49) — LAND SURFACE 2 (50–51) (nearest foot)

CIRCLE APPROPRIATE LETTER
A — A WELL WAS ABANDONED AND SEALED WHEN THIS WELL WAS COMPLETED

E — ELECTRIC LOG OBTAINED

P — TEST WELL CONVERTED TO PRODUCTION WELL

I HEREBY CERTIFY THAT THIS WELL HAS BEEN CONSTRUCTED IN ACCORDANCE WITH COMAR 10.17.13 "WELL CONSTRUCTION" AND IN CONFORMANCE WITH ALL CONDITIONS STATED IN THE ABOVE CAPTIONED PERMIT, AND THAT THE INFORMATION PRESENTED HEREIN IS ACCURATE AND COMPLETE TO THE BEST OF MY KNOWLEDGE.

DRILLERS IDENT. NO. 238

DRILLERS SIGNATURE (MUST MATCH SIGNATURE ON APPLICATION): Paul L. Mayne

SITE SUPERVISOR (sign. of driller or journeyman responsible for sitework if different from permittee)

LOCATION OF WELL ON LOT
SHOW PERMANENT STRUCTURE SUCH AS BUILDING, SEPTIC TANKS, AND/OR LANDMARKS AND INDICATE NOT LESS THAN TWO DISTANCES (MEASUREMENTS TO WELL)

N

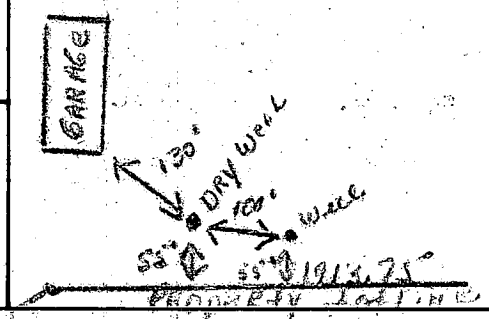

HEALTH