DEPT. OF INSPECTIONS, LICENSES AND PERMITS
3430 COURT HOUSE DRIVE
ELLICOTT CITY, MD 21043
PERMITS (410) 313-2455
INSPECTIONS (410) 313-1810
AUTOMATED INFORMATION (410) 313-3800

HOWARD COUNTY PERMIT APPLICATION

PERMIT NUMBER B1000280 9

Building Address 14101 HOWARD RD.
DAYTON, MD 21036

X Suite/Apt. #: _____ SDP/WP/Petition #: _____

Census Tract _____ Subdivision _____

Section _____ Area _____ Lot _____

Tax Map 27 Parcel 180 Grid _____

Zoning Map Coordinates Lot Size

Existing Use _____
Proposed Use _____
Estimated Construction Cost $ _____
X Description of Work CONSTRUCT OF ATTACHED 16'x24' DECK

Occupant or Tenant MARK K. SMITH
Contact Name _____
Address _____
City _____ State _____ Zip Code _____
Phone _____ Fax _____

Property Owner's Name MARK K. SMITH
Address 14101 HOWARD RD.
City DAYTON State MD Zip Code 21036
Home Phone 410-531-8442 Work Phone 301-210-1811
Applicant's Name & Mailing Address, (if other than stated herein):

Phone _____ Fax _____

Contractor Company _____
Contact Person _____
Address _____
City _____ State _____ Zip Code _____
License No. _____
Phone _____ Fax _____

Engineer or Architect Company _____
Contact Person _____
Address _____
City _____ State _____ Zip Code _____
Phone _____ Fax _____

BUILDING DESCRIPTION – *COMMERCIAL*

Building Characteristics
Height:
No. of stories:
Gross area, sq. ft. per floor:
Use group:
Construction type:
___ Reinforced Concrete
___ Structural Steel
___ Masonry
___ Wood Frame
___ State Certified Modular

Utilities
Water Supply:
___ Public
___ Private
Sewage Disposal:
___ Public
___ Private
Electric Yes ☐ No ☐
Gas Yes ☐ No ☐
Heating System:
Electric ☐ Oil ☐
Natural Gas ☐
Propane Gas ☐
Sprinkler system: N/A ☐
___ Full
___ Partial
___ Other Suppression
___ # of Heads

BUILDING DESCRIPTION – *RESIDENTIAL*

Building Characteristics
SF Dwelling ☐ SF Townhouse ☐
Depth Width
1st floor:
2nd floor:
Basement:
Finished Basement ☐ Unfinished Basement ☐ Crawl space ☐ Slab on Grade ☐
No. of Bedrooms _____
Multi-family dwellings:
No. of efficiency units: _____
No. of 1 BR units: _____
No. of 2 BR units: _____
No. of 3 BR units: _____
Other Structure: _____
Dimensions: _____
Footings: _____
Roof: _____
___ State Certified Modular
___ Manufactured Home

Utilities
Water Supply:
___ Public
✓ Private
Sewage Disposal:
___ Public
✓ Private
Electric Yes ☐ No ☐
Gas Yes ☐ No ☐
Heating System:
Electric ☐ Oil ☐
Natural Gas ☐
Propane Gas ☐
Sprinkler system: N/A ☐
___ NFPA #13D
___ NFPA #13R
___ Other:

THE UNDERSIGNED HEREBY CERTIFIES AND AGREES AS FOLLOWS: (1) THAT HE/SHE IS AUTHORIZED TO MAKE THIS APPLICATION; (2) THAT THE INFORMATION IS CORRECT; (3) THAT HE/SHE WILL COMPLY WITH ALL REGULATIONS OF HOWARD COUNTY WHICH ARE APPLICABLE THERETO; (4) THAT HE/SHE WILL PERFORM NO WORK ON THE ABOVE REFERENCED PROPERTY NOT SPECIFICALLY DESCRIBED IN THIS APPLICATION; (5) THAT HE/SHE GRANTS COUNTY OFFICIALS THE RIGHT TO ENTER ONTO THIS PROPERTY FOR THE PURPOSE OF INSPECTING THE WORK PERMITTED AND POSTING NOTICES.

MK Smith
Applicant's Signature

MARK K. SMITH
Print Name

Email Address

Title/Company

9-08-10
Date

Checks payable to: **DIRECTOR OF FINANCE OF HOWARD COUNTY**
****PLEASE WRITE NEATLY AND LEGIBLY.****
- FOR OFFICE USE ONLY -

AGENCY	DATE	SIGNATURE APPROVAL
Land Development, DPZ		
State Highways		
Building Officials		
Dev. Engineering, DPZ		
Health	9-8-10	Neal Smith
Fire Protection		

Is Sediment Control approval required prior to issuance?
YES ☐ NO ☐

CONTINGENCY CONSTRUC TION START: ☐
ONE STOP SHOP: ☐

DPZ SETBACK INFORMATION
Front: _____
Rear: _____
Side: _____
Side St.: _____

All minimum setbacks met?
YES ☐ NO ☐

Is Entrance Permit Required?
YES ☐ NO ☐
Historic District?
YES ☐ NO ☐
Lot Coverage for New Town Zone _____
SDP/Red-line approval date _____

PROPERTY ID #

Filing fee	$
Permit fee	$
Excise tax	$
Add'l per fee	$
TOTAL FEES	$
Sub-total paid	$
Balance due	$
Check	#
Validation	#

Accepted by _____

Distribution of Copies - White: Building Officials Green: LDD, DPZ Yellow: DED, DPZ Pink: Health Gold: SHA

GENERAL NOTES:

1) THIS LOCATION DRAWING IS PREPARED FOR THE BENEFIT OF THE CLIENT SIGNING THE HOUSE LOCATION SURVEY APPROVAL FORM INSOFAR AS IT IS REQUIRED BY A LENDER OR TITLE INSURANCE COMPANY OR ITS AGENTS IN CONNECTION WITH THE CONTEMPLATED TRANSFER, FINANCING OR REFINANCING OF THE PROPERTY SHOWN HEREON. UNLESS INDICATED AS BEING A BOUNDARY SURVEY, THIS LOCATION DRAWING IS NOT INTENDED FOR USE IN THE ESTABLISHMENT OF PROPERTY LINES AND IS NOT TO BE RELIED UPON FOR THE ESTABLISHMENT OR LOCATIONS OF FENCES, GARAGES, BUILDINGS OR OTHER EXISTING OR FUTURE IMPROVEMENTS. AS A RESULT, THIS LOCATION DRAWING DOES NOT PROVIDE FOR ACCURATE IDENTIFICATION OF PROPERTY LINES, BUT SUCH IDENTIFICATION MAY NOT BE REQUIRED FOR THE TRANSFER OF TITLE OR SECURING FINANCING FOR RE-FINANCING.
2) SUBJECT PROPERTY IS SHOWN IN ZONE C ON THE NATIONAL FLOOD INSURANCE PROGRAM FLOOD INSURANCE RATE MAP OF HOWARD COUNTY, MARYLAND, COMMUNITY PANEL No. 24004400268 EFFECTIVE DEC. 4, 1986.
3) THE OFFSETS FROM BUILDING LINE TO PROPERTY LINE AS SHOWN ON THE PLAT HEREON ARE TO AN ACCURACY OF PLUS OR MINUS 1' (±)
4) NO TITLE REPORT FURNISHED. SUBJECT TO ALL EASEMENTS, RIGHTS OF WAY AND CONDITIONS OF RECORD.
5) THE EXISTING WELL(S) SHOWN ON THIS PLAN IDENTIFIED WITH THE ATTACHED WELL TAG NUMBER HO- 91 -2447) HAS BEEN FIELD LOCATED BY FISHER, COLLINS AND CARTER, INC. PROFESSIONAL LAND SURVEYORS AND IS ACCURATELY SHOWN.

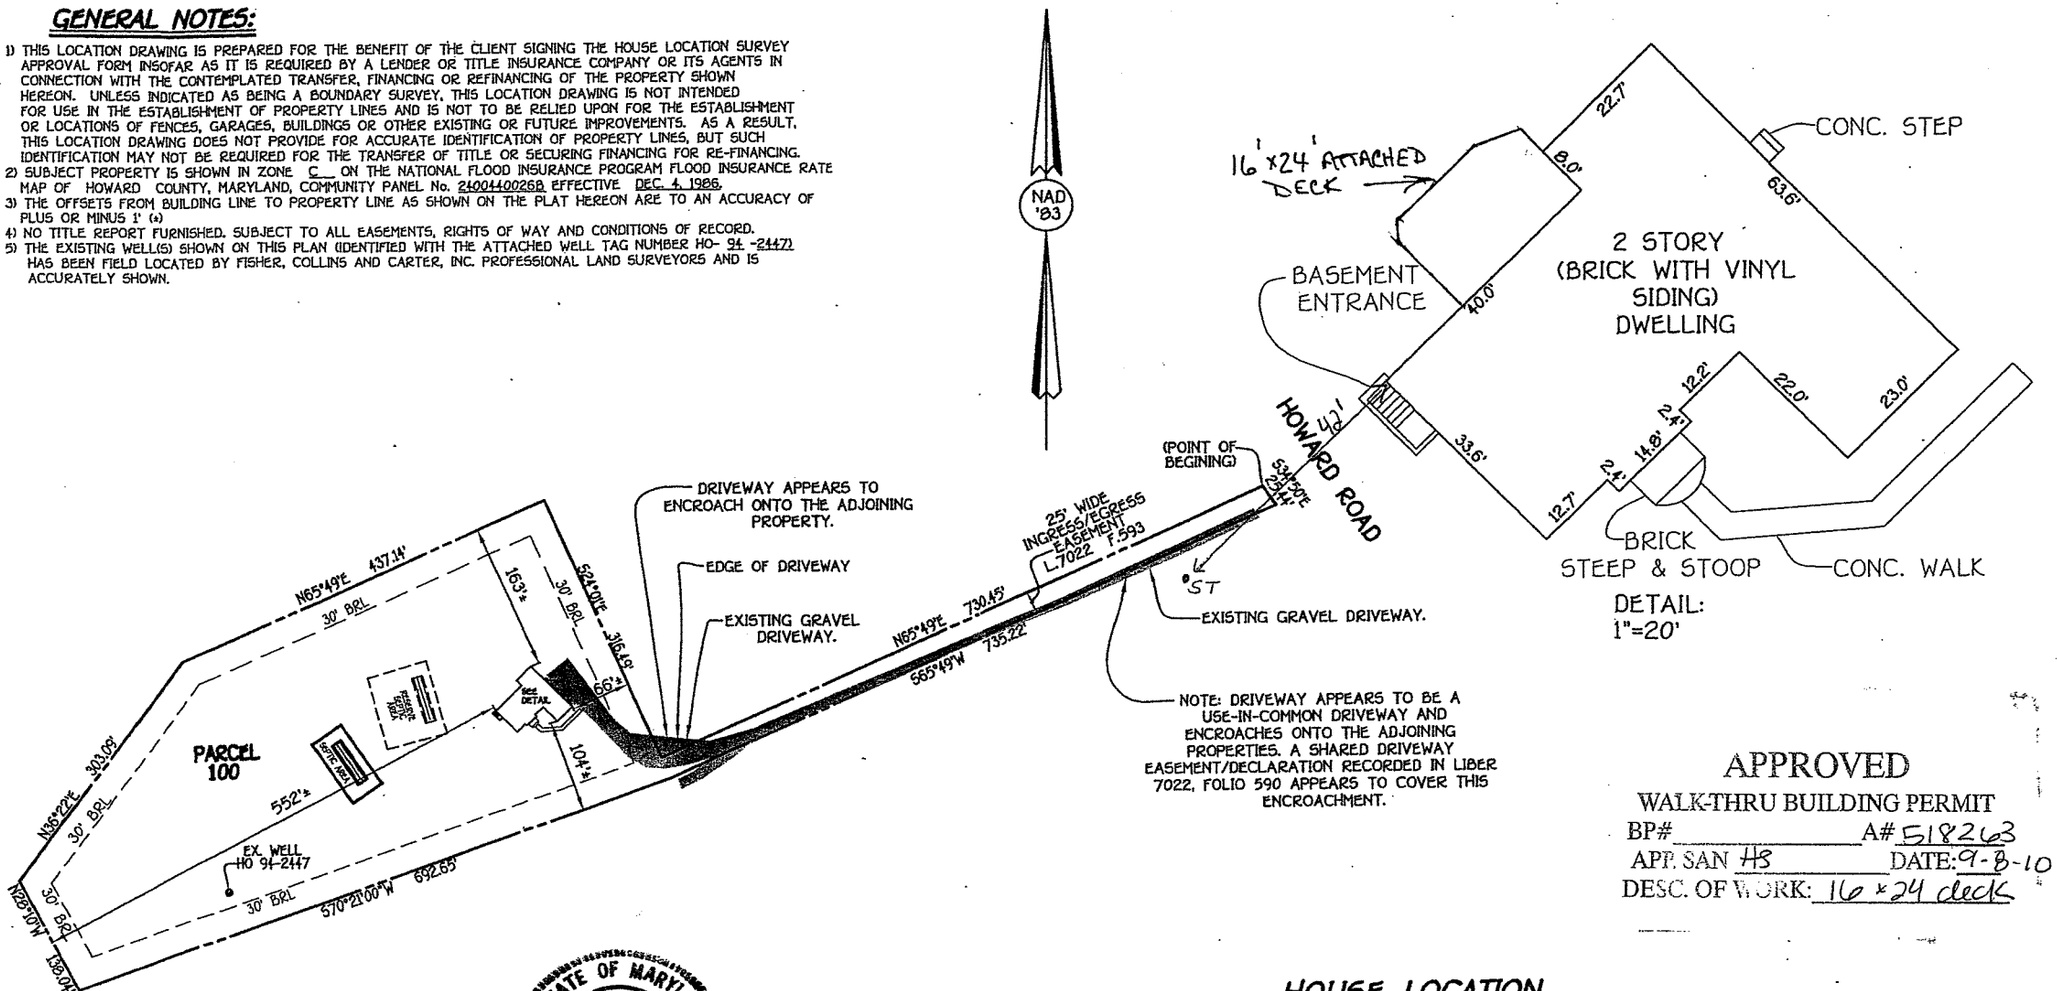

APPROVED

WALK-THRU BUILDING PERMIT
BP# _____ A# 518263
APP. SAN HS DATE: 9-8-10
DESC. OF WORK: 16 x 24 deck

HOUSE LOCATION DRAWING

FOUNDATION LOCATION: 7/06/05
FINAL LOCATION: _____
BOUNDARY SURVEY: _____

SCALE: 1"=150'
DATE: 07/07/05
DRAWN BY: HZ
CHECKED BY: MLR
PROJECT No.: 61773

DEED REFERENCE: LIBER 5078, FOLIO 597
TAX MAP #27 PARCEL 100
#14101 HOWARD ROAD
FIFTH ELECTION DISTRICT
HOWARD COUNTY, MARYLAND

STATE OF MARYLAND
MARK L ROBEL
NO. 339
REGISTERED
PROPERTY LINE SURVEYOR

FISHER, COLLINS & CARTER, INC.
CIVIL ENGINEERING CONSULTANTS & LAND SURVEYORS
CENTENNIAL SQUARE OFFICE PARK - 10272 BALTIMORE NATIONAL PIKE
ELLICOTT CITY, MARYLAND 21042
(410) 461 - 2855

Mark L. Robel 12/28/05
PROFESSIONAL LAND SURVEYOR REG. # 339 DATE

B.R.L.= BUILDING RESTRICTION LINE
TOP OF FOUNDATION ELEV.= 531.3'±

K:\SDSKPROJ\61773 HOWARD ROAD\dwg\61773 HL Parcel 100.dwg, 12/28/2005 9:42:34 AM, \\MIMAS\Oce TDS600