COMPLETE THIS FORM WHEN DROPPING OFF ANY CORRESPONDENCE AND/OR PLANS TO THE HOWARD COUNTY DEPARTMENT OF INSPECTIONS, LICENSES AND PERMITS COUNTER:

Date: June 9, 2011

To: Dan Swinder
(Person's Name and Division)

From: Michael Pettit (301) 604 8609 H/2403881033 C
(Your Name, Company Name and Telephone Number)

RECEIVED
JUN 09 2011
PLAN REVIEW DIVISION

Subject: Project name Pettit 2nd Floor addition

Project site address 7018 Pindell School Rd Fulton MD

Permit Number B1001438 **SDP #** _____

Other information pertinent to this project revised drawings

✓ Please check the attachments below that you are submitting with this transmittal:

___ Letter of response to Howard County plan review code letter

✓ Revised plans and/or revised details: When submitting for a complete **re-**review, **duplicate sets shall be submitted.**

___ Structural steel certification

___ Energy conservation calculations

___ Certification for _____ (be specific).

4 Copies of Plat ~~3 Copies Attch~~ (be specific).

___ Two sets of single family dwelling model plans to be placed on permanent file: Model name and/or #_____

___ Other _____

Is there anyone else that should be contacted regarding this project if there are questions?

If so, please list that person's name and telephone number below:

None (____)_____
(Person's name) (Telephone number)

PLEASE ASSURE ALL DOCUMENTS AND/OR REVISIONS ARE APPROPRIATELY SIGNED AND SEALED, IF NECESSARY, BY A LICENSED ARCHITECT OR ENGINEER. PLEASE BE ADVISED THAT INSUFFICIENT INFORMATION MAY RESULT IN THE DELAY OF REVIEW BY THE PLANS EXAMINER. THE DEPARTMENT OF INSPECTIONS, LICENSES AND PERMITS WILL CONTACT YOU IF THERE IS A PROBLEM. IN ADDITION, ONCE THE BUILDING PERMIT IS APPROVED BY THE PLAN REVIEW DIVISION AND ALL OTHER REQUIRED SIGNATORY AGENCIES, AND THE BUILDING PERMIT IS READY FOR ISSUANCE, THE PERMIT DIVISION WILL NOTIFY THE APPROPRIATE CONTACT PERSON FOR PERMIT PICK UP. ALL PERMIT STATUS INQUIRIES SHALL BE DIRECTED TO THE PERMIT DIVISION AT 410-313-2455. CODE RELATED QUESTIONS AND PLAN REVIEW INQUIRIES SHALL BE DIRECTED TO THE PLAN REVIEW DIVISION AT 410-313-2436. PLEASE ALLOW A MINIMUM OF FIVE (5) WORKING DAYS FOR ANY PLAN SUBMITTALS TO BE REVIEWED. THANK YOU.

Received by _____ CC:

white: Plan Review Division
yellow: Applicant
pink: Permit Division

t:\Updated forms\transmit.frm - Rev. 5/08

CC: Zoning
Neanie

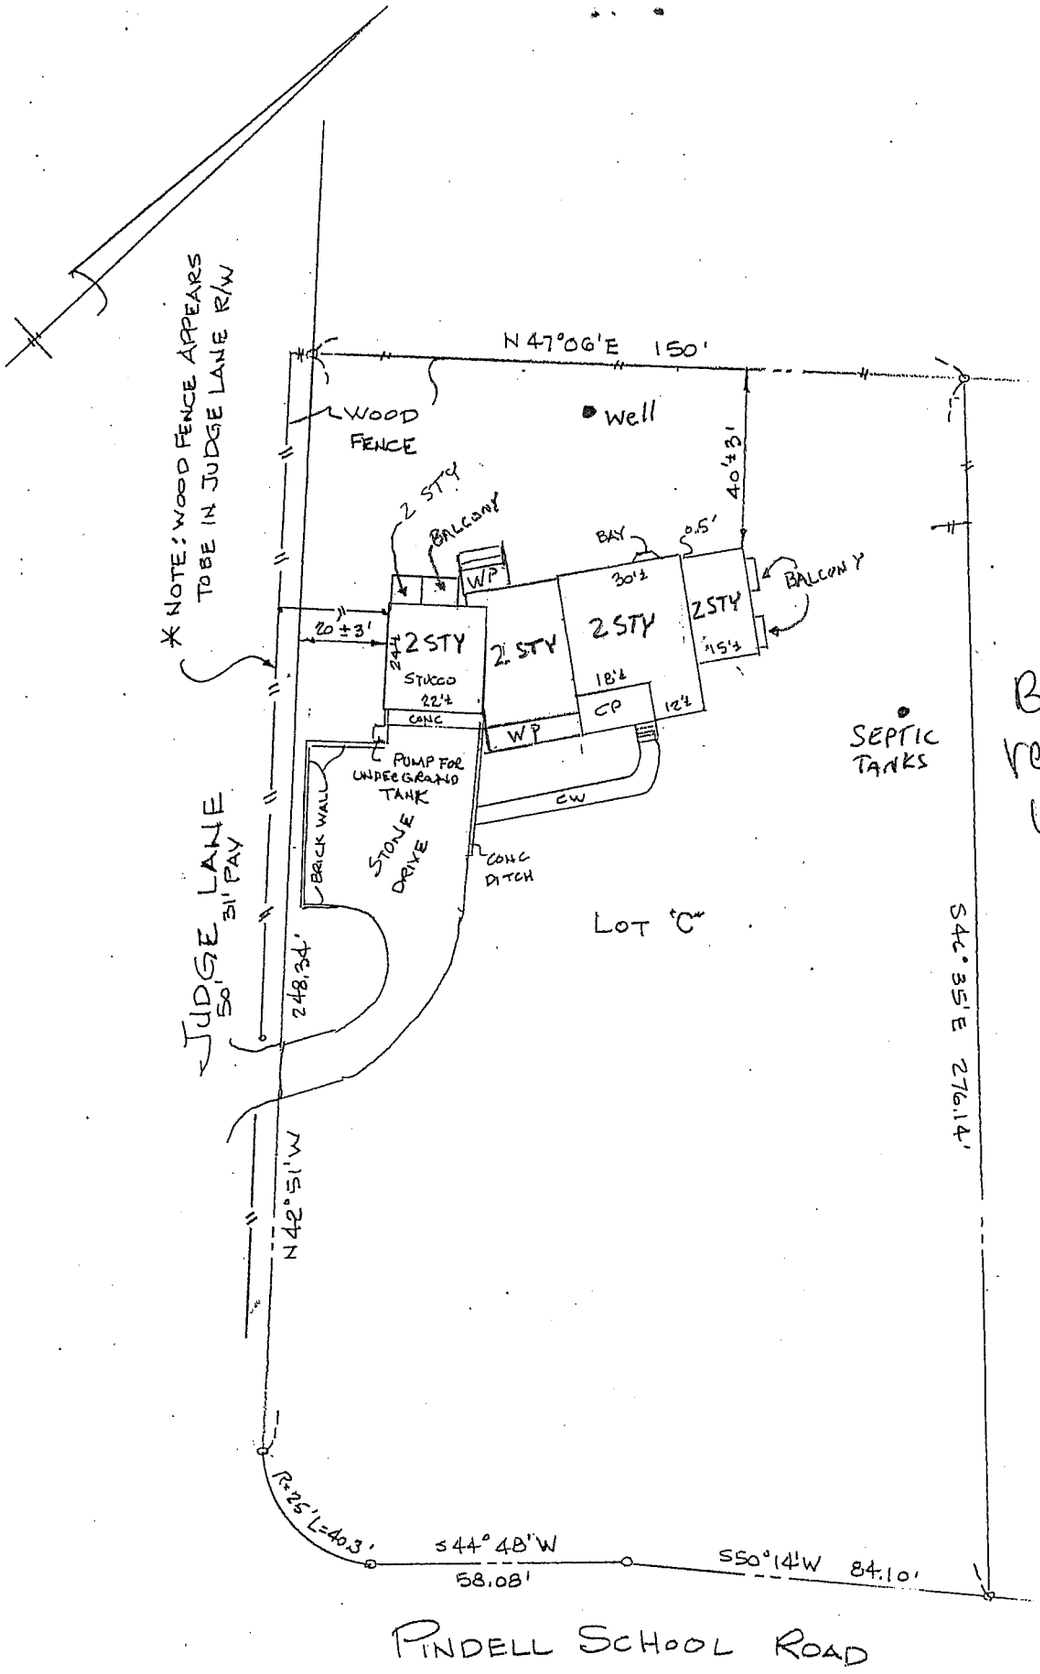

B1100/1438
revision OK
6-21-11
MG

The plat is of benefit to a consumer only insofar as it is required by a lender or a title insurance company or its agent in connection with contemplated transfer, financing or refinancing. The plat is not to be relied upon for the establishment or location of fences, garages, buildings, or other existing or future improvements. The plat does not provide for the accurate identification of property boundary lines, but such identification may not be required for the transfer of title or securing financing or refinancing.

THE LOT SHOWN HEREON IS IN FLOOD ZONE C PER F.E.M.A. FLOOD INSURANCE RATE MAP PANEL # 2400440003B

*7018 PINDELL SCHOOL ROAD

LOT C, PLAN OF A SUBDIVISION OF THE PROPERTY OF JOSEPH D. JUDGE
PLAT BOOK 5/82
HOWARD CO., MARYLAND

SCALE 1"=40'	LOCATION CERTIFICATION
DATE 9-14-04	WITZ & ASSOCIATES GENERAL SURVEYING CO.
JOB No.	1009 Frederick Road Baltimore, MD 21228 Phone 410-869-3536

STATE OF MARYLAND
WALTER H. WITZ, JR.
No. 79
REGISTERED
PROPERTY LINE SURVEYOR