A# 00985

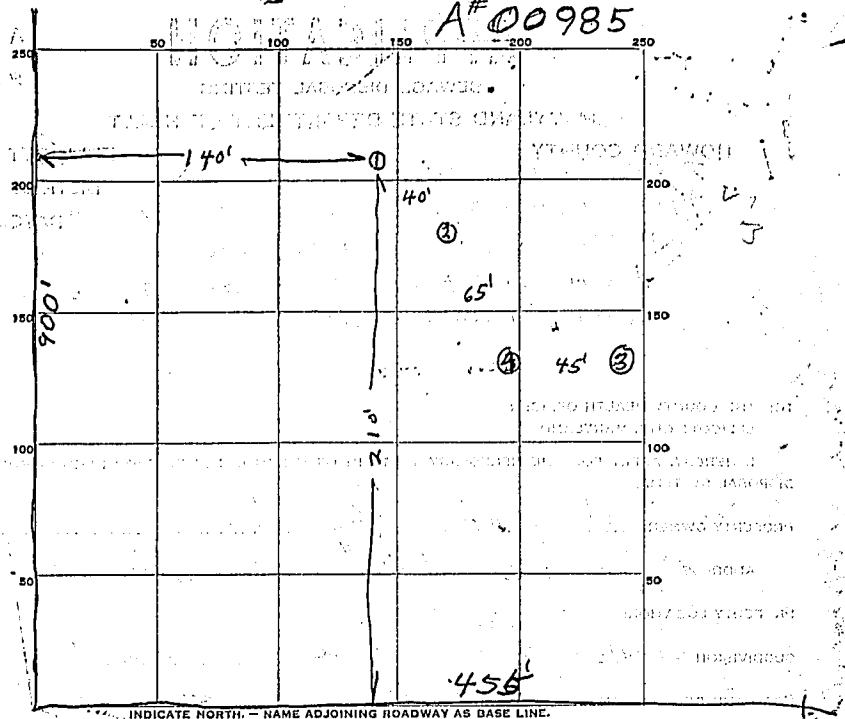

Lot #4

INDICATE NORTH. — NAME ADJOINING ROADWAY AS BASE LINE.

OWEN BROWN RD

DATE	TEST NO.	DEPTH	PRE-WET START	PRE-WET STOP	TEST - 1" DROP START	TEST - 1" DROP STOP	TIME
5/20	1	3	11:43	12:10	1210	1242	32 min
	2	3	11:45	12:11	1211	1250	39 min
	3	3	11:46	1126	3/4"	40 min	
	4	3	ground water at 3'				

SOIL AUGER FINDING

TESTED BY Raymond Hodges

REMARKS

ALSO PRESENT Ray L. Bowman LOT NO. 2 & 3

32
40
39
3)117
37