Property known as: LOT 9
LOTS 1-26 DUNFRETTEN ESTATES
5TH ELECT. DIST. HOWARD CO., MD. PLAT #5402

THIS PLAT CAN NOT BE USED TO ESTABLISH PROPERTY LINES OR CORNERS.

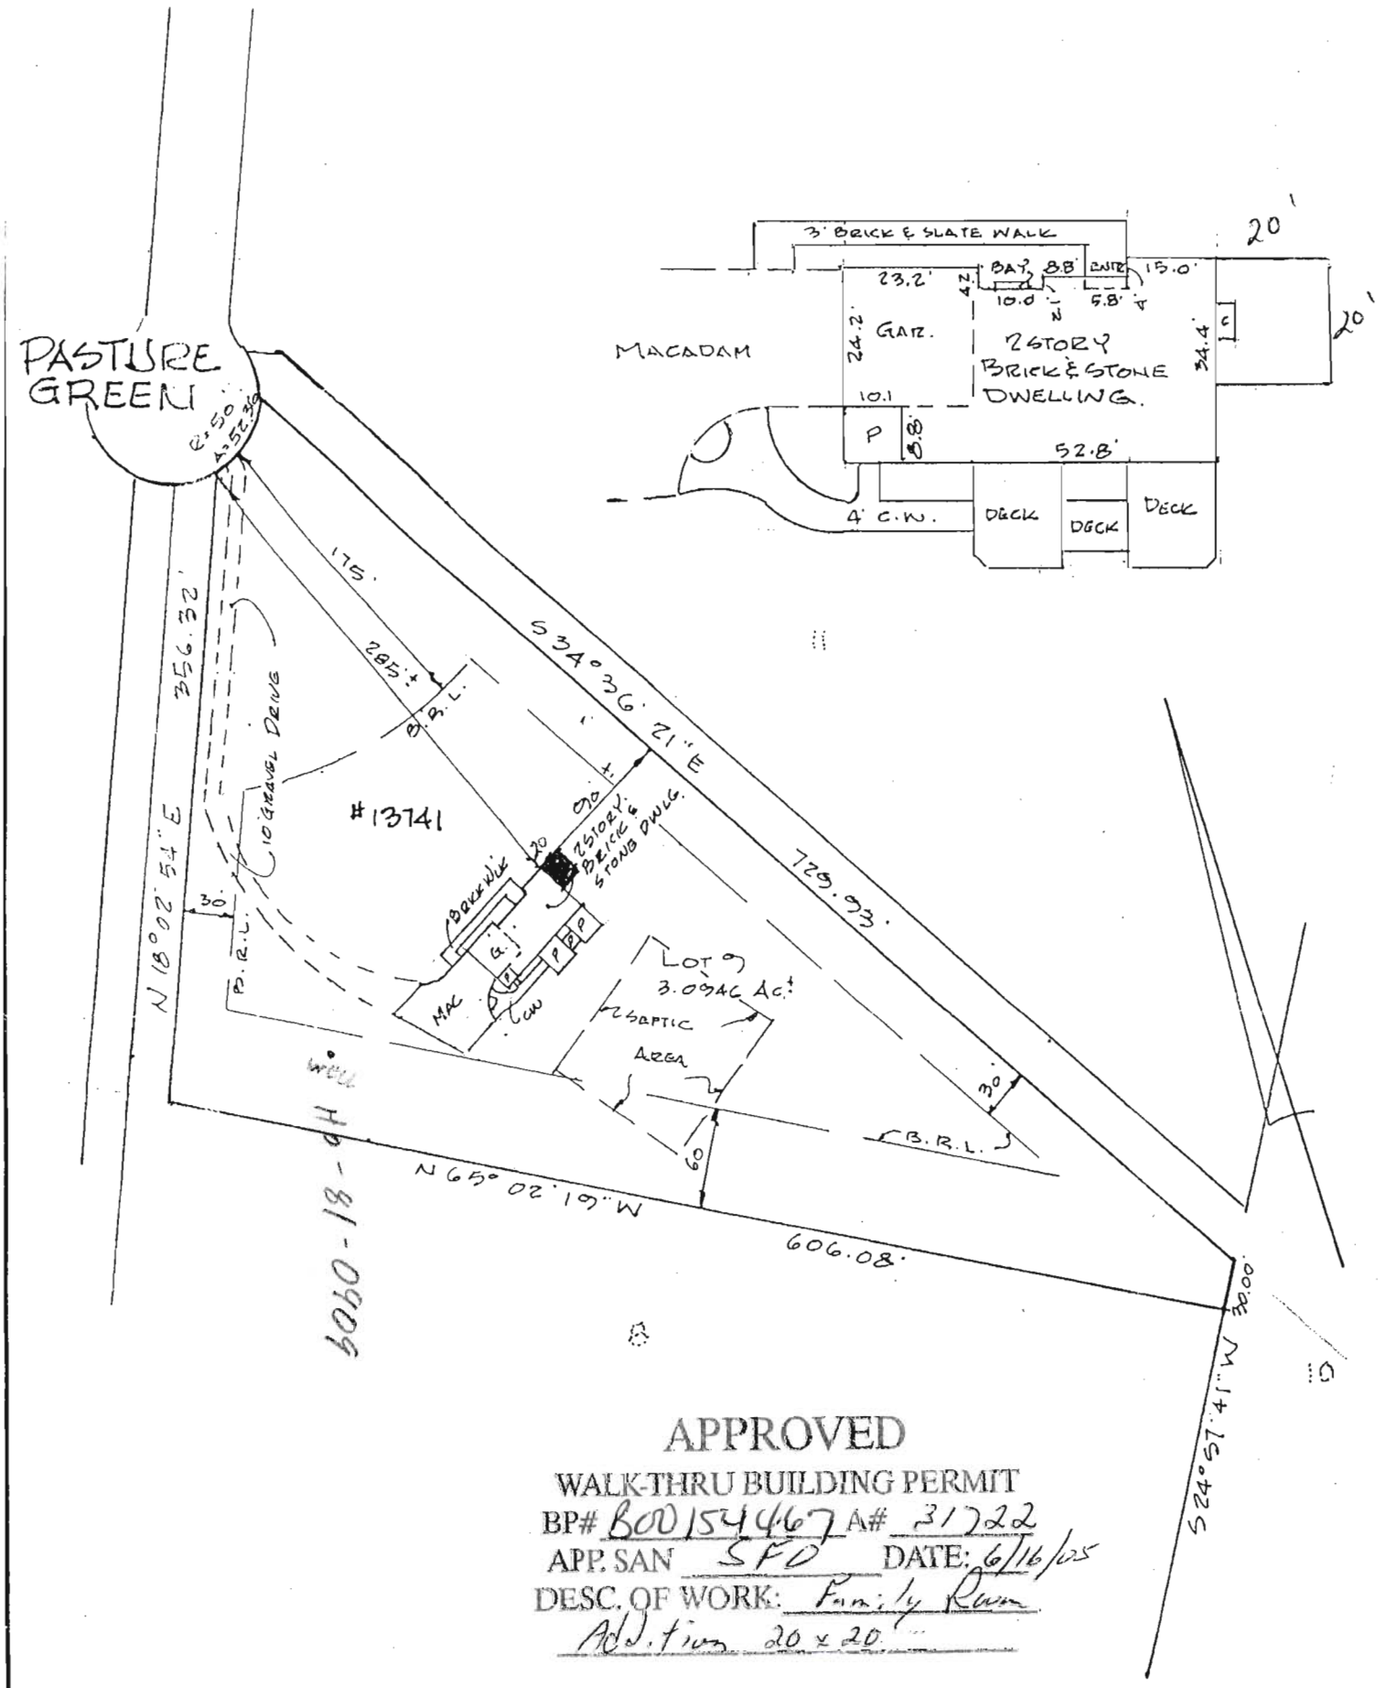

APPROVED
WALK-THRU BUILDING PERMIT
BP# B00154467 A# 31722
APP. SAN SFO DATE: 6/16/05
DESC. OF WORK: Family Room Addition 20 x 20.

LOCATION SURVEY PLAT
SUBJECT PROPERTY NOT LOCATED IN A FLOOD PLAIN AREA UNLESS OTHERWISE NOTED

CERTIFICATION	SEAL	SCALE: 1" = 100' DATE: 3-13-92
This is to certify that I have surveyed the property known as: #13741 PASTURE GREEN for the purpose of locating the improvements thereon, and the improvements are located as shown.	STATE OF MARYLAND WALTER PARK 8530 REGISTERED PROFESSIONAL LAND SURVEYOR Walter Park	LAND DESIGN ENGINEERING, INC. SUITE 210 10620 GUILFORD ROAD JESSUP, MARYLAND 20794 880-0034 (BALT) 604-6264 (WASH) 604-6735 (FAX)