(A) P 546297

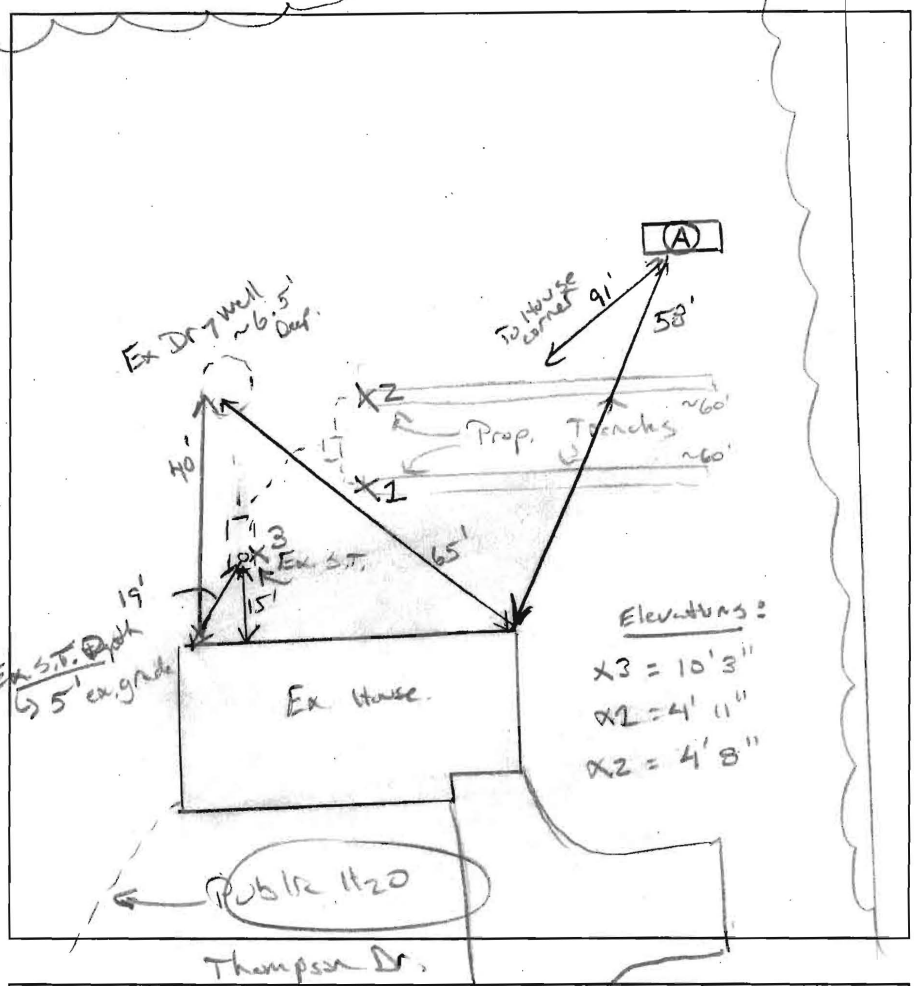

(A)

10" WK SBK, L, Gr roots, Dry

Br/Rd. L, 10% clay, roots 20% mica slat Friable, wk SBK

4'

Br/R/Y SL, Friable, roots, Dry, platy, roots micaceous

8'

Br/Y FSL, smooth boundary, Highly micaceous wk platy

14'

DATE	TEST #	DEPTH	START	BREAK 1" DROP	STOP 2" DROP	TIME OF 2ND INCH	P/F/H
4/9/14	(A)	4'/14'	00:29	00:34	00:41	7	(P)
		6'7"	00:48	00:49:30	00:52:	2 1/2	(P)

Property of Public H2O. Ex. Drywell collapsed.

REMARKS MPI increase w/ soil depth.

SANITARIAN K. Wolf BACKHOE George Subosky OTHERS Helper / Homeowner

TEST HOLES USED IN SDA 1 AVG. PERC TIME ~5 SQ. FT/BR

TRENCH WIDTH 2 INLET DEPTH Varies MAX. BOT DEPTH 9 EFFECTIVE S/W all

3 BR.

$\frac{450}{1.2} = 375 \div 2 = 187.5\ (.57) = 110 \sim 2 \times 60'$