APPROVED

WALK-THRU BUILDING PERMIT

BP# _____ A# N/A

APP. SAN HS DATE: 8-16-12

DESC. OF WORK: addition over garage (no footprint change)

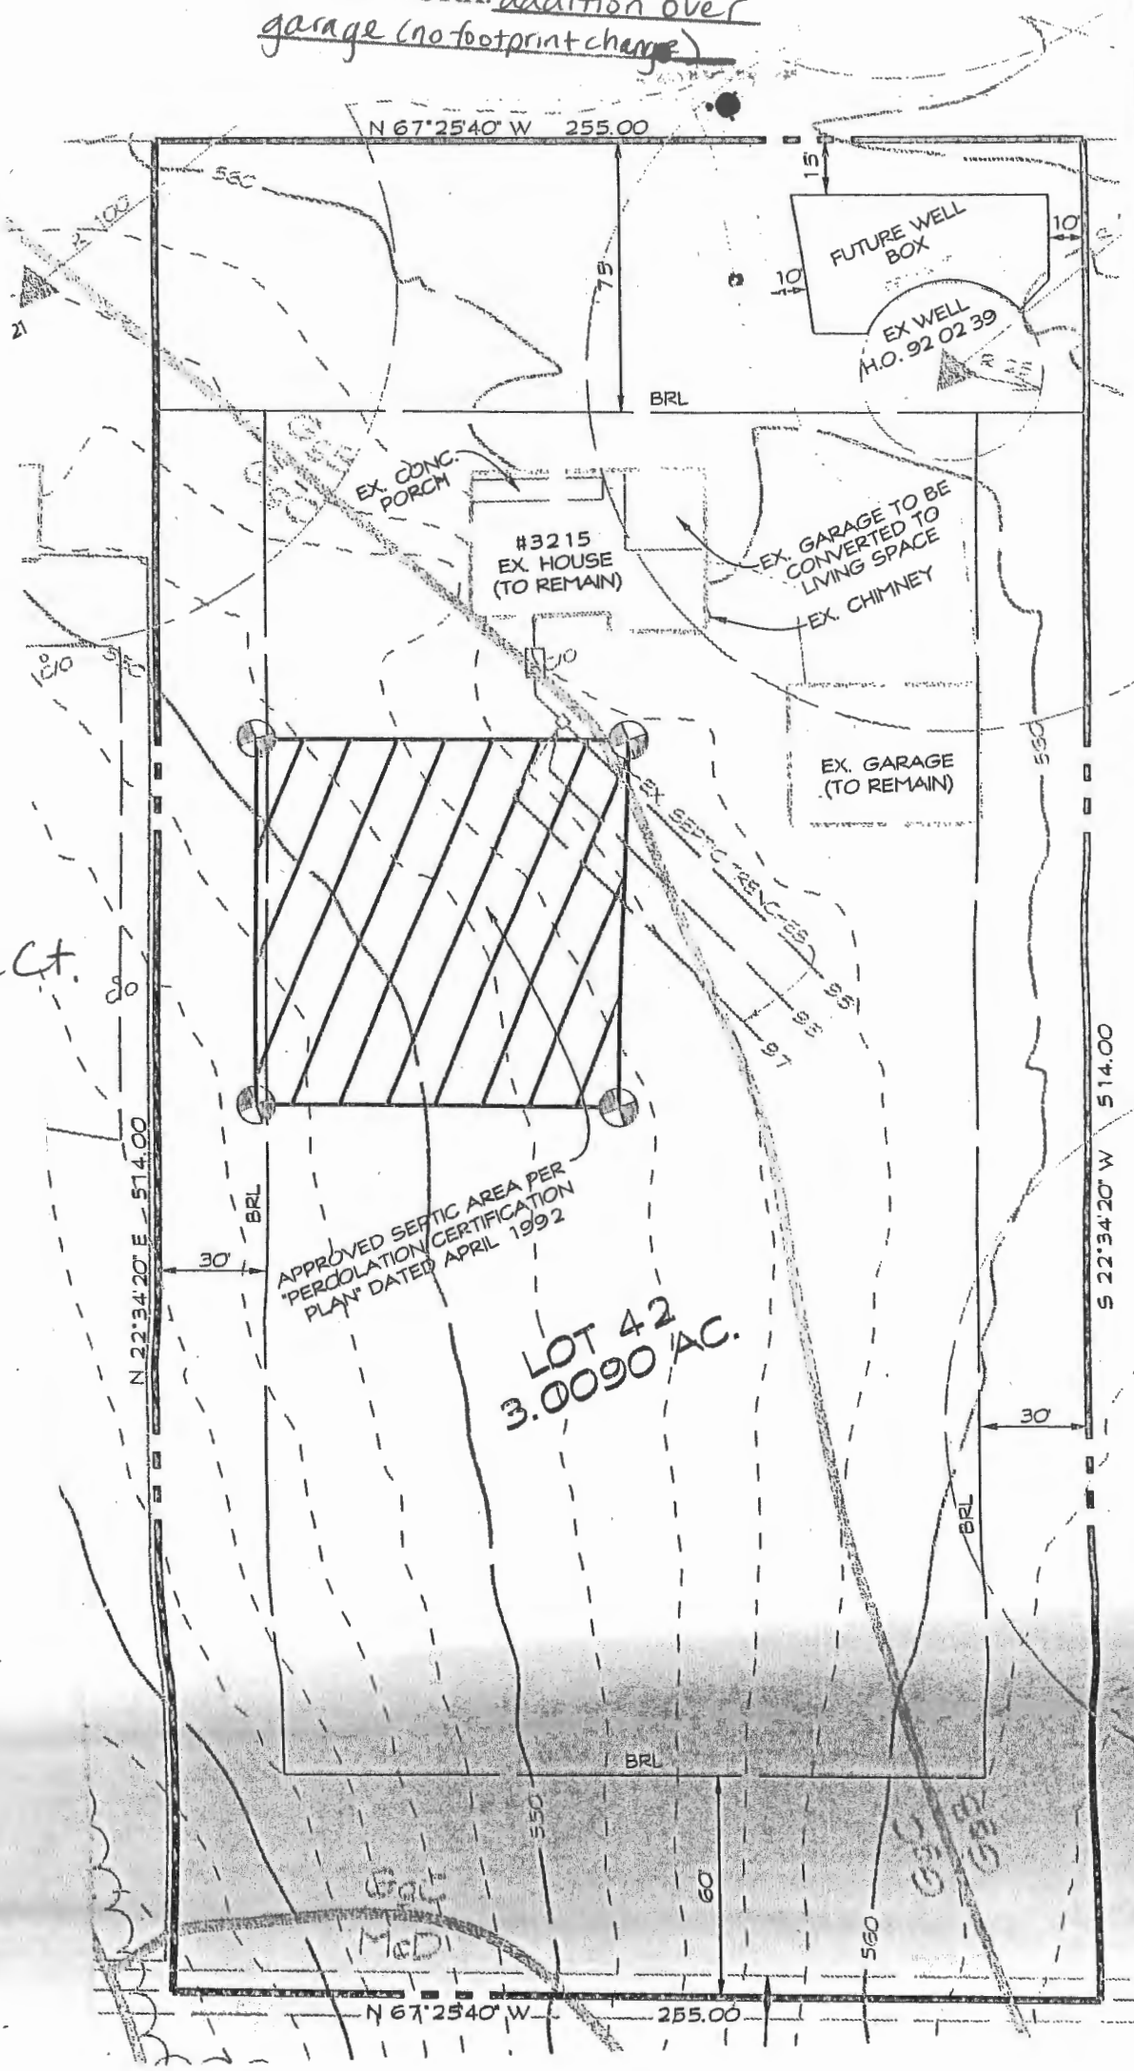

3215
Starting Gate Ct.