
 WATER WELL ABANDONMENT-SEALING REPORT FORM

SUBMIT COPIES OF COMPLETED FORM TO:

- * COUNTY ENVIRONMENTAL AGENCY (contact MDE, WMA if address needed)
- * WELL OWNER
- * MDE, WATER MANAGEMENT ADMINISTRATION, WELL PROGRAM

DATE WELL ABANDONED: 10/08/18 (month/day/year)

* PERMIT NUMBER OF ABANDONED WELL (if any)

HO-73-3056

* PERMIT NUMBER OF REPLACEMENT WELL:

* PERSON ABANDONING WELL: William Guzzardi


WELL DRILLER'S LICENSE NUMBER: 233

CIRCLE: MWD ~~MSD~~ ~~MGD~~

* OWNER'S NAME: May Whitney Stuart

SITE LOCATION MAP

* WELL LOCATION:
 COUNTY: Howard
 NEAREST TOWN: Columbia
 TAX MAP 0641 BLOCK _____ PARCEL 0420
 SUBDIVISION: 0000
 SECTION: _____ LOT: 222
 STREET ADDRESS: 10718 Moosberger Ct

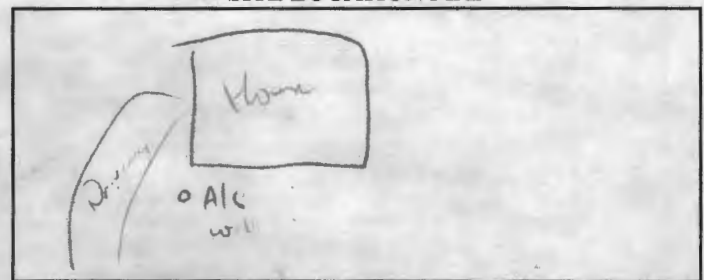

LATITUDE 3 9 . 1 7 5 6 4 2

LONGITUDE 7 6 . 8 9 0 9 2 6

LOG OF SEALING MATERIAL

MATERIAL	FEET	
	FROM	TO
<u>Bestonite</u>	<u>100</u>	<u>10</u>
<u>Concrete</u>	<u>10</u>	<u>2</u>

* TYPE OF WELL BEING ABANDONED:

- DRILLED JETTED
- BORED HAND DUG
- OTHER (specify) _____

* USE CODE:

- DOMESTIC MUNICIPAL/PUBLIC
- IRRIGATION INDUSTRIAL
- TEST/OBSERVATION GEOTHERMAL

VOLUME OF MATERIAL USED

Bestonite (30000), Concrete (2 bags)

* TYPE OF CASING:

- STEEL PLASTIC
- CONCRETE OTHER (specify) _____

SIZE OF CASING: 6" INCHES IN DIAMETER

DEPTH OF WELL: 150 FEET DEEP

WAS ANY CASING REMOVED? YES NO

If yes, length removed, in feet: 3

WAS CASING RIPPED OR PERFORATED? YES NO

SIGNATURE William Guzzardi LICENSE# 233

MWD MSD MGS
 CIRCLE ONE

10/17/18
 DATE

COUNTY

Pursuant to § 10-624 of the State Govt. Article of the Maryland Code, personal info requested on this form is used in processing this form pursuant to COMAR 26.04.04. Failure to provide the info may result in this form not being processed. You have the right to inspect, amend, or correct this form. The Maryland Department of the Environment is subject to the Maryland Public Information Act. This form may be made available on the Internet via MDE's website and is subject to inspection or copying, in whole or in part, by the public and other governmental agencies, if not protected by federal or State law.