



Building Permit Application

Howard County Maryland
Department of Inspections, Licenses and Permits
3430 Court House Drive
Permits: 410-313-2455
www.howardcountymd.gov

Date Received: _____

Permit No.: _____

Building Address: 5942 Clifton Oaks Dr
 City: Clarksville State: MD Zip Code: 21029
 Suite/Apt. #: _____ SDP/WP/BA #: _____
 Subdivision: _____
 Lot: _____ Tax Map: _____ Parcel: _____

Existing Use: Back yard
 Proposed Use: Swimming pool
 Estimated Construction Cost: \$ 100,000.00
 Description of Work: Inground pool

Occupant/Tenant Name: Occupant
 Was tenant space previously occupied? Yes No
 Contact Name: Nicholas Colombal
 Address: 5942 Clifton Oaks Dr
 City: Clarksville State: MD Zip Code: 21029
 Phone: 443-710-3928 Fax: _____
 Email: n.colombal@gmail.com

Property Owner's Name: Nicholas Colombal
 Address: 5942 Clifton Oaks Dr
 City: Clarksville State: MD Zip Code: 21029
 Phone: 443-710-3928 Fax: _____
 Email: n.colombal@gmail.com

Applicant's Name & Mailing Address, (if other than stated herein)
 Applicant's Name: Cristobal Vera
 Address: 1859 August Ave
 City: Dundalk State: MD Zip Code: 21222
 Phone: 443-5296472
 Email: Cris.V.Cisneros@gmail.com

Contractor Company: _____
 Contact Person: _____
 Address: _____
 City: _____ State: _____ Zip Code: _____
 License No.: _____
 Phone: _____ Fax: _____
 Email: _____

Engineer/Architect Company: _____
 Responsible Design Prof.: _____
 Address: _____
 City: _____ State: _____ Zip Code: _____
 Phone: _____ Fax: _____
 Email: _____

Commercial Building Characteristics	Residential Building Characteristics
Height:	<input checked="" type="checkbox"/> SF Dwelling <input type="checkbox"/> SF Townhouse
No. of stories:	Depth Width
Gross area, sq. ft./floor:	1 st floor:
	2 nd floor:
Area of construction (sq. ft.):	Basement:
	<input checked="" type="checkbox"/> Finished Basement
Use group:	<input type="checkbox"/> Unfinished Basement
	<input type="checkbox"/> Crawl Space
	<input type="checkbox"/> Slab on Grade
Construction type:	No. of Bedrooms:
<input type="checkbox"/> Reinforced Concrete	Multi-family Dwelling
<input type="checkbox"/> Structural Steel	No. of efficiency units:
<input type="checkbox"/> Masonry	No. of 1 BR units:
<input type="checkbox"/> Wood Frame	No. of 2 BR units:
<input type="checkbox"/> State Certified Modular	No. of 3 BR units:
	Other Structure:
	Dimensions:
<input checked="" type="checkbox"/> Roadside Tree Project Permit	Footings:
<input type="checkbox"/> Yes <input type="checkbox"/> No	Roof:
<input type="checkbox"/> Roadside Tree Project Permit #	<input type="checkbox"/> State Certified Modular
	<input type="checkbox"/> Manufactured Home

Utilities	
Electric:	<input checked="" type="checkbox"/> Yes <input type="checkbox"/> No
Gas:	<input type="checkbox"/> Yes <input checked="" type="checkbox"/> No
Water Supply	
<input type="checkbox"/> Public	
<input checked="" type="checkbox"/> Private	
Sewage Disposal	
<input type="checkbox"/> Public	
<input checked="" type="checkbox"/> Private	
Heating System	
<input checked="" type="checkbox"/> Electric <input type="checkbox"/> Oil	
<input type="checkbox"/> Natural Gas <input type="checkbox"/> Propane Gas	
<input type="checkbox"/> Other:	
Sprinkler System:	
<input type="checkbox"/> Yes <input type="checkbox"/> No	
Grading Permit Number:	
Building Shell Permit Number:	

THE UNDERSIGNED HEREBY CERTIFIES AND WARRANTS AS FOLLOWS: (1) THAT HE/SHE IS AUTHORIZED TO MAKE THIS APPLICATION; (2) THAT THE INFORMATION IS CORRECT; (3) THAT HE/SHE WILL COMPLY WITH ALL REGULATIONS OF HOWARD COUNTY WHICH ARE APPLICABLE THERETO; (4) THAT HE/SHE WILL PERFORM NO WORK ON THE ABOVE REFERENCED PROPERTY NOT SPECIFICALLY DESCRIBED IN THIS APPLICATION; (5) THAT HE/SHE GRANTS HOWARD COUNTY OFFICIALS THE RIGHT TO ENTER ONTO THIS PROPERTY FOR THE PURPOSE OF INSPECTING THE WORK PERMITTED AND POSTING NOTICES.

Applicant's Signature: Cristobal Vera Print Name: Cristobal Vera
 Email Address: Cris.V.Cisneros@gmail.com Date: _____
 Title/Company: _____

Checks Payable to: DIRECTOR OF FINANCE OF HOWARD COUNTY
PLEASE WRITE NEATLY & LEGIBLY

FOR OFFICE USE ONLY

AGENCY	DATE	SIGNATURE OF APPROVAL
State Highways		
Building Officials		
PSZA (Zoning)		
PSZA (Engineering)		
Health		<u>[Signature]</u>

Is Sediment Control approval required for issuance? Yes No
 CONTINGENCY CONSTRUCTION START

DPZ SETBACK INFORMATION
Front:
Rear:
Side:
Side St.:
All minimum setbacks met? <input type="checkbox"/> Yes <input type="checkbox"/> No
Is Entrance Permit Required? <input type="checkbox"/> Yes <input type="checkbox"/> No
Historic District? <input type="checkbox"/> Yes <input type="checkbox"/> No
Lot Coverage for New Town Zone:
SDP/Red-line approval date:

Filing Fee	\$
Permit Fee	\$
Tech Fee	\$
Excise Tax	\$
PSFS	\$
Guaranty Fund	\$
Add'l per Fee	\$
Total Fees	\$
Sub- Total Paid	\$
Balance Due	\$
Check	#

Distribution of Copies: White: Building Officials Green: PSZA,Zoning Yellow: PSZA,Engineering Pink: Health Gold: SHA

- TEST 1 3 MIN. @ 4'-0" > 2 MIN. @ 11'-0"
- TEST 2 6 MIN. @ 4'-6" > 2 MIN. @ 11'-0"
- TEST 3 HEAVY MOTTLES @ 9'-6"
- TEST 4 4 MIN. @ 6'-7" > 2 MIN. @ 11'-6"
- TEST 5 OK to 14'-0"
- TEST 6 OK to 11'-0"
- TEST 7 6 MIN. @ 6'-6" > 2 MIN. @ 11'-0"
- TEST 8 OK to 13'-9"
- TEST 9 ROCK at 7'-6"
- TEST 10 2 MIN. @ 3'-0" 5 MIN. @ 5'-0"
- TEST 10 7 MIN. @ 3'-6" > 2 MIN. @ 9'-0"


Contract Purchaser NICK COLOMBEL ERIKA L. COLOMBEL
 Subdivision Name WESTSIDE
 Lot Number 10 Plat# 16876
 Street(s) #5942 CLIFTON OAKS DRIVE
 Water PRIVATE Sewer PRIVATE
 Scale 1"=100'

 Left Yard Setback 93'±
 Rear Yard Setback 800'±
 House Dimensions _____
 Garage Dimensions _____

Peter L. Podolak
 Peter L. Podolak, P.E.
 Reg. #19561

I hereby certify that these documents were prepared by me, I am a duly licensed professional engineer under the laws of Maryland, license no. 19561, expiration date: 3/31/2014

PREPARED BY:
 LEON A. PODOLAK AND ASSOCIATES, L.L.C.
 147 E. MAIN STREET P.O. BOX 266
 WESTMINSTER, MARYLAND 21157
 PHONE: (410) 848-2229 (410) 876-1226
 FAX: (410) 848-2258
 email: drawings@lapodolak.com

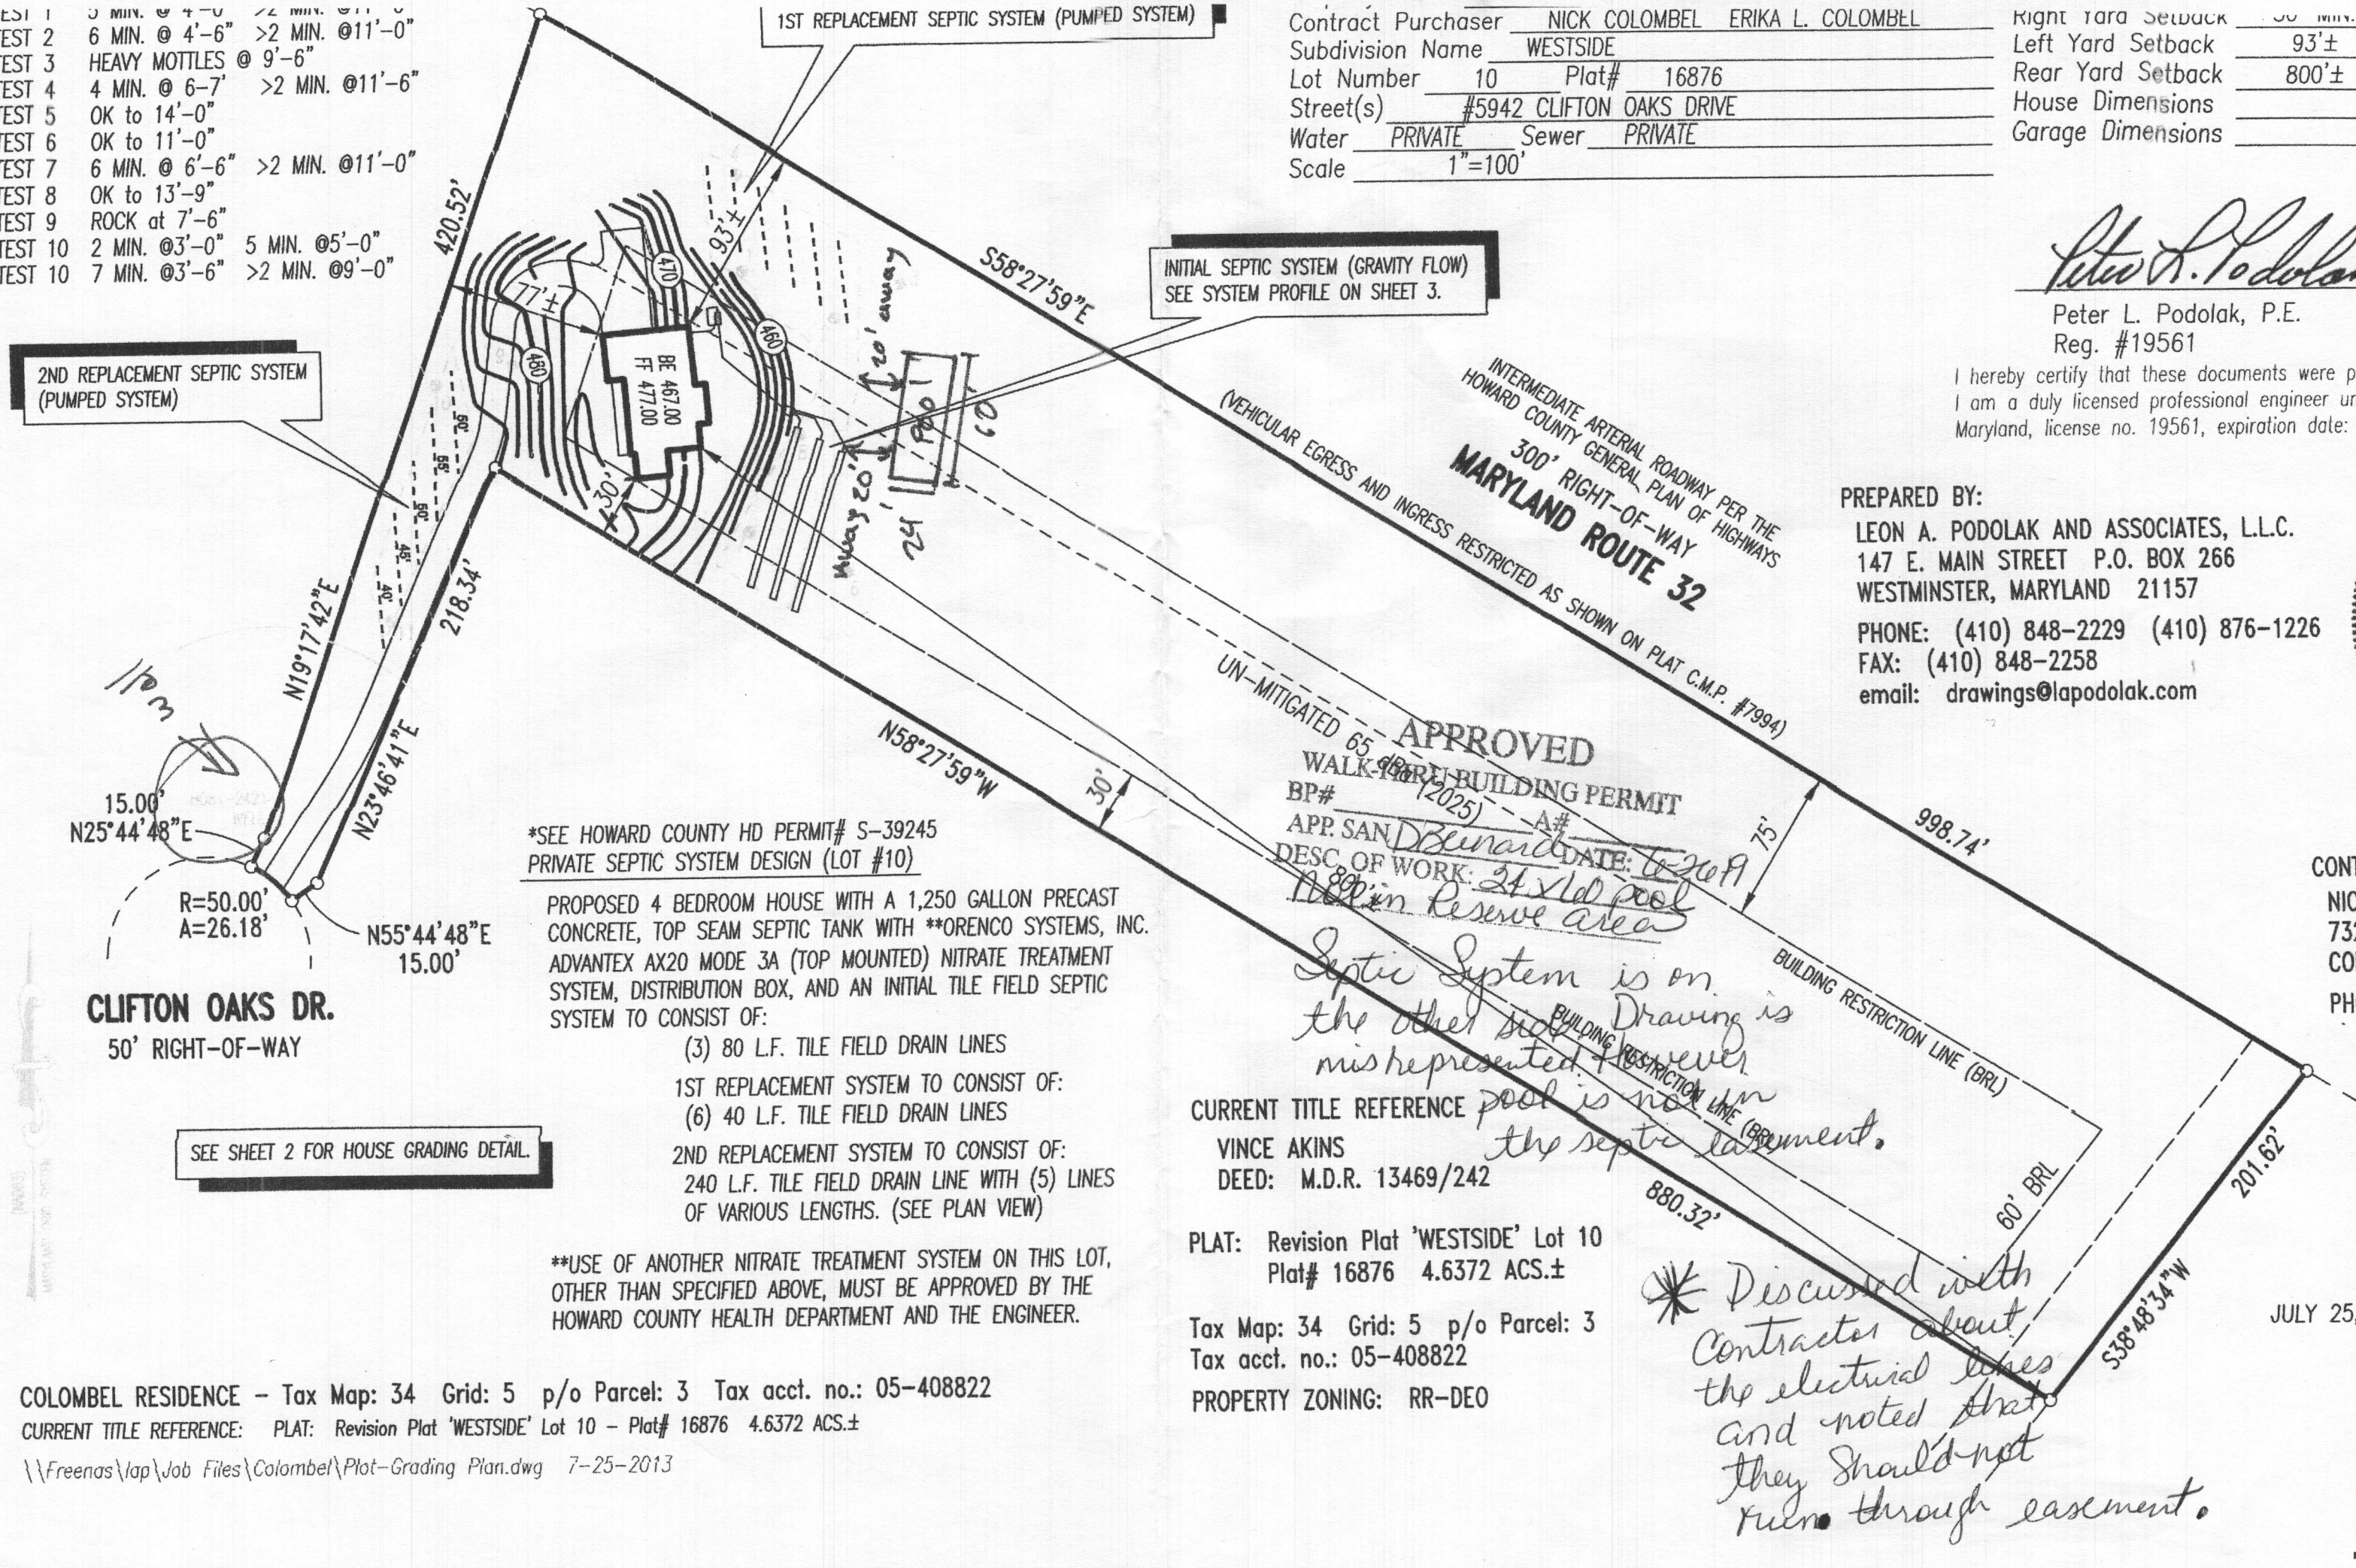

*SEE HOWARD COUNTY HD PERMIT# S-39245
 PRIVATE SEPTIC SYSTEM DESIGN (LOT #10)

PROPOSED 4 BEDROOM HOUSE WITH A 1,250 GALLON PRECAST CONCRETE, TOP SEAM SEPTIC TANK WITH **ORENCO SYSTEMS, INC. ADVANTEX AX20 MODE 3A (TOP MOUNTED) NITRATE TREATMENT SYSTEM, DISTRIBUTION BOX, AND AN INITIAL TILE FIELD SEPTIC SYSTEM TO CONSIST OF:

- (3) 80 L.F. TILE FIELD DRAIN LINES
- 1ST REPLACEMENT SYSTEM TO CONSIST OF:
- (6) 40 L.F. TILE FIELD DRAIN LINES
- 2ND REPLACEMENT SYSTEM TO CONSIST OF:
- 240 L.F. TILE FIELD DRAIN LINE WITH (5) LINES OF VARIOUS LENGTHS. (SEE PLAN VIEW)

**USE OF ANOTHER NITRATE TREATMENT SYSTEM ON THIS LOT, OTHER THAN SPECIFIED ABOVE, MUST BE APPROVED BY THE HOWARD COUNTY HEALTH DEPARTMENT AND THE ENGINEER.

CLIFTON OAKS DR.
 50' RIGHT-OF-WAY

SEE SHEET 2 FOR HOUSE GRADING DETAIL.

APPROVED
 in Reserve area

Septic System is on the other side of the pool is not in the septic easement.

CURRENT TITLE REFERENCE
 VINCE AKINS
 DEED: M.D.R. 13469/242

PLAT: Revision Plat 'WESTSIDE' Lot 10
 Plat# 16876 4.6372 ACS.±

Tax Map: 34 Grid: 5 p/o Parcel: 3
 Tax acct. no.: 05-408822

PROPERTY ZONING: RR-DEO

* Discussed with contractors about the electrical lines and noted that they should not run through easement.

CONTF
 NICK
 732:
 COLI
 PHO

JULY 25,

COLOMBEL RESIDENCE - Tax Map: 34 Grid: 5 p/o Parcel: 3 Tax acct. no.: 05-408822
 CURRENT TITLE REFERENCE: PLAT: Revision Plat 'WESTSIDE' Lot 10 - Plat# 16876 4.6372 ACS.±