
WATER WELL ABANDONMENT-SEALING REPORT FORM

SUBMIT COPIES OF COMPLETED FORM TO:

- * COUNTY ENVIRONMENTAL AGENCY (contact MDE, WMA if address needed)
- * WELL OWNER
- * MDE, WATER MANAGEMENT ADMINISTRATION, WELL PROGRAM

APPROVED

DATE WELL ABANDONED: 2/4/19 (month/day/year)

* PERMIT NUMBER OF ABANDONED WELL (if any) _____

* PERMIT NUMBER OF REPLACEMENT WELL: _____

* PERSON ABANDONING WELL: William Guizzardi


WELL DRILLER'S LICENSE NUMBER: 233

* OWNER'S NAME: Mayer Walker

CIRCLE: MWD/MSD/MGD

SITE LOCATION MAP

* WELL LOCATION:
COUNTY: Howard
NEAREST TOWN: Elkridge
TAX MAP 0037 BLOCK _____ PARCEL 0211
SUBDIVISION: _____
SECTION: _____ LOT: _____
STREET ADDRESS: 6198 Montgomery Rd

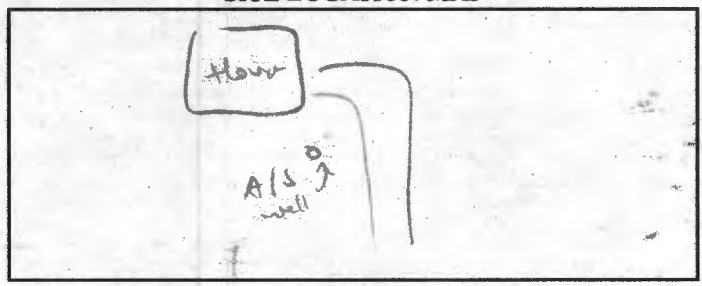

LATITUDE 39.213397

LONGITUDE 76.767328

pump stuck in well - could not be removed

* TYPE OF WELL BEING ABANDONED:
 DRILLED _____ JETTED _____
 BORED _____ HAND-DUG _____
 OTHER (specify) _____

* USE CODE:
 DOMESTIC _____ MUNICIPAL/PUBLIC _____
 IRRIGATION _____ INDUSTRIAL _____
 TEST/OBSERVATION _____ GEOTHERMAL _____

* TYPE OF CASING:
 STEEL _____ PLASTIC _____
 CONCRETE _____ OTHER (specify) _____

SIZE OF CASING: 4 INCHES IN DIAMETER

DEPTH OF WELL: 40 FEET DEEP

WAS ANY CASING REMOVED? YES NO
If yes, length removed, in feet: _____

WAS CASING RIPPED OR PERFORATED? YES NO

SIGNATURE-MASTER WELL DRILLER OR SUPERVISING SANITARIAN LICENSE# William Guizzardi 233

MWD / MSD / MGS 02/05/19
CIRCLE ONE DATE

COUNTY

LOG OF SEALING MATERIAL

MATERIAL	FEET	
	FROM	TO
Bentonite	40	6
Grout	6	3
VOLUME OF MATERIAL USED		
<u>Bentonite (20 BAGS), Grout (1 BAG)</u>		

Pursuant to §910-624 of the State Govt. Article of the Maryland Code, personal info requested on this form is used in processing this form pursuant to COMAR 26.04.04. Failure to provide the info may result in this form not being processed. You have the right to inspect, amend, or correct this form. The Maryland Department of the Environment is subject to the Maryland Public Information Act. This form may be made available on the Internet via MDE's website and is subject to inspection or copying, in whole or in part, by the public and other governmental agencies, if not protected by federal or State Law.