


Final 10/16

Approved for  
scope of work as  
described in letter

10/15/19  


September 17, 2019

Mr. Davis,

I am writing this letter to request a waiver of the Percolation Certification for the building permit requested for 7409 Oakcrest Lane In Clarksville. We have decided to not finish off the existing space of the house, but we are looking to only add the breezeway from the existing garage and the new garage addition. The existing garage would be used for additional storage space.

Seeing how the new garage addition to be built does not interfere with the septic easement of the house, we feel this should not be an issue with the current of future septic system.

Thank you,



Nicholas Dzubak



Bureau of Environmental Health

8930 Stanford Boulevard, Columbia, MD 21045

Main: 410-313-2640 | Fax: 410-313-2648

TDD 410-313-2323 | Toll Free 1-866-313-6300

www.hchealth.org

Facebook: www.facebook.com/hocohealth

Twitter: HowardCoHealthDep

Maura J. Rossman, M.D., Health Officer

SEWAGE DISPOSAL SYSTEM SPECIFICATIONS WORKSHEET

Address: 7409 Oakcrest Lane

Subdivision: Hopkins Mead Lot: 30

Table with 4 columns: Hole, Initial system, Application rate, Effective area beginning depth, Bottom maximum depth. Includes handwritten entries for Hole D, B, and A.

Design Flow = 150 gallons per day per bedroom

Design flow ÷ application rate = square footage of drainfield required

Linear length of trench required = drainfield square footage x sidewall reduction percentage ÷ trench width

Sidewall reduction credit formula:

(W + 2) / (W + 1 + 2D) x 100 = Percent of length of standard trench where W=trench width and D= depth between effective area beginning depth and trench bottom.

Standard design requirements:

- Trenches must be located to provide room for 3 systems in the disposal area
• All trenches must be equal length unless low pressure dosed
• All trenches must be on contour
• Minimum trench spacing: 10' for all trenches utilizing sidewall reduction credit.
• Minimum trench spacing for trenches with no sidewall credit (bottom area only) is 6' for a 2' wide trench and 9' for a 3' wide trench
• Maximum trench length is 100'
• Maximum pipe depth is 4' - Anything south of B gets 6' Max Bottom

Additional requirements:

- Avoid hole C as much as possible
- If 3 systems (Initial/Existing + 2 replacements) cannot fit within the Sewage disposal area (SDA) two systems (Initial/Existing + 1 Replacement) with a BAT Unit may be allowed. Health Dept. approval is required prior to.

Approved: Robert [Signature] Date: 1/28/19


MP 51962B

**A**  
 Bm  
 CLM  
 Strong rd  
 Sticky SiLL  
 Ribbons 2"  
 Rock 5%  
 6 1/2 -  
 71  
 Str rd  
 SiL - L  
 micaceous  
 Strong yellow  
 begins @  
 7 1/2'  
 sig structure  
 packets of  
 mica, silt  
 Bottom

**B**  
 dense rd  
 2 1/2" CL L  
 Rock 5%  
 Strong rd  
 SiL  
 micaceous  
 6'  
 corner  
 of dry  
 well

V. K. sample  
 No mottles  
 L. Sand  
 moist 15'  
 Bottom

**C**  
 org, rdbrn  
 SiLL  
 2 1/2 -  
 Strong  
 y. white  
 SiL  
 micaceous  
 various  
 colors  
 Bottom

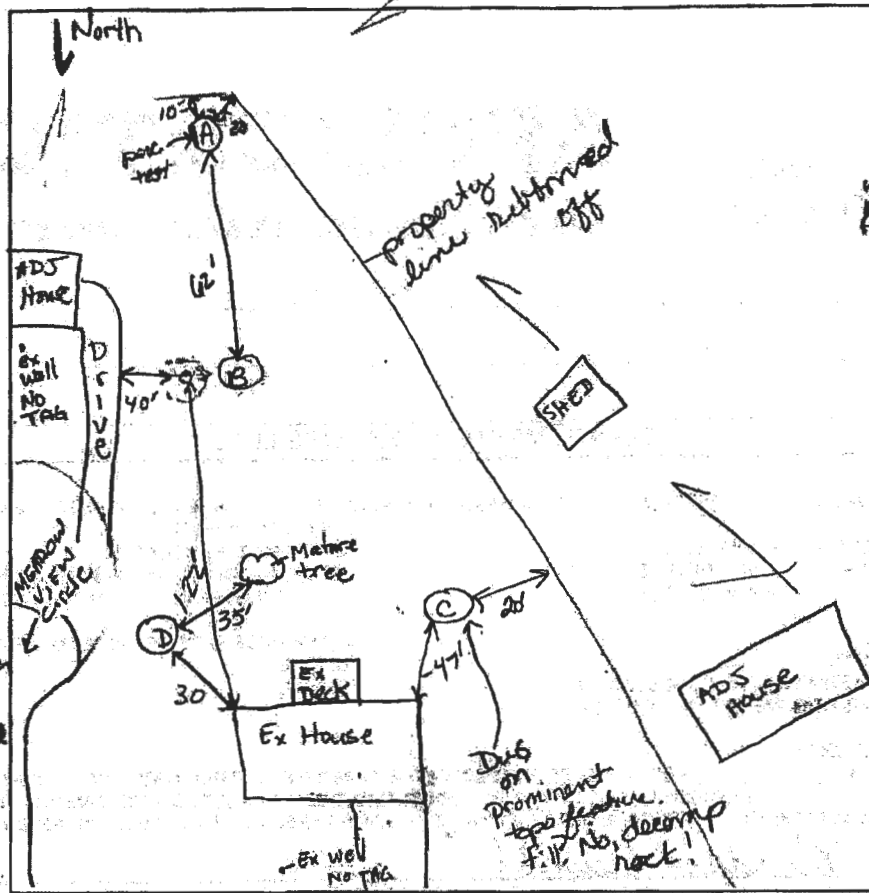

**C** Small  
 Strong rd  
 SiLL  
 Strong yellow  
 Strong rd  
 white  
 DK red/purple  
 Clumps  
 of decomposed  
 Rock - SiLL  
 breaks up  
 into 2mm-5mm  
 platy pieces  
 compacted  
 clumps

**D**

**D**

Oakcrest Ln

DATE	TEST #	DEPTH	START	BREAK 1" DROP	STOP 2" DROP	TIME OF 2nd INCH	P/F/H	
10/22/82	<b>A</b>	6 1/2' / 16'	10:22 <sup>30</sup>	10:26 <sup>15</sup>	10:31	4 min	H	
			Water coming in @ 16' No signs of saturation					
			@ 10:44 Cave in @ 12' due to saturation					
			@ 11:45 Cave in @ 10'					
	<b>B</b>	6 1/2' / 15'	11:01	11:10	11:20	10	P	
	<b>C</b>	6 1/2' / 11'	11:10	11:15	11:32	17	P	
	<b>D</b>	Visual	see hole B					P
			Hole <b>C</b> purposely dug on abnormal top feature. OTHER HOLES homogeneous					


REMARKS

SANITARIAN Kacie Norman BACKHOE Hatfields OTHERS \_\_\_\_\_

TEST HOLES USED IN SDA \_\_\_\_\_ AVG. PERC TIME ~10 SQ. FT/BR. 210

TRENCH WIDTH 2-3 INLET DEPTH 6 MAX BOT DEPTH 8 EFFECTIVE SAW 2

Low area 30' below perc hole  
 B-bottom @ 6' NO SIDEWALL USAGE.

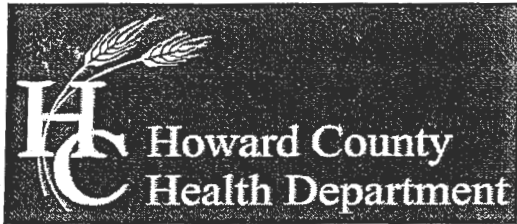

Bureau of Environmental Health

8930 Stanford Boulevard, Columbia, MD 21045
Main: 410-313-2640 | Fax: 410-313-2648
TDD 410-313-2323 | Toll Free 1-866-313-6300
www.hchealth.org

Facebook: www.facebook.com/hocohealth
Twitter: HowardCoHealthDep

Maura J. Rossman, M.D., Health Officer

SEWAGE DISPOSAL SYSTEM SPECIFICATIONS WORKSHEET

Address: 7409 Oakcrest Lane

Subdivision: Hopkins Mead Lot: 30

Table with 4 columns: Hole, Replacement type, Application rate, Effective area beginning depth, Bottom maximum depth. Includes handwritten entries for Hole D, Hole B, and Hole A.

Design Flow = 150 gallons per day per bedroom
Design flow ÷ application rate = square footage of drainfield required
Linear length of trench required = drainfield square footage x sidewall reduction percentage ÷ trench width

Sidewall reduction credit formula:

(W + 2) / (W + 1 + 2D) x 100 = Percent of length of standard trench where W=trench width and D= depth between effective area beginning depth and trench bottom.

Standard design requirements:

- Trenches must be located to provide room for 3 systems in the disposal area
All trenches must be equal length unless low pressure dosed
All trenches must be on contour
Minimum trench spacing: 10' for all trenches utilizing sidewall reduction credit. Additional spacing may be necessary for any trench using over 3.5' of effective sidewall. In those cases, the spacing formula is 2D +W up to a maximum spacing of 18'.
Minimum trench spacing for trenches with no sidewall credit (bottom area only) is 6' for a 2' wide trench and 9' for a 3' wide trench (spacing is measured edge to edge)
Maximum trench length is 100'
Maximum pipe depth is 4' - Anything south of B gets 6' Max Bottom

Additional requirements:

- Avoid hole C as much as possible
- If 3 systems (Initial/Existing + 2 replacements) cannot fit within the sewage disposal area (SDA) two systems, (Initial/Existing + 1 Replacement) with a BAT Unit may be allowed. Health Dept. approval is required prior to.

Approved: [Signature] Date: 1/28/19

SITE INSPECTION SHEET

OWNER: Cynthia Dzubak PHONE #: \_\_\_\_\_


ADDRESS: 7409 Oak Crest Lane CONTRACTOR: \_\_\_\_\_

WELL TAG #: None

SUBDIVISION: \_\_\_\_\_ LOT: 30 COUNTY #: \_\_\_\_\_

PROPOSAL: Construct new detached garage with breeze way connecting. Existing garage to be used for storage.

LOCATION DIAGRAM

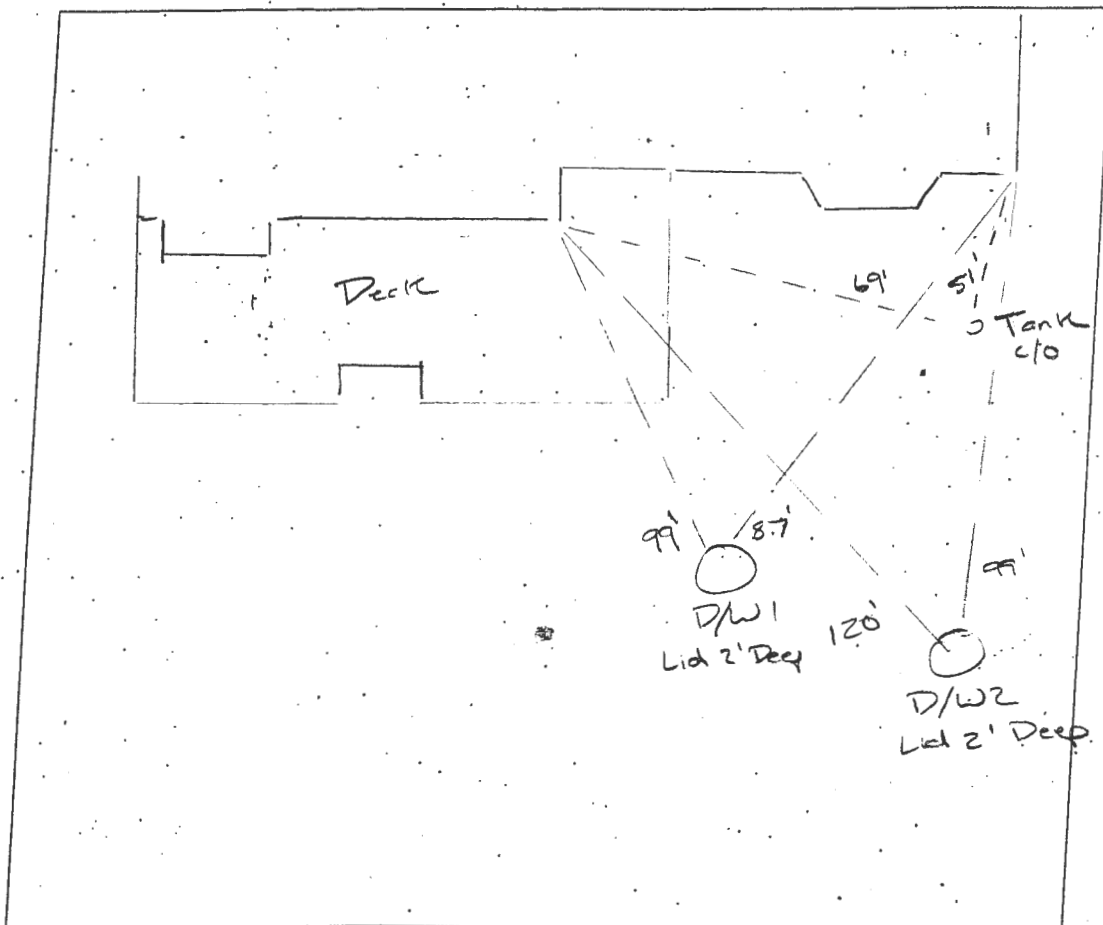

Inlet pipe depth 4.5' (Bottom of pipe)  
Lid 1.5' deep?  
3.5' to bottom of riser  
Liquid 4' 7" depth

COMMENTS: Septic seems to be functioning properly from surface. No signs of failure from surface. Well is in satisfactory condition. Two piece cap with no tabs. Well is 55' from right corner of house, when looking at the house. Well is 40' straight out from the house. Well has been gps. located.

DATE: 7/20/2019 INSPECTOR: RSF





Sent from my iPhone



# SHANABERGER & LANE

---

Surveying Land Planning Construction Stakeout

April 2, 2019

Mr. Robert "Spencer" Freemon  
Howard County Health Department  
8930 Stanford Blvd. Columbia, MD 21045  
Bureau of Environmental Health  
Well and Septic Program  
Phone: 410-313-6357  
[rfreemon@howardcountymd.gov](mailto:rfreemon@howardcountymd.gov)

re: Perc Certification Plat, 7409 Oakcrest Lane

Dear Mr. Freemon:

Thank you for agreeing to review this perc certification plat while we are awaiting the results of uncovering the existing septic system at 7409 Oakcrest Lane.

This letter is written in explanation of the accompanying perc certification plat.

7409 Oakcrest Lane is a residential property with an existing house, well, and septic system, as are the 2 neighboring properties 7405 and 7413 Oakcrest Lane. The existing well on 7405 Oakcrest Lane has a significant effect on reducing the available septic area on 7409 Oakcrest. Other limiting factors include a shallow water table at Perc Hole A at the low end of septic area, and a manmade graded outlet to allow the walkout basement on the house on 7409 Oakcrest.

The septic area shown on the perc certification plat respects the 100-foot well radius from the existing well on 7405 Oakcrest, and the required 10-foot setbacks to property line and 20 foot setback from the existing house foundation. There is 7,924 square feet of septic area available. If the grading for the walkout area is excluded, I do not believe there is enough available septic area to support 2 systems for a 5-bedroom house. Knowing this, I analyzed the drainage area to the graded walkout and find that it is between 0.12 and 0.13 acres, which is made up entirely of onsite runoff. There is no cross-site runoff; nor is this a traditional natural drainage course. Perc Test C was intentionally dug in the middle of the graded walkout to see what groundwater conditions existed, and it was dry at 14 feet.

For this reason, I have run some of the trenches for the initial system and replacement system across the graded walkout. I have also included 6 cross-sections showing all 6 trenches that will cross the graded walkout. I did not show the 14-foot depth of Perc Test C on the cross-section since it is so far below what is shown. I believe the depth from existing grade to stone, the lack of any natural drainage, and the 14-foot depth of Perc Test C indicate that the graded walkout will not compromise the intended function of the trenches crossing the graded walkout. I do recognize that avoiding the walkout with any trenches would be preferred, but I do not believe it is possible.

I began laying out the trenches from high to low, since the best soil is higher in the septic area and there is more sidewall available to assist with infiltration. Trenches at and below Perc Test B have no sidewall available at all.

The wells on 7405, 7409, and 7413 Oakcrest are all field-located, as is the septic tank cleanout on 7409. I was hoping to find the well on 7405 Oakcrest further away, but it is where it is. I do not believe the highest northwest corner of the septic area for 7409 Oakcrest is high enough to hydraulically upslope from the well on 7405 Oakcrest. My understanding of "hydraulically upslope" is half of the angle between a line directly uphill from the well, and a line of equal elevation to the well. There is also a slight drainage swale between the 2 lots.

I recognize that this is an imperfect situation and I expect to make some changes to this plat before it is (hopefully) approved. This is a first attempt, which I believe is needed to make some progress and to get some direction from the Health Department on which way to go. Please let me know if you need any further information from me, and feel free to call or email. Thank you.

Sincerely,




A handwritten signature in black ink, appearing to read "Gregory Scott Shanaberger".

G. Scott Shanaberger  
Professional L.S.

# PROFILE TRENCH I-A

SCALE: 1" = 10' HORIZ.

1" = 1' VERT.

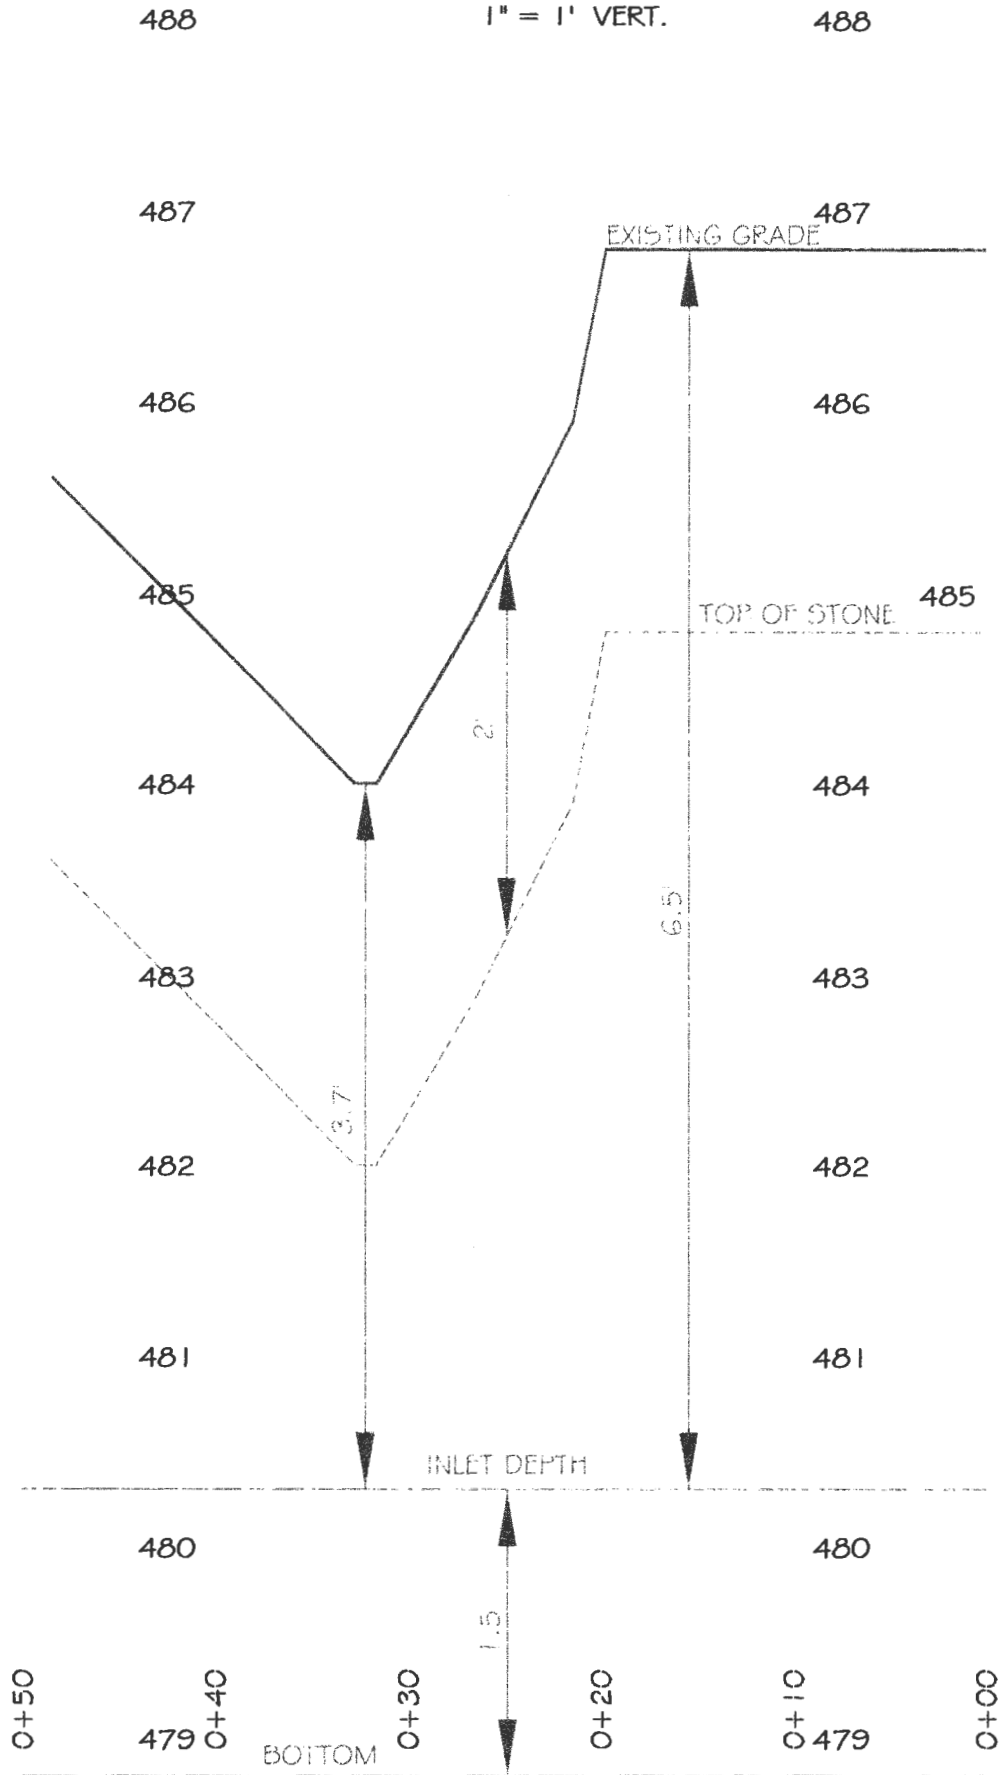

487

# PROFILE TRENCH 1-B

487

SCALE: 1" = 10' HORIZ.

1" = 1' VERT.

486

EXISTING GRADE

486

485

485

484

TOP OF STONE

484

483

483

482

482

481

481

480

480

479

PERC HOLE 'C' DRY AT 14' DEPTH HERE

479

478

BOTTOM

478

0+70

0+60  
477

0+50


0+40

0+30

0+20

0+10  
477

0+00

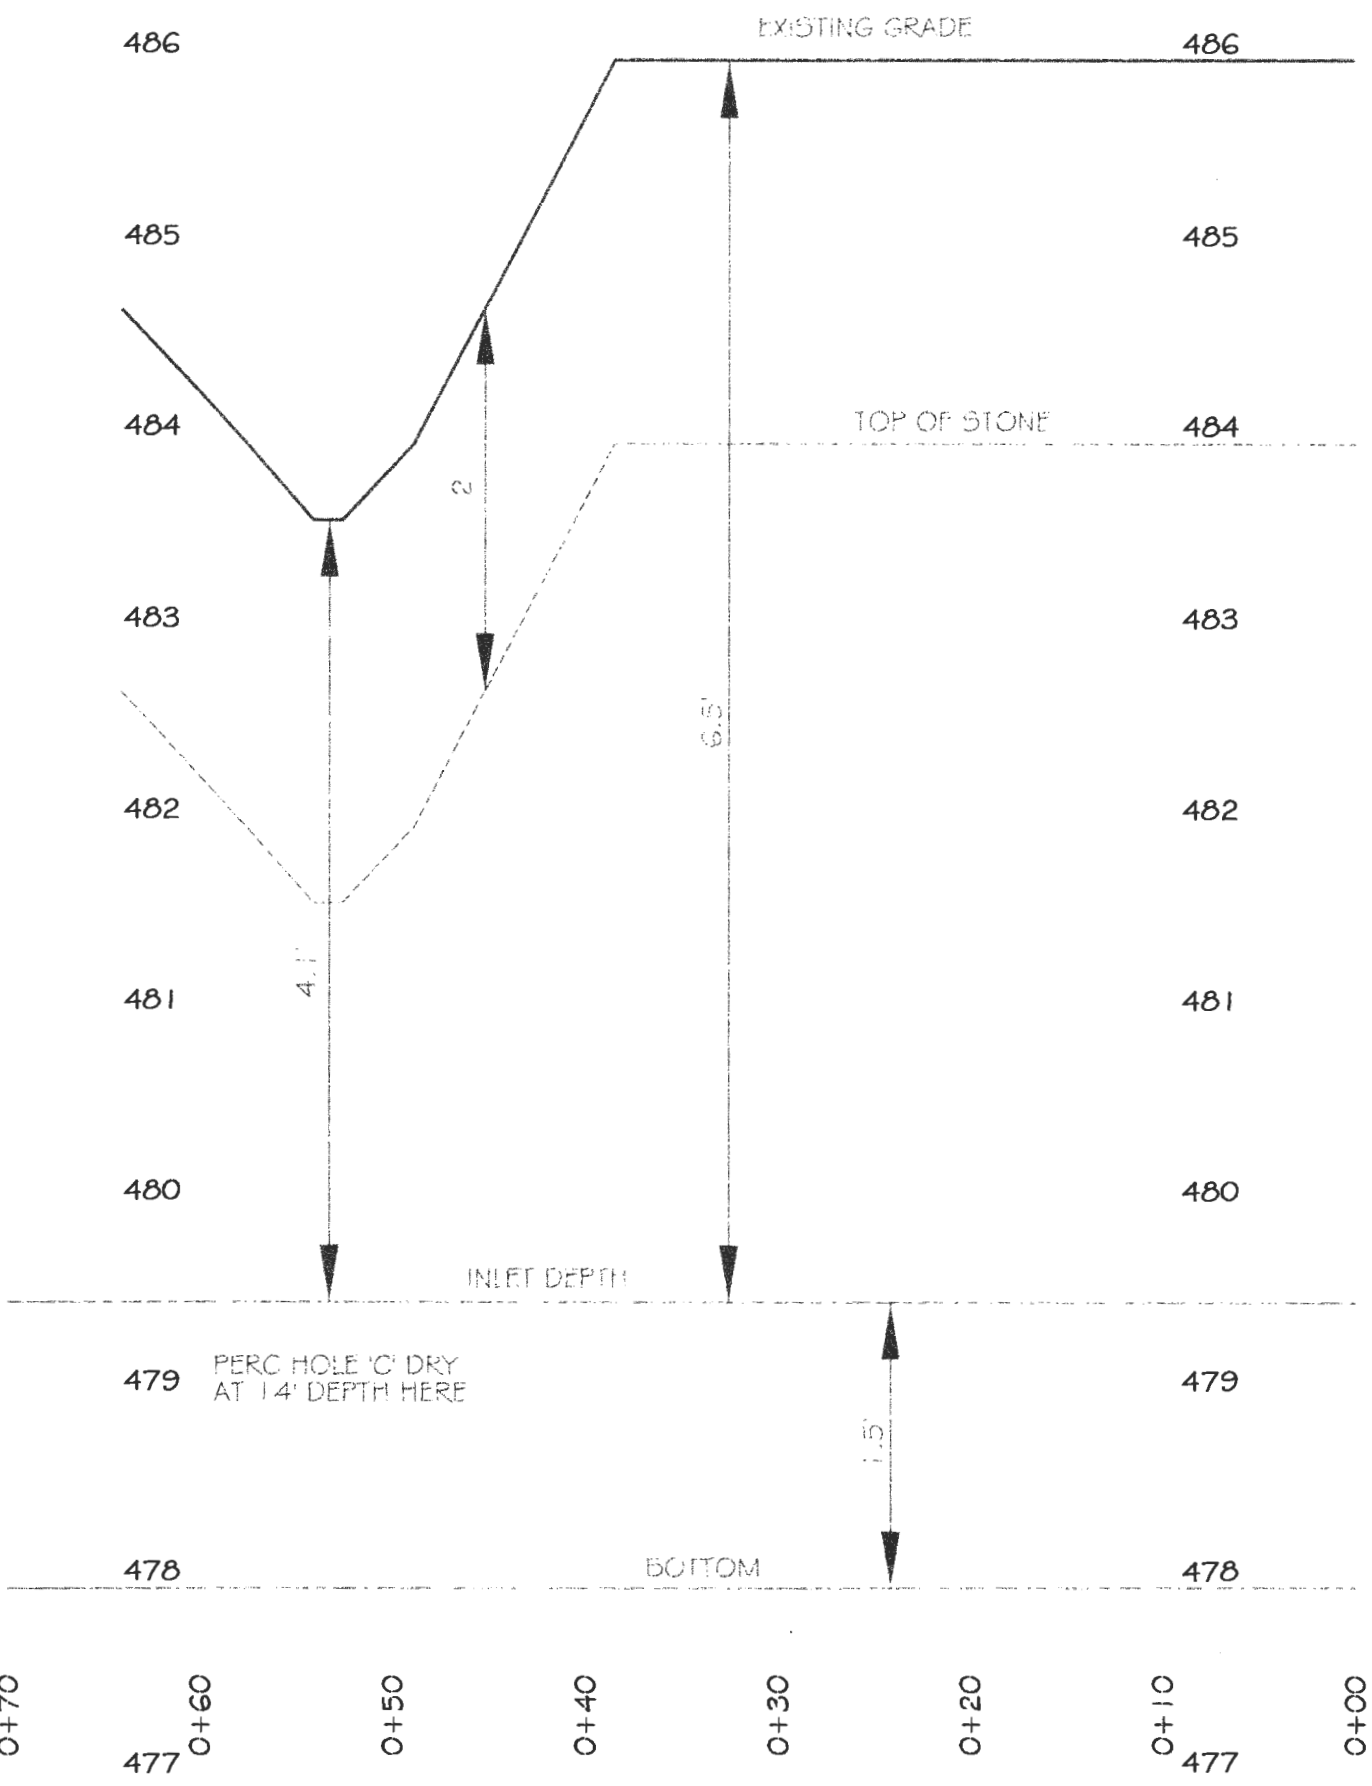

487

# PROFILE TRENCH 1C

487

SCALE: 1" = 10' HORIZ.

1" = 1' VERT.

486

486

EXISTING GRADE

485

485

484

484

TOP OF STONE

483

483

482

482

481

481

480

480

479

479

INLET DEPTH

478

478

BOTTOM


0+80  
 477 0+70  
 0+60  
 0+50  
 0+40  
 0+30  
 477 0+20  
 0+10

4.2'

2'

6.5'


1.5'

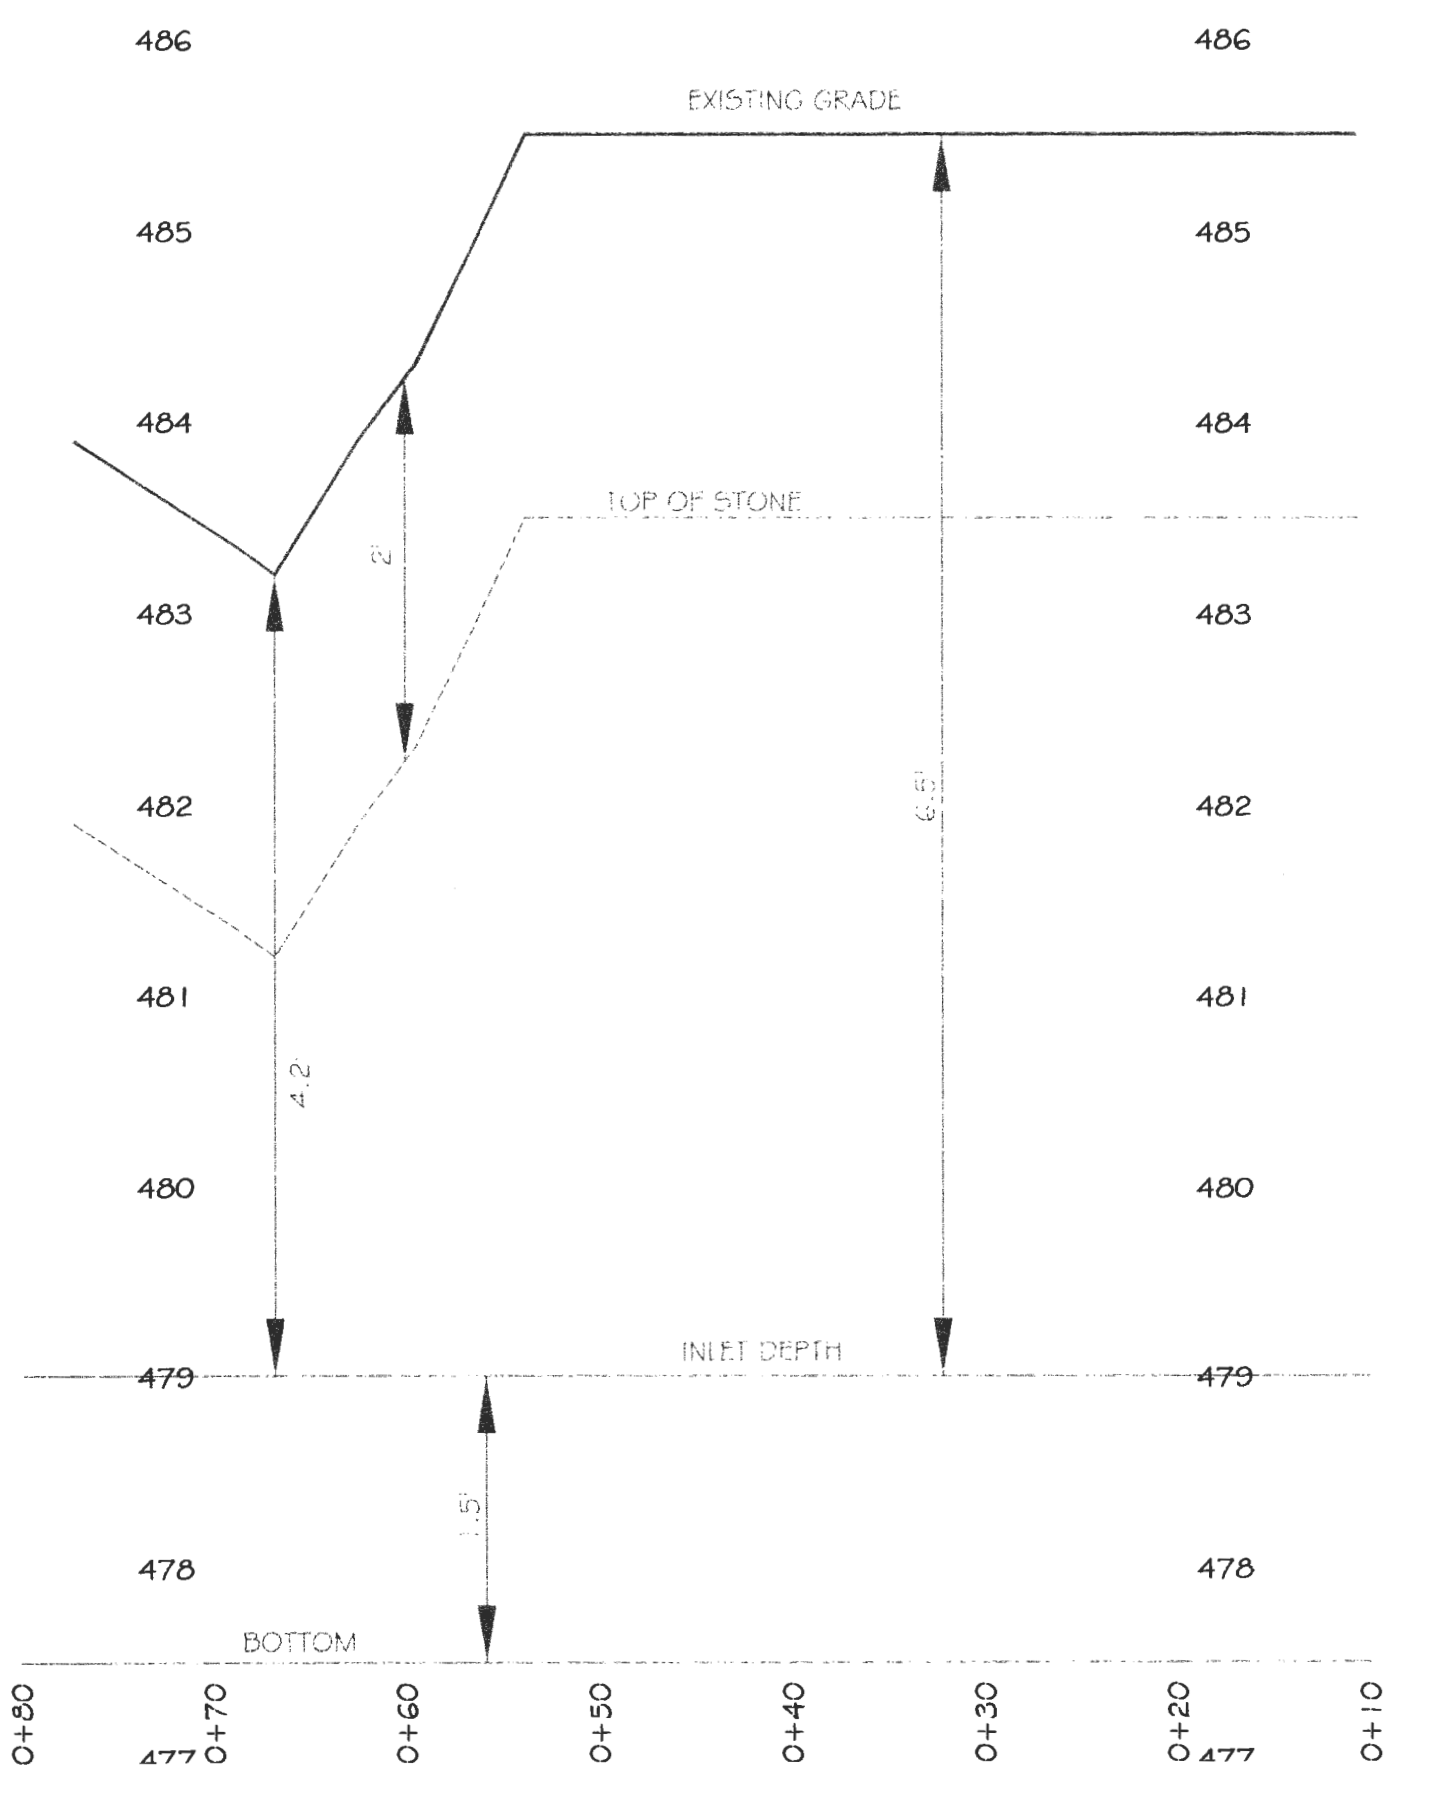

# PROFILE TRENCH R-A

SCALE: 1" = 10' HORIZ.

1" = 1' VERT.

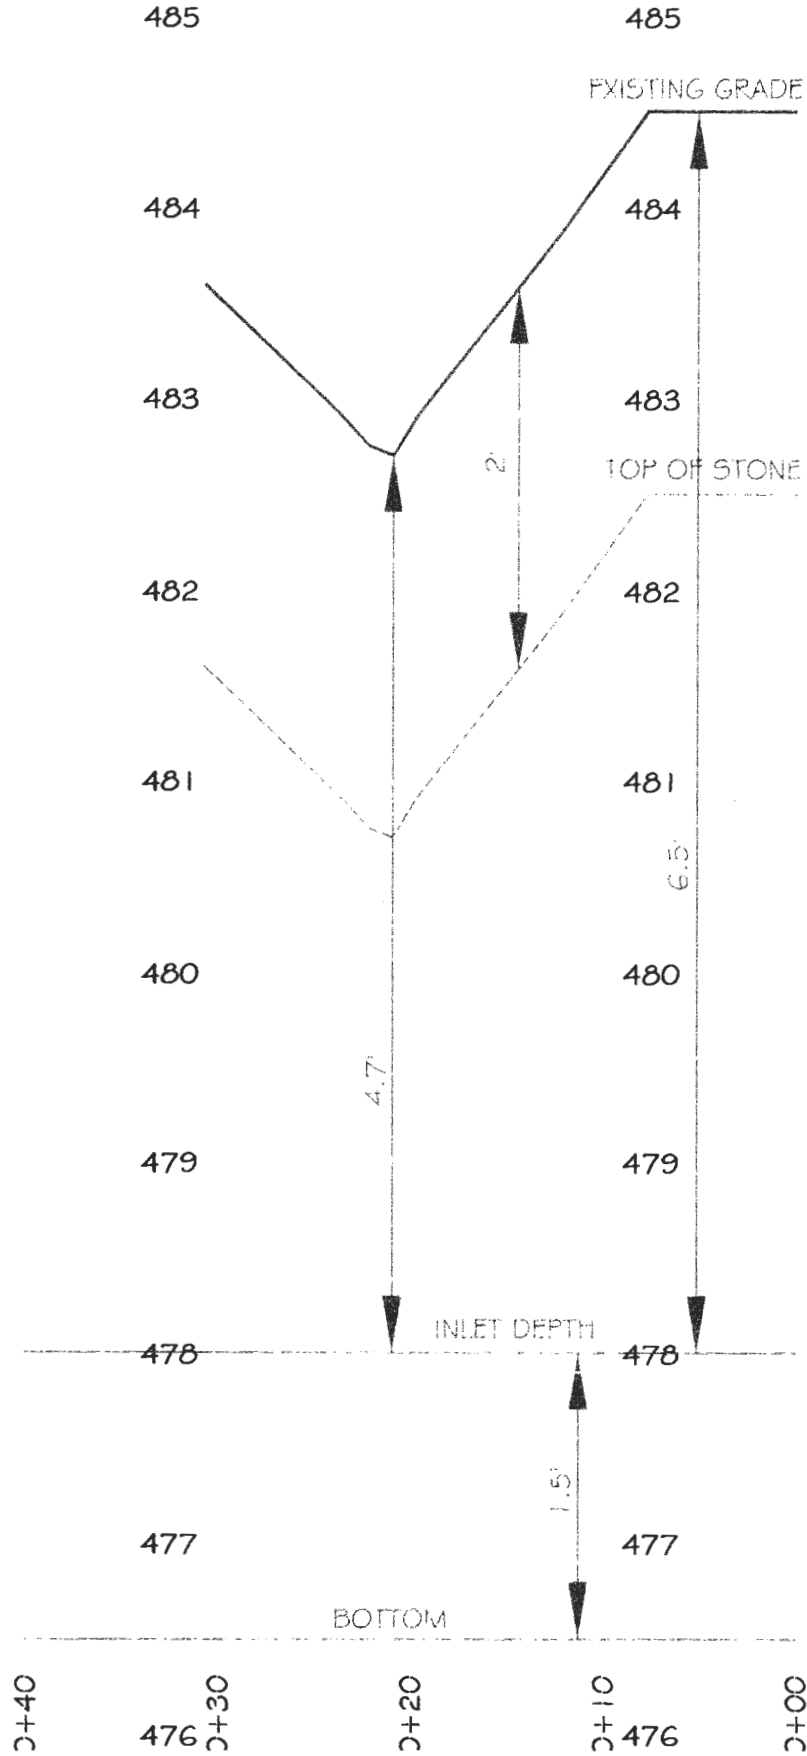

485

485

# PROFILE TRENCH R-B

SCALE: 1" = 10' HORIZ.

1" = 1' VERT.

484

484

EXISTING GRADE

483

483

2

482

482

TOP OF STONE

481

481

5.4'

6.5'

480

480

479

479

478

478

INLET DEPTH

477

477

1.5'

476

476

0+60

475

0+50

0+40


0+30

0+20

0+10

475


0+00

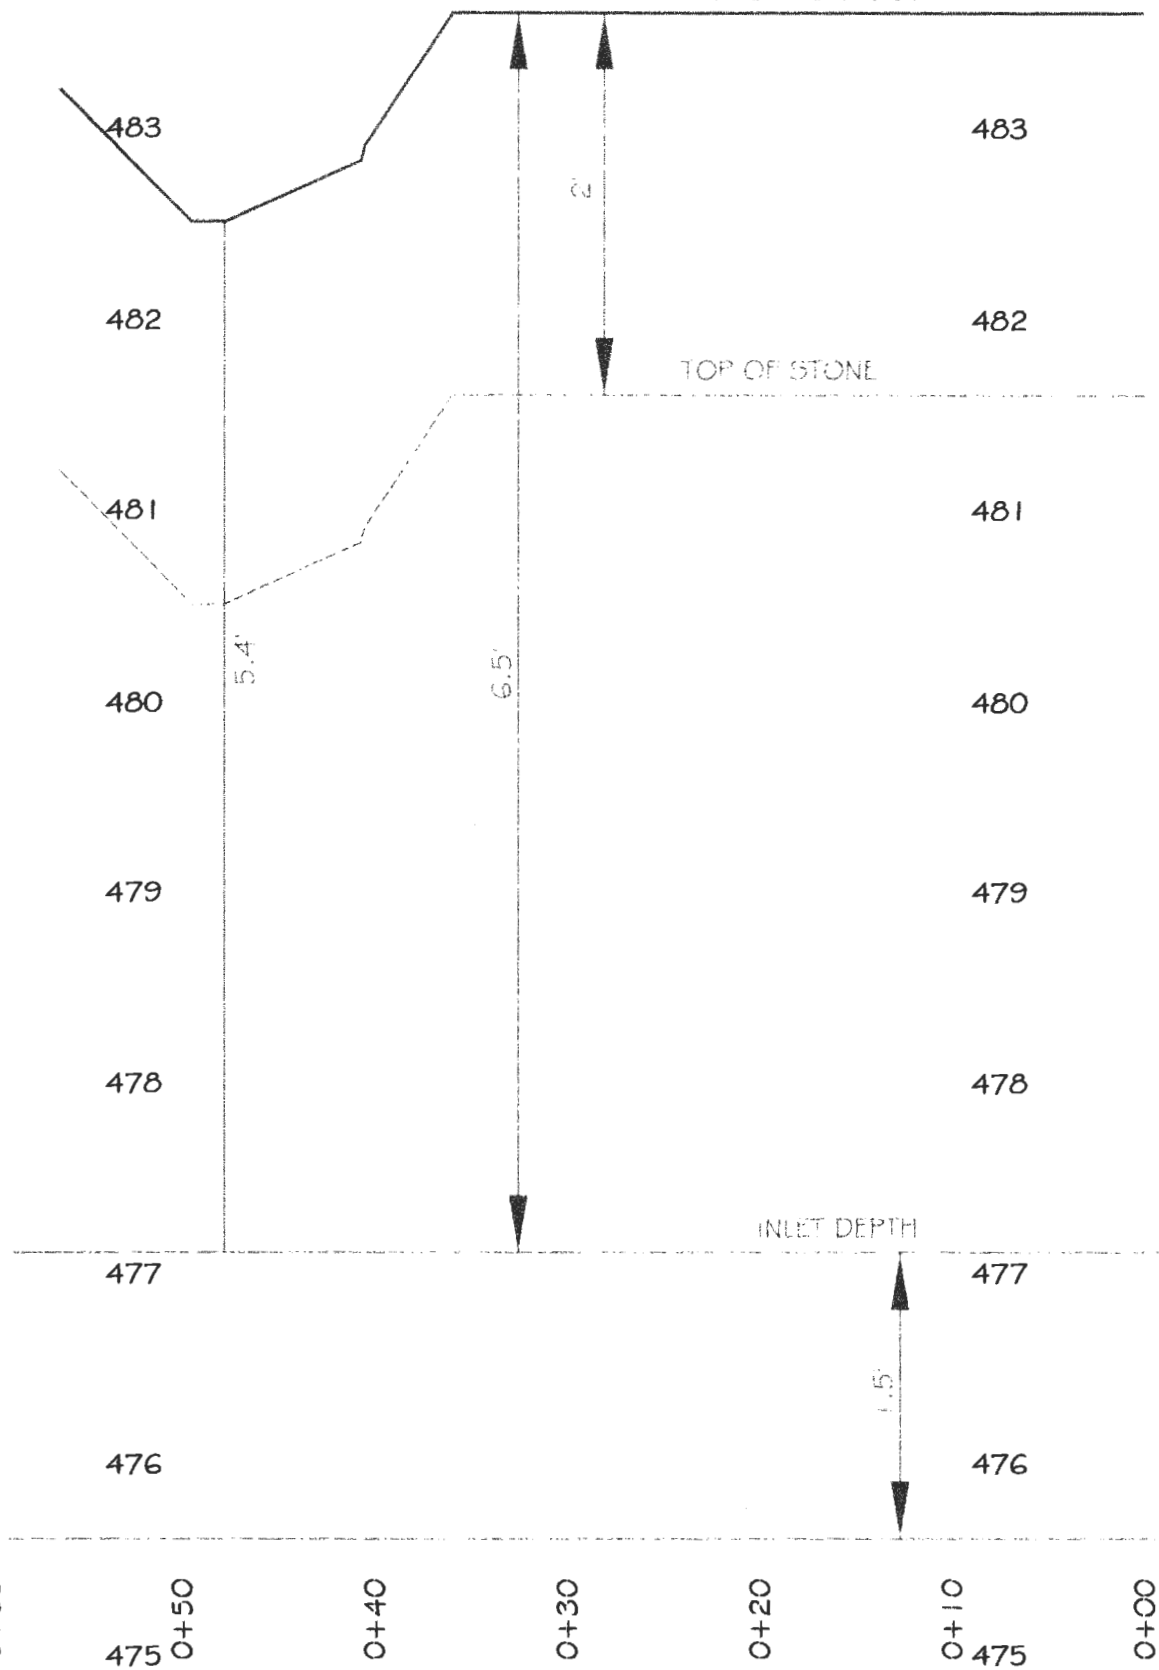

# PROFILE TRENCH R-C

SCALE: 1" = 10' HORIZ.

1" = 1' VERT.

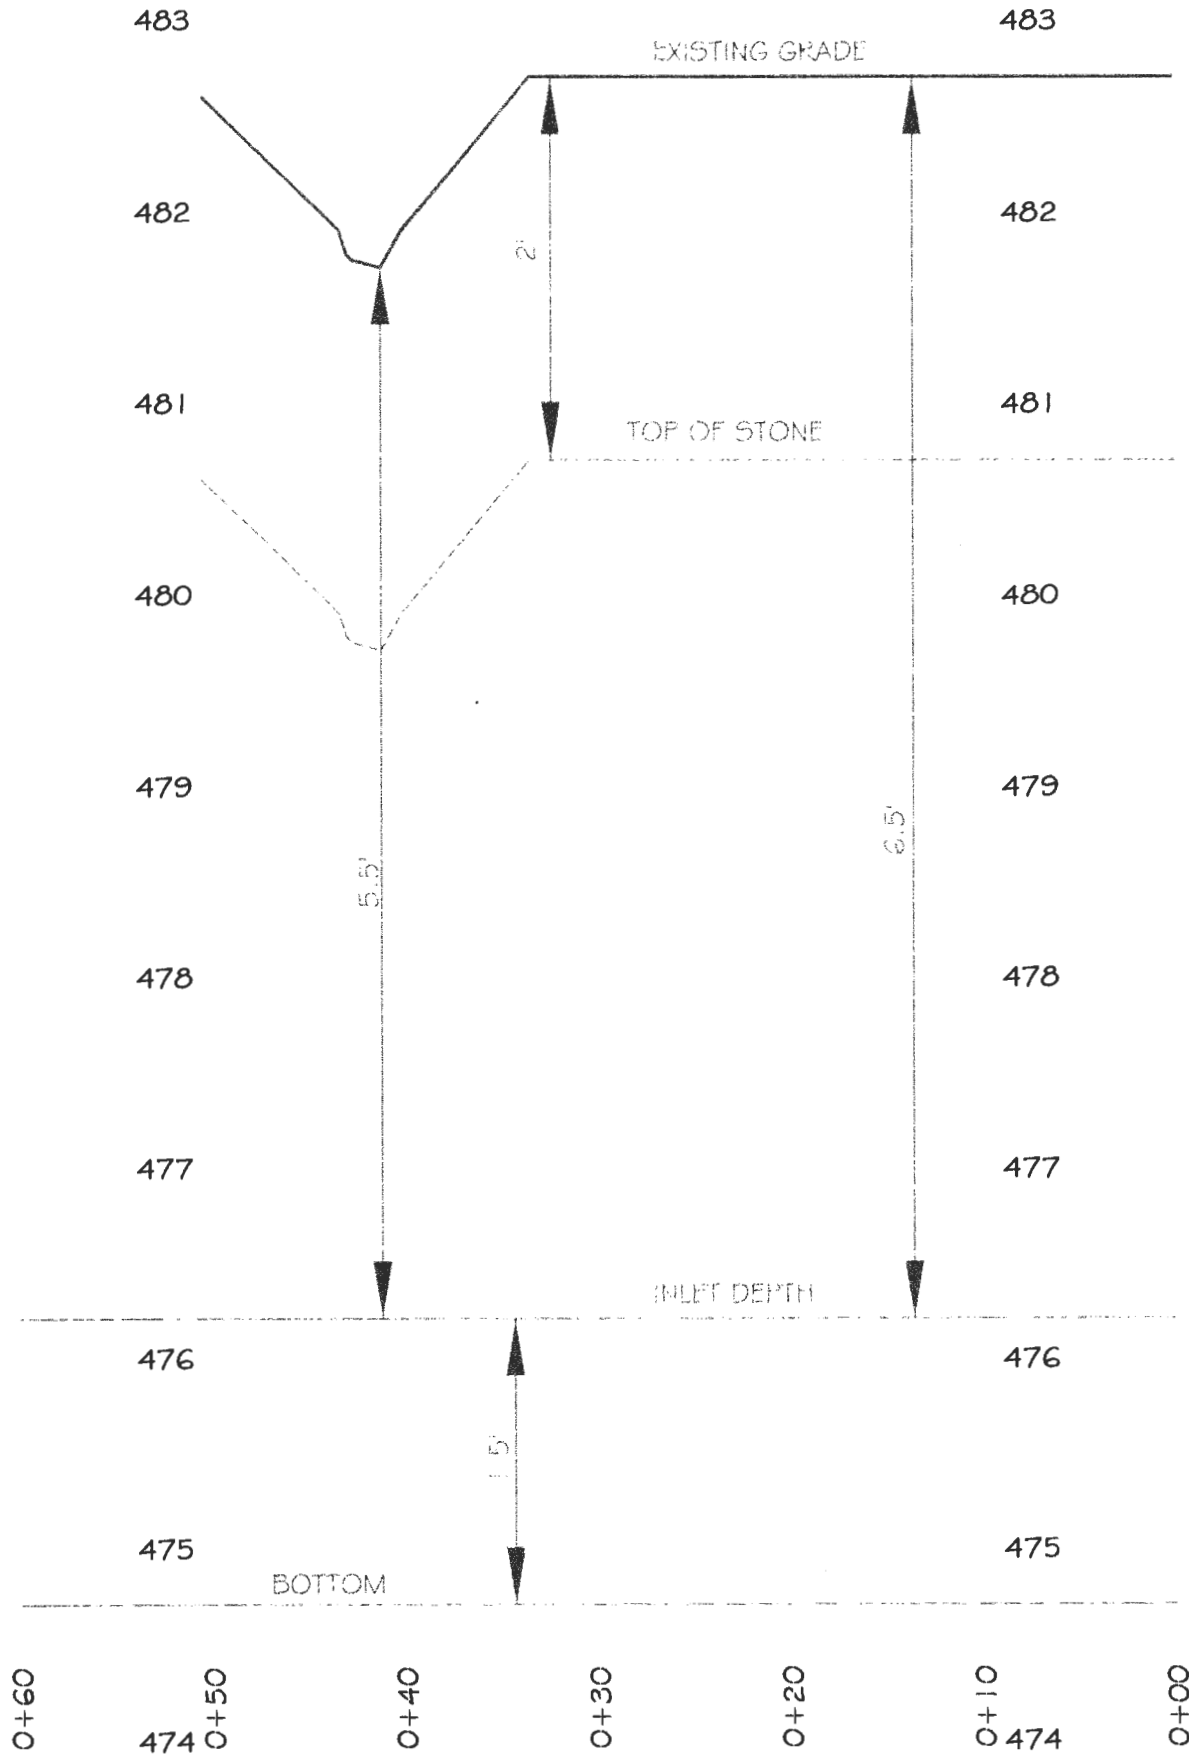

# SHANABERGER & LANE

Surveying

Land Planning

Construction Stakeout

8726 Town & Country Blvd., Suite 201  
Ellicott City, Md. 21043  
(410) 461-9563  
fax: (410) 461-9693  
home@shanlane.com

## **TRANSMITTAL**

DATE: 04/02/2019

FROM: G. Scott Shanaberger

TO: Bureau of Environmental Health

PROJECT: 7409 Oakcrest Lane

ATTENTION: Robert "Spencer" Freemon

**2 copies of Perc Certification Plan for initial review**  
**2 copies of six (6) sets of cross-sectional views of trenches.**  
**1 letter**

G. Scott Shanaberger


Received -----

Date -----

# PROFILE TRENCH I-A

SCALE: 1" = 10' HORIZ.

1" = 1' VERT.

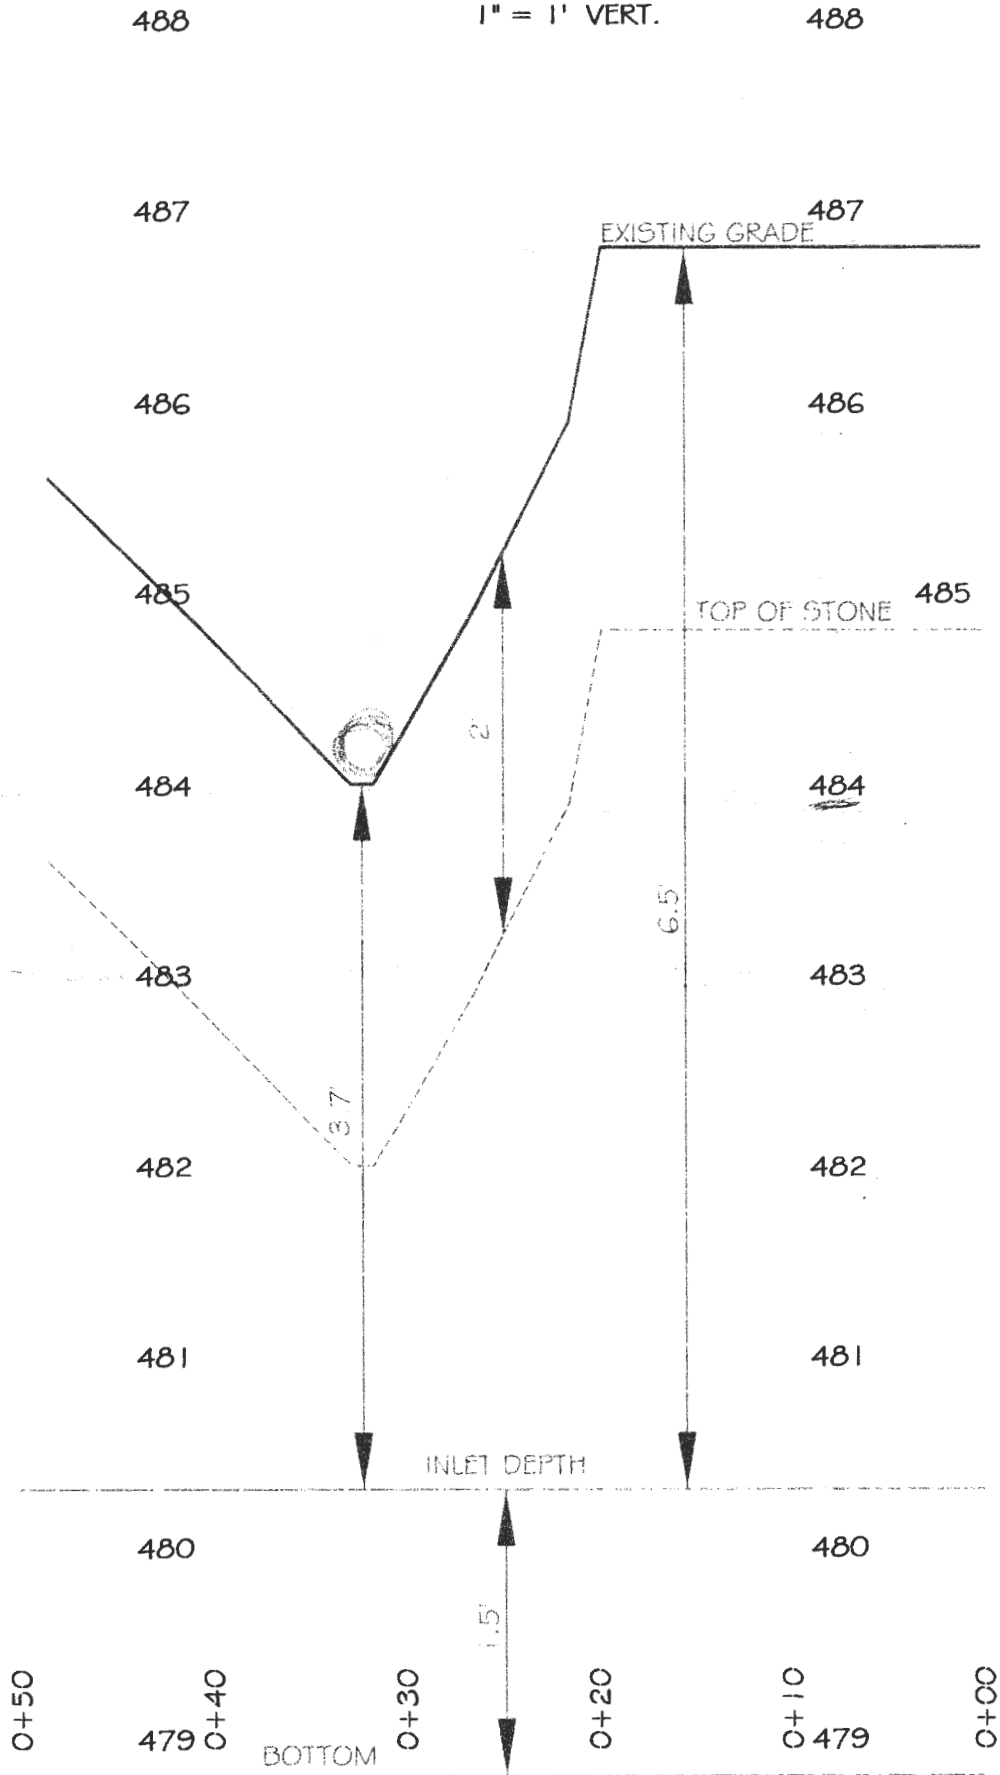

487

# PROFILE TRENCH 1-B

487

SCALE: 1" = 10' HORIZ.

1" = 1' VERT.

486

EXISTING GRADE

486

485

485

484

TOP OF STONE

484

483

483

482

482

481

481

480

480

479

PERC HOLE 'C' DRY AT 14' DEPTH HERE

479

478

BOTTOM

478

0+70

477

0+60

0+50

0+40


0+30

0+20

0+10

477

0+00

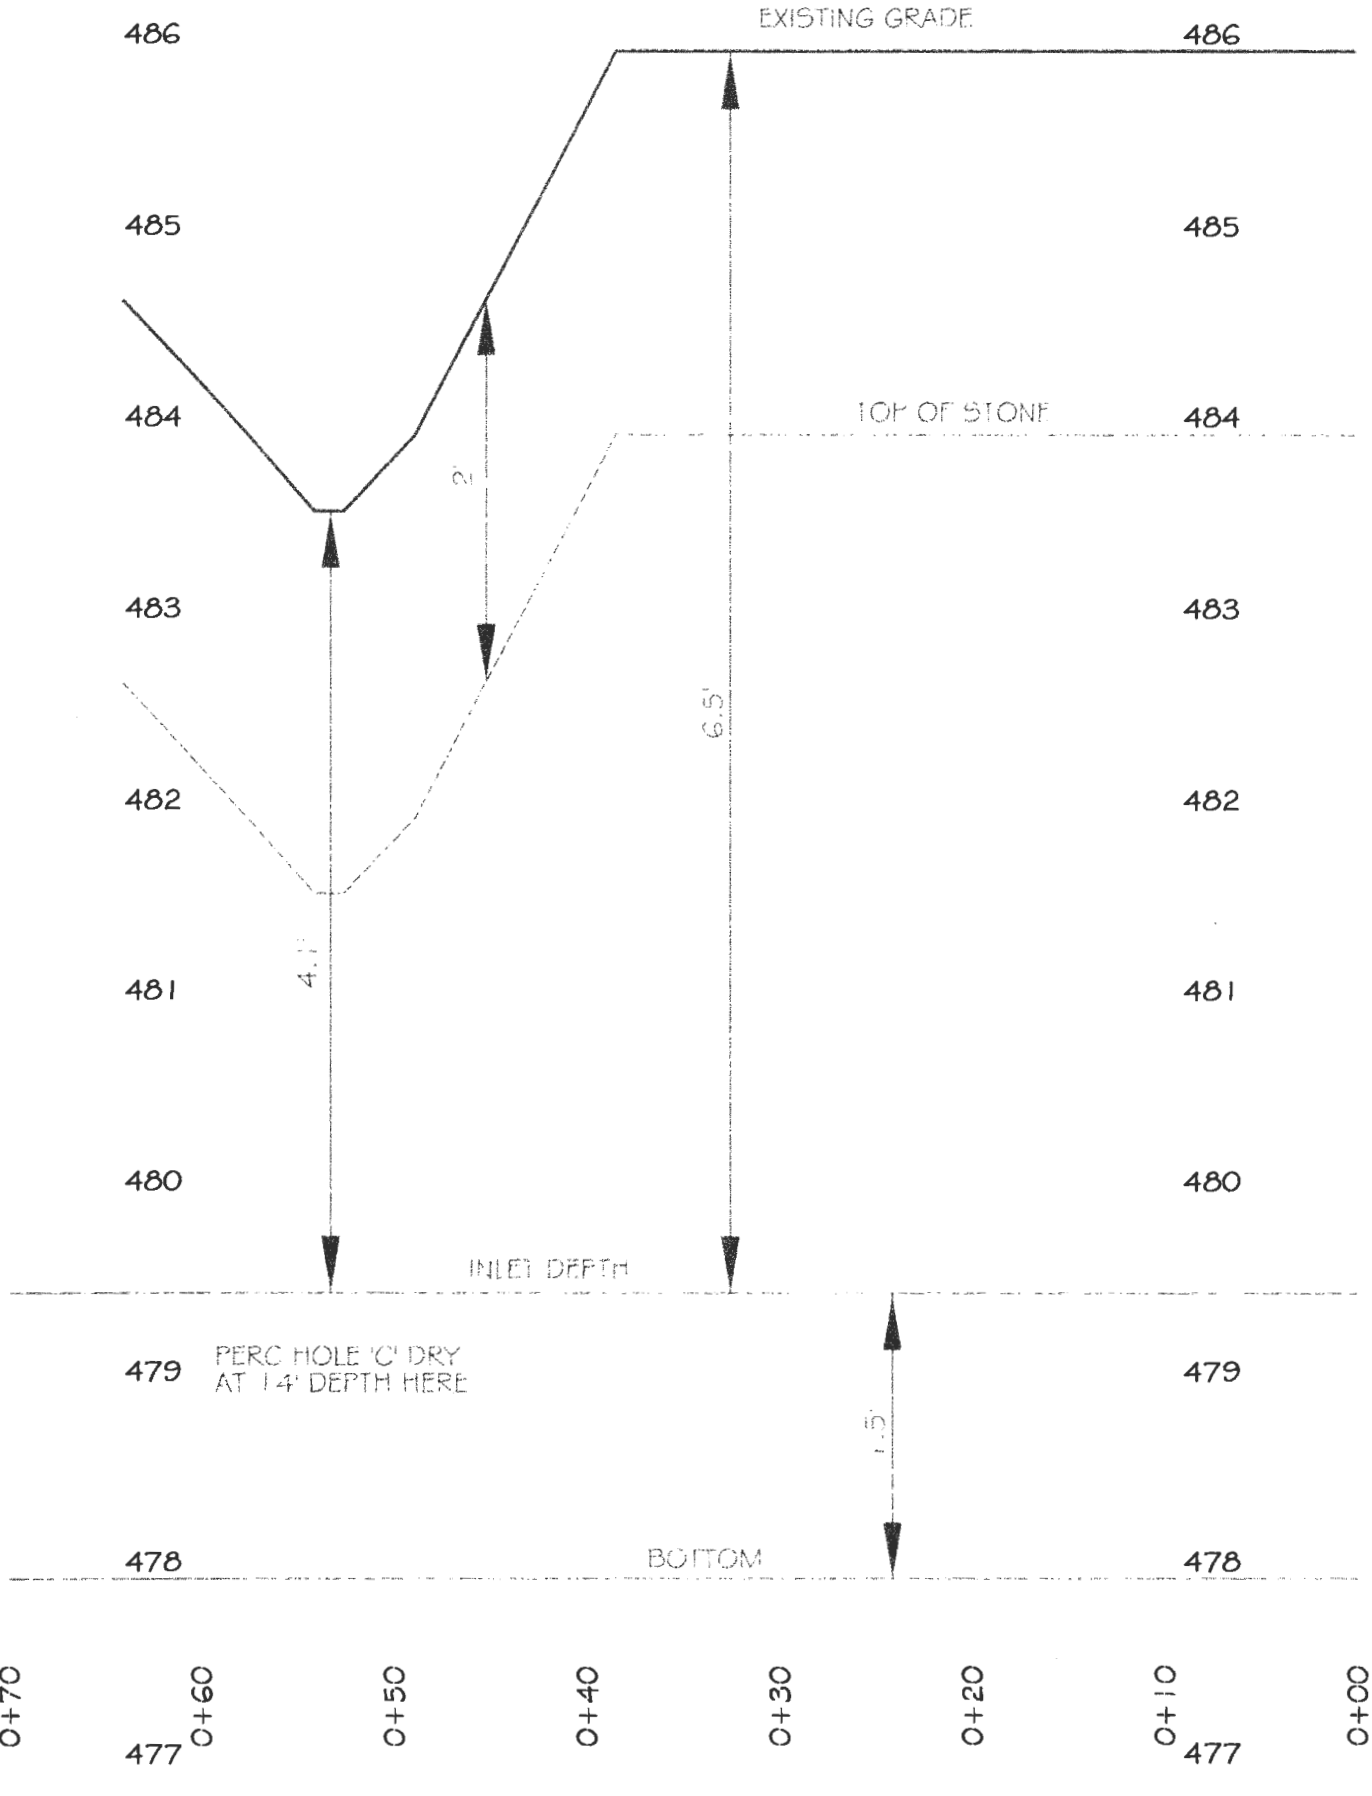

487

# PROFILE TRENCH 1C

487

SCALE: 1" = 10' HORIZ.

1" = 1' VERT.

486

486

EXISTING GRADE

485

485

484

484

TOP OF STONE

483

483

482

482

481

481

480

480

479

479

INLET DEPTH

478

478

BOTTOM

0+30

477 0+70

0+60


0+50

0+40

0+30

477 0+20


0+10

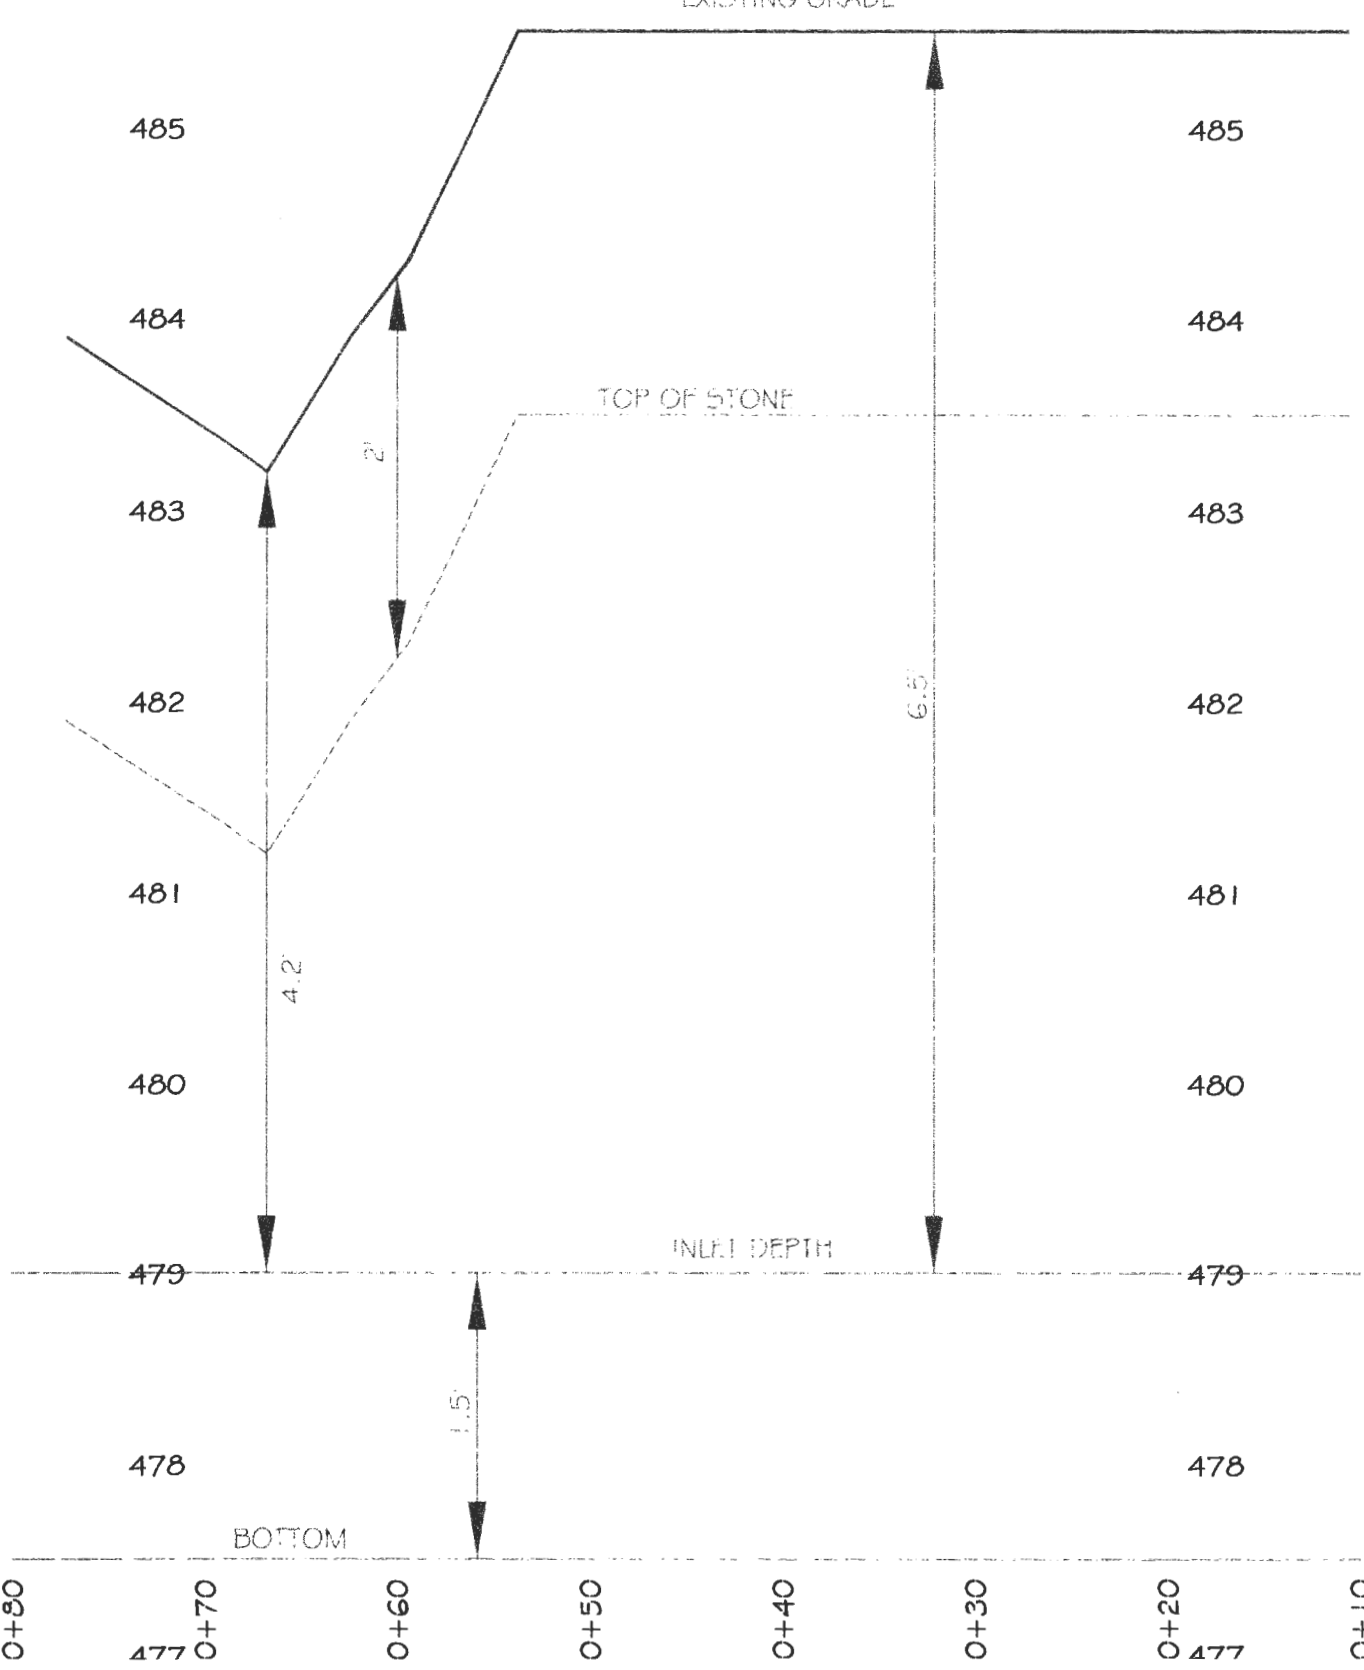

# PROFILE TRENCH R-A

SCALE: 1" = 10' HORIZ.

1" = 1' VERT.

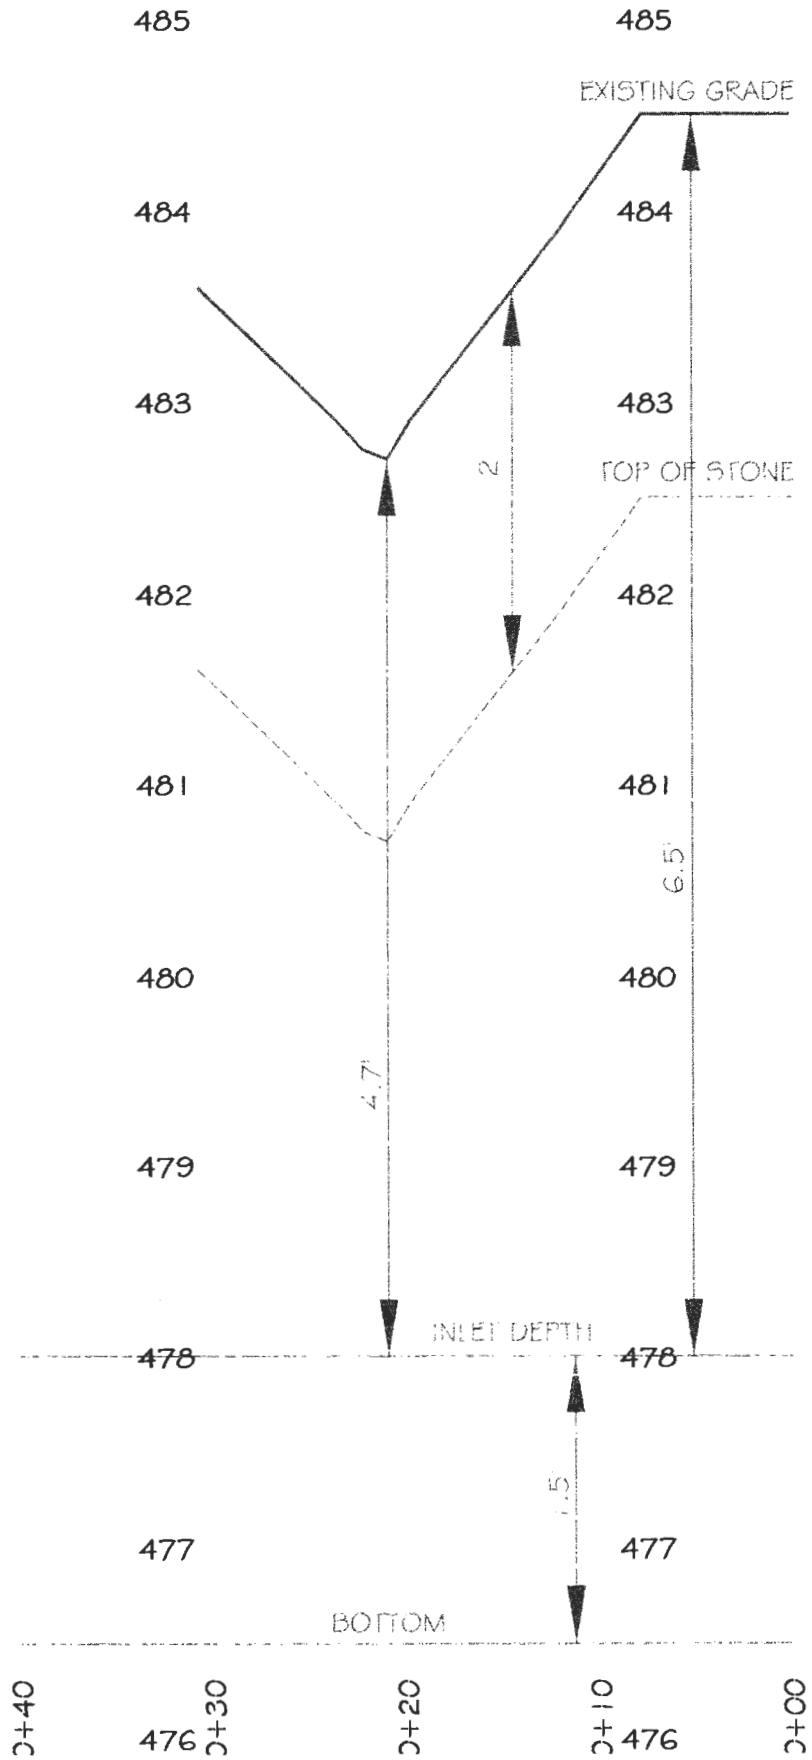

# PROFILE TRENCH R-B




SCALE: 1" = 10' HORIZ.

1" = 1' VERT.

484

484

EXISTING GRADE

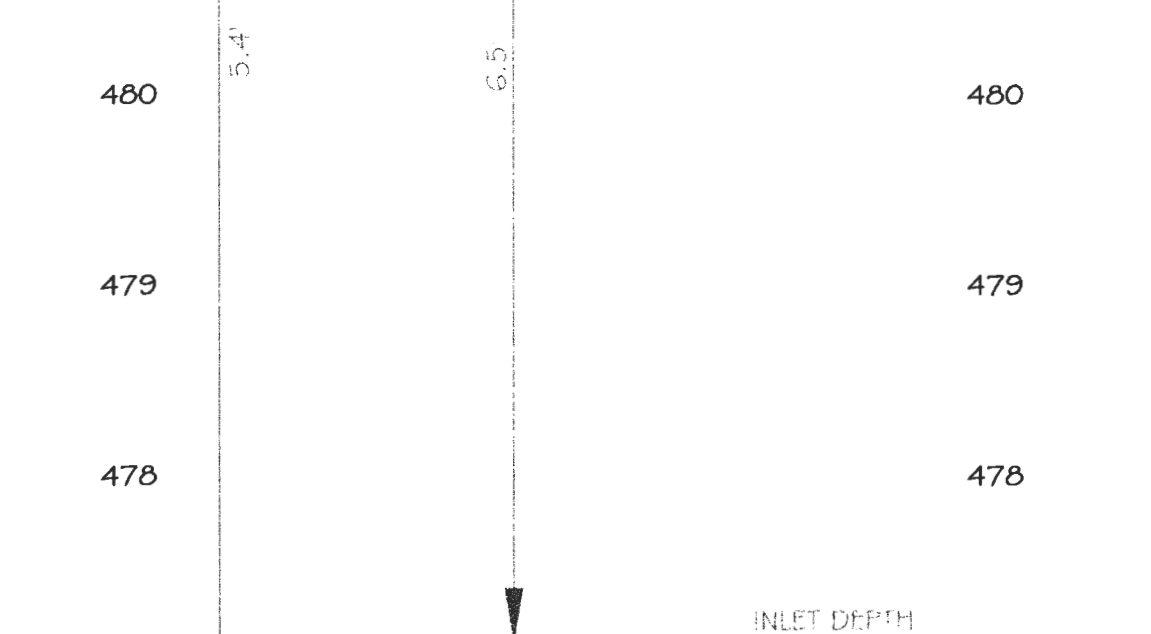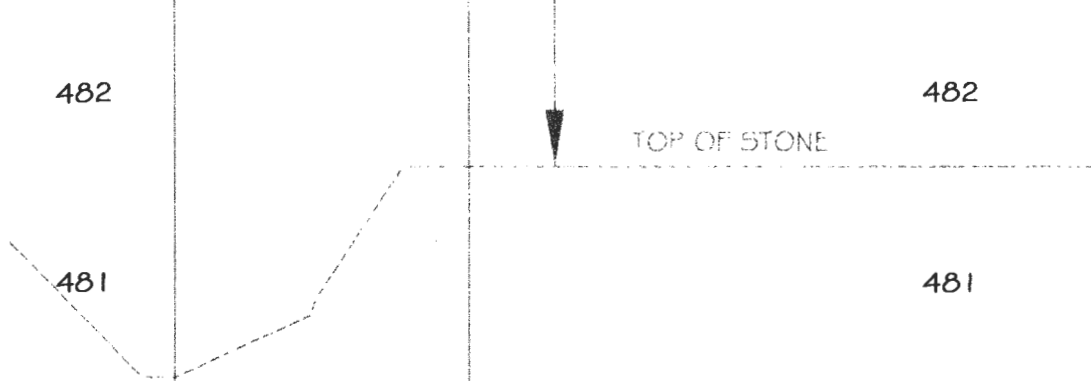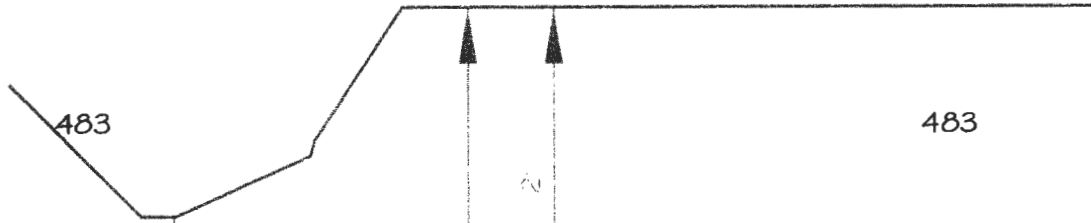

0+60

475 0+50

0+40

0+30

0+20


0+10 475

0+00

# PROFILE TRENCH R-C

SCALE: 1" = 10' HORIZ.

1" = 1' VERT.

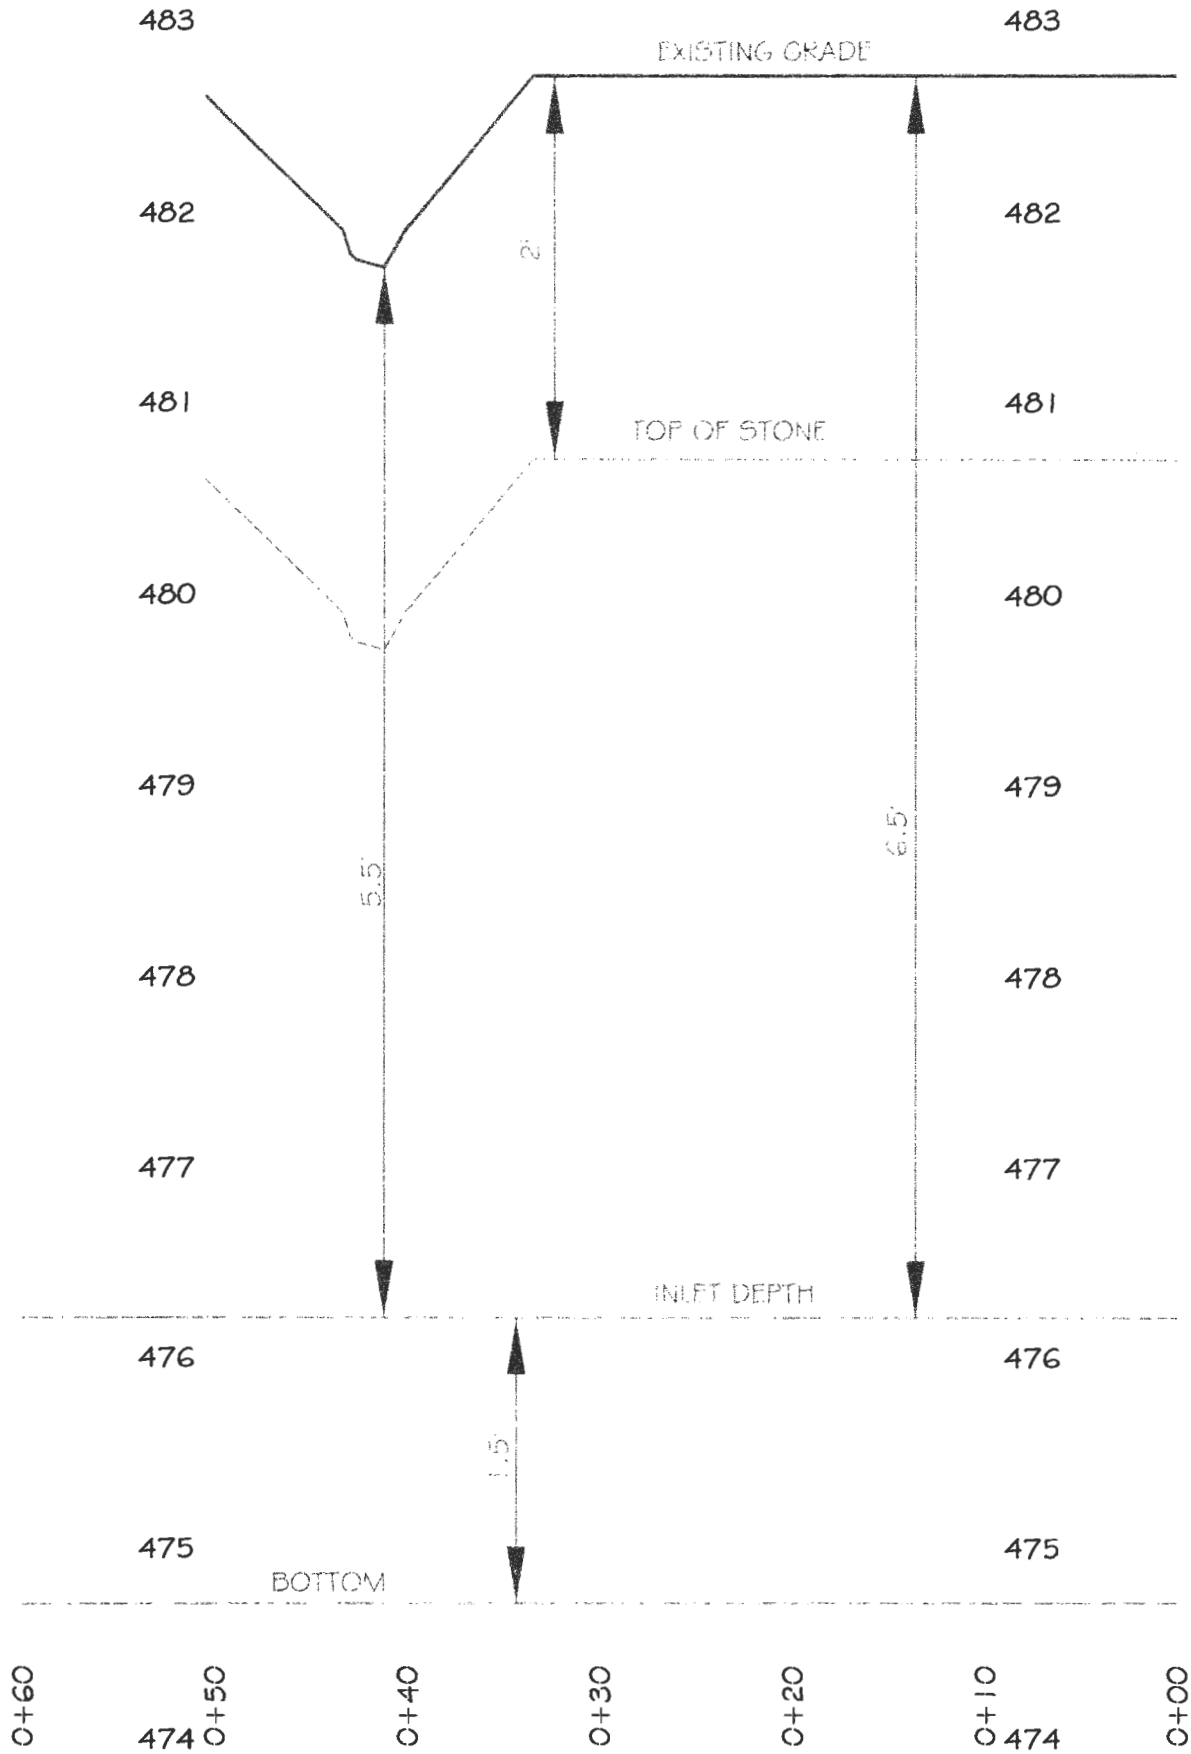

## Freemon, Robert

---

**From:** Robert Freemon <coastal4life@icloud.com>  
**Sent:** Thursday, May 09, 2019 1:51 PM  
**To:** Freemon, Robert  
**Subject:** Pics

[Note: This email originated from outside of the organization. Please only click on links or attachments if you know the sender.]





**NOTES:**

- THE PURPOSE OF THIS PLAT IS TO OBTAIN APPROVAL FOR A PRIVATE SEWAGE AREA TO ACCOMMODATE AN ADDITION TO THE HOUSE.
- TOPOGRAPHY SHOWN ON THIS LOT WAS FIELD RUN BY SHANABERGER & LANE IN JANUARY, 2019, ON THE NAVD83 SYSTEM, USING HOWARD COUNTY TRAVERSE POINT 41 EB, ELEVATION 463.78. TOPOGRAPHY ON SURROUNDING PROPERTIES IS FROM 2013 HOWARD COUNTY LIDAR.
- BOUNDARY LINES ON THIS PLAT ARE FROM PLAT BOOK 7, FOLIO 85, AND FROM PROPERTY CORNER LOCATIONS BY SHANABERGER & LANE IN JANUARY, 2019. BOUNDARY LINES SHOWN HEREON DO NOT REPRESENT A BOUNDARY SURVEY BY SHANABERGER & LANE.
- ONSITE IMPROVEMENTS WITHIN THE LIMITS OF FIELD RUN TOPOGRAPHY WERE LOCATED BY SHANABERGER & LANE IN JANUARY, 2019. OTHER IMPROVEMENTS SHOWN ARE FROM 2013 HOWARD COUNTY LIDAR. SOME ONSITE WELL AND SEPTIC SYSTEM COMPONENTS, AND 2 OFFSITE WELLS WERE FIELD-LOCATED IN JANUARY, 2019.
- OTHER EXISTING WELL AND SEPTIC SYSTEM LOCATIONS SHOWN HEREON ARE FROM AVAILABLE HOWARD COUNTY HEALTH DEPARTMENT RECORDS.

- FUTURE WELL
  - EXISTING WELL
  - SOIL TYPE BOUNDARY
  - WOODSLINE/TREES
  - SUCCESSFUL PERC TEST
  - FAILED PERC TEST

- SOIL TYPES PER N.R.C.S WEB SOIL SURVEY:
  - GaC-Galla loam, 8 to 15 percent slopes
  - GhB-Glenide-Urban land complex, 0 to 8 percent slopes

- DESIGNATES LIMITS OF FIELD-RUN TOPOGRAPHY

- ANY CHANGE TO A PRIVATE SEWAGE AREA SHALL REQUIRE A REVISED PERC CERTIFICATION PLAN.

- ALL KNOWN EXISTING WELLS AND SEWAGE DISPOSAL AREAS WITHIN 100' OF THE PROPERTY AND WELLS WITHIN 200' DOWNSLOPE OF THE PROPOSED SDA HAVE BEEN SHOWN PER FIELD LOCATION WHEN POSSIBLE AND PER AVAILABLE RECORDS WHEN NOT POSSIBLE.

- THIS AREA DESIGNATES A PRIVATE SEWAGE AREA TO ACCOMMODATE 2 SYSTEMS AS REQUIRED BY THE MARYLAND STATE DEPARTMENT OF THE ENVIRONMENT FOR INDIVIDUAL SEWAGE DISPOSAL (COMAR 26.04.03). IMPROVEMENTS OF ANY NATURE IN THIS AREA ARE RESTRICTED UNTIL PUBLIC SEWERAGE IS AVAILABLE. THESE AREAS SHALL BECOME NULL AND VOID UPON CONNECTION TO A PUBLIC SEWERAGE SYSTEM. THE COUNTY HEALTH OFFICER SHALL HAVE THE AUTHORITY TO GRANT ADJUSTMENTS TO THE PRIVATE SEWAGE AREA. RECORDATION OF A MODIFIED SEWAGE AREA SHALL NOT BE NECESSARY.

- THE LOT SHOWN HEREON COMPLIES WITH THE MINIMUM OWNERSHIP WIDTH AND LOT AREA AS REQUIRED BY THE MARYLAND DEPARTMENT OF THE ENVIRONMENT.

- A BAT TANK WILL BE REQUIRED FOR NEW SEPTIC SYSTEM.

- A LOW-PRESSURE DOSAGE SYSTEM WILL BE REQUIRED DUE TO UNEQUAL TRENCH LENGTHS.

**SEPTIC SYSTEM TRENCH DESIGN SPECIFICATIONS**

<p><b>INITIAL SYSTEM:</b></p> <ul style="list-style-type: none"> <li>- APPLICATION RATE: 0.8</li> <li>- EFFECTIVE AREA BEGINNING DEPTH: 6.5'</li> <li>- BOTTOM MAXIMUM DEPTH: 8'</li> </ul>	<p><b>REPLACEMENT SYSTEM #1:</b></p> <ul style="list-style-type: none"> <li>- APPLICATION RATE: 0.8</li> <li>- EFFECTIVE AREA BEGINNING DEPTH: 4'</li> <li>- BOTTOM MAXIMUM DEPTH: 8'</li> </ul>	
<p><b>1. DESIGN FLOW:</b></p> <ul style="list-style-type: none"> <li>- 5 BEDROOMS AT 150 GAL/DAY</li> <li>- 5 X 150 GPD = 750 GPD</li> </ul>	<p><b>1. DESIGN FLOW:</b></p> <ul style="list-style-type: none"> <li>- 5 BEDROOMS AT 150 GAL/DAY</li> <li>- 5 X 150 GPD = 750 GPD</li> </ul>	
<p><b>2. SQUARE FOOTAGE OF DRAIN FIELD REQUIRED:</b></p> <ul style="list-style-type: none"> <li>- DESIGN FLOW (750 GPD) / APPLICATION RATE (0.8) = 937.5 SF</li> </ul>	<p><b>2. SQUARE FOOTAGE OF DRAIN FIELD REQUIRED:</b></p> <ul style="list-style-type: none"> <li>- DESIGN FLOW (750 GPD) / APPLICATION RATE (0.8) = 937.5 SF</li> </ul>	
<p><b>3. SIDEWALL REDUCTION CREDIT:</b></p> <ul style="list-style-type: none"> <li>- TRENCH WIDTH (W) = 3'</li> <li>- TRENCH EFFECTIVE DEPTH (D) = 1.5'</li> <li>- <math>(W+2) / (W+1+2D) \times 100 = 71.43\% = 0.7143</math></li> </ul>	<p><b>3. SIDEWALL REDUCTION CREDIT: (TRENCHES R-A, R-B, R-C, R-D)</b></p> <ul style="list-style-type: none"> <li>- TRENCH WIDTH (W) = 3'</li> <li>- TRENCH EFFECTIVE DEPTH (D) = 1.5'</li> <li>- <math>(W+2) / (W+1+2D) \times 100 = 71.43\% = 0.7143</math></li> <li>- NO SIDEWALL REDUCTION CREDIT FOR TRENCHES R-E, R-F</li> </ul>	
<p><b>4. LINEAR LENGTH OF TRENCH REQUIRED:</b></p> <ul style="list-style-type: none"> <li>- DRAIN FIELD SQUARE FOOTAGE (937.5) X SIDEWALL REDUCTION CREDIT (0.7143) / TRENCH WIDTH (3') = 223.2 LF</li> </ul>	<p><b>4. LINEAR LENGTH OF TRENCH REQUIRED: VARIES</b></p> <ul style="list-style-type: none"> <li>- LINEAR LENGTH OF TRENCH PROVIDED: 223.2 LF</li> <li>- 4 TRENCHES, LENGTHS 48.5', 64.1', 77.2', 33.4'</li> </ul>	
<p><b>6. EXISTING GRADE</b></p> <table border="1"> <tr><td>TRENCH I-A:</td><td>486.9 (SEE PROFILE)</td></tr> <tr><td>TRENCH I-B:</td><td>486.0 (SEE PROFILE)</td></tr> <tr><td>TRENCH I-C:</td><td>485.6 (SEE PROFILE)</td></tr> <tr><td>TRENCH I-D:</td><td>484.6</td></tr> <tr><td>TRENCH I-A:</td><td>480.4</td></tr> <tr><td>TRENCH I-B:</td><td>479.5</td></tr> <tr><td>TRENCH I-C:</td><td>479.1</td></tr> <tr><td>TRENCH I-D:</td><td>478.1</td></tr> </table>	TRENCH I-A:	486.9 (SEE PROFILE)	TRENCH I-B:	486.0 (SEE PROFILE)	TRENCH I-C:	485.6 (SEE PROFILE)	TRENCH I-D:	484.6	TRENCH I-A:	480.4	TRENCH I-B:	479.5	TRENCH I-C:	479.1	TRENCH I-D:	478.1	<p><b>6. EXISTING GRADE</b></p> <table border="1"> <tr><td>TRENCH R-A:</td><td>484.6 (SEE PROFILE)</td></tr> <tr><td>TRENCH R-B:</td><td>483.7 (SEE PROFILE)</td></tr> <tr><td>TRENCH R-C:</td><td>482.8 (SEE PROFILE)</td></tr> <tr><td>TRENCH R-D:</td><td>481.7</td></tr> <tr><td>TRENCH R-E:</td><td>480.5</td></tr> <tr><td>TRENCH R-F:</td><td>479.2</td></tr> <tr><td>TRENCH R-A:</td><td>478.1</td></tr> <tr><td>TRENCH R-B:</td><td>477.2</td></tr> <tr><td>TRENCH R-C:</td><td>476.3</td></tr> <tr><td>TRENCH R-D:</td><td>475.2</td></tr> <tr><td>TRENCH R-E:</td><td>478.5</td></tr> <tr><td>TRENCH R-F:</td><td>477.2</td></tr> </table>	TRENCH R-A:	484.6 (SEE PROFILE)	TRENCH R-B:	483.7 (SEE PROFILE)	TRENCH R-C:	482.8 (SEE PROFILE)	TRENCH R-D:	481.7	TRENCH R-E:	480.5	TRENCH R-F:	479.2	TRENCH R-A:	478.1	TRENCH R-B:	477.2	TRENCH R-C:	476.3	TRENCH R-D:	475.2	TRENCH R-E:	478.5	TRENCH R-F:	477.2
<p><b>7. INVERT</b></p>	<p><b>7. INVERT</b></p>	



**SHANABERGER & LANE**  
 8726 TOWN & COUNTRY BLVD.  
 SUITE 201  
 ELLICOTT CITY, MD 211043  
 (410) 461-9563  
 (410) 461-9693 fax  
 home@shanablane.com

HEREBY CERTIFY THAT THE INFORMATION SHOWN HEREON REFLECTS WORK DONE BY ME OR UNDER MY DIRECT SUPERVISION USING AVAILABLE PUBLIC AND PRIVATE INFORMATION AND IS CORRECT TO THE BEST OF MY PROFESSIONAL KNOWLEDGE AND BELIEF.

*Scott Shanabarger*  
 G. SCOTT SHANABARGER  
 PROFESSIONAL LAND SURVEYOR #10839  
 LICENSE EXPIRATION DATE 4/2/2020

**APPROVED:**  
 FOR PRIVATE WATER AND SEWERAGE SYSTEMS

HEALTH OFFICER, HOWARD COUNTY HEALTH DEPT. DATE

**OWNERS**  
 CYNTHIA ANN DZUBAK  
 NICHOLAS WILLIAM DZUBAK  
 7409 OAKCREST LANE  
 CLARKSVILLE, MD. 21109

PERC CERTIFICATION PLAT  
**7409 OAKCREST LANE**  
 LOT 30 SEC. 2 HOPKINS MEAD  
 PLAT BOOK 7, FOLIO 85 TITLE DEED: 8016375  
 TAX MAP 41, GRID 15, PARCEL 19C  
 5rd ELECTION DISTRICT, HOWARD COUNTY, MD.  
 SCALE: 1" = 30' DATE: 3/27/19  
 PURPOSE: TO MAKE EX. GARAGE INTO LIVING SPACE, ADD A NEW GARAGE AND A PORCH