

GEORGE W. BROWN
1011/609
EX. ZONING - R

TYPICAL SECTION - ROAD 'A'

VICINITY MAP
SCALE: 1" = 600'

GENERAL NOTES

- TAX MAP: 2 PARCEL: 124
- DEED REFERENCE: C43/255
- EXISTING ZONING: R
- PRIVATE WATER AND PRIVATE SEWAGE TO BE UTILIZED
- MD. RTE. 144 IS AN EXISTING PUBLIC ROAD.
- TOTAL AREA OF SITE: 43.88 AC
- TOTAL NO. OF LOTS: 12
- BOUNDARY SHOWN HEREON IS BASED ON DEED PLOTTING.
- TOPO SHOWN HEREON IS BASED ON HOWARD CO. 1" = 200' AERIAL TOPO MAPS.
- TOTAL AREA OF LOTS: 43.2 AC
- THE LOTS SHOWN HEREON COMPLY WITH THE MINIMUM OWNERSHIP WIDTH AND LOT AREAS AS REQUIRED BY THE MARYLAND STATE DEPARTMENT OF HEALTH AND MENTAL HYGIENE.
- THIS AREA DESIGNATES A PRIVATE SEWAGE EASEMENT OF APPROXIMATELY 10,000 SQ. FT. AS REQUIRED BY THE MARYLAND STATE DEPARTMENT OF HEALTH AND MENTAL HYGIENE FOR INDIVIDUAL SEWAGE DISPOSAL IMPROVEMENTS OF ANY NATURE IN THIS AREA ARE RESTRICTED UNTIL PUBLIC SEWAGE IS AVAILABLE AND SERVICING ANY RESIDENTIAL STRUCTURES CONSTRUCTED ON THESE BUILDING SITES. THESE EASEMENTS SHALL BECOME NULL AND VOID UPON CONNECTION TO A PUBLIC SEWAGE SYSTEM. THE COUNTY HEALTH OFFICER SHALL HAVE THE AUTHORITY TO GRANT ENCROACHMENTS INTO THE PRIVATE SEWAGE EASEMENT. RECREATION OF A MODIFIED SEWAGE EASEMENT SHALL NOT BE NECESSARY.
- ALL PERCOLATION TEST HOLES SHOWN HEREON HAVE BEEN FIELD LOCATED AND SHOWN THIS (W).

APPROVED FOR PRIVATE WATER AND PRIVATE SEWAGE SYSTEMS, HOWARD COUNTY HEALTH DEPARTMENT

HOWARD COUNTY HEALTH OFFICER _____ DATE _____

PERCOLATION TEST DATA

LOT NO.	AVERAGE PERC TIME IN MINUTES FOR SECOND INCH	MAXIMUM DEPTH PERMITTED FOR EFFLUENT PIPE TO ENTER SEWAGE DISPOSAL AREA AT ITS HIGHEST ELEV WITH REFERENCE TO EL. GRADE AT TIME OF TEST
1		
2		
3		
4		
5		
6		
7		
8		
9		
10		
11		
12		

RICHARD HOUGH PROP.

RECEIVED
JAN 10 1985
DIV. OF LAND DEVELOPMENT
COUNTY OF HOWARD

OWNER/DEVELOPER

RICHARD M. HOUGH
17591 RTE. 144
MT. AIRY, MD. 21771

Seiter Dec 29 84

TITLE: **PRELIMINARY PLAN P-8636**


PROJECT: **COUNTRY VIEW**

LOCATION: TAX MAP 2, PARCEL 124; 402 FILE NO. 5-85-11
FOURTH ELECTION DISTRICT, HOWARD COUNTY, MARYLAND


DATE: NOV, 1985 SCALE: 1" = 100' DESIGN BY: D.R. DRAWN BY: S.D.K. CHECKED BY: J.A.B. DRAWING NO.: 10P1 JOB NO.: 84/38

boender associates engineers, surveyors, planners
3565 ELLICOTT MILLS DRIVE
ELLICOTT CITY, MARYLAND 21043
301-466-7777

William Finney 12-19-85

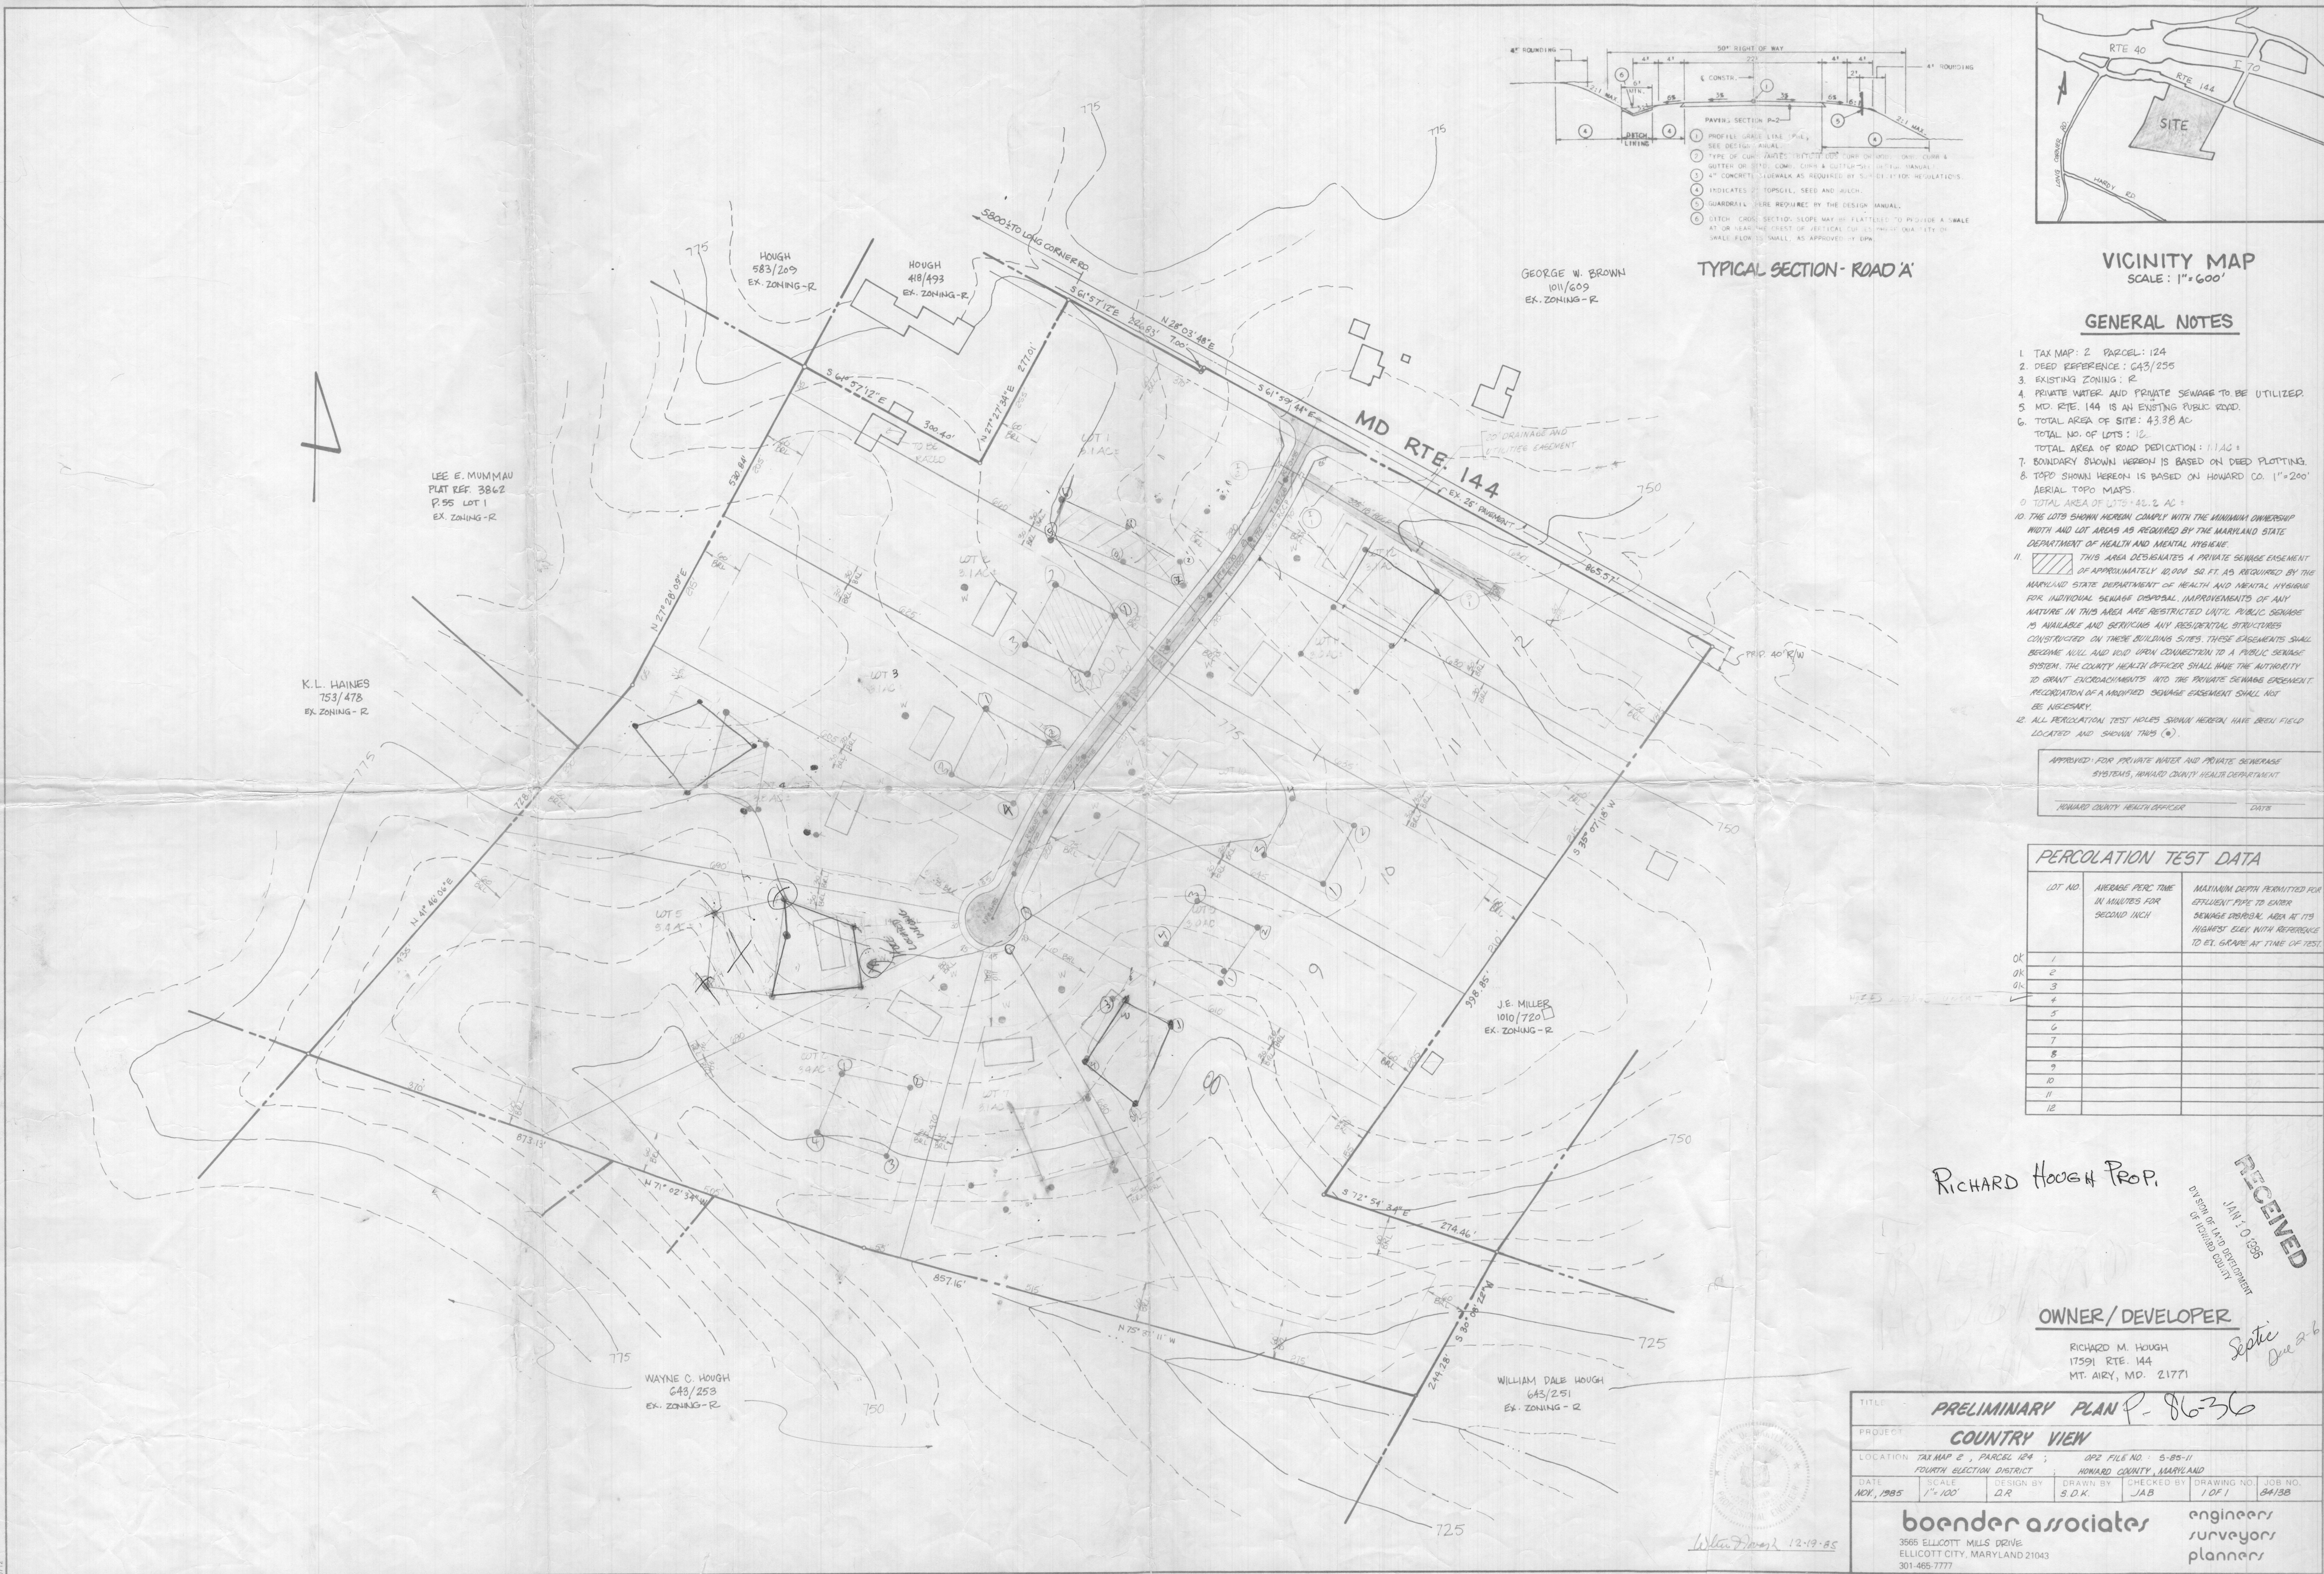


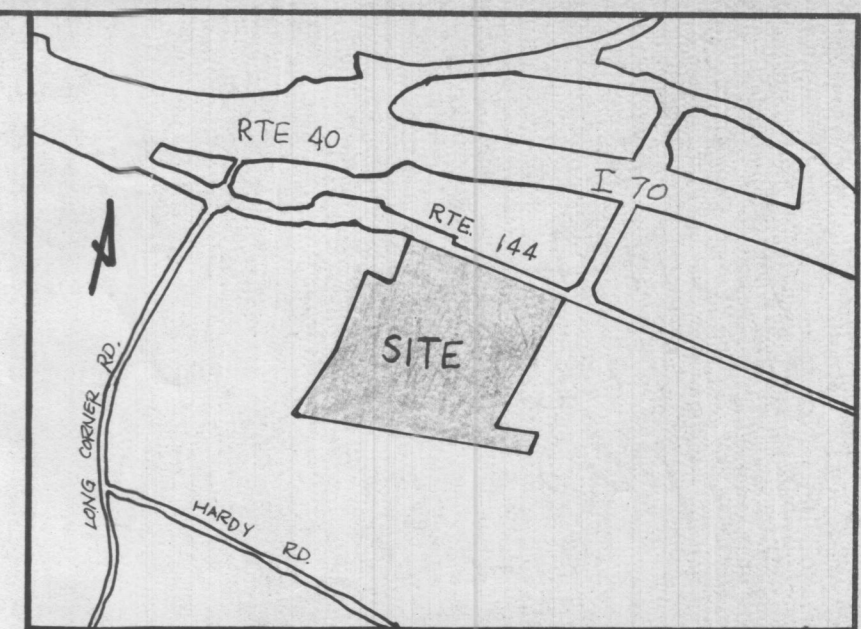

VICINITY MAP
 SCALE: 1" = 600'

GENERAL NOTES

1. TAX MAP: 2 PARCEL: 124
2. DEED REFERENCE: G43/255
3. EXISTING ZONING: R
4. PRIVATE WATER AND PRIVATE SEWAGE TO BE UTILIZED.
5. MD. RTE. 144 IS AN EXISTING PUBLIC ROAD.
6. TOTAL AREA OF SITE: 43.88 AC.
TOTAL NO. OF LOTS: 12
7. TOTAL AREA OF ROAD DEDICATION: 1.140 AC.
8. BOUNDARY SHOWN HEREON IS BASED ON A FIELD SURVEY.
9. TOPO SHOWN HEREON IS BASED ON HOWARD CO. 1" = 200' AERIAL TOPO MAPS.
10. TOTAL AREA OF LOTS: 44.2 AC.
11. THE LOTS SHOWN HEREON COMPLY WITH THE MINIMUM OWNERSHIP WIDTH AND LOT AREAS AS REQUIRED BY THE MARYLAND STATE DEPARTMENT OF HEALTH AND MENTAL HYGIENE.
12. THIS AREA DESIGNATES A PRIVATE SEWAGE EASEMENT OF APPROXIMATELY 10,000 SQ. FT. AS REQUIRED BY THE MARYLAND STATE DEPARTMENT OF HEALTH AND MENTAL HYGIENE FOR INDIVIDUAL SEWAGE DISPOSAL. IMPROVEMENTS OF ANY NATURE IN THIS AREA ARE RESTRICTED UNTIL PUBLIC SEWAGE IS AVAILABLE AND SERVICING ANY RESIDENTIAL STRUCTURES CONSTRUCTED ON THESE BUILDING SITES, THESE EASEMENTS SHALL BECOME NULL AND VOID UPON CONNECTION TO A PUBLIC SEWAGE SYSTEM. THE COUNTY HEALTH OFFICER SHALL HAVE THE AUTHORITY TO GRANT ENCROACHMENTS INTO THE PRIVATE SEWAGE EASEMENT. RECORDATION OF A MODIFIED SEWAGE EASEMENT SHALL NOT BE NECESSARY.
13. ALL PERCOLATION TEST HOLES SHOWN HEREON HAVE BEEN FIELD LOCATED AND SHOWN THIS (C).

APPROVED FOR PRIVATE WATER AND PRIVATE SEWAGE SYSTEMS, HOWARD COUNTY HEALTH DEPARTMENT
James G. DeLoe
 HOWARD COUNTY HEALTH OFFICER

PERCOLATION TEST DATA

OLD LOT NO.	NEW LOT NO.	AVERAGE PERC. TIME IN HOURS FOR SECOND INCH	MAXIMUM DEPTH PERMITTED FOR EFFLUENT PIPE TO ENTER SEWAGE DISPOSAL AREA AT ITS HIGHEST ELEV. WITH REFERENCE TO E1. GRADE AT TIME OF TEST.
1	1	18	5'
2	2	12	5'
3	3	5	3.5'
4, 5	4	10	4'
4, 5, 6	5	10	3.5'
5, 6, 7	6	5	4.5'
7, 8	7	8	4'
7, 8	8	8	3'
9	9	5	3'
10	10	5	3.5'
11	11	15	4'
12	12	3	3'

TENTATIVELY APPROVED ON SEPT. 18, 1986

OFFICE OF PLANNING AND ZONING OF HOWARD COUNTY
Thomas J. Harris 2-13-87
 PLANNING DIRECTOR DATE

OWNER/DEVELOPER

RICHARD M. HOUGH
 17591 RTE. 144
 MT. AIRY, MD. 21771



TITLE: **PRELIMINARY PLAN**

PROJECT: **COUNTRY VIEW**

LOCATION: TAX MAP 2; PARCEL 124; 492 FILE NO.: S-85-11
 FOURTH ELECTION DISTRICT; HOWARD COUNTY, MARYLAND

DATE: NOV, 1985 SCALE: 1" = 100' DESIGN BY: D.R. DRAWN BY: S.D.K. CHECKED BY: JAB. DRAWING NO.: 1 OF 1 JOB NO.: 84/38

boender associates engineers, surveyors, planners
 3565 ELLICOTT MILLS DRIVE
 ELLICOTT CITY, MARYLAND 21043
 301-465-7777

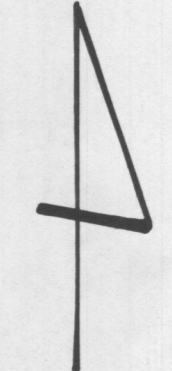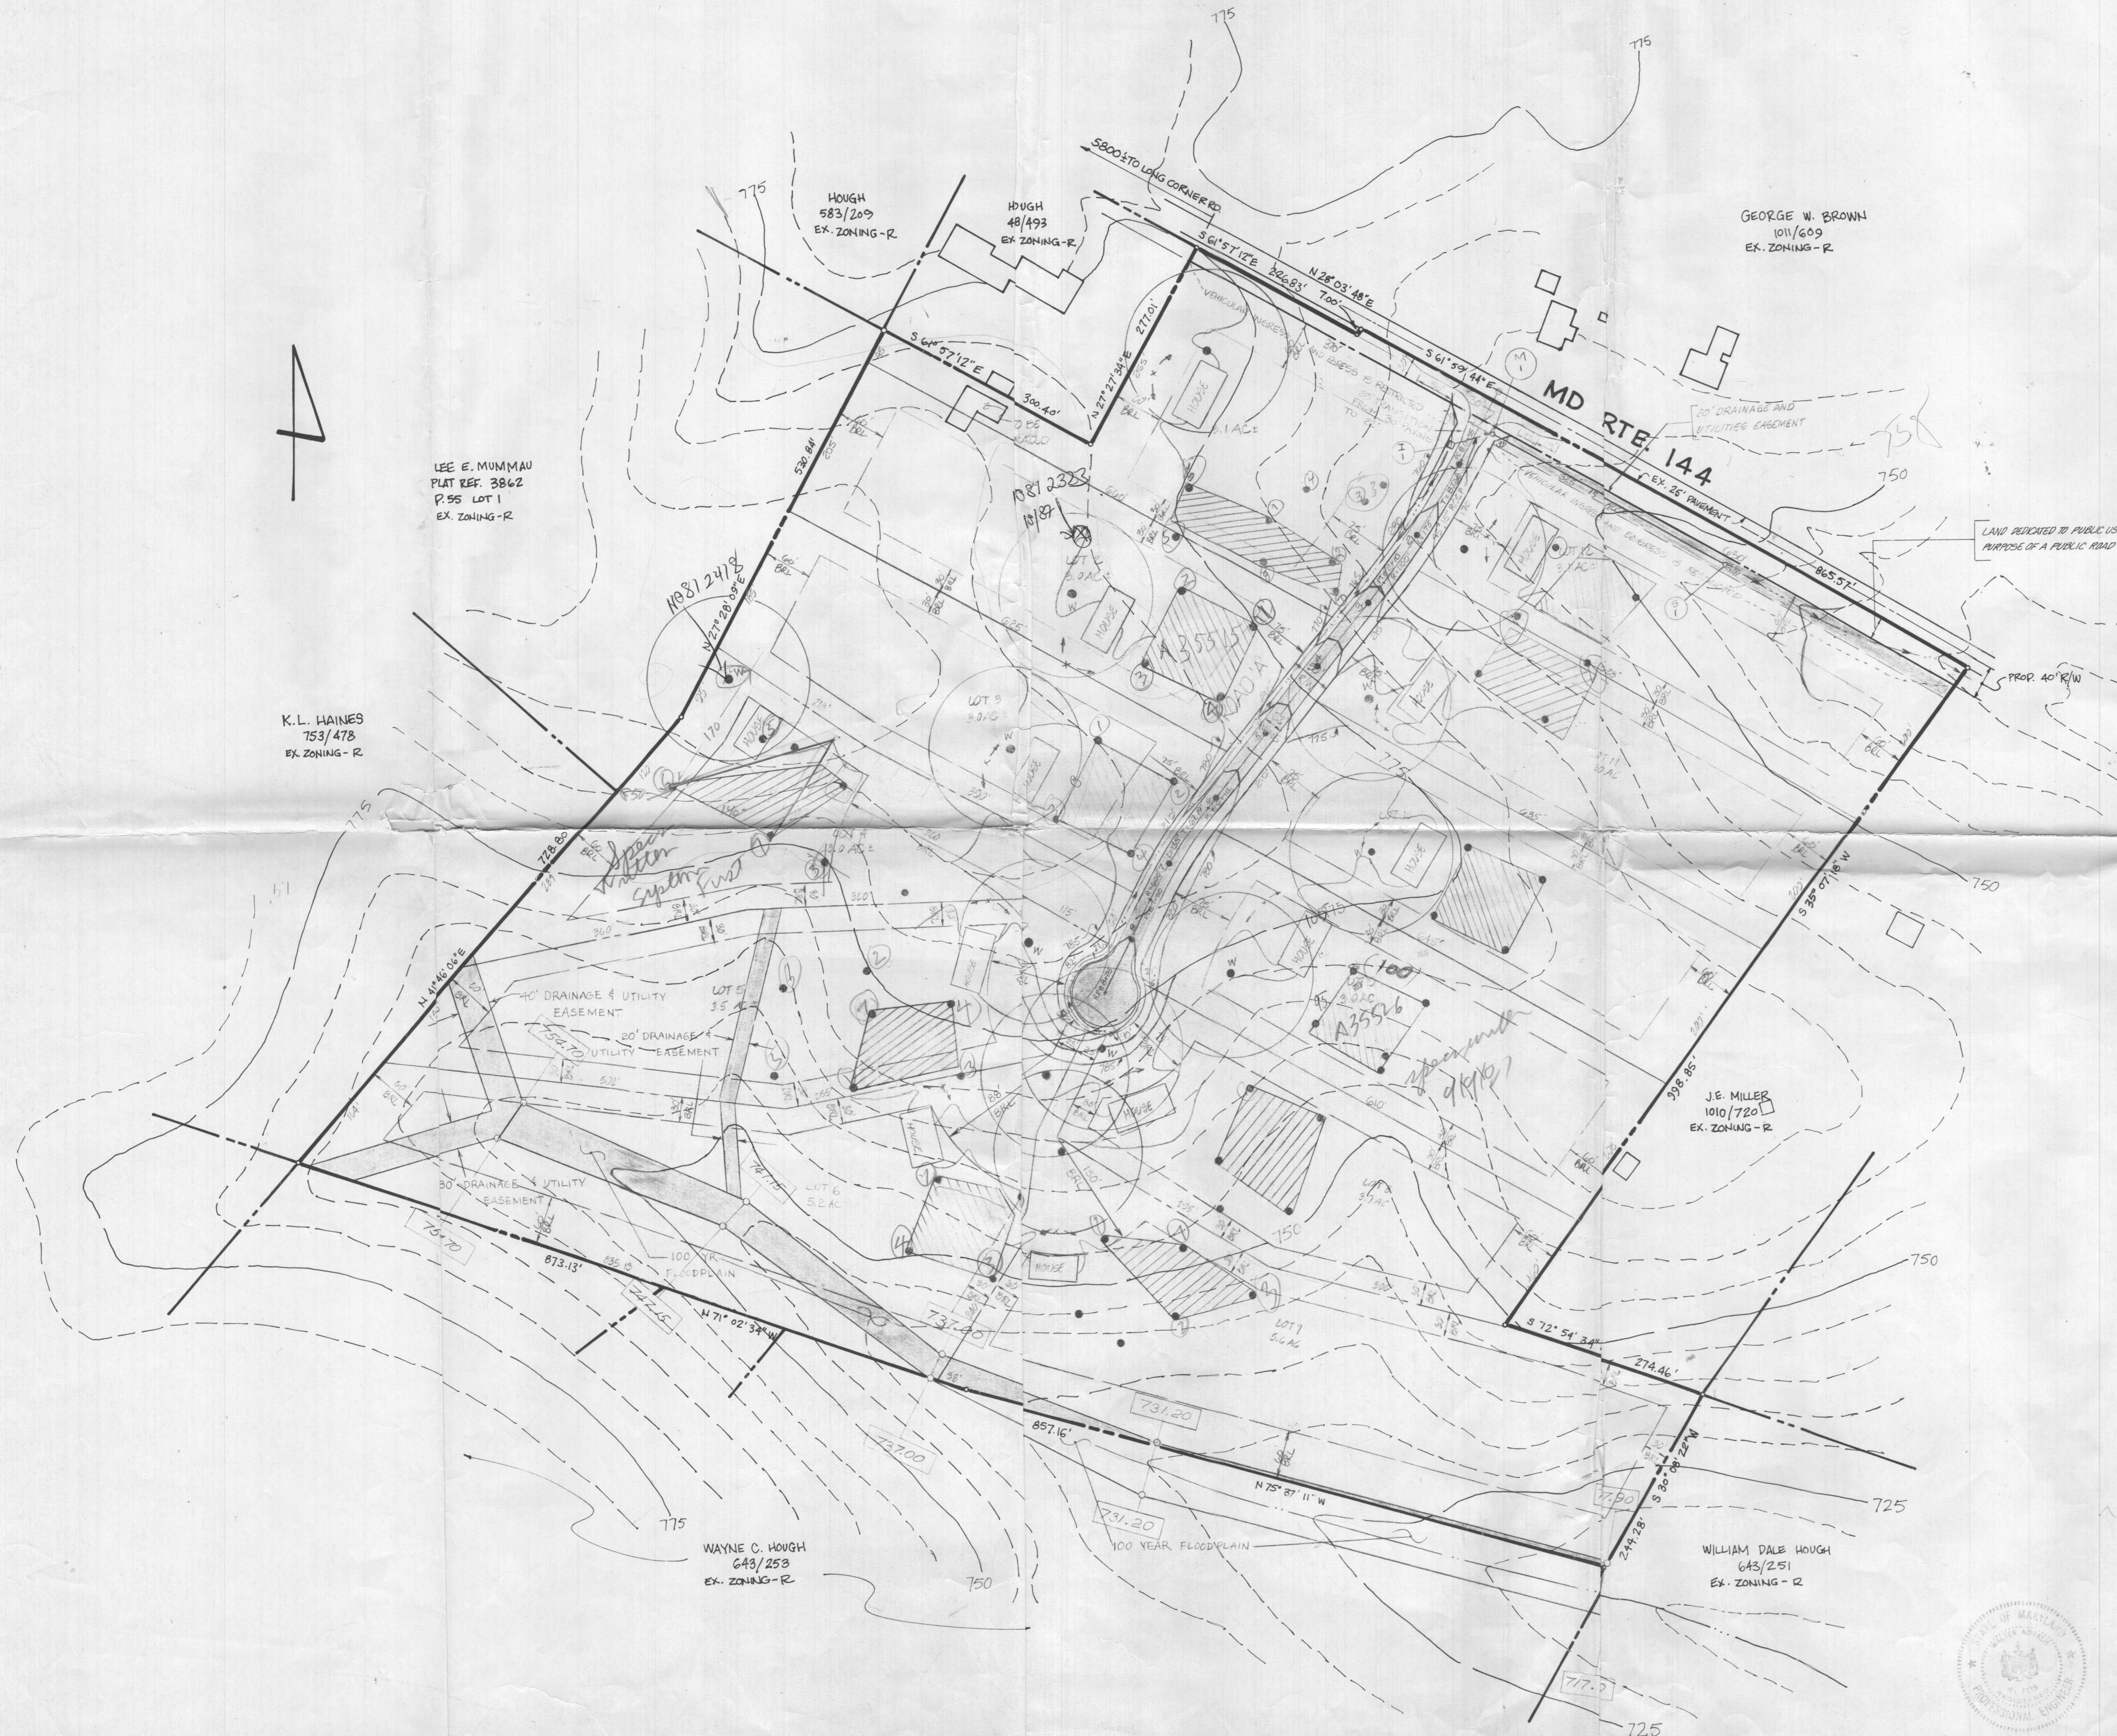

LEE E. MUMMAU
 PLAT REF. 3862
 P. 95 LOT 1
 EX. ZONING - R

K.L. HAINES
 753/478
 EX. ZONING - R

HOUGH
 583/209
 EX. ZONING - R

HOUGH
 48/493
 EX. ZONING - R

GEORGE W. BROWN
 101/609
 EX. ZONING - R

J.E. MILLER
 1010/720
 EX. ZONING - R

WAYNE C. HOUGH
 643/253
 EX. ZONING - R

WILLIAM DALE HOUGH
 643/251
 EX. ZONING - R