


Wastewater

Models

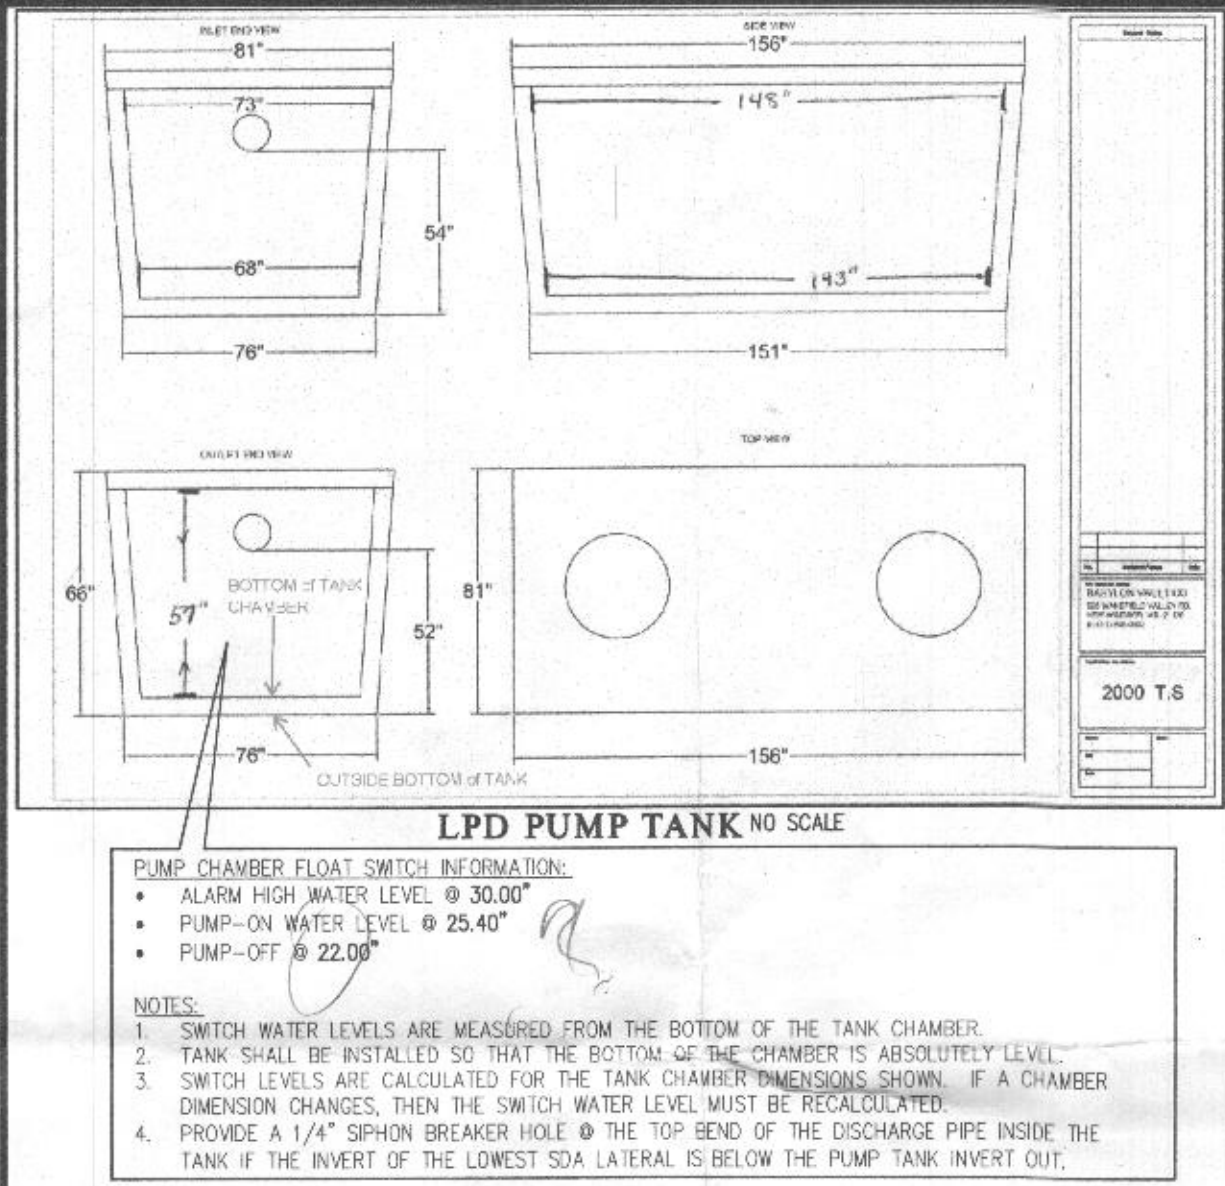


Rectangular Trapezoidal Pump Chamber Volume Calculations (Babylon Vault 2000 T.S)

H: Height (inside dimension from bottom of chamber to top seal)	57.0 in.
W: Top Width (inside dimension)	73.0 in.
L: Top Length (inside dimension)	148.0 in.
a: Bottom Width (inside dimension)	68.0 in.
b: Bottom Length (inside dimension)	141.0 in.
Chamber Bottom Area (a x b)	9724.0 sq. in.
Height from bottom of chamber to inlet level (Si)	50.0 in.
Chamber width at inlet level (Ci)	72.39 in.
Chamber length at inlet level (Di)	147.39 in.
Chamber Sectional Area at inlet level (Ci x Di)	10668.7 sq. in.
Chamber Volume at inlet level (Vi)	509657 cu. in.
	2206 gal.

Float Switch Setting Parameters & Volume Calculations

Design Flow per day (min. reserved capacity to set alarm level)	6 doses at 150 gal./dose	900 gal.
Dosing frequency per day & volume per dose	30,000 in.	
Water level (Sa) to switch on alarm	70.63 in.	
Chamber width at alarm level (Ca)	145.63 in.	
Chamber length at alarm level (Da)	10286.2 sq. in.	
Chamber Sectional Area at alarm level (Ca x Da)	300118 cu. in.	1299 gal.
Water volume at alarm level (Va)	209538 sq. in.	907 gal.
Reserved Capacity provided at alarm setting (Vi - Va)	209538 sq. in.	907 gal.
Back check reserved capacity : ((Si - Sa)/6) * (Ci * Di) + (Ci * Ca) * (Di + Da) + Ca * Da	30,000 in.	
Alarm High water level (from bottom of pump chamber)	25,400 in.	
Pump on water level (O) from bottom of pump chamber	70.23 in.	
Chamber width at this level (Co)	145.23 in.	
Chamber length at this level (Do)	10199.09 sq. in.	
Chamber Sectional Area at this level (Co x Do)	253002 cu. in.	1035 gal.
Water volume (Vo) to switch pump on	22,900 in.	
Pump off water level (F) from bottom of pump chamber	69.93 in.	
Chamber width at this level (Cf)	144.93 in.	
Chamber length at this level (Df)	10134.92 sq. in.	
Chamber Sectional Area at this level (Cf x Df)	218434 cu. in.	946 gal.
Water volume (Vf) to switch pump off	34568 cu. in.	150 gal.
Volume between on off switches: ((O - F)/6) * (Co * Do) + (Co * Cf) * (Do + Df) + Cf * Df	34568 cu. in.	150 gal.
Back Check dosing volume switch setting: Vo - Vf	34568 cu. in.	150 gal.

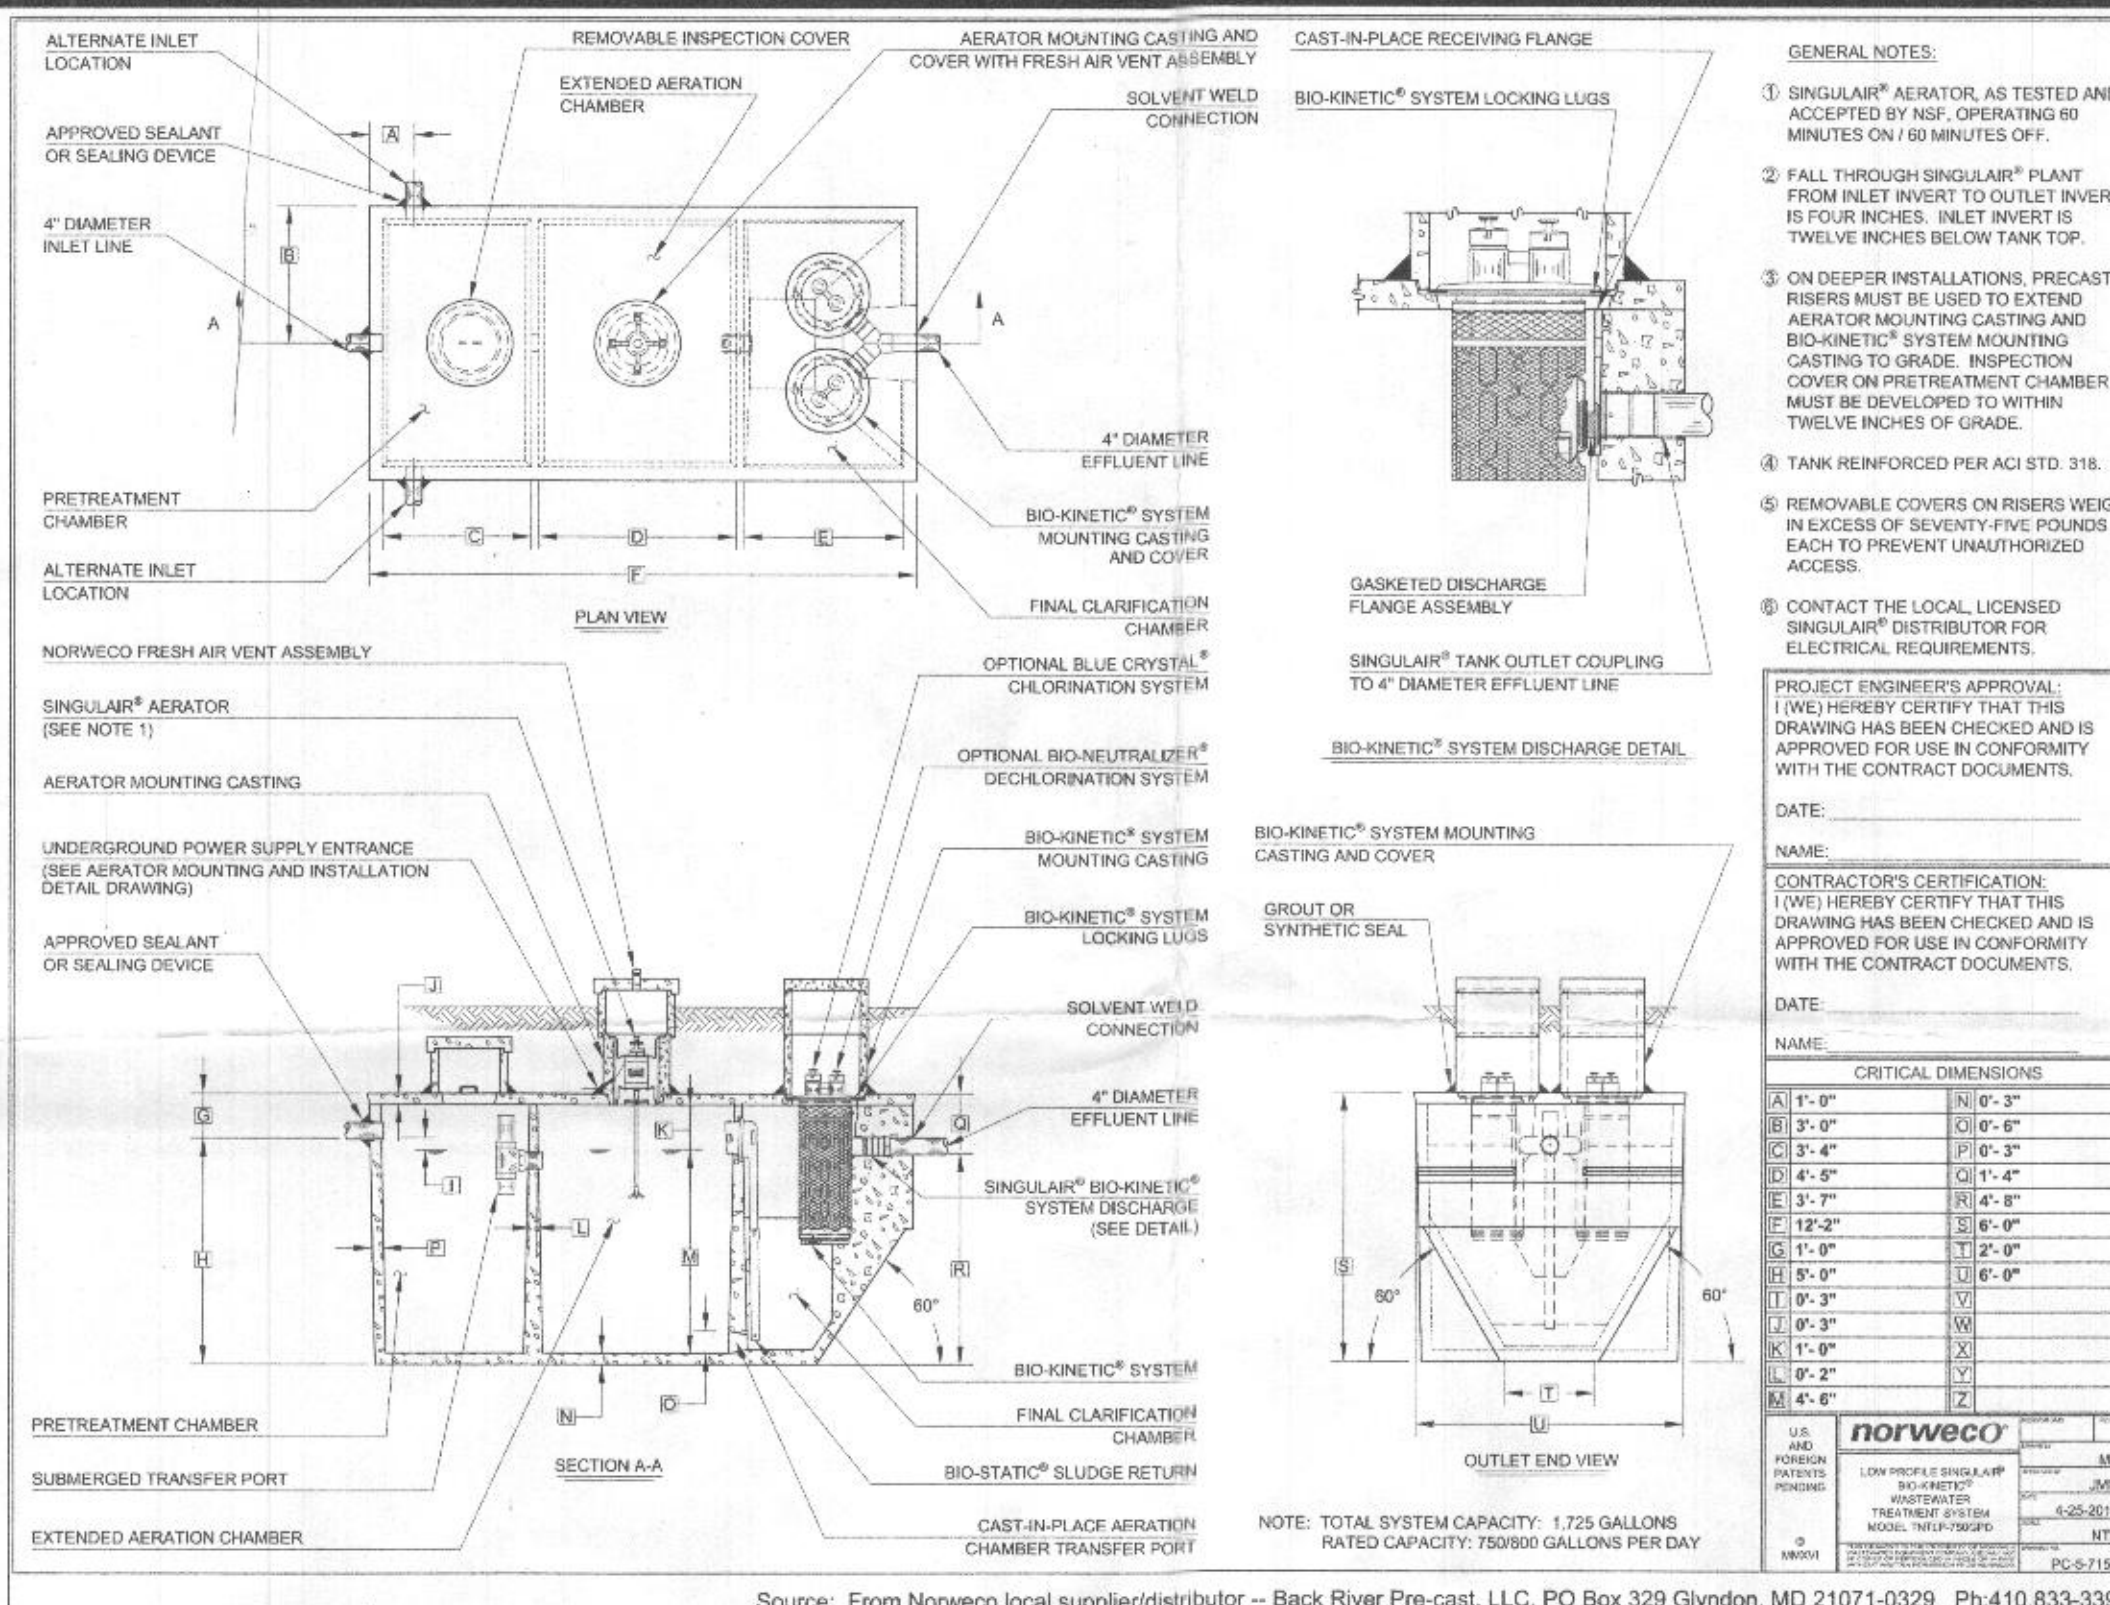

Gaither's Chance Lot-7

System Input Information

Application Rate	1.2	1.2	1.2
Effective area beginning depth	3.0	3.0	3.0
Effective area maximum bottom depth	5.5	5.5	5.5
Number of Bedrooms	6	6	6
Design flow at 150 gal./day/bedroom	900	900	900

Absorption Trench Calculations

Drainfield area required (Design flow/application rate)	750 s.f.	750 s.f.	750 s.f.
Effluent pipe depth to invert (cannot exceed 4\"/>			

LOW PRESSURE DISTRIBUTION SYSTEM CALCULATIONS

Per MDE BASIC LPD DESIGN - Draft Version 1 - Date July 3, 2014

ADDRESS: 5046 Gaithers Chance Drive

SUBDIVISION: Gaither's Chance

DATE: October, 2017

LOT: 7

Design Flow: 900 gpd

Pump Off Elevation: 538.07

Inv. Out of Pump Tank: 540.15

Pump Bottom Elevation: 536.73

Number of Manifolds: 1

Manifold 1 Type: End-Feed

Lateral	Elev.	Length	Flow
1	551.0	89.5	89.5
2	550.0	89.5	89.5

1" Elev. Range, Single Manifold OK

Trench	Elev (ft) Head	Orifice Diam.	Orifice Flow Rate	Orifice Spacing	Number of Orifices	Trench Length	Lateral Diam.	Type	
1	551.0	2	5/16	1.63	5.35	13	21.17	66.83	1.5 SCH 40
2	550.0	3	5/16	1.99	6.32	11	21.94	66.34	1.5 SCH 40

Min. System Discharge Rate: 43.1 gpm

Manifold Diam. 2.0 in Vel. 4.4 fps Friction Loss (Table 4.4) 3.024






Force Main Diam. 2.0 in Vel. 4.4 fps Friction Loss (Table 4.4) 3.024

Minimum Dose: 150.0 gal

Calculate Total Design Head

- Friction Loss in Foremain: 4.0 ft
- Friction Loss from Fittings: 21 ft X 3.024 = 63.5 ft
- Friction Loss from Laterals: 1.5 ft
- Static Head: 12.93 ft
- Min. Distal (discharge) head: 2 ft

TDH: 21.1 ft

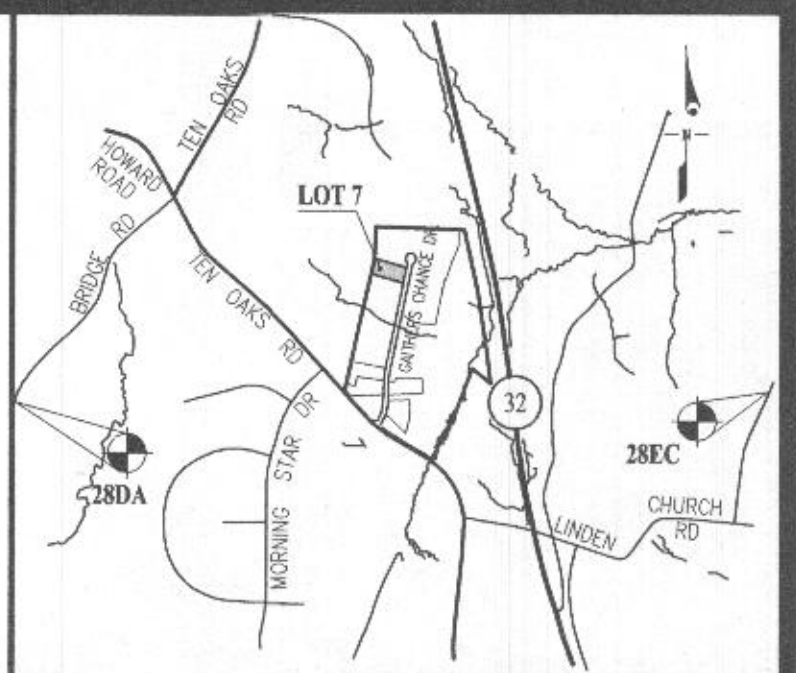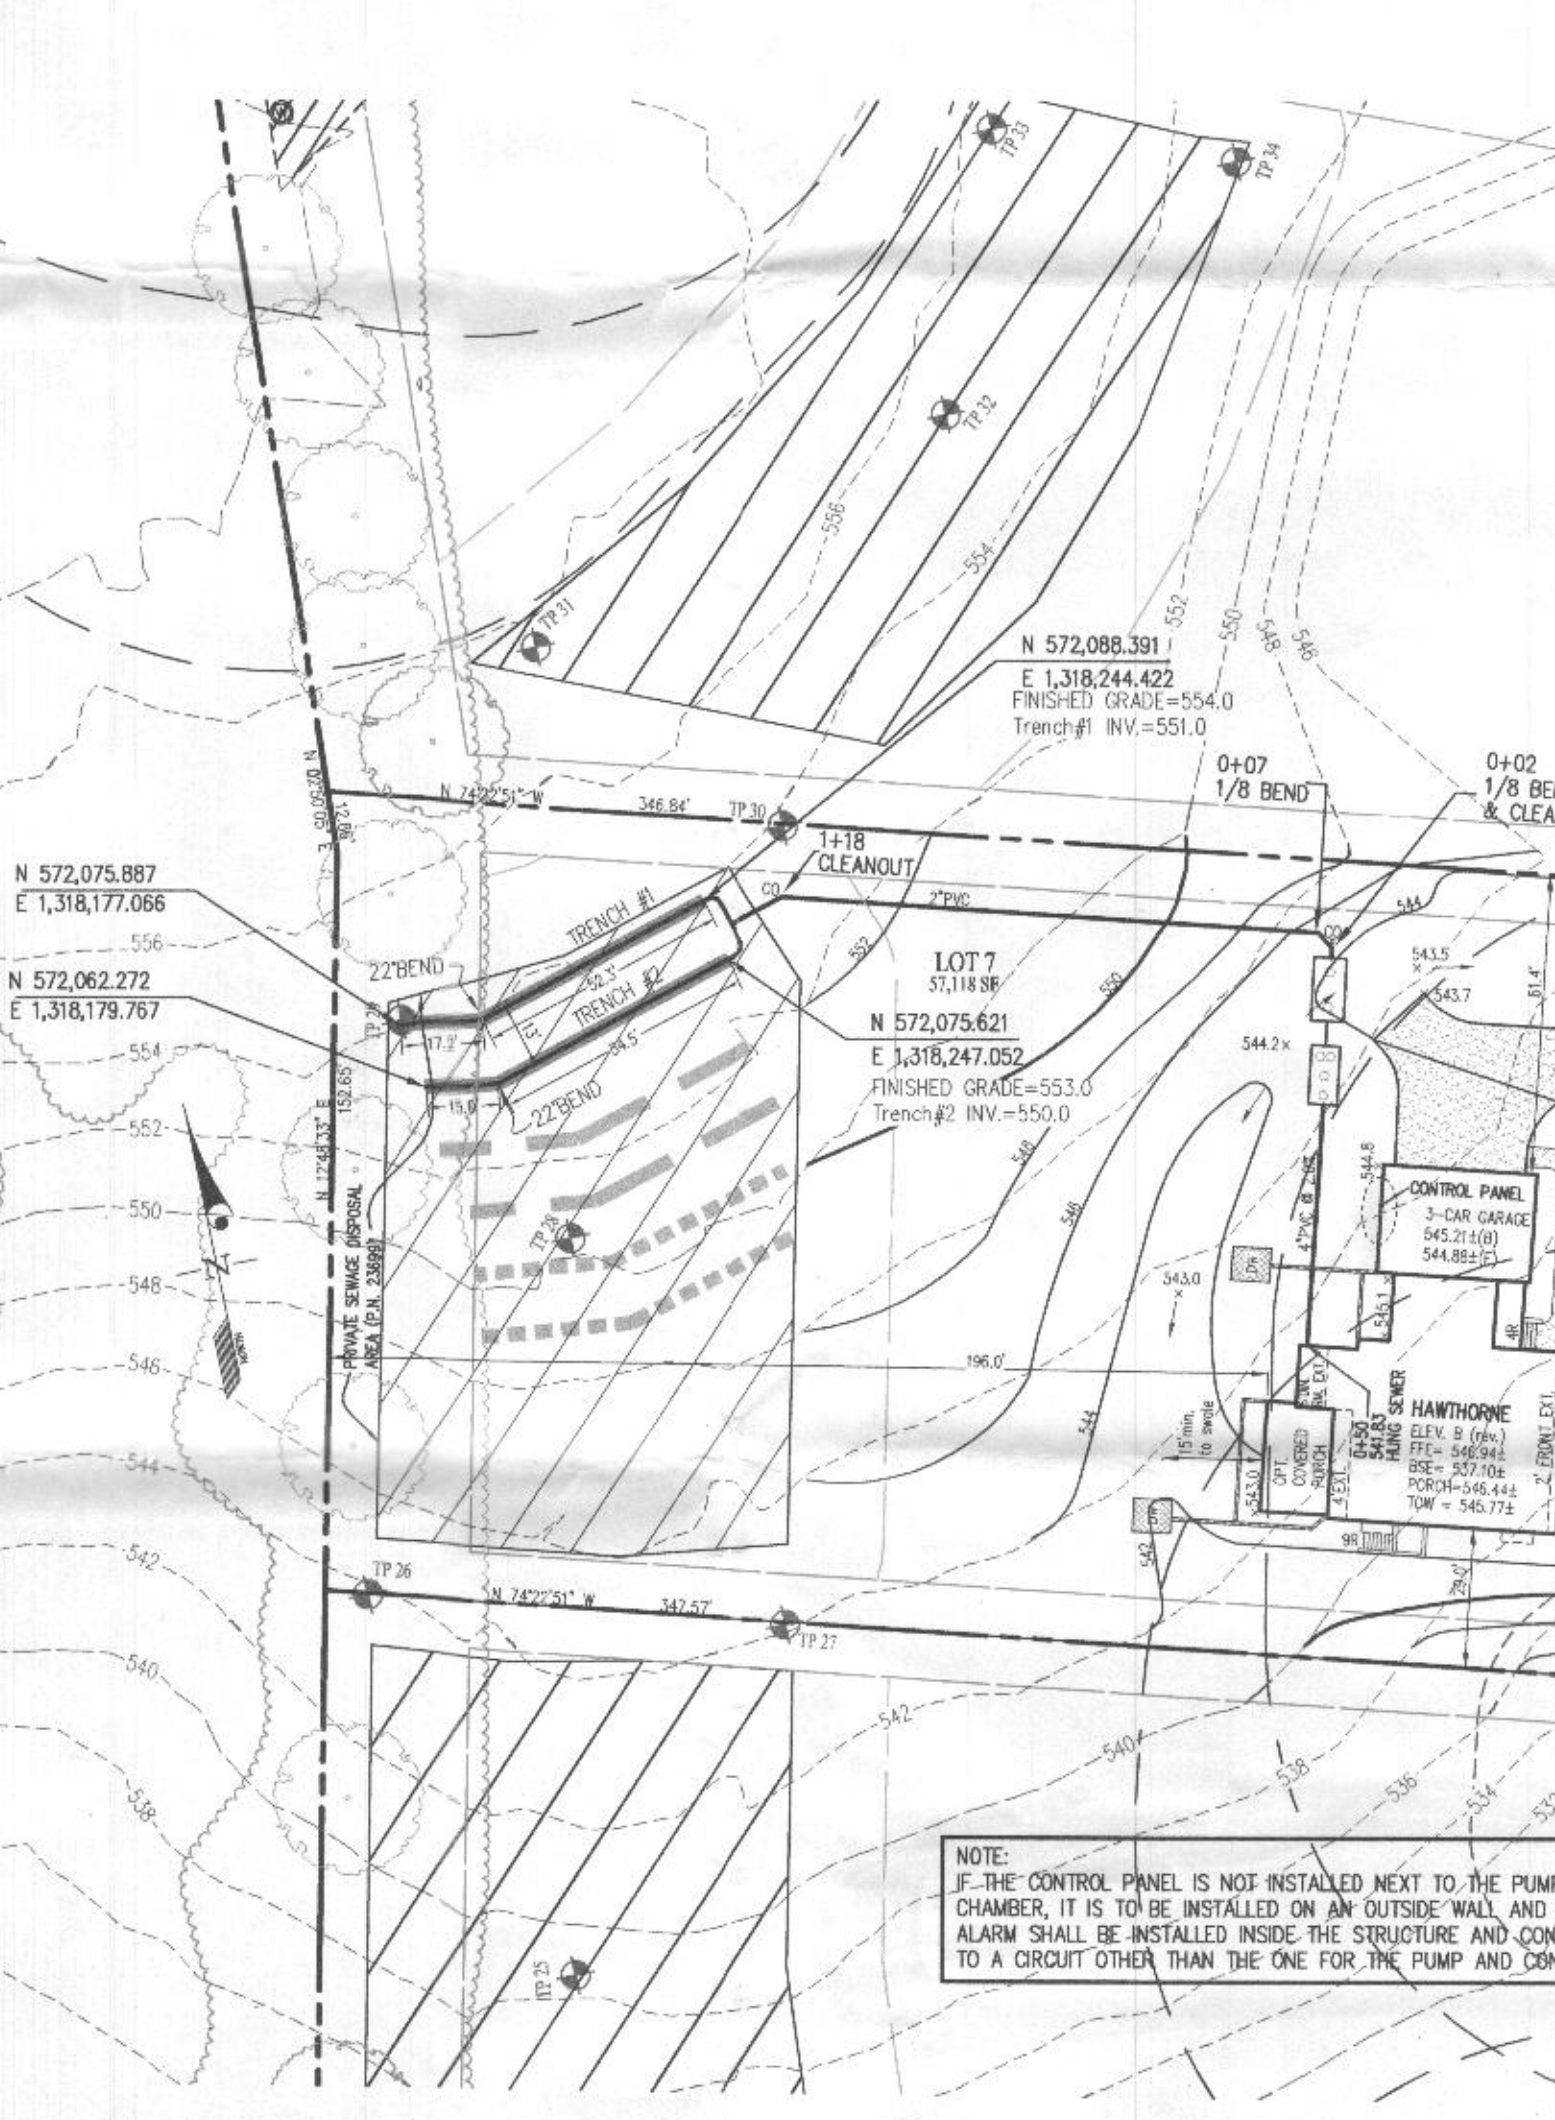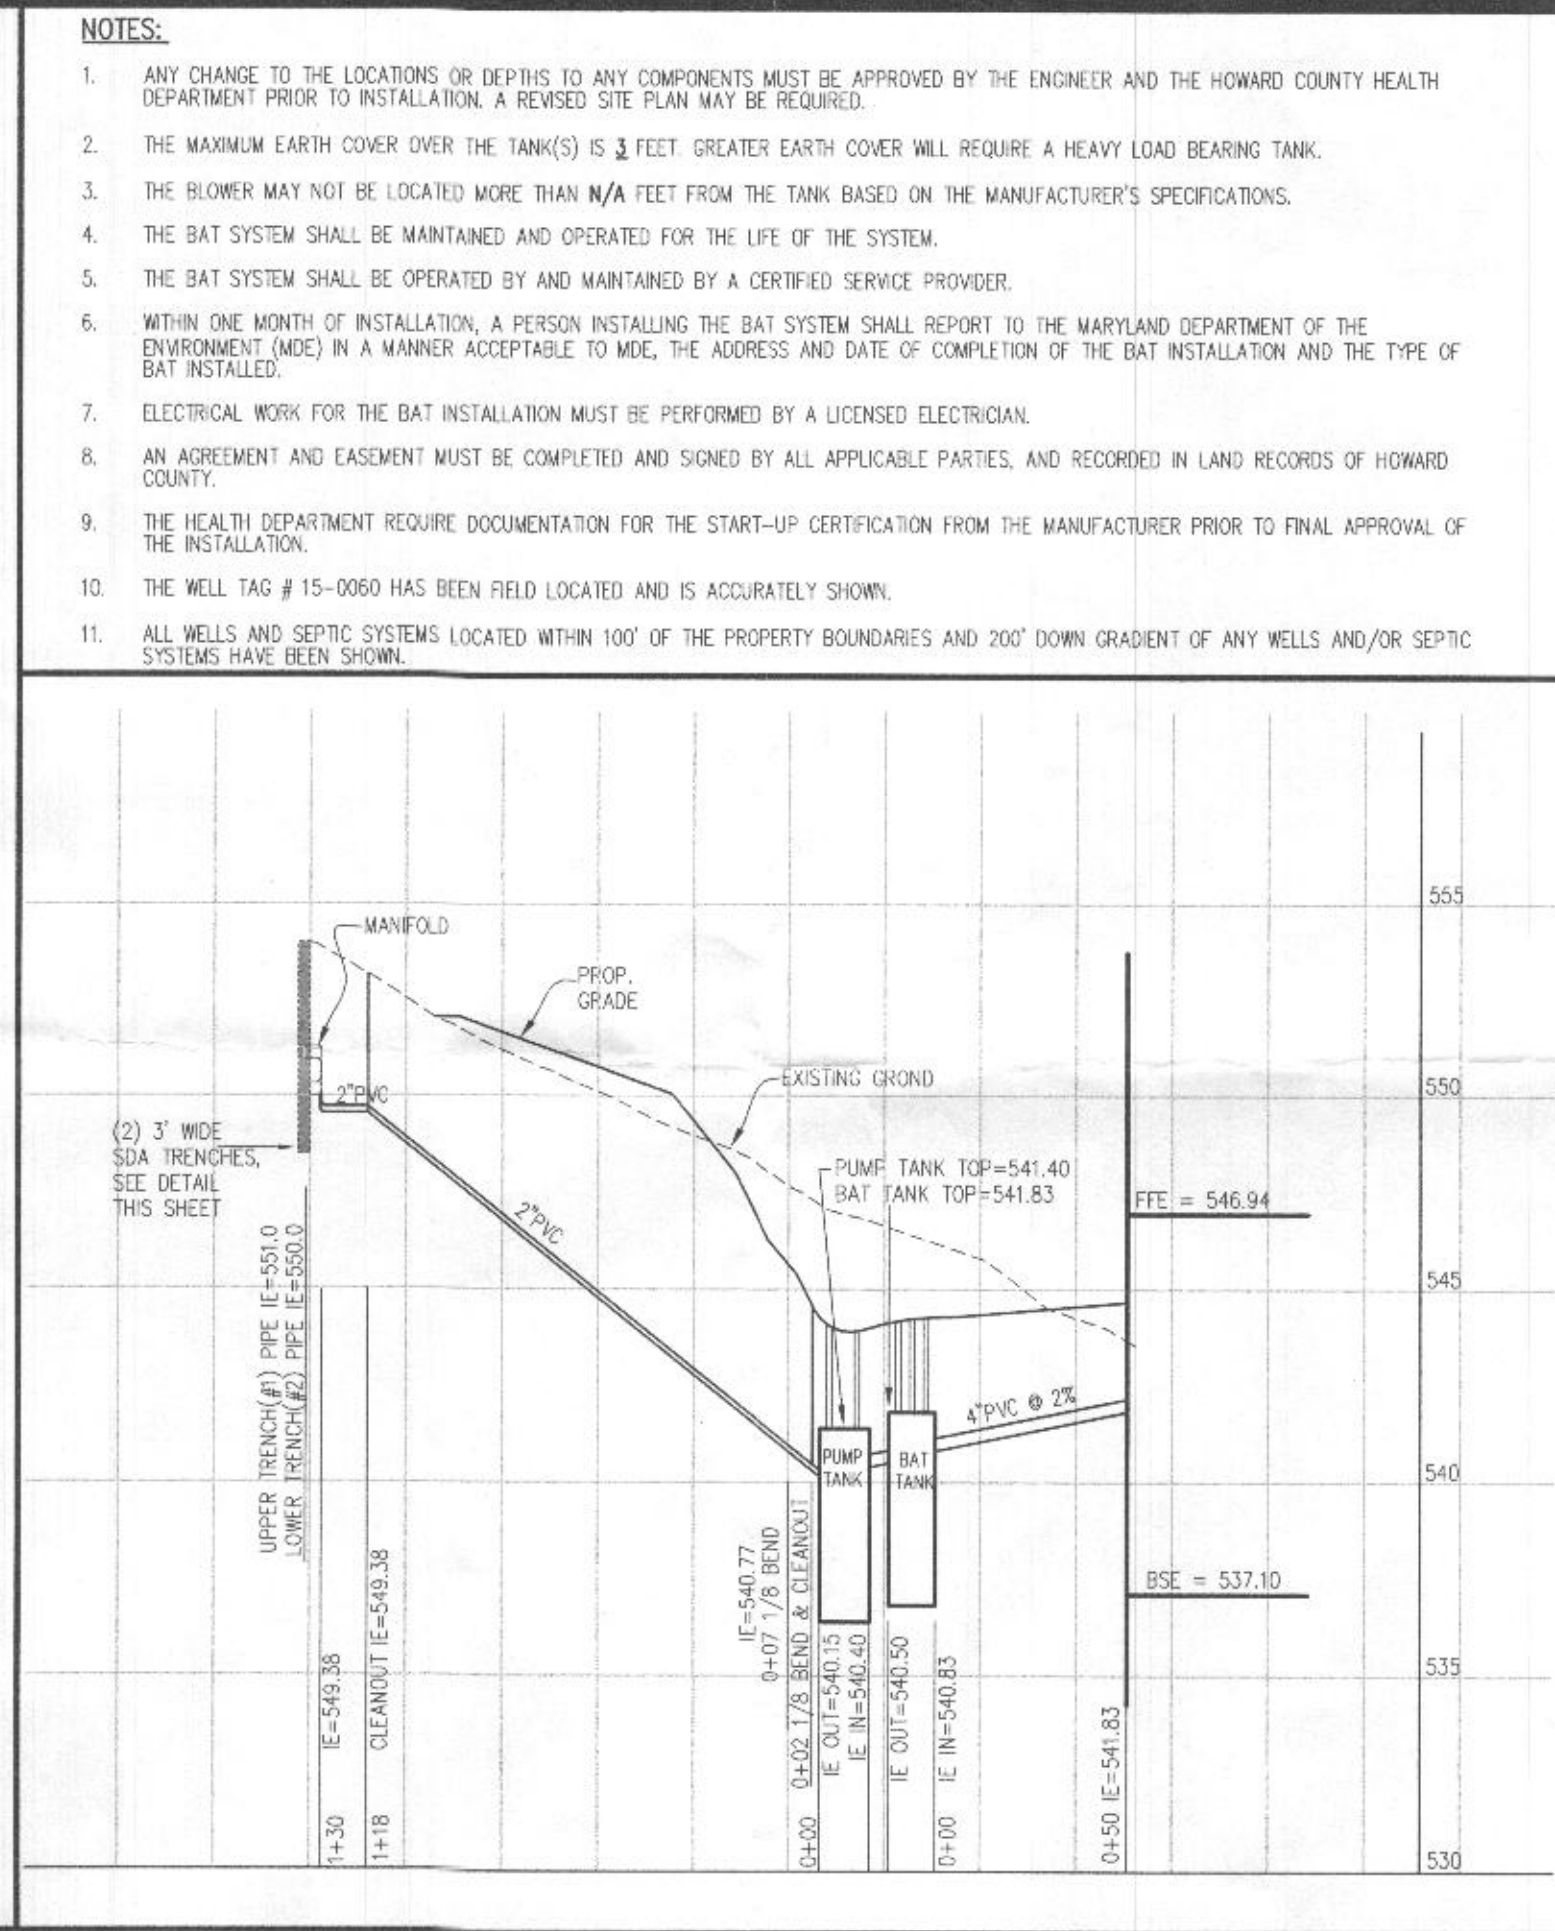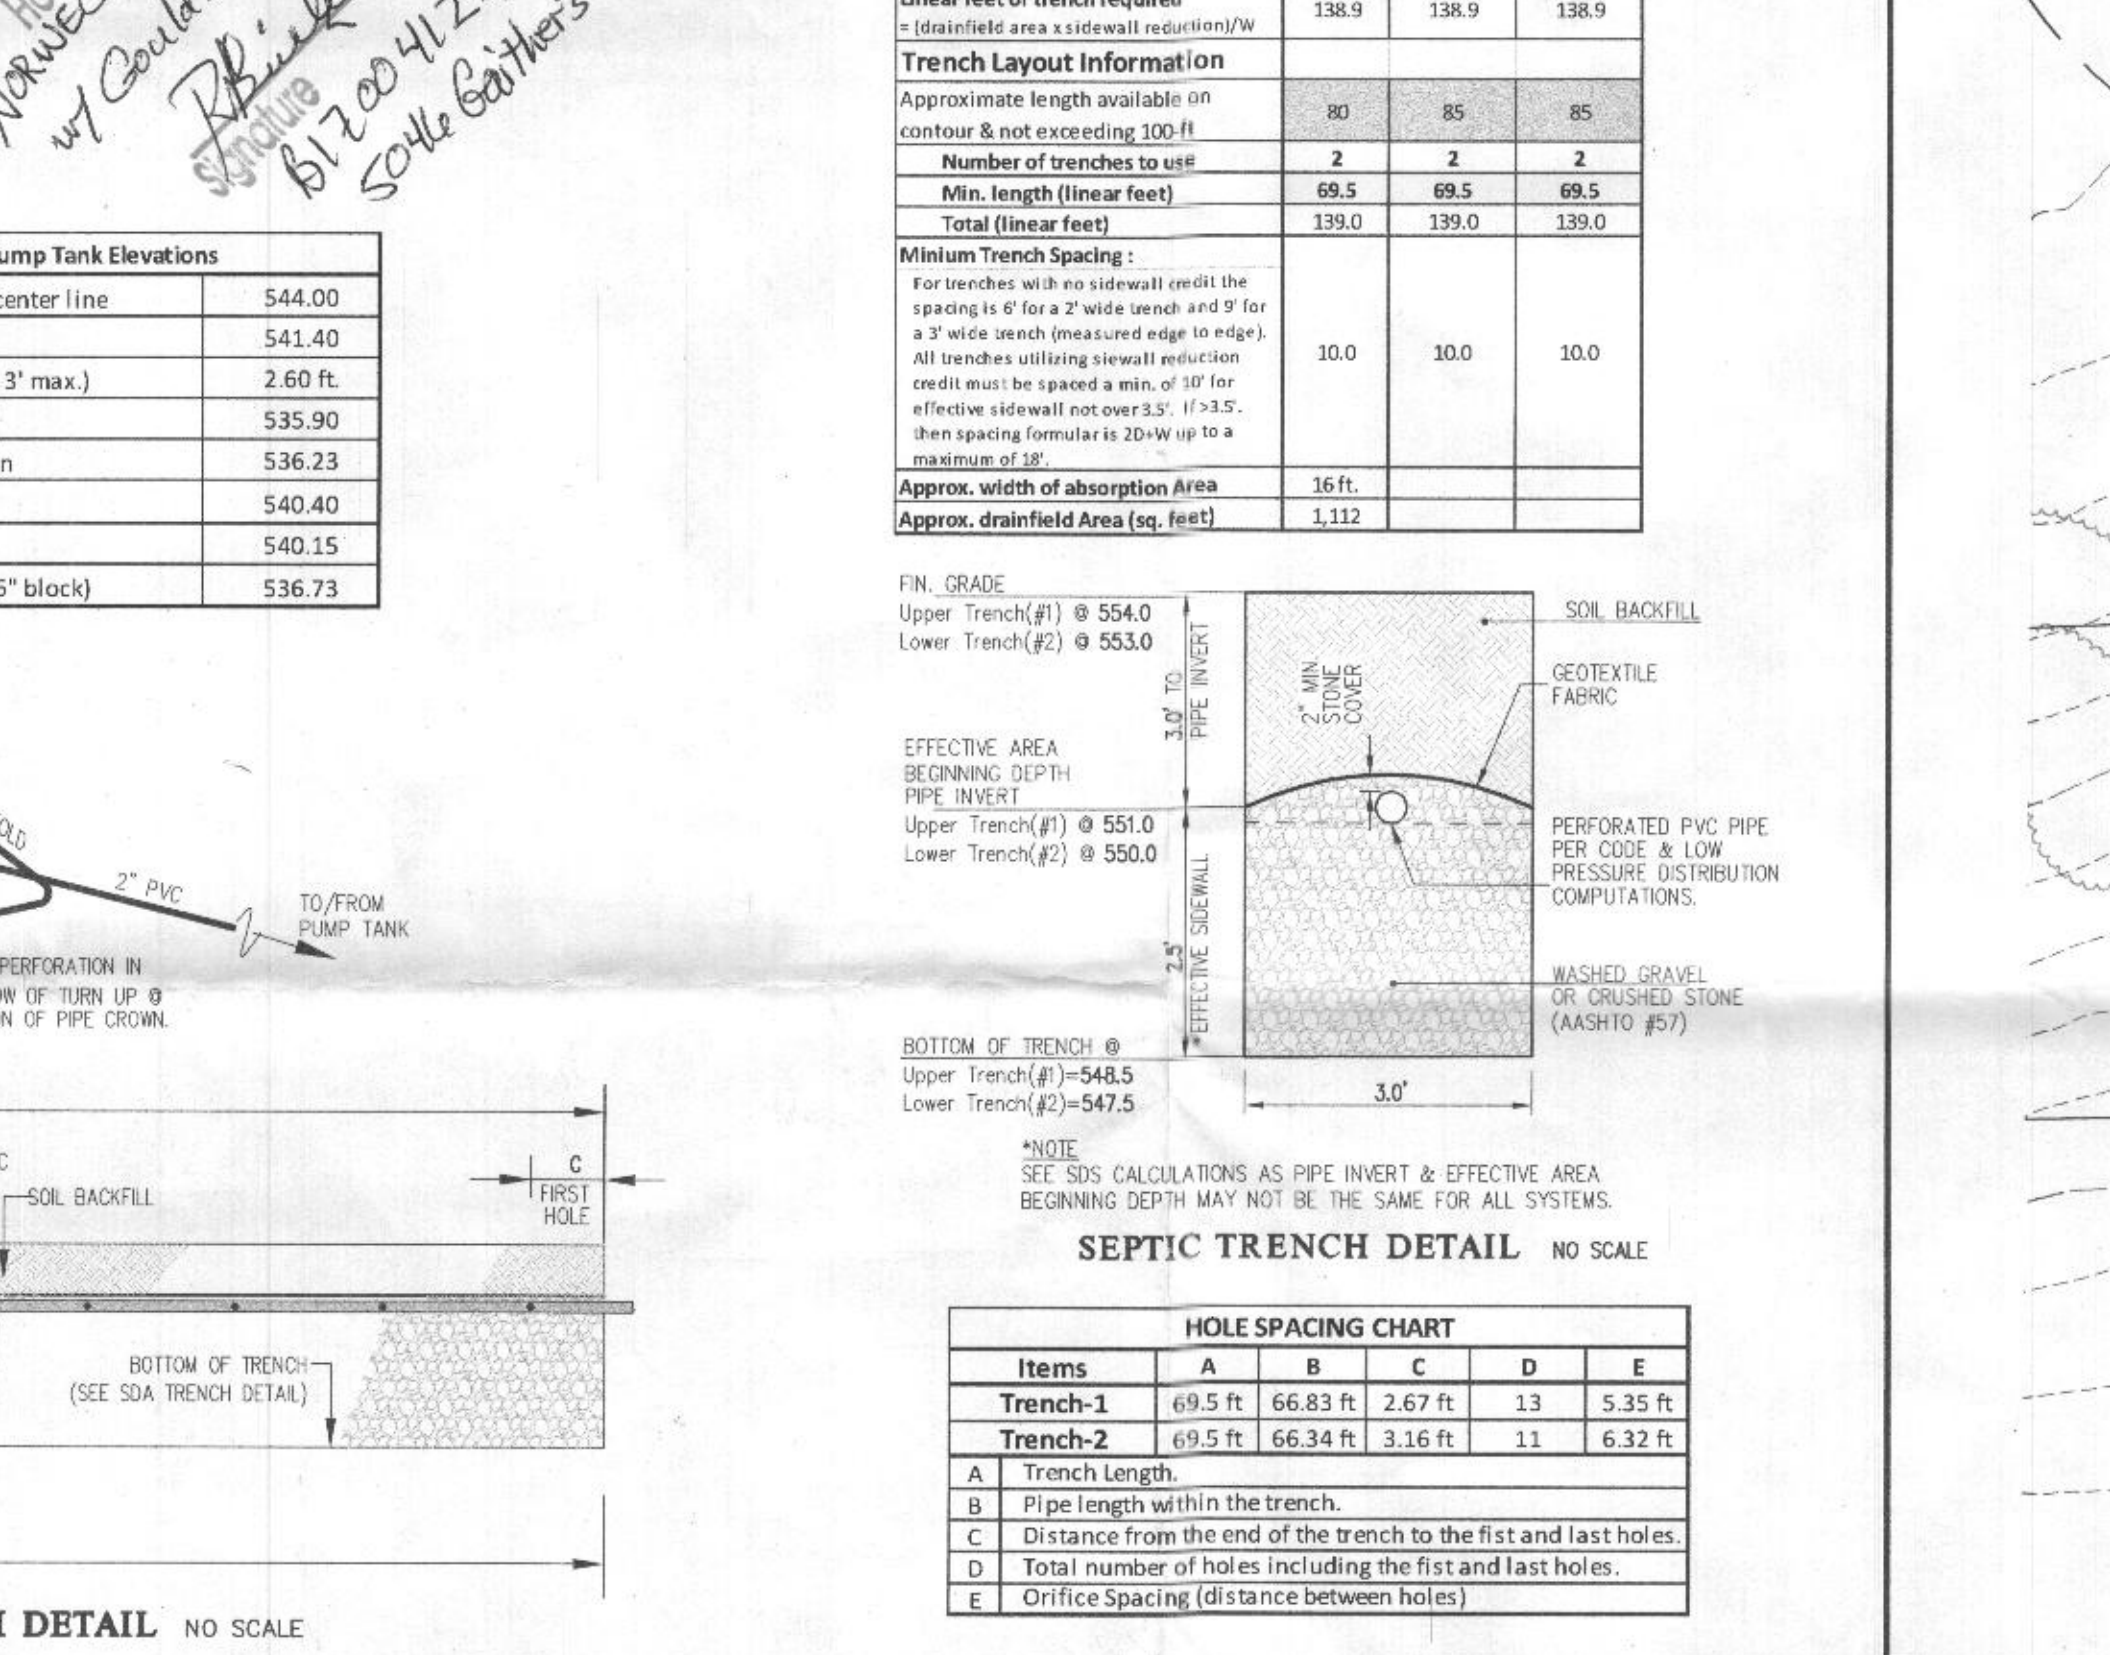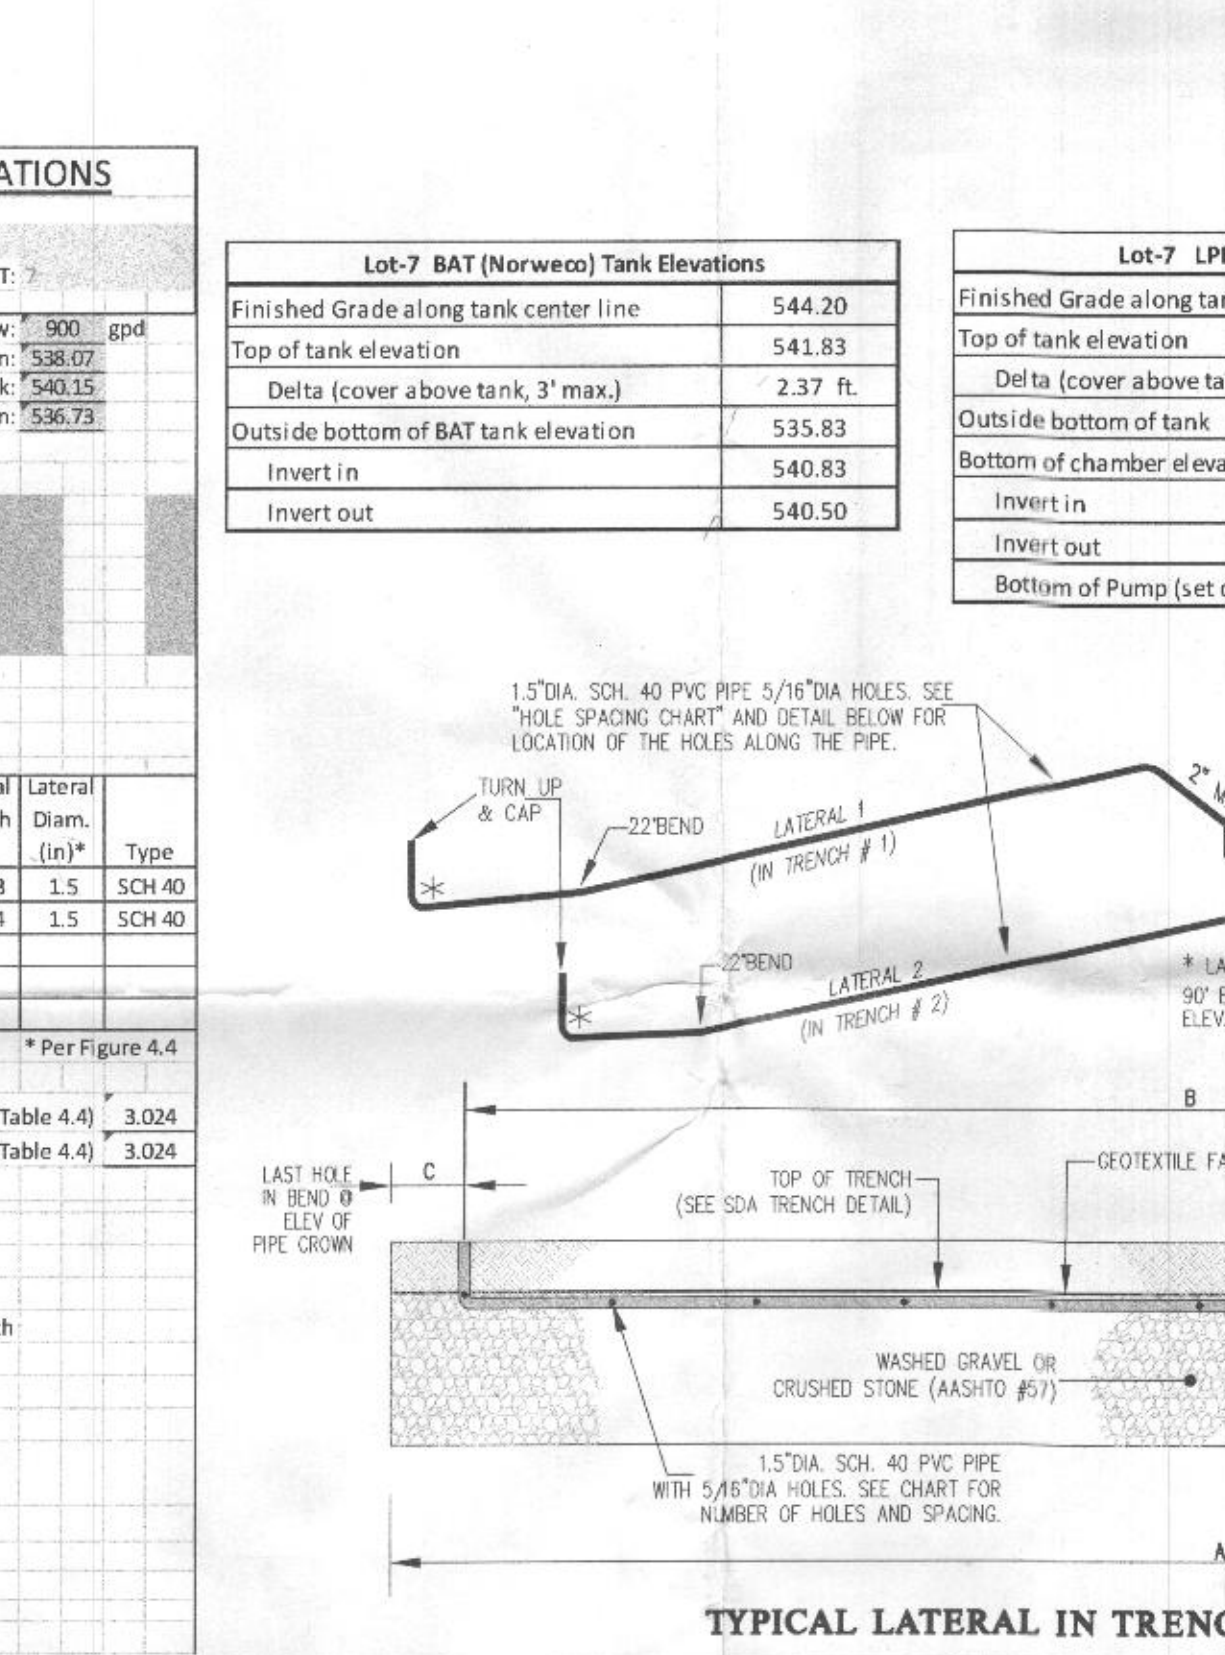

BENCHMARKS

28DA	ELEV. 564.362	N = 570,624.996	E = 1,314,434.172
28EC		N = 570,757.386	E = 1,322,274.727

LEGEND

- 500 EXISTING CONTOUR
- 600 PROPOSED CONTOUR
- FFE FIRST FLOOR ELEVATION
- TGF TOP OF FOUNDATION WALL
- BSE BASEMENT SLAB ELEVATION
- SEPTIC DISPOSAL AREA
- INITIAL SYSTEM 3' WIDE TRENCH
- FIRST REPLACEMENT SYSTEM 3' WIDE TRENCH
- SECOND REPLACEMENT SYSTEM 3' WIDE TRENCH
- TP # PERCOLATION TEST HOLES (PASSED)
- TP # PERCOLATION TEST HOLES (FAILED)

GLWGUTSCHICK LITTLE & WEBER, P.A.

CIVIL ENGINEERS, LAND SURVEYORS, LAND PLANNERS, LANDSCAPE ARCHITECTS

3609 NATIONAL DRIVE - SUITE 250 - BURTONSVILLE OFFICE PARK

BURTONSVILLE, MARYLAND 20866

TEL: 301-421-4024 BALTIMORE: 410-880-1820 DC/VA: 301-989-2524 FAX: 301-421-4186

DATE	REVISION	BY	APPR.

PREPARED FOR:

MB GAITHER'S CHANCE, LLC

1686 E. GUIDE DRIVE

ROCKVILLE, MARYLAND 20850

PH: 301-762-9511

ATTN: MARC QUINT

PROFESSIONAL CERTIFICATION

I HEREBY CERTIFY THAT THESE PLANS WERE PREPARED OR APPROVED BY ME, AND THAT I AM A DULY LICENSED PROFESSIONAL ENGINEER UNDER THE LAWS OF THE STATE OF MARYLAND, LICENSE NO. 12875

EXPIRATION DATE: MAY 26, 2018

12/1/17