
 WATER WELL ABANDONMENT-SEALING REPORT FORM

SUBMIT COPIES OF COMPLETED FORM TO:

- * COUNTY ENVIRONMENTAL AGENCY (contact MDE, WMA if address needed)
- * WELL OWNER
- * MDE, WATER MANAGEMENT ADMINISTRATION, WELL PROGRAM

Approved
 2/2/21 (ST)

DATE WELL ABANDONED: 11/13/20 (month/day/year)

* PERMIT NUMBER OF ABANDONED WELL (if any) N/A

* PERMIT NUMBER OF REPLACEMENT WELL: N/A


* PERSON ABANDONING WELL: BRETT SWEENEY WELL DRILLER'S LICENSE NUMBER: 237

CIRCLE: MWD MSD BMGD

* OWNER'S NAME: BOARD OF ED. HOWARD COUNTY

SITE LOCATION MAP

* WELL-LOCATION:
 COUNTY: HOWARD
 NEAREST TOWN: COLUMBIA
 TAX MAP 0042 BLOCK PARCEL 0405
 SUBDIVISION: 0000
 SECTION: _____ LOT: _____
 STREET ADDRESS: 8800 GUILFORD RD.

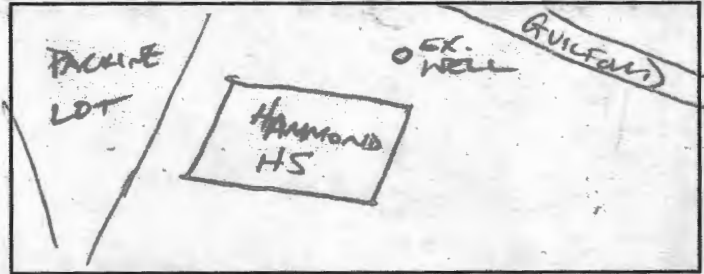

LATITUDE 39.168191

LONGITUDE 76.859709

LOG OF SEALING MATERIAL

MATERIAL	FEET	
	FROM	TO
<u>TOPSOIL</u>	<u>0</u>	<u>1</u>
<u>BENTONITE</u>	<u>1</u>	<u>30</u>

VOLUME OF MATERIAL USED

12 BAGS HOLE PLUG

* TYPE OF WELL BEING ABANDONED:
 DRILLED JETTED
 BORED HAND DUG
 OTHER (specify) _____

* USE CODE:
 DOMESTIC MUNICIPAL/PUBLIC
 IRRIGATION INDUSTRIAL
 TEST/OBSERVATION GEOTHERMAL

* TYPE OF CASING:
 STEEL PLASTIC
 CONCRETE OTHER (specify) _____

SIZE OF CASING: 6 INCHES IN DIAMETER

DEPTH OF WELL: 30 FEET DEEP

WAS ANY CASING REMOVED? YES NO
 If yes, length removed, in feet: _____

WAS CASING RIPPED OR PERFORATED? YES NO

SIGNATURE-MASTER WELL DRILLER OR SUPERVISING SANITARIAN [Signature] LICENSE# 237

MWD MSD MGS
 CIRCLE ONE

12/16/20 DATE

COUNTY

Pursuant to § 10-624 of the State Govt. Article of the Maryland Code, personal info requested on this form is used in processing this form pursuant to COMAR 26.04.04. Failure to provide the info may result in this form not being processed. You have the right to inspect, amend, or correct this form. The Maryland Department of the Environment is subject to the Maryland Public Information Act. This form may be made available on the Internet via MDE's website and is subject to inspection or copying, in whole or in part, by the public and other governmental agencies, if not protected by federal or State Law.