

\*\*\*\*\*  
 WATER WELL ABANDONMENT-SEALING REPORT FORM  
 \*\*\*\*\*

SUBMIT COPIES OF COMPLETED FORM TO:

- \* COUNTY ENVIRONMENTAL AGENCY (contact MDE, WMA if address needed)
- \* WELL OWNER
- \* MDE, WATER MANAGEMENT ADMINISTRATION, WELL PROGRAM

APPROVED  
 06/22/2020  
 [Signature]

DATE WELL ABANDONED: May 6 / 2020 (month/day/year)

X - X - X  
 - - -

- \* PERMIT NUMBER OF ABANDONED WELL (if any)
- \* PERMIT NUMBER OF REPLACEMENT WELL:


\* PERSON ABANDONING WELL: J. Hsu WELL DRILLER'S LICENSE NUMBER: 553

CIRCLE: MWD / MSD / MGD

\* OWNER'S NAME: State Highway Administration

SITE LOCATION MAP

\* WELL LOCATION: Howard  
 COUNTY: Howard  
 NEAREST TOWN: West Friendship  
 TAX MAP 15 BLOCK PARCEL 24  
 SUBDIVISION: 2001  
 SECTION: LOT 3  
 STREET ADDRESS: 3110 LAKE RD

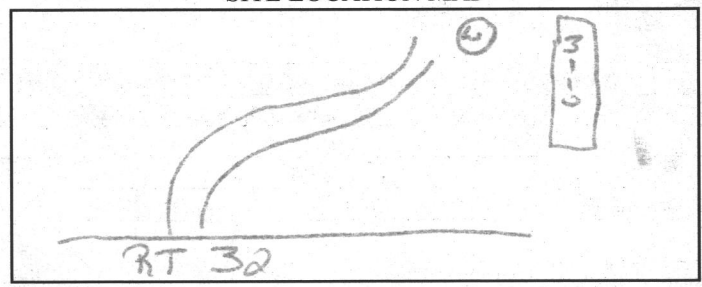

LATITUDE 3 9.284596  
 LONGITUDE 7 6.966081

LOG OF SEALING MATERIAL

MATERIAL	FEET	
	FROM	TO
Quik Grout (Berbrite)	140	0'

VOLUME OF MATERIAL USED

9 50lb bags 234 gallons

- \* TYPE OF WELL BEING ABANDONED:  
 DRILLED  JETTED  
 BORED  HAND DUG  
 OTHER (specify) \_\_\_\_\_

- \* USE CODE:  
 DOMESTIC  MUNICIPAL/PUBLIC  
 IRRIGATION  INDUSTRIAL  
 TEST/OBSERVATION  GEOTHERMAL

- \* TYPE OF CASING:  
 STEEL  PLASTIC  
 CONCRETE  OTHER (specify) \_\_\_\_\_

SIZE OF CASING: 6 INCHES IN DIAMETER

DEPTH OF WELL: 140 FEET DEEP

WAS ANY CASING REMOVED? YES  NO   
 If yes, length removed, in feet: X

WAS CASING RIPPED OR PERFORATED? YES  NO

SIGNATURE-MASTER WELL DRILLER OR SUPERVISING SANITARIAN LICENSE#

553 MWD / MSD / MGS 5/6/20

CIRCLE ONE DATE

COUNTY

Pursuant to § 10-624 of the State Govt. Article of the Maryland Code, personal info requested on this form is used in processing this form pursuant to COMAR 26.04.04. Failure to provide the info may result in this form not being processed. You have the right to inspect, amend, or correct this form. The Maryland Department of the Environment is subject to the Maryland Public Information Act. This form may be made available on the Internet via MDE's website and is subject to inspection or copying, in whole or in part, by the public and other governmental agencies, if not protected by federal or State Law.