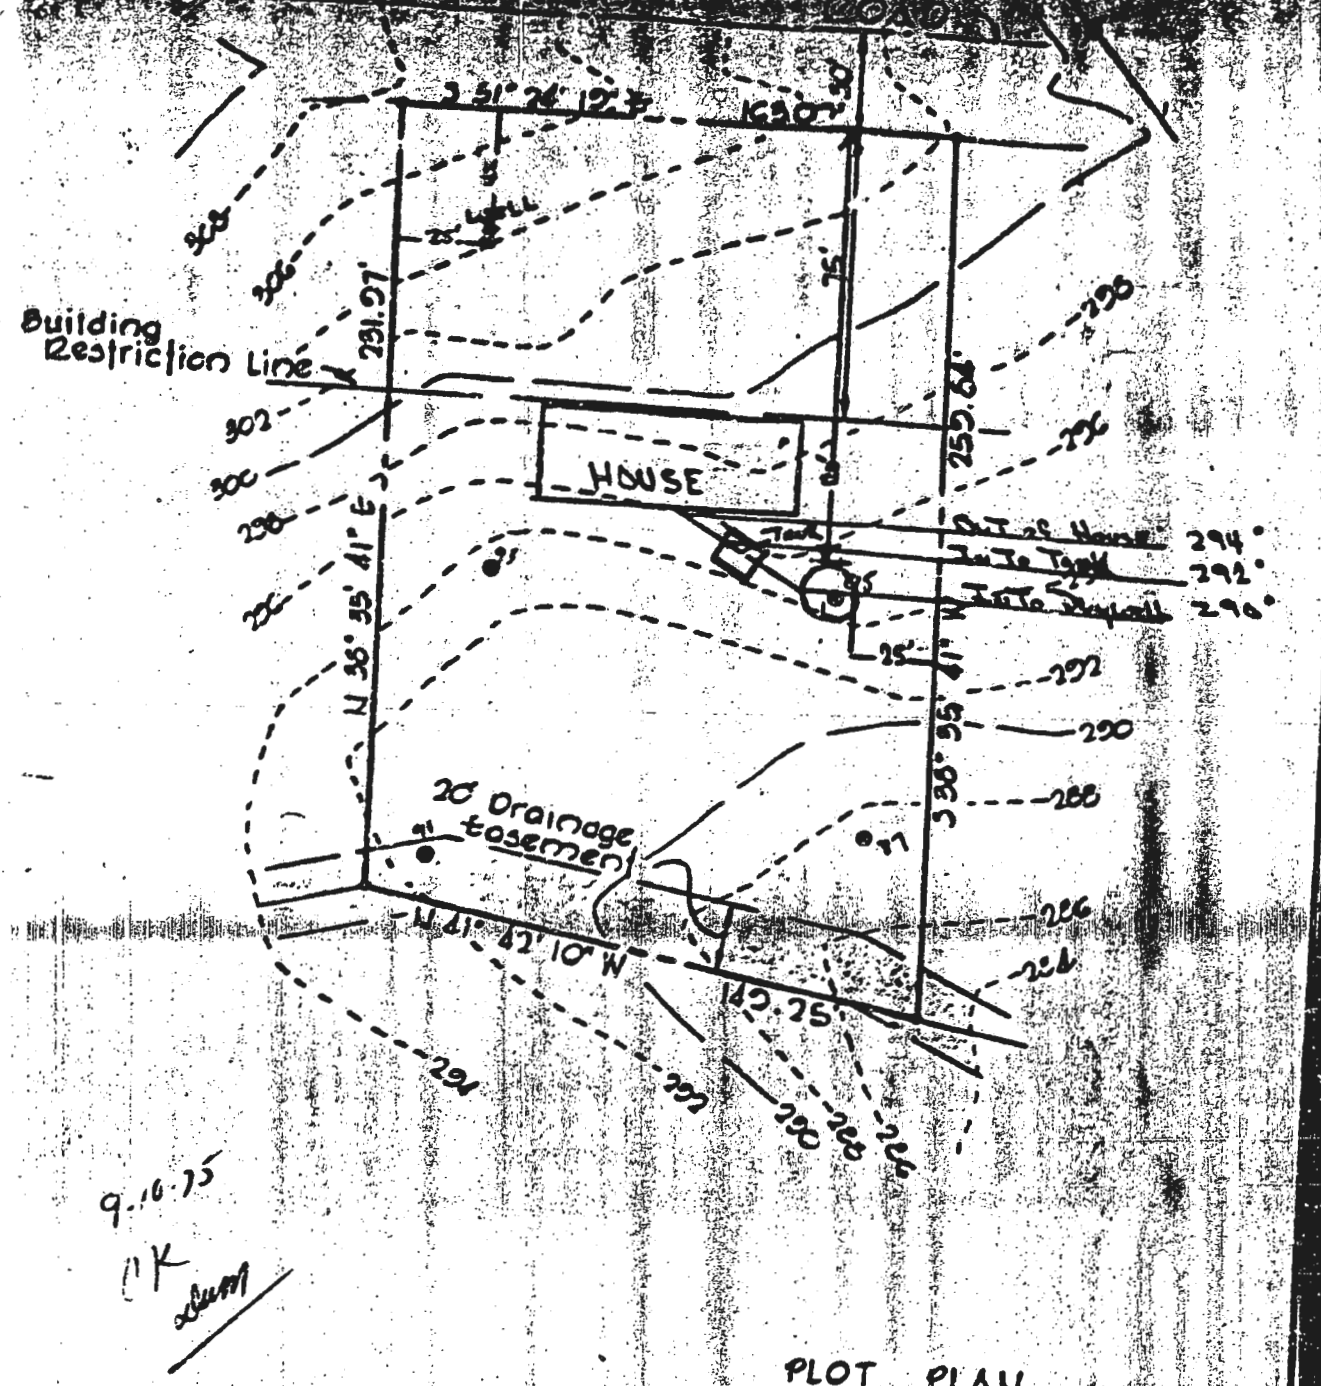

PLOT PLAN
TO ACCOMPANY
BUILDING PERMIT APPLICATION
Lot #2
SHAFFER'S MILL ESTATES
4th ELECTION DIST. HOWARD CO., MD.
July 24, 1975 Scale: 1" = 50'