


NOTES:

- 1) B.R.L. Information, if shown, was obtained from existing record plat or local agencies and is not guaranteed by NTT, Inc.
- 2) Building line and/or Flood Zone Information is subject to the interpretation of the originator.
- 3) NTT, Inc. does not certify to unknown or unrecorded encroachments or overlaps.
- 4) Property markers NOT found, or guaranteed by this location.
- 5) Setback distance accuracy: 1'±

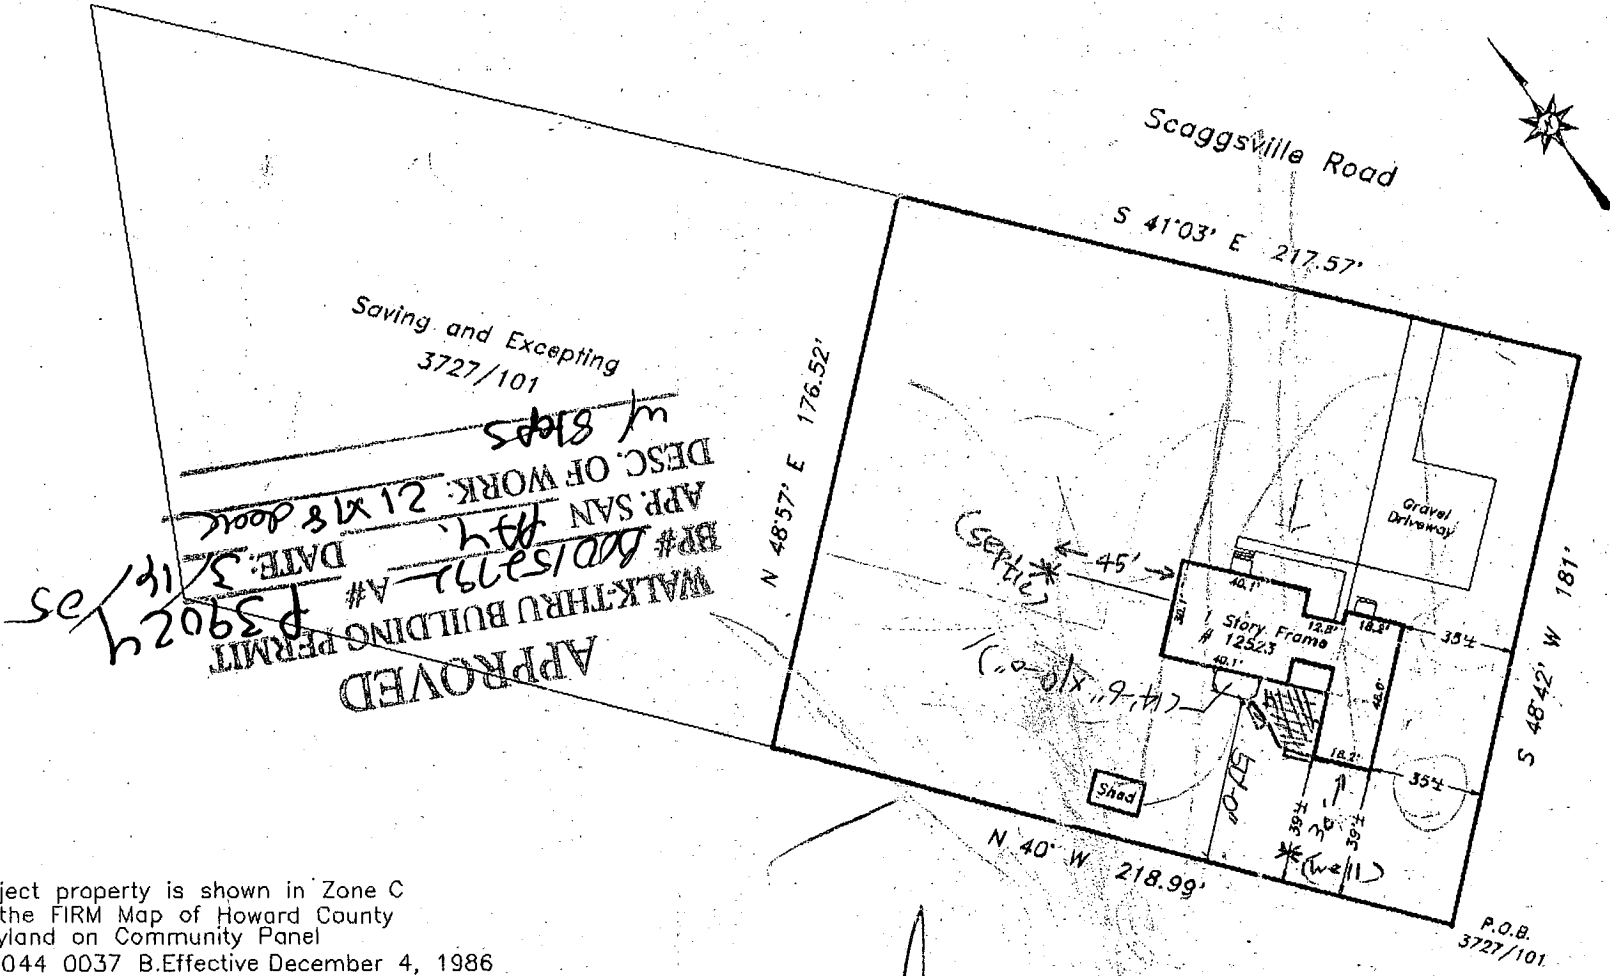


Subject property is shown in Zone C on the FIRM Map of Howard County Maryland on Community Panel 240044 0037 B.Effective December 4, 1986

This is to certify that I have surveyed the property shown hereon, being known as 12523 Scaggsville Road

and recorded among the land records of HOWARD County, Maryland in Liber 3727, folio 101 for the purpose of locating the improvements thereon.

- * This plat is of benefit to the consumer only insofar as it is required by a lender or a title insurance company or its agent in connection with contemplated transfer, financing, or refinancing purposes.
- * This plat is not to be relied upon for the establishment of location of fences, garages, buildings, or other existing or future structures.
- * This plat does not provide for the accurate identification of property boundary lines, but such identification may not be required for the transfer of title or for securing financing or refinancing.

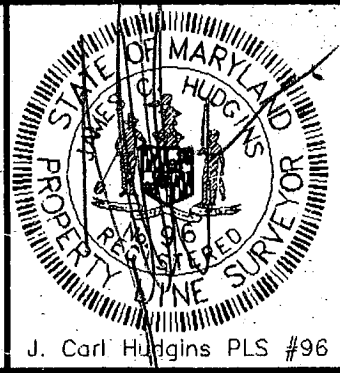

J. Carl Huggins PLS #96

LOCATION DRAWING
12523 Scaggsville Road

HOWARD COUNTY, MD.

NTT Associates, Inc.

16205 Old Frederick Road
Mt. Airy, Maryland 21771
Ph. (410)442-2031
Fax No. (410)442-1315

Scale:	1" = 60'
Date:	4/21/03
Field By:	EDV
Drawn By:	EDV
Drawing #:	1573Bet