

APPLICATION

PERCOLATION TESTING

A 59276

P _____

HOWARD COUNTY HEALTH DEPARTMENT
BUREAU OF ENVIRONMENTAL HEALTH
P O BOX 476 ELLICOTT CITY, MARYLAND 21043
TELEPHONE 461-9933

DISTRICT _____

DATE 12/19/97

TO: THE COUNTY HEALTH OFFICER
ELLICOTT CITY, MARYLAND

I HEREBY APPLY FOR THE NECESSARY TEST IN ORDER TO CONSTRUCT (OR RECONSTRUCT) A SEWAGE DISPOSAL SYSTEM.

PROPERTY OWNER Bruce A. Manger

ADDRESS 2719 St. Paul Street, Baltimore, MD 21218 PHONE 410-467-9700

PROSPECTIVE BUYER Heritage Land Development

ADDRESS 3243 Bethany Lane, Ellicott City, MD 21042 PHONE 410-313-8808

PROPERTY LOCATION:

SUBDIVISION Peacefields LOT NO 10

ROAD AND DESCRIPTION MD Route 97

TAX MAP 21 PARCEL # 63

SIZE OF LOT 1 Acre ± TYPE BLDG S. F. D.
(SINGLE FAMILY DWELLING OR COMMERCIAL)

THE SYSTEM INSTALLED UNDER THIS APPLICATION IS ACCEPTABLE ONLY UNTIL PUBLIC FACILITIES BECOME AVAILABLE. I FULLY UNDERSTAND THE FEE CONNECTED WITH THE FILING OF THIS PERC TEST APPLICATION IS NON-REFUNDABLE UNDER ANY CIRCUMSTANCES. I ALSO AGREE TO COMPLY WITH ALL M.O.S.H.A. REQUIREMENTS IN TESTING THIS LOT.


(SIGNATURE OF APPLICANT)

APPROVED BY _____ FOR _____ DATE _____

REJECTED BY _____ FOR _____ DATE _____

HOLD PENDING FURTHER TESTS _____ DATE _____


REASONS FOR REJECTION OR HOLDING _____

THIS IS NOT A PERMIT

HD-216

A
 12" BRN SL
 2 SBL MFR
 MICACEOUS
 ROOT
 29" RED YEL BRN
 S LOAM SBL
 WSS WSD FEW CHERT
 MH DEPOSITS
 RED BRN
 SL SBL
 MH CHERT 5'
 60" YEL BRN
 SLSL
 DMFR

6" Blw Yellow
 SLSL
 14" YEL RED
 SBL SBL

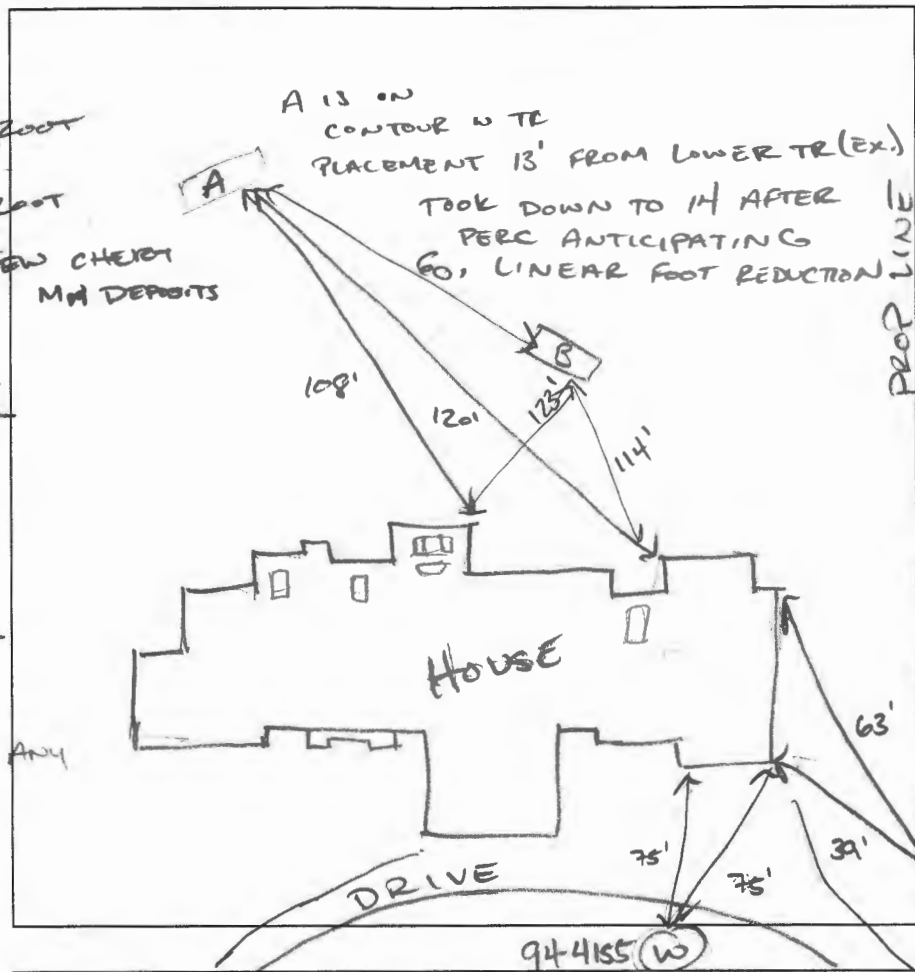

B
 12" YEL RED SCL
 29" RED BRN
 60"
 14"

SAME AS A

DATE	TEST #	DEPTH	START	BREAK 1" DROP	STOP 2" DROP	TIME OF 2ND INCH	P/F/H	
12/10/2020	A	5 / 14	0:00	9:00	28:45	19:45	P	
		4 / 12	RESTHELFED - REFUSED					
12/10/2020	B	5 / 14	0:00	10:00	26:00	16:00	P	

94-2545

EX SYSTEM COMPLETELY SATURATED ALL 3 TR
 REMARKS 60" CLEVELL LOAM. NO SIGNS OF PEDOC FEATURES
 SANITARIAN CABAHUG 00997 BACKHOE HATFIELD'S OTHERS TODD
 TEST HOLES USED IN SDA _____ AVG. PERC TIME _____ SQ. FT/BR 6
 TRENCH WIDTH 2' INLET DEPTH 4' MAX. BOT DEPTH 10' EFFECTIVE SW 5'

$$\frac{150 \cdot 6 \text{ RC}}{0.6} = 1500$$

2'	750	.31	232.5'
3'	500	.36	180



United States
Department of
Agriculture

NRCS

Natural
Resources
Conservation
Service


A product of the National
Cooperative Soil Survey,
a joint effort of the United
States Department of
Agriculture and other
Federal agencies, State
agencies including the
Agricultural Experiment
Stations, and local
participants

Custom Soil Resource Report for Howard County, Maryland



December 1, 2020

Custom Soil Resource Report Soil Map

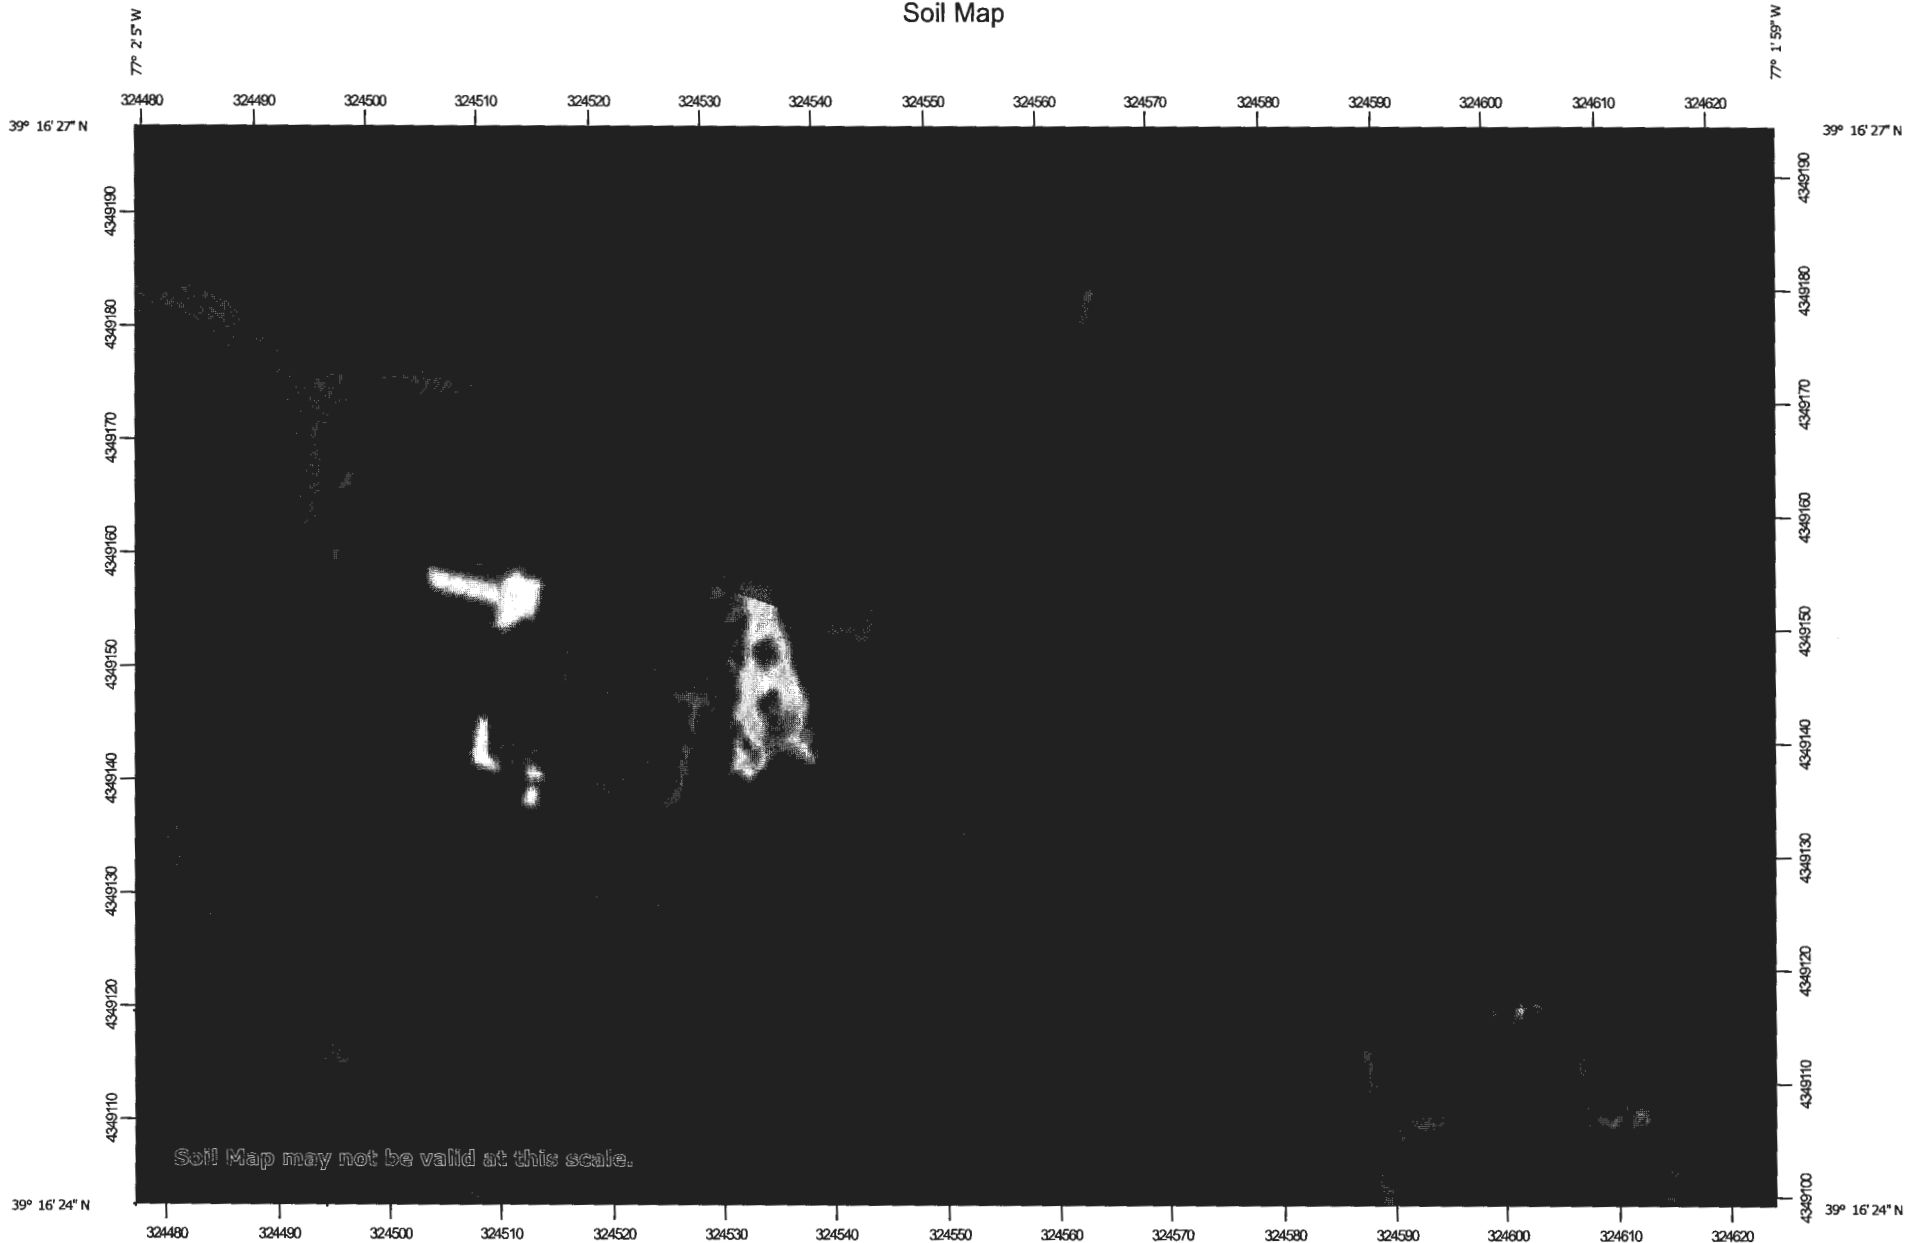

77° 2' 5\"



Map Scale: 1:671 if printed on A landscape (11" x 8.5") sheet.


0 5 10 20 30 Meters

0 30 60 120 180 Feet

Map projection: Web Mercator Corner coordinates: WGS84 Edge tics: UTM Zone 18N WGS84

MAP LEGEND

Area of Interest (AOI)

 Area of Interest (AOI)

Soils

 Soil Map Unit Polygons


 Soil Map Unit Lines

 Soil Map Unit Points

Special Point Features

 Blowout

 Borrow Pit

 Clay Spot

 Closed Depression

 Gravel Pit

 Gravelly Spot

 Landfill

 Lava Flow


 Marsh or swamp


 Mine or Quarry

 Miscellaneous Water


 Perennial Water


 Rock Outcrop


 Saline Spot

 Sandy Spot


 Severely Eroded Spot

 Sinkhole

 
 Slide or Slip


 Sodic Spot

 Spoil Area

 Stony Spot

 Very Stony Spot

  Wet Spot

 Other

 Special Line Features

Water Features

 Streams and Canals

Transportation

 Rails

 Interstate Highways

 US Routes

 Major Roads

 Local Roads

Background

 Aerial Photography

MAP INFORMATION

The soil surveys that comprise your AOI were mapped at 1:12,000.

Warning: Soil Map may not be valid at this scale.

Enlargement of maps beyond the scale of mapping can cause misunderstanding of the detail of mapping and accuracy of soil line placement. The maps do not show the small areas of contrasting soils that could have been shown at a more detailed scale.

Please rely on the bar scale on each map sheet for map measurements.

Source of Map: Natural Resources Conservation Service

Web Soil Survey URL:

Coordinate System: Web Mercator (EPSG:3857)

Maps from the Web Soil Survey are based on the Web Mercator projection, which preserves direction and shape but distorts distance and area. A projection that preserves area, such as the Albers equal-area conic projection, should be used if more accurate calculations of distance or area are required.

This product is generated from the USDA-NRCS certified data as of the version date(s) listed below.

Soil Survey Area: Howard County, Maryland

Survey Area Data: Version 15, Jun 12, 2020

Soil map units are labeled (as space allows) for map scales 1:50,000 or larger.

Date(s) aerial images were photographed: May 3, 2015—Feb 22, 2017

The orthophoto or other base map on which the soil lines were compiled and digitized probably differs from the background imagery displayed on these maps. As a result, some minor shifting of map unit boundaries may be evident.

Howard County, Maryland

GaD—Gaila loam, 15 to 25 percent slopes

Map Unit Setting

National map unit symbol: vm2b
Elevation: 250 to 1,050 feet
Mean annual precipitation: 35 to 50 inches
Mean annual air temperature: 48 to 57 degrees F
Frost-free period: 150 to 255 days
Farmland classification: Not prime farmland

Map Unit Composition

Gaila and similar soils: 85 percent
Minor components: 15 percent
Estimates are based on observations, descriptions, and transects of the mapunit.

Description of Gaila

Setting

Landform: Hillslopes, ridges
Landform position (two-dimensional): Backslope
Landform position (three-dimensional): Nose slope, interfluvium, side slope
Down-slope shape: Convex
Across-slope shape: Convex
Parent material: Residuum weathered from quartz muscovite schist

Typical profile

Ap - 0 to 8 inches: silt loam
Bt - 8 to 17 inches: loam
BC - 17 to 20 inches: loam
C - 20 to 76 inches: sandy loam

Properties and qualities

Slope: 15 to 25 percent
Depth to restrictive feature: More than 80 inches
Drainage class: Well drained
Runoff class: Medium
Capacity of the most limiting layer to transmit water (Ksat): Moderately high to high
(0.57 to 1.98 in/hr)
Depth to water table: More than 80 inches
Frequency of flooding: None
Frequency of ponding: None
Available water capacity: Moderate (about 7.8 inches)

Interpretive groups

Land capability classification (irrigated): None specified
Land capability classification (nonirrigated): 4e
Hydrologic Soil Group: B
Hydric soil rating: No

Minor Components

Manor

Percent of map unit: 15 percent
Landform: Hillslopes, ridges

Custom Soil Resource Report

Landform position (two-dimensional): Backslope
Landform position (three-dimensional): Interfluve, side slope
Down-slope shape: Convex
Across-slope shape: Convex
Hydric soil rating: No

GgA—Glenelg loam, 0 to 3 percent slopes

Map Unit Setting

National map unit symbol: 2w062
Elevation: 30 to 1,200 feet
Mean annual precipitation: 40 to 55 inches
Mean annual air temperature: 48 to 57 degrees F
Frost-free period: 150 to 192 days
Farmland classification: All areas are prime farmland

Map Unit Composition

Glenelg and similar soils: 85 percent
Minor components: 15 percent
Estimates are based on observations, descriptions, and transects of the mapunit.

Description of Glenelg

Setting

Landform: Hillslopes
Landform position (two-dimensional): Backslope, summit, shoulder
Landform position (three-dimensional): Side slope
Down-slope shape: Linear
Across-slope shape: Convex, linear, concave
Parent material: Residuum weathered from mica schist

Typical profile

Ap1 - 0 to 6 inches: loam
Ap2 - 6 to 10 inches: clay loam
Bt1 - 10 to 18 inches: clay loam
Bt2 - 18 to 25 inches: clay loam
Bt3 - 25 to 30 inches: clay loam
BCt - 30 to 42 inches: loam
CBt - 42 to 54 inches: loam
C - 54 to 76 inches: very channery fine sandy loam

Properties and qualities

Slope: 0 to 3 percent
Depth to restrictive feature: More than 80 inches
Drainage class: Well drained
Runoff class: Medium
Capacity of the most limiting layer to transmit water (Ksat): Moderately high to high
(0.20 to 1.98 in/hr)
Depth to water table: More than 80 inches
Frequency of flooding: None

Custom Soil Resource Report

Frequency of ponding: None
Available water capacity: High (about 10.9 inches)

Interpretive groups

Land capability classification (irrigated): None specified
Land capability classification (nonirrigated): 1
Hydrologic Soil Group: B
Hydric soil rating: No

Minor Components

Brinklow

Percent of map unit: 10 percent
Landform: Hillslopes
Landform position (two-dimensional): Backslope, shoulder, summit
Landform position (three-dimensional): Side slope
Down-slope shape: Convex
Across-slope shape: Convex
Hydric soil rating: No

Glenville

Percent of map unit: 5 percent
Landform: Swales, drainageways
Landform position (two-dimensional): Footslope, backslope
Landform position (three-dimensional): Head slope, interfluve, base slope
Down-slope shape: Linear, concave
Across-slope shape: Concave, linear
Hydric soil rating: No

GgB—Glenelg loam, 3 to 8 percent slopes

Map Unit Setting

National map unit symbol: 2v7gp
Elevation: 30 to 1,200 feet
Mean annual precipitation: 40 to 55 inches
Mean annual air temperature: 48 to 57 degrees F
Frost-free period: 150 to 192 days
Farmland classification: All areas are prime farmland

Map Unit Composition

Glenelg and similar soils: 85 percent
Minor components: 15 percent
Estimates are based on observations, descriptions, and transects of the mapunit.

Description of Glenelg

Setting

Landform: Interfluves, hillslopes
Landform position (two-dimensional): Summit, backslope, shoulder
Landform position (three-dimensional): Interfluve, side slope
Down-slope shape: Linear

Custom Soil Resource Report

Across-slope shape: Convex, linear, concave
Parent material: Residuum weathered from mica schist

Typical profile

Ap1 - 0 to 6 inches: loam
Ap2 - 6 to 10 inches: clay loam
Bt1 - 10 to 18 inches: clay loam
Bt2 - 18 to 25 inches: clay loam
Bt3 - 25 to 30 inches: clay loam
BCt - 30 to 42 inches: loam
CBt - 42 to 54 inches: loam
C - 54 to 76 inches: channery fine sandy loam

Properties and qualities

Slope: 3 to 8 percent
Depth to restrictive feature: More than 80 inches
Drainage class: Well drained
Runoff class: Medium
Capacity of the most limiting layer to transmit water (Ksat): Moderately high to high
(0.20 to 1.98 in/hr)
Depth to water table: More than 80 inches
Frequency of flooding: None
Frequency of ponding: None
Available water capacity: High (about 10.4 inches)

Interpretive groups

Land capability classification (irrigated): None specified
Land capability classification (nonirrigated): 2e
Hydrologic Soil Group: B
Hydric soil rating: No

Minor Components

Gaila

Percent of map unit: 10 percent
Landform: Hillslopes, ridges
Landform position (two-dimensional): Backslope, shoulder
Landform position (three-dimensional): Side slope
Down-slope shape: Convex
Across-slope shape: Linear
Hydric soil rating: No

Glenville

Percent of map unit: 5 percent
Landform: Drainageways, swales
Landform position (two-dimensional): Shoulder, backslope
Landform position (three-dimensional): Side slope
Down-slope shape: Concave
Across-slope shape: Linear
Hydric soil rating: No

MaD—Manor loam, 15 to 25 percent slopes

Map Unit Setting

National map unit symbol: 2tmcg
Elevation: 250 to 1,000 feet
Mean annual precipitation: 40 to 55 inches
Mean annual air temperature: 48 to 57 degrees F
Frost-free period: 150 to 192 days
Farmland classification: Not prime farmland

Map Unit Composition

Manor and similar soils: 85 percent
Minor components: 15 percent
Estimates are based on observations, descriptions, and transects of the mapunit.

Description of Manor

Setting

Landform: Hillslopes
Landform position (two-dimensional): Shoulder, backslope, summit
Landform position (three-dimensional): Side slope
Down-slope shape: Convex
Across-slope shape: Convex
Parent material: Residuum weathered from mica schist

Typical profile

A1 - 0 to 2 inches: loam
A2 - 2 to 6 inches: sandy loam
Bw1 - 6 to 13 inches: fine sandy loam
Bw2 - 13 to 22 inches: fine sandy loam
C1 - 22 to 30 inches: fine sandy loam
C2 - 30 to 44 inches: channery coarse sand
C3 - 44 to 53 inches: loamy sand
C4 - 53 to 83 inches: channery loamy sand
Cr - 83 to 108 inches: bedrock
R - 108 to 138 inches: bedrock

Properties and qualities

Slope: 15 to 25 percent
Surface area covered with cobbles, stones or boulders: 0.0 percent
Depth to restrictive feature: 59 to 100 inches to paralithic bedrock; 100 to 128 inches to lithic bedrock
Drainage class: Well drained
Capacity of the most limiting layer to transmit water (Ksat): Moderately low (0.01 to 0.07 in/hr)
Depth to water table: More than 80 inches
Frequency of flooding: None
Frequency of ponding: None
Available water capacity: Moderate (about 8.0 inches)

Interpretive groups

Land capability classification (irrigated): None specified
Land capability classification (nonirrigated): 4e
Hydrologic Soil Group: B
Hydric soil rating: No

Minor Components

Blocktown

Percent of map unit: 5 percent
Landform: Hillslopes
Landform position (two-dimensional): Backslope
Landform position (three-dimensional): Side slope
Down-slope shape: Convex
Across-slope shape: Convex
Hydric soil rating: No


Glenville

Percent of map unit: 5 percent
Landform: Drainageways, swales
Landform position (two-dimensional): Footslope, backslope
Landform position (three-dimensional): Base slope, head slope, interfluve
Down-slope shape: Linear
Across-slope shape: Concave
Hydric soil rating: No

Mt. airy

Percent of map unit: 5 percent
Landform: Hillslopes
Landform position (two-dimensional): Backslope, summit, shoulder
Landform position (three-dimensional): Nose slope
Down-slope shape: Convex
Across-slope shape: Convex
Hydric soil rating: No

Custom Soil Resource Report
Map—Drainage Class (15521 Cattail Oaks - Drainage)

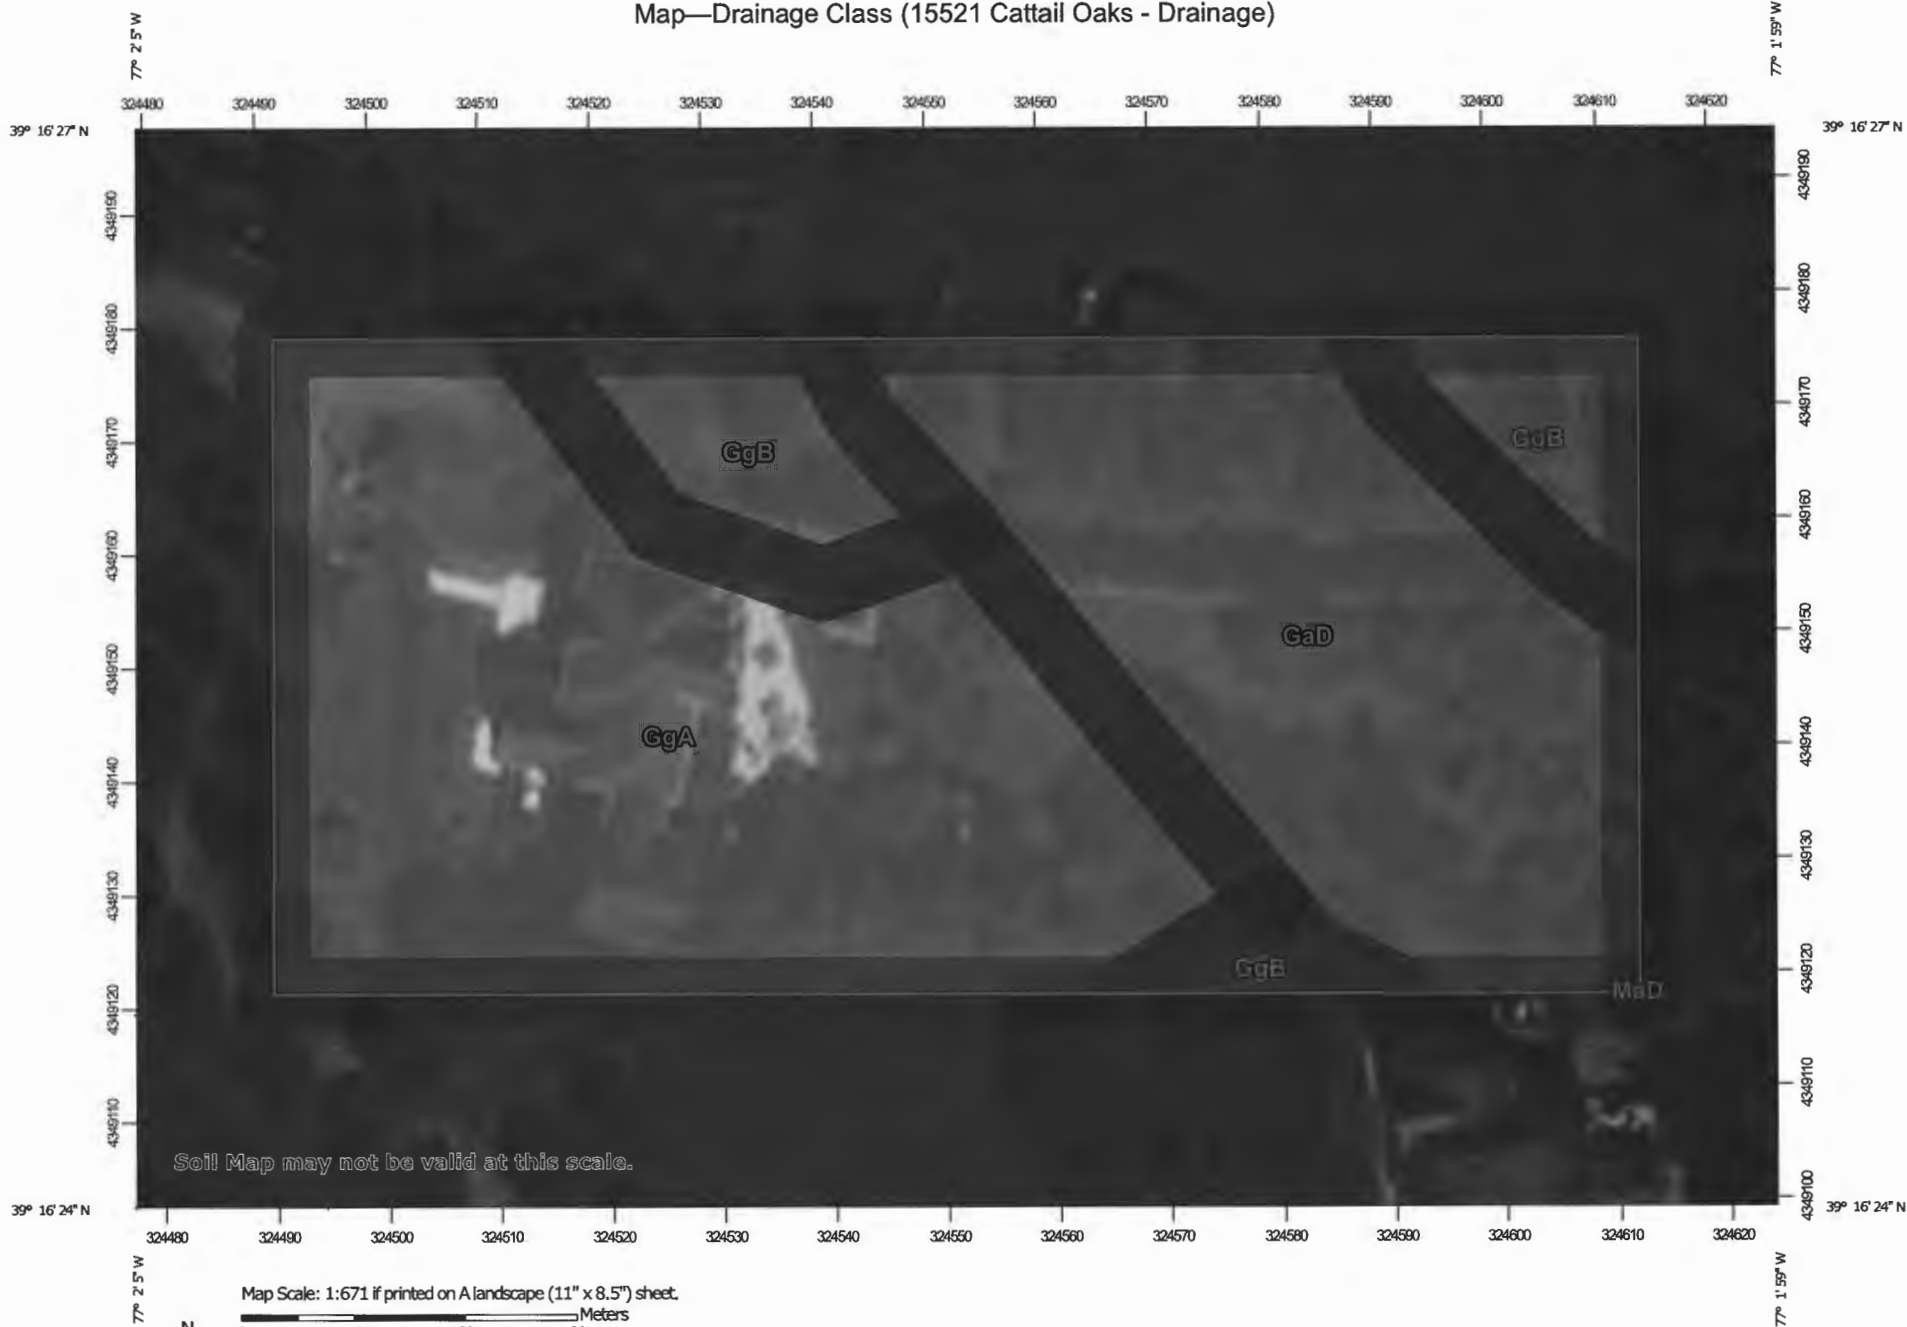

Soil Map may not be valid at this scale.

Map Scale: 1:671 if printed on A landscape (11" x 8.5") sheet.


0 5 10 20 30 Meters

0 30 60 120 180 Feet

Map projection: Web Mercator Corner coordinates: WGS84 Edge tics: UTM Zone 18N WGS84




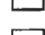





MAP LEGEND

Area of Interest (AOI)










 Area of Interest (AOI)

Soils










Soil Rating Polygons

-  Excessively drained
-  Somewhat excessively drained
-  Well drained
-  Moderately well drained
-  Somewhat poorly drained
-  Poorly drained
-  Very poorly drained
-  Subaqueous
-  Not rated or not available


Soil Rating Lines

-  Excessively drained
-  Somewhat excessively drained
-  Well drained
-  Moderately well drained
-  Somewhat poorly drained
-  Poorly drained
-  Very poorly drained
-  Subaqueous
-  Not rated or not available


Soil Rating Points

-  Excessively drained
-  Somewhat excessively drained
-  Well drained
-  Moderately well drained
-  Somewhat poorly drained
-  Poorly drained
-  Very poorly drained
-  Subaqueous
-  Not rated or not available


Water Features

 Streams and Canals

Transportation

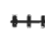-  Rails
-  Interstate Highways
-  US Routes
-  Major Roads
-  Local Roads

Background

 Aerial Photography

MAP INFORMATION

The soil surveys that comprise your AOI were mapped at 1:12,000.

Warning: Soil Map may not be valid at this scale.

Enlargement of maps beyond the scale of mapping can cause misunderstanding of the detail of mapping and accuracy of soil line placement. The maps do not show the small areas of contrasting soils that could have been shown at a more detailed scale.

Please rely on the bar scale on each map sheet for map measurements.

Source of Map: Natural Resources Conservation Service
 Web Soil Survey URL:
 Coordinate System: Web Mercator (EPSG:3857)

Maps from the Web Soil Survey are based on the Web Mercator projection, which preserves direction and shape but distorts distance and area. A projection that preserves area, such as the Albers equal-area conic projection, should be used if more accurate calculations of distance or area are required.

This product is generated from the USDA-NRCS certified data as of the version date(s) listed below.

Soil Survey Area: Howard County, Maryland
 Survey Area Data: Version 15, Jun 12, 2020

Soil map units are labeled (as space allows) for map scales 1:50,000 or larger.

Date(s) aerial images were photographed: May 3, 2015—Feb 22, 2017

The orthophoto or other base map on which the soil lines were compiled and digitized probably differs from the background imagery displayed on these maps. As a result, some minor shifting of map unit boundaries may be evident.

Table—Drainage Class (15521 Cattail Oaks - Drainage)

Map unit symbol	Map unit name	Rating	Acres in AOI	Percent of AOI
GaD	Gaila loam, 15 to 25 percent slopes	Well drained	0.6	36.1%
GgA	Glenelg loam, 0 to 3 percent slopes	Well drained	0.9	50.6%
GgB	Glenelg loam, 3 to 8 percent slopes	Well drained	0.2	13.3%
MaD	Manor loam, 15 to 25 percent slopes	Well drained	0.0	0.0%
Totals for Area of Interest			1.8	100.0%

Rating Options—Drainage Class (15521 Cattail Oaks - Drainage)

Aggregation Method: Dominant Condition

Component Percent Cutoff: None Specified

Tie-break Rule: Higher

Custom Soil Resource Report

Three values are provided to identify the expected Low (L), Representative Value (R), and High (H).

Physical Soil Properties—Howard County, Maryland														
Map symbol and soil name	Depth	Sand	Silt	Clay	Moist bulk density	Saturated hydraulic conductivity	Available water capacity	Linear extensibility	Organic matter	Erosion factors			Wind erodibility group	Wind erodibility index
										Kw	Kf	T		
	<i>In</i>	<i>Pct</i>	<i>Pct</i>	<i>Pct</i>	<i>g/cc</i>	<i>micro m/sec</i>	<i>In/In</i>	<i>Pct</i>	<i>Pct</i>					
GaD—Gaila loam, 15 to 25 percent slopes														
Gaila	0-8	5-35- 52	28-52- 85	5-13- 20	1.40-1.45-1.55	4.00-9.00-14.00	0.06-0.14-0.20	0.0- 1.5- 2.9	0.5- 0.5- 1.0	.55	.55	5	3	86
	8-17	40-43- 60	20-40- 50	10-18- 25	1.10-1.25-1.40	4.00-9.00-14.00	0.17-0.19-0.21	0.0- 1.5- 2.9	1.0- 2.0- 3.0	.37	.37			
	17-20	40-43- 60	20-40- 50	10-18- 25	1.10-1.25-1.40	4.00-9.00-14.00	0.17-0.19-0.21	0.0- 1.5- 2.9	1.0- 2.0- 3.0	.37	.37			
	20-76	45-68- 80	5-20- 30	5-13- 20	1.25-1.38-1.50	14.00-28.00-42.00	0.08-0.11-0.14	0.0- 1.5- 2.9	0.3- 0.4- 0.5	.24	.24			

Custom Soil Resource Report

Physical Soil Properties—Howard County, Maryland														
Map symbol and soil name	Depth	Sand	Silt	Clay	Moist bulk density	Saturated hydraulic conductivity	Available water capacity	Linear extensibility	Organic matter	Erosion factors			Wind erodibility group	Wind erodibility index
										Kw	Kf	T		
	In	Pct	Pct	Pct	g/cc	micro m/sec	In/In	Pct	Pct					
GgA—Glenelg loam, 0 to 3 percent slopes														
Glenelg	0-6	24-32- 52	35-43- 50	7-25- 27	1.30-1.38-1.47	4.00-9.00-14.00	0.09-0.16-0.17	0.1- 1.0- 1.3	1.0- 2.5- 6.0	.24	.24	4	6	48
	6-10	10-29- 52	35-44- 68	7-27- 30	1.43-1.46-1.50	4.00-12.00-14.00	0.09-0.17-0.17	0.2- 2.2- 2.9	0.8- 2.0- 4.0	.28	.28			
	10-18	10-26- 40	27-46- 63	20-29- 35	1.47-1.52-1.56	1.40-9.00-14.00	0.10-0.20-0.22	0.6- 2.5- 3.7	0.1- 0.1- 0.5	.37	.37			
	18-25	24-27- 65	12-46- 50	7-28- 35	1.54-1.56-1.59	1.40-9.00-14.00	0.10-0.20-0.22	0.2- 2.3- 3.7	0.0- 0.1- 0.3	.37	.37			
	25-30	24-29- 65	10-43- 47	7-28- 35	1.54-1.62-1.70	1.40-9.00-14.00	0.10-0.17-0.23	0.2- 2.5- 3.7	0.0- 0.1- 0.2	.37	.37			
	30-42	10-42- 52	28-34- 65	7-25- 30	1.51-1.53-1.55	4.00-12.00-14.00	0.05-0.21-0.23	0.1- 1.7- 2.8	0.0- 0.1- 0.1	.32	.32			
	42-54	30-38- 83	10-38- 50	7-24- 25	1.60-1.62-1.64	4.00-12.00-14.00	0.05-0.21-0.23	0.1- 1.6- 1.9	0.0- 0.0- 0.1	.37	.37			
	54-76	50-68- 75	20-28- 35	1- 4- 15	1.58-1.60-1.61	4.00-28.00-42.00	0.01-0.06-0.14	0.0- 0.0- 0.7	0.0- 0.0- 0.1	.10	.43			

Custom Soil Resource Report

Physical Soil Properties—Howard County, Maryland														
Map symbol and soil name	Depth	Sand	Silt	Clay	Moist bulk density	Saturated hydraulic conductivity	Available water capacity	Linear extensibility	Organic matter	Erosion factors			Wind erodibility group	Wind erodibility index
										Kw	Kf	T		
	In	Pct	Pct	Pct	g/cc	micro m/sec	In/In	Pct	Pct					
GgB—Glenelg loam, 3 to 8 percent slopes														
Glenelg	0-6	24-32- 52	35-43- 50	7-25- 27	1.30-1.38-1.47	4.00-9.00-14.00	0.14-0.19-0.24	0.2- 1.0- 1.4	1.0- 2.5- 6.0	.24	.24	5	6	48
	6-10	10-29- 52	35-44- 68	7-27- 30	1.43-1.46-1.50	4.00-12.00-14.0	0.16-0.21-0.24	0.2- 1.9- 2.4	0.8- 2.0- 4.0	.28	.28			
	10-18	10-26- 40	27-46- 63	20-29- 35	1.47-1.52-1.56	1.40-9.00-14.00	0.15-0.18-0.20	0.8- 2.0- 2.8	0.1- 0.1- 0.5	.37	.37			
	18-25	24-27- 65	12-46- 50	7-28- 35	1.54-1.56-1.59	1.40-9.00-14.00	0.15-0.17-0.19	0.2- 1.9- 2.8	0.0- 0.1- 0.3	.37	.37			
	25-30	24-29- 65	10-43- 47	7-28- 35	1.54-1.62-1.70	1.40-9.00-14.00	0.12-0.15-0.22	0.2- 2.0- 2.8	0.0- 0.1- 0.2	.37	.37			
	30-42	10-42- 52	28-34- 65	7-25- 30	1.51-1.53-1.55	4.00-12.00-14.0	0.14-0.18-0.24	0.2- 1.6- 2.2	0.0- 0.1- 0.1	.32	.32			
	42-54	30-38- 83	10-38- 50	7-24- 25	1.60-1.62-1.64	4.00-12.00-14.0	0.12-0.18-0.24	0.2- 1.5- 1.7	0.0- 0.0- 0.1	.37	.37			
	54-76	50-68- 75	20-28- 35	1- 4- 15	1.58-1.60-1.61	4.00-28.00-42.0	0.11-0.13-0.15	0.0- 0.1- 0.7	0.0- 0.0- 0.1	.20	.43			

COUNTY #

SOIL PROFILE
334


0' dull orange brown cilm
3.0 lgt or tan powdery SiSalm 50% Rx

332

3.0 brn cilm
9.5 lgt orange tan SiLm
>50% Rx
lgt or tan SaLm

331

no distinct clay layer
lgt pink SiSalm
85- >50% pebbles of rock
100

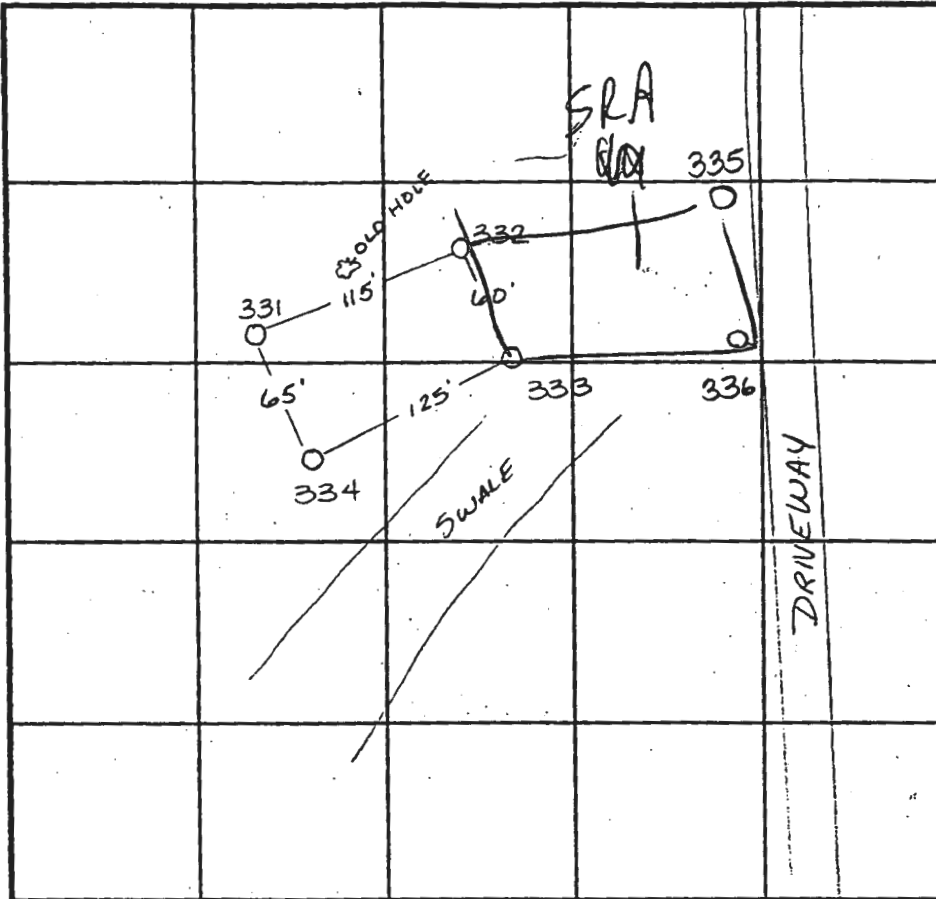

SOIL PROFILE
333 335

0' orange brown SiCilm
3.0 Pink SaSilm 15% rock

336

12.0 dark red brn SiCilm
3.0 or tan SaLm friable sub & blocky dry <5% Rx
11.0

DATE	TEST NO.	DEPTH	PRE-WET		TEST - 1" DROP		TIME
			START	STOP	START	STOP	
1-7-98	334	Visual to 12.0		see profile			OK
	332	3.5 / 12.0	10:45	10:46	10:46	10:47	1min
	331	Visual to 10.0 (collapsed @ 10.0)					OK
	333	3.0 / 12.0	10:56	10:57	10:57	10:59	2min
1-9-98	335	Visual to 12.0 - see profile					OK
	336	3.5 / 11.0	12:42	12:48	12:48	12:54	6min

REMARKS old hole looks rocky

TYPE OF SOIL

TESTED BY Amy McMillen

ALSO PRESENT Tim Feaga

TRENCH DESIGN DATA: AVERAGE PERCOLATION TIME 2 min

TRENCH WIDTH 3.0

INLET DEPTH 2.5

MAXIMUM BOTTOM DEPTH 4.5

SQ. FT./BEDROOM 180

COUNTY #

SOIL PROFILE
334

dull
orange
brown
clm

lgt or
tan
powdery
silm
5% Ry

332

brn
clm


lgt
orange
tan
silm

>50%
Ry
lgt or
tan
silm

331

no
distinct
clay
layer
lgt
pink
silm

>50%
pockets
of
rock

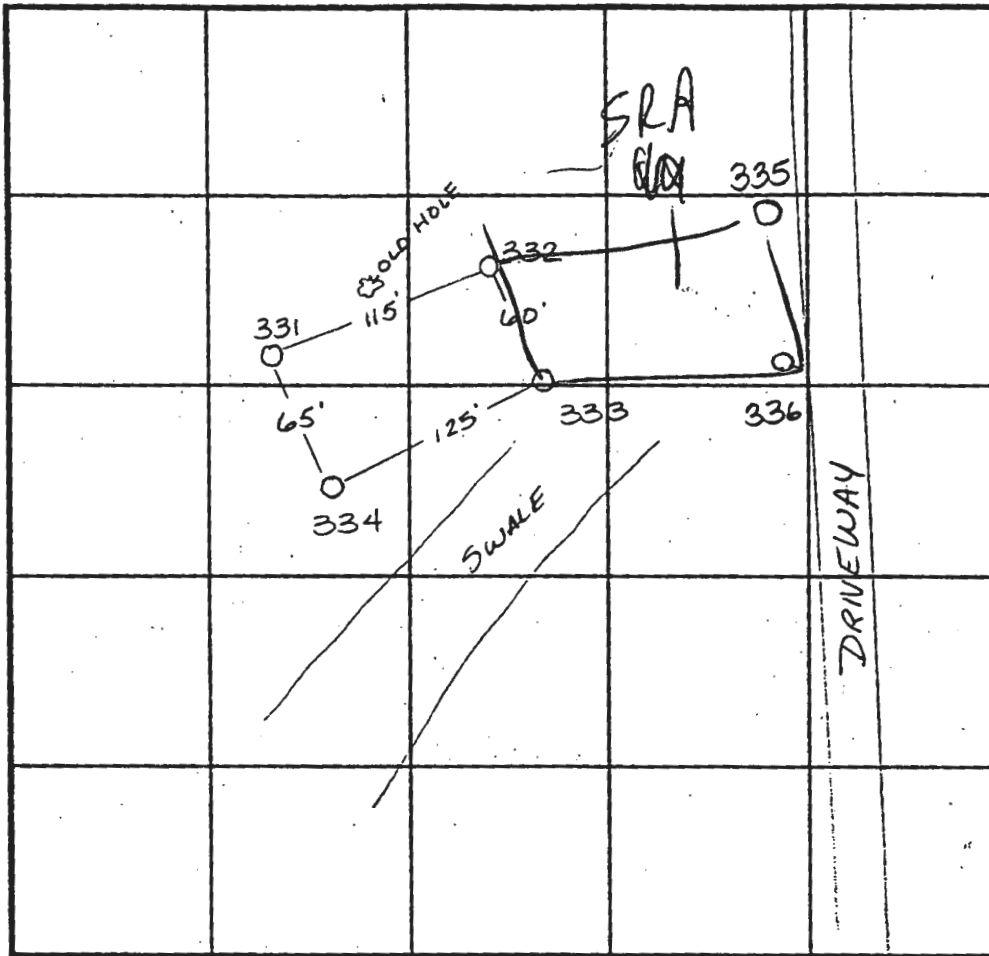

INDICATE NORTH - NAME ADJOINING ROADWAY AS BASE LINE.

SOIL PROFILE
333 335

0'
orange
brown
silm

3.0
pink
silm
15%
rock

12.0

336

dark
red brn
silm

3.0
or tan
silm
friable
sub &
blocky
dry
45% Ry

11.0

DATE	TEST NO.	DEPTH	PRE-WET		TEST - 1" DROP		TIME
			START	STOP	START	STOP	
1-7-98	334	Visual	to 12.0	see profile	—	—	OK
	332	3.5' v12.0	10:45	10:46	10:46	10:47	1min
	331	Visual	to 10.0	(collapsed @ 10.0)	—	—	OK
	333	3.0 v12.0	10:56	10:57	10:57	10:59	2min
1-9-98	335	Visual	to 12.0	- see profile	—	—	OK
	336	3.5' v11.0	12:42	12:48	12:48	12:54	6min

REMARKS old hole looks rocky

TYPE OF SOIL

TESTED BY Amy McMillen

ALSO PRESENT Tim Feaga


TRENCH DESIGN DATA: AVERAGE PERCOLATION TIME 2 min

TRENCH WIDTH 3.0

INLET DEPTH 2.5

MAXIMUM BOTTOM DEPTH 4.5

SQ. FT./BEDROOM 180

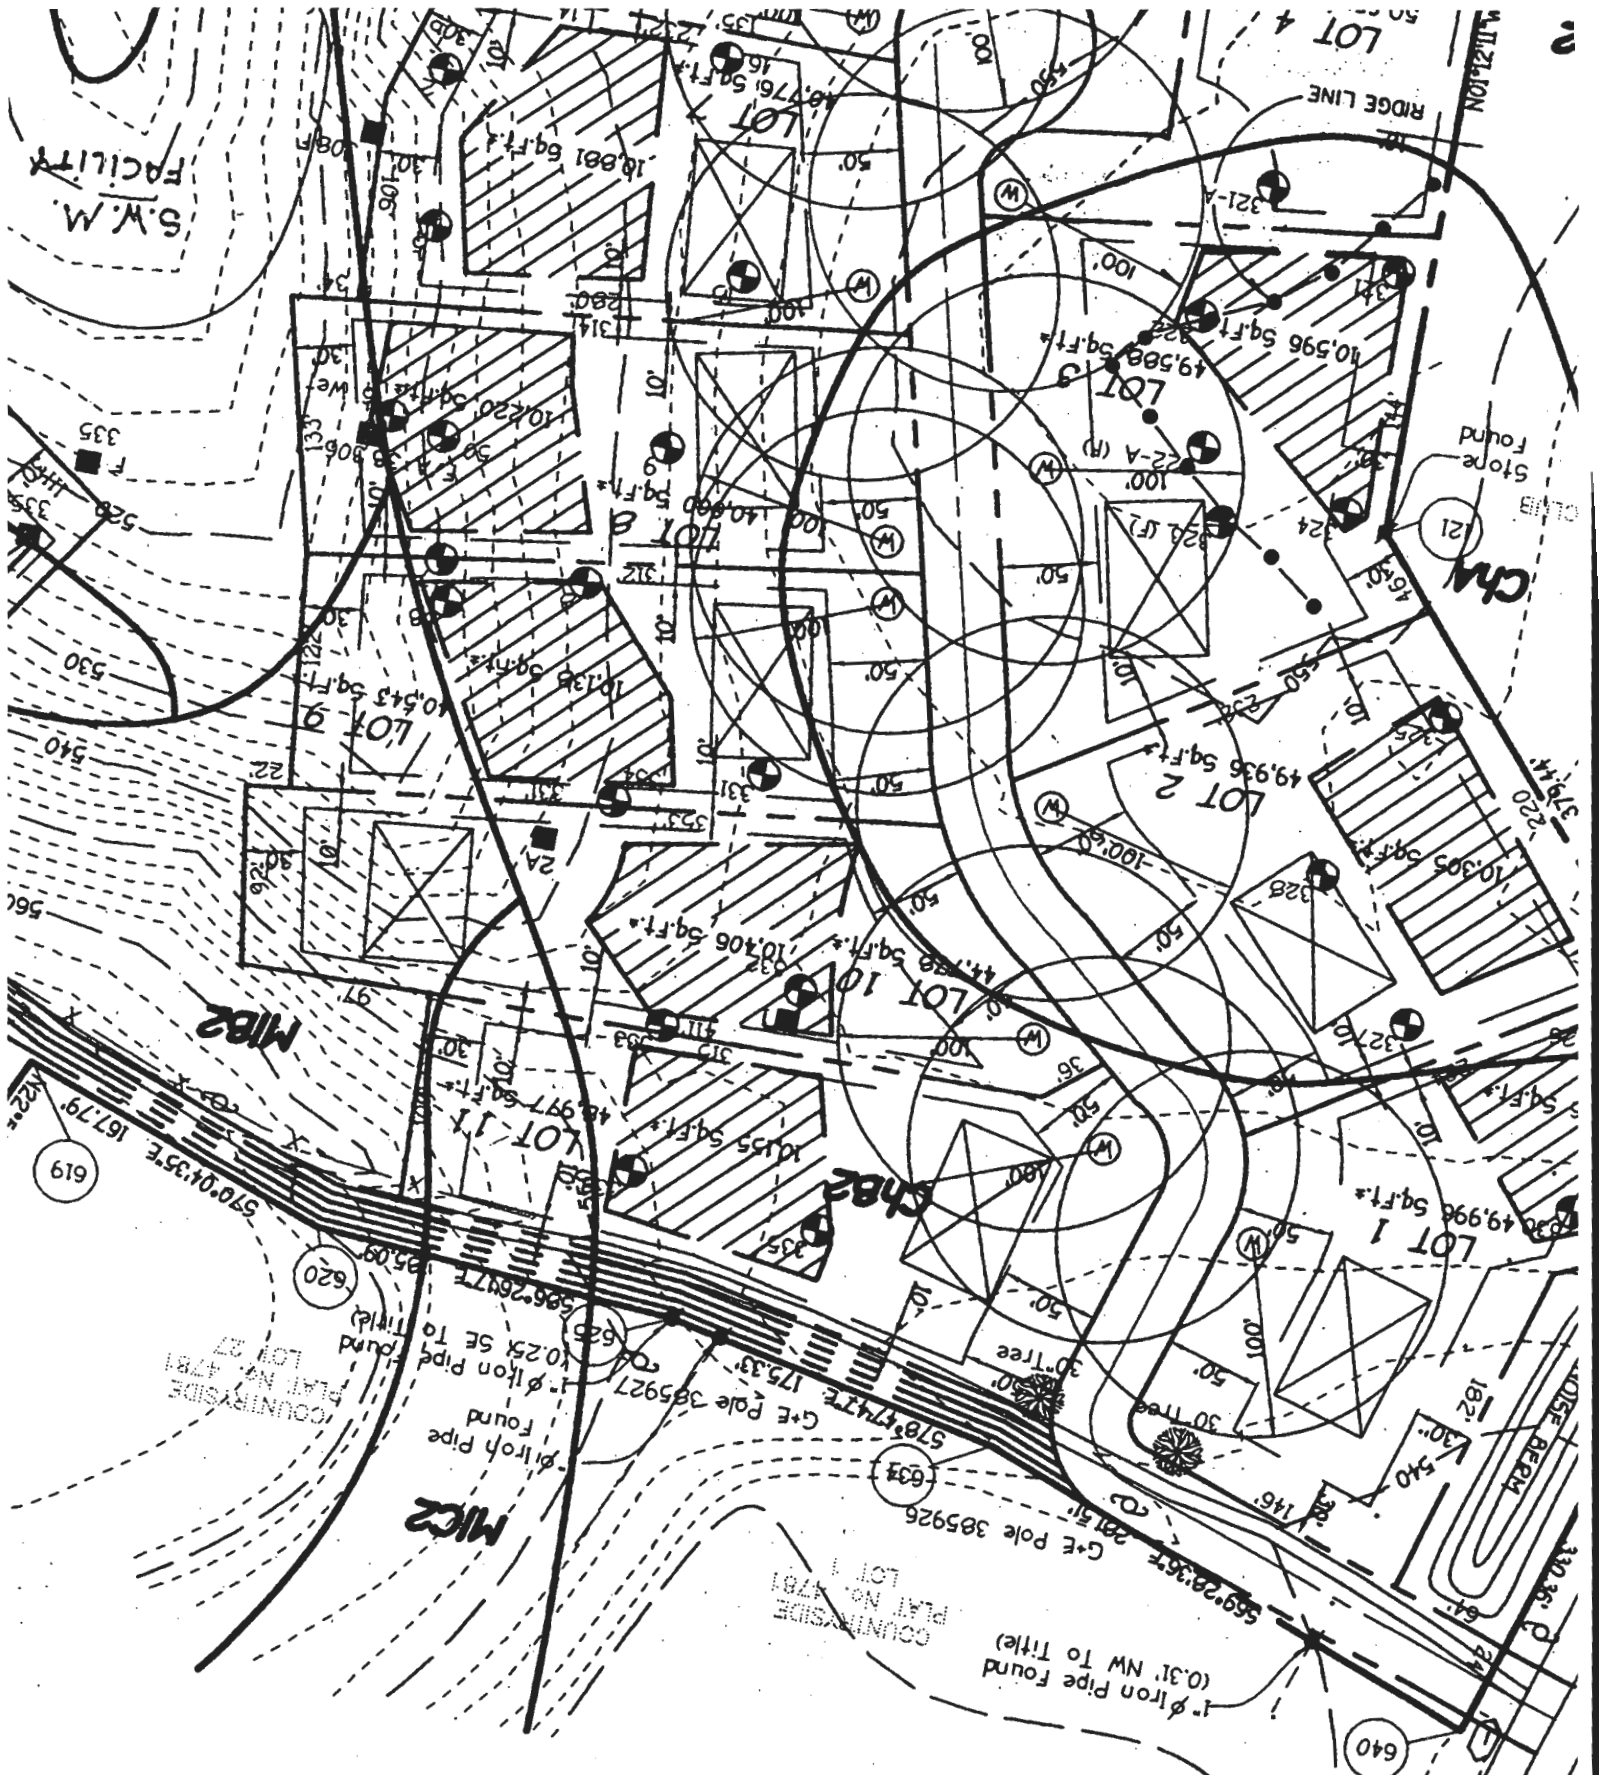

Signed Perc Cont
 11-6-98
 Tim Feaga = FCC