
 WATER WELL ABANDONMENT-SEALING REPORT FORM

SUBMIT COPIES OF COMPLETED FORM TO:

- * COUNTY ENVIRONMENTAL AGENCY (contact MDE, WMA if address needed)
- * WELL OWNER
- * MDE, WATER MANAGEMENT ADMINISTRATION, WELL PROGRAM

APPROVED
 07/16/2021

DATE WELL ABANDONED: 2/3/2020 (month/day/year)

* PERMIT NUMBER OF ABANDONED WELL (if any) _____

* PERMIT NUMBER OF REPLACEMENT WELL: _____


* PERSON ABANDONING WELL: Michael Bartow

WELL DRILLER'S LICENSE NUMBER: 355
 CIRCLE: MWD / MSD / MGD

* OWNER'S NAME: Dorsey Family Homes

SITE LOCATION MAP

* WELL LOCATION:
 COUNTY: Howard
 NEAREST TOWN: Eikrig
 TAX MAP _____ BLOCK _____ PARCEL _____
 SUBDIVISION: Pink Acres
 SECTION: _____ LOT: _____
 STREET ADDRESS: 6275 Montgomery RD

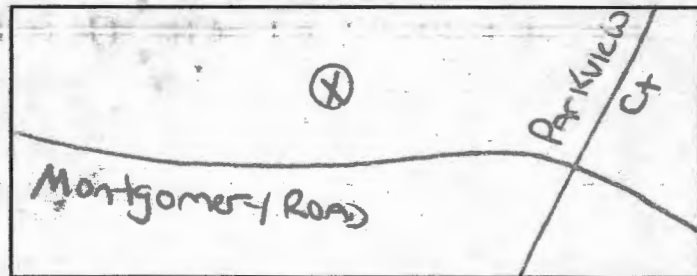

LATITUDE 3 9.21327
 LONGITUDE 7 6.76469

LOG OF SEALING MATERIAL

MATERIAL	FEET	
	FROM	TO
Bentonite Clay	120	0
VOLUME OF MATERIAL USED		
2100 lbs Bentonite		

* TYPE OF WELL BEING ABANDONED:
 DRILLED JETTED
 BORED HAND DUG
 OTHER (specify) _____

* USE CODE:
 DOMESTIC MUNICIPAL/PUBLIC
 IRRIGATION INDUSTRIAL
 TEST/OBSERVATION GEOTHERMAL

* TYPE OF CASING:
 STEEL PLASTIC
 CONCRETE OTHER (specify) _____

SIZE OF CASING: 6 INCHES IN DIAMETER

DEPTH OF WELL: 120 FEET DEEP

WAS ANY CASING REMOVED? YES / NO
 If yes, length removed, in feet: _____

WAS CASING RIPPED OR PERFORATED? YES / NO

SIGNATURE-MASTER WELL DRILLER OR SUPERVISING SANITARIAN [Signature] LICENSE# 355

CIRCLE ONE MWD / MSD / MGS DATE 2/3/2020

COUNTY _____

Pursuant to § 10-624 of the State Govt. Article of the Maryland Code, personal info requested on this form is used in processing this form pursuant to COMAR 26.04.04. Failure to provide the info may result in this form not being processed. You have the right to inspect, amend, or correct this form. The Maryland Department of the Environment is subject to the Maryland Public Information Act. This form may be made available on the Internet via MDE's website and is subject to inspection or copying, in whole or in part, by the public and other governmental agencies, if not protected by federal or State Law.