

\*\*\*\*\*  
 WATER WELL ABANDONMENT-SEALING REPORT FORM  
 \*\*\*\*\*

**SUBMIT COPIES OF COMPLETED FORM TO:**

- \* COUNTY ENVIRONMENTAL AGENCY (contact MDE, WMA if address needed)
- \* WELL OWNER
- \* MDE, WATER MANAGEMENT ADMINISTRATION, WELL PROGRAM

APPROVED  
 07/21/2021

DATE WELL ABANDONED: NOVEMBER 21, 2019 (month/day/year)

\* PERMIT NUMBER OF ABANDONED WELL (if any) \_\_\_\_\_

\* PERMIT NUMBER OF REPLACEMENT WELL: \_\_\_\_\_


\* PERSON ABANDONING WELL: Bruce Thompson

WELL DRILLER'S LICENSE NUMBER: ISD 03 Y  
 CIRCLE: MWD / MSD / MGD

\* OWNER'S NAME: CAROL DUDLEY

SITE LOCATION MAP

\* WELL LOCATION:  
 COUNTY: Howard  
 NEAREST TOWN: WEST FRIENDSHIP  
 TAX MAP \_\_\_\_\_ BLOCK \_\_\_\_\_ PARCEL \_\_\_\_\_  
 SUBDIVISION: ROSEMARY ESTATES  
 SECTION: \_\_\_\_\_ LOT: 17  
 STREET ADDRESS: 3462 Rosemary Lane

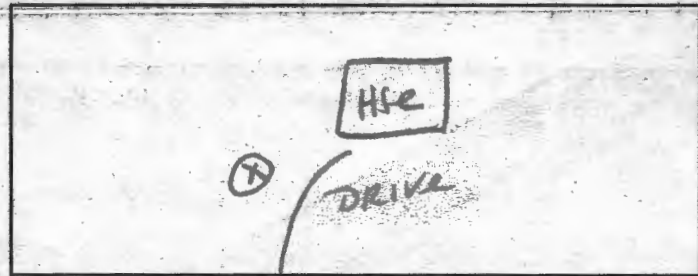

LATITUDE 39.277658

LONGITUDE 77.962104

LOG OF SEALING MATERIAL

MATERIAL	FEET	
	FROM	TO
Bentonite	150	2
CRUSHER RUN	2	0
VOLUME OF MATERIAL USED		
<u>1000 # Bentonite mixed for slurry</u>		

\* TYPE OF WELL BEING ABANDONED:  
 DRILLED  JETTED  
 BORED  HAND DUG  
 OTHER (specify) \_\_\_\_\_

\* USE CODE:  
 DOMESTIC  MUNICIPAL/PUBLIC  
 IRRIGATION  INDUSTRIAL  
 TEST/OBSERVATION  GEOTHERMAL

\* TYPE OF CASING:  
 STEEL  PLASTIC  
 CONCRETE  OTHER (specify) N/A

SIZE OF CASING: N/A INCHES IN DIAMETER

DEPTH OF WELL: 150 FEET DEEP

WAS ANY CASING REMOVED? YES \_\_\_ NO N/A  
 If yes, length removed, in feet: \_\_\_\_\_

WAS CASING RIPPED OR PERFORATED? YES \_\_\_ NO N/A

SIGNATURE Sony F. Prater LICENSE# 040

MWD / MSD / MGS 11-27-19  
 CIRCLE ONE DATE

COUNTY

Pursuant to § 10-624 of the State Govt. Article of the Maryland Code, personal info requested on this form is used in processing this form pursuant to COMAR 26.04.04. Failure to provide the info may result in this form not being processed. You have the right to inspect, amend, or correct this form. The Maryland Department of the Environment is subject to the Maryland Public Information Act. This form may be made available on the Internet via MDE's website and is subject to inspection or copying, in whole or in part, by the public and other governmental agencies, if not protected by federal or State Law.