

WATER WELL ABANDONMENT-SEALING REPORT FORM

**BMIT COPIES OF COMPLETED FORM TO:**

COUNTY ENVIRONMENTAL AGENCY (contact MDE, WMA if address needed)  
 WELL OWNER  
 MDE, WATER MANAGEMENT ADMINISTRATION, WELL PROGRAM

APPROVED  
 07/16/2021

DATE WELL ABANDONED: MAY 24, 2021 (month/day/year)

\* PERMIT NUMBER OF ABANDONED WELL (if any)

\* PERMIT NUMBER OF REPLACEMENT WELL:

HO 95 - 1372

\* PERSON ABANDONING WELL: FRANK SINGLETON


WELL DRILLER'S LICENSE NUMBER: WMD 046

CIRCLE: MWD / MSD / MGD

\* OWNER'S NAME: AND Design + Development

SITE LOCATION MAP

\* WELL LOCATION:  
 COUNTY: Howard  
 NEAREST TOWN: MT AIRY  
 TAX MAP \_\_\_\_\_ BLOCK \_\_\_\_\_ PARCEL \_\_\_\_\_  
 SUBDIVISION: \_\_\_\_\_  
 SECTION: \_\_\_\_\_ LOT: \_\_\_\_\_  
 STREET ADDRESS: 18461 PENN SHOP RD

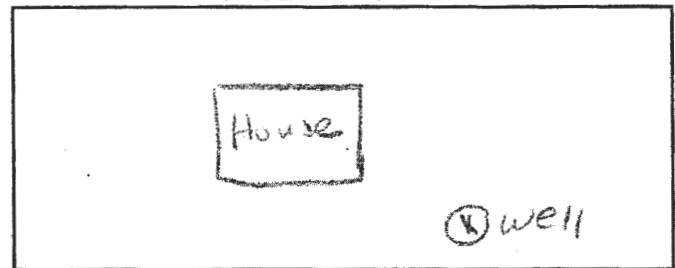

LATITUDE 39.345823

LONGITUDE 77.259288

LOG OF SEALING MATERIAL

\* TYPE OF WELL BEING ABANDONED:  
 DRILLED \_\_\_\_\_ JETTED  
 BORED \_\_\_\_\_ HAND DUG  
 \_\_\_\_\_ OTHER (specify) \_\_\_\_\_

MATERIAL	FEET	
	FROM	TO
<u>Bentonite</u>	<u>139</u>	<u>1</u>
<u>TOP SOIL</u>	<u>1</u>	<u>0</u>

\* USE CODE:  
 DOMESTIC \_\_\_\_\_ MUNICIPAL/PUBLIC  
 IRRIGATION \_\_\_\_\_ INDUSTRIAL  
 TEST/OBSERVATION \_\_\_\_\_ GEOTHERMAL

VOLUME OF MATERIAL USED

\* TYPE OF CASING:  
 STEEL \_\_\_\_\_ PLASTIC  
 CONCRETE \_\_\_\_\_ OTHER (specify) \_\_\_\_\_

300 # mixed br slurry

SIZE OF CASING: 6 INCHES IN DIAMETER

DEPTH OF WELL: 139 FEET DEEP

WAS ANY CASING REMOVED?  YES \_\_\_\_\_ NO

If yes, length removed, in feet: 2

WAS CASING RIPPED OR PERFORATED? \_\_\_\_\_ YES  NO

SIGNATURE: Deasy J. Partular LICENSE# 040

MWD / MSD / MGS  
 CIRCLE ONE

5-28-21  
 DATE

DRILLER

Pursuant to § 10-624 of the State Govt. Article of the Maryland Code, personal info requested on this form is used in processing this form pursuant to COMAR 26.04.04. Failure to provide the info may result in this form not being processed. You have the right to inspect, amend, or correct this form. The Maryland Department of the Environment is subject to the Maryland Public Information Act. This form may be made available on the Internet via MDE's website and is subject to inspection or copying, in whole or in part, by the public and other governmental agencies, if not protected by federal or State Law.