

WATER WELL ABANDONMENT-SEALING REPORT FORM

SUBMIT COPIES OF COMPLETED FORM TO:

- \* COUNTY ENVIRONMENTAL AGENCY (contact MDE, WMA if address needed)
- \* WELL OWNER
- \* MDE, WATER MANAGEMENT ADMINISTRATION, WELL PROGRAM

Approved  
 07/16/2021

DATE WELL ABANDONED: MARCH 11, 2021 (month/day/year)

\* PERMIT NUMBER OF ABANDONED WELL (if any)

HO - 73 - 1932

\* PERMIT NUMBER OF REPLACEMENT WELL:

\* PERSON ABANDONING WELL: FRANK SINGLETON

WELL DRILLER'S LICENSE NUMBER: WRO 046


CIRCLE: MWD / MSD / MGD

\* OWNER'S NAME: Sandy Smith

SITE LOCATION MAP

\* WELL LOCATION:

COUNTY: Howard  
 NEAREST TOWN: \_\_\_\_\_  
 TAX MAP: \_\_\_\_\_ BLOCK: \_\_\_\_\_ PARCEL: \_\_\_\_\_  
 SUBDIVISION: \_\_\_\_\_  
 SECTION: \_\_\_\_\_ LOT: \_\_\_\_\_  
 STREET ADDRESS: 12080 OLD FRED RD

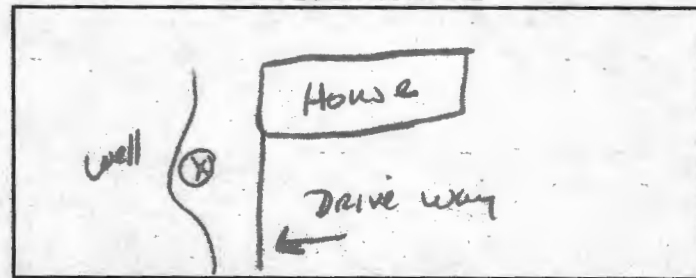

LATITUDE 39.321433

LONGITUDE 76.932594

LOG OF SEALING MATERIAL

MATERIAL	FEET	
	FROM	TO
<u>Bentonite</u>	<u>145</u>	<u>0</u>

\* TYPE OF WELL BEING ABANDONED:

- DRILLED  JETTED
- BORED  HAND DUG
- OTHER (specify) \_\_\_\_\_

\* USE CODE:

- DOMESTIC  MUNICIPAL/PUBLIC
- IRRIGATION  INDUSTRIAL
- TEST/OBSERVATION  GEOTHERMAL

VOLUME OF MATERIAL USED

480 # mixed as slurry

\* TYPE OF CASING:

- STEEL  PLASTIC
- CONCRETE  OTHER (specify) \_\_\_\_\_

SIZE OF CASING: 6 INCHES IN DIAMETER

DEPTH OF WELL: 145 FEET DEEP

WAS ANY CASING REMOVED?  YES  NO

If yes, length removed, in feet: 1

WAS CASING RIPPED OR PERFORATED?  YES  NO

SIGNATURE-MASTER WELL DRILLER OR SUPERVISING SANITARIAN Frank Singleton LICENSE# 040

MWD / MSD / MGS 3-11-21 DATE  
 CIRCLE ONE

COUNTY George Eastwood

Pursuant to § 10-624 of the State Govt. Article of the Maryland Code, personal info requested on this form is used in processing this form pursuant to COMAR 26.04.04. Failure to provide the info may result in this form not being processed. You have the right to inspect, amend, or correct this form. The Maryland Department of the Environment is subject to the Maryland Public Information Act. This form may be made available on the Internet via MDE's website and is subject to inspection or copying, in whole or in part, by the public and other governmental agencies, if not protected by federal or State Law.