

PERMIT NUMBER: B20003776

DATE ACCEPTED:

RECEIVED  
OCT 21 2020

**RESIDENTIAL BUILDING PERMIT APPLICATION**  
HOWARD COUNTY DEPARTMENT OF INSPECTIONS, LICENSES, AND PERMITS  
3430 COURT HOUSE DRIVE, ELLICOTT CITY, MD 21043 - PHONE: (410) 313-2455 OPTION #4  
www.howardcountymd.gov

**BUILDING SITE ADDRESS REQUIRED**  
Street Address: 3326 ROSCOMMON DR Unit:  
City: GLENELG State: MD Zip Code: 21732  
Subdivision/Village/Complex Name: SDP/WP/BA #:  
Lot: 17 Tax Map: 22 Parcel: Grading Permit #:

**DESCRIPTION OF WORK REQUIRED**  
Existing Use: DENT, BATH Proposed Use: DENT, BATH Estimated Cost: \$ 8000  
Trade Work to Be Completed (Separate Permits Required):  Mechanical (HVACR)  Electrical  Plumbing  None  
WE ARE ADDING NEW BATH ROOM IN THE BASEMENT AREA NEXT TO EXISTING DENT 6x8 48 sq ft.

**PROPERTY OWNER INFORMATION REQUIRED**  
Owner(s) Name(s) (As it appears on tax records): DAVID BERNSTEIN Primary Residence:  Yes  No  
Owner's Street Address: 3326 ROSCOMMON DRIVE  
City: GLENELG State: MD Zip Code: 21732  
Phone: 910 990 9335 Email:

**APPLICANT NAME REQUIRED - INDIVIDUAL WHO SIGNS THIS APPLICATION**  
Business Name: MOP SOLUTIONS LLC Contact Name:  
Street Address: 17156 MUSS SIDE LN  
City: OLNEY State: MD Zip Code: 20830  
Phone: 301-835 8030 Email: MOP SOLUTIONS LLC 6 SAUND. WAY

**CONTRACTOR INFORMATION REQUIRED**  
Business Name: MOP SOLUTIONS LLC  
Licensee's Name: EDVAMU SERRA License #: 119127  
Street Address: 17156 MUSS SIDE LN  
City: OLNEY State: MD Zip Code: 20832  
Phone: 301/835 8030 Email:

**ARCHITECT/ENGINEER INFORMATION INDIVIDUAL WHO SIGNED PLANS, IF APPLICABLE**  
Business Name: Name:  
Street Address:  
City: State: Zip Code:  
Phone: Email:

**BUILDING CHARACTERISTICS REQUIRED**  
Primary Structure:  SF Dwelling  SF Townhouse  SF Duplex  Mobile Home  Multi-Family Dwelling (MF\*) Condo:  Yes  No  
Utilities:  Electric  Gas Water Supply:  Public  Private (Well) Sewage Disposal:  Public  Private (Septic) >  
Heating System:  Electric  Natural Gas  Propane  Other: Roadside Tree Project:  No  Yes: #  
Sprinkler System:  NFPA 13  NFPA 13R  NFPA 13D  None Fire Alarm System:  Yes  No  Voice Evac


**ADDITIONAL RESIDENTIAL INFORMATION (PLEASE SELECT/COMPLETE ALL THAT APPLY)**  
Model Name & Options:  
# of Bedrooms (SF): # of efficiency units (MF\*): # of 1 BR (MF\*): # of 2 BR (MF\*): # of 3 BR (MF\*):  
# Rooms: # Full Baths: 2 # Half Baths: 1 # Fireplaces: 2  
Garage/Carport Info:  Attached Garage  Detached Garage  Integral Garage  Carport  None  
Basement/Foundation Info:  Slab on Grade  Post & Pier  Unfinished Basement  Finished Basement:  Full or  Partial  
1st Fl Width: 1st Fl Depth: 2nd Fl Width: 2nd Fl Depth: Bsmt Width: Bsmt Depth:  
Energy Method:  Prescriptive  Performance  UA Alternative  ERI Gross Area: sq ft Occupiable Area: sq ft

**AGREEMENT/ DISCALIMER REQUIRED**  
THE UNDERSIGNED HEREBY CERTIFIES AND AGREES AS FOLLOWS: (1) THAT HE/SHE IS AUTHORIZED TO MAKE THIS APPLICATION; (2) THAT THE INFORMATION IS CORRECT; (3) THAT HE/SHE WILL COMPLY WITH ALL REGULATIONS OF HOWARD COUNTY WHICH ARE APPLICABLE THERETO; (4) THAT HE/SHE WILL PERFORM NO WORK ON THE ABOVE REFERENCED PROPERTY NOT SPECIFICALLY DESCRIBED IN THIS APPLICATION; (5) THAT HE/SHE GRANTS COUNTY OFFICIALS THE RIGHT TO ENTER ONTO THIS PROPERTY FOR THE PURPOSE OF INSPECTING THE WORK PERMITTED AND POSTING NOTICES.  
APPLICANT'S ORIGINAL SIGNATURE: DATE SIGNED: 10.21.2020

**FOR OFFICE USE ONLY** CHECKS PAYABLE TO: DIRECTOR OF FINANCE OF HOWARD COUNTY  
AGENCIES REQUIRED/APPROVALS:  
 PR  DPZ  DED  Health  SHA  CID  
SUBMITTAL FEES: \$0.00 PAYMENT: In arrears check ACCEPTED BY: DEAP Box

ADD NEW BATHROOM AND EGRESS WINDOW.

CONTACTOR: MDR SOLUTIONS LLC  
# 301.835.8030.  
OWNER: DAVID BERNSTEIN / BREON HARKAVY  
PROJECT ADDRESS: 3326 ROSCOMMON DRIVE, GLENELES, MD 21737

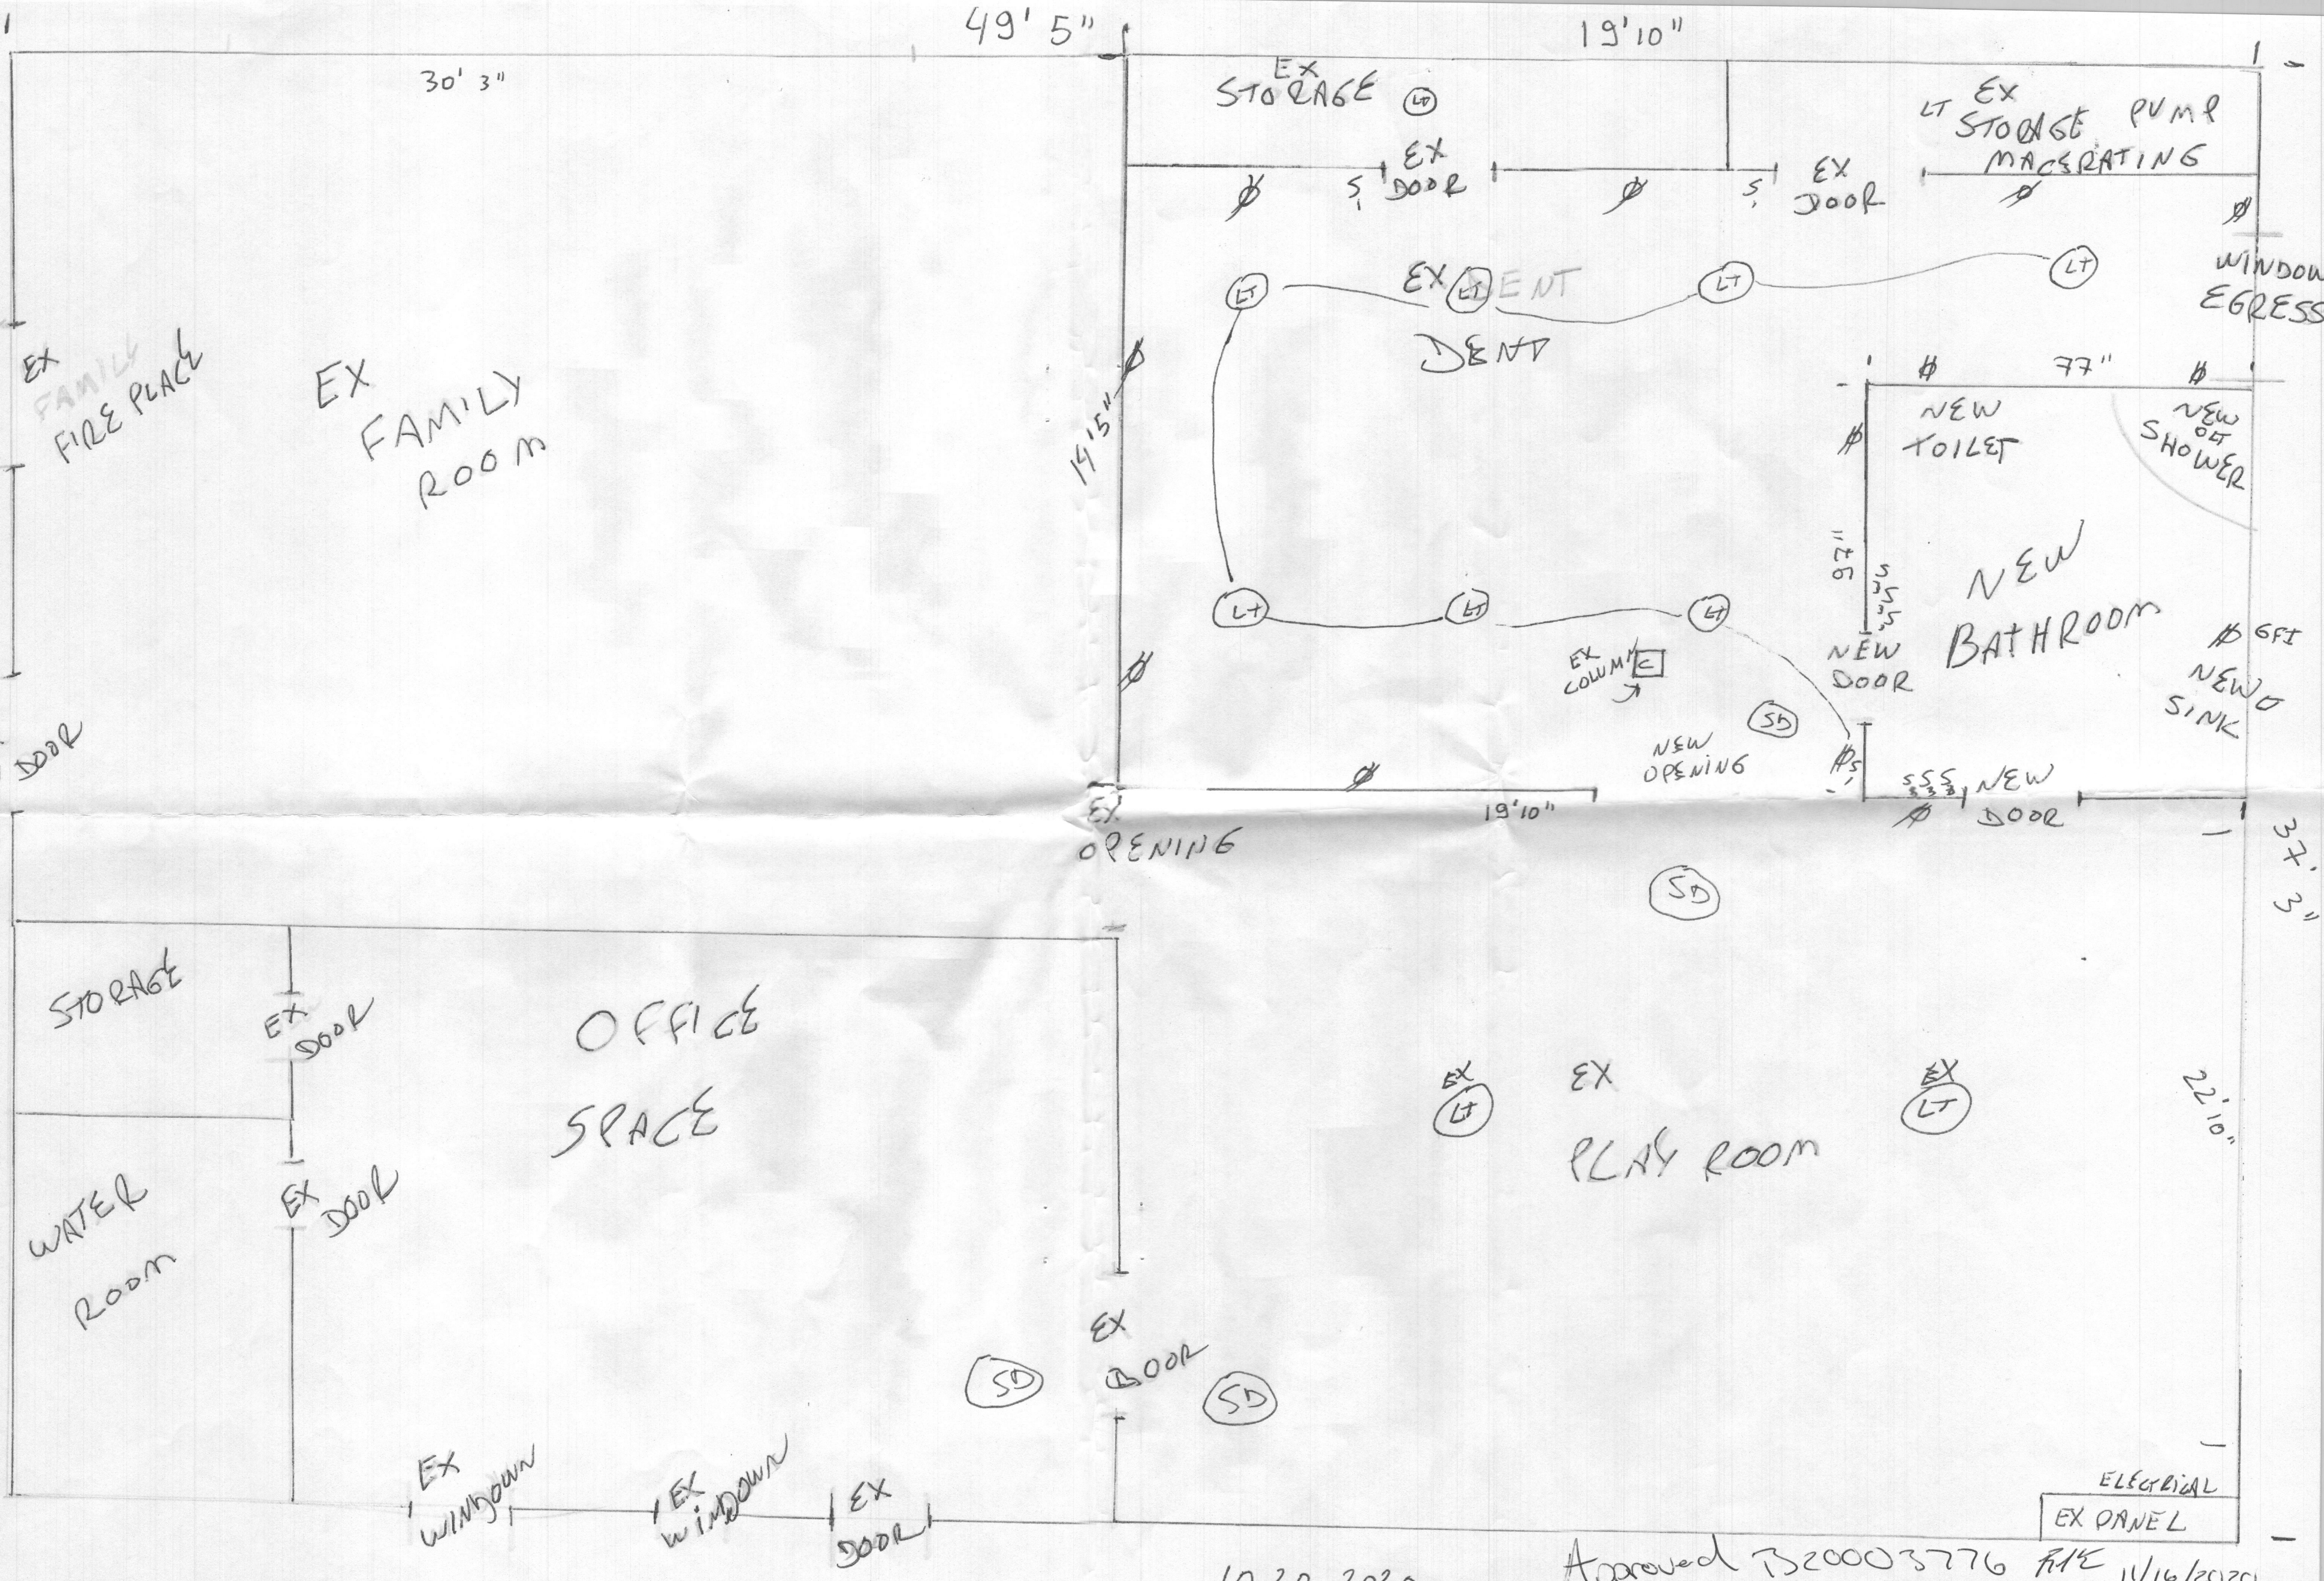

10.20.2020

Approved 7520003776 FILE 11/16/2020

ELECTRICAL EX PANEL