


| COORDINATE SCHEDULE | | |
|---------------------|-------------|-------------|
| NO. | NORTH | EAST |
| 1 | 541,768.876 | 822,059.121 |
| 5 | 540,007.153 | 821,519.289 |
| 6 | 540,202.214 | 821,240.086 |
| 7 | 541,788.128 | 821,022.769 |
| 8 | 541,746.716 | 822,023.769 |
| 9 | 541,430.639 | 821,978.089 |
| 10 | 541,433.346 | 821,610.585 |
| 11 | 541,790.634 | 821,662.222 |
| 12 | 541,701.006 | 821,611.793 |
| 13 | 540,764.855 | 821,403.452 |
| 14 | 540,770.813 | 821,262.779 |
| 15 | 540,114.451 | 821,174.334 |

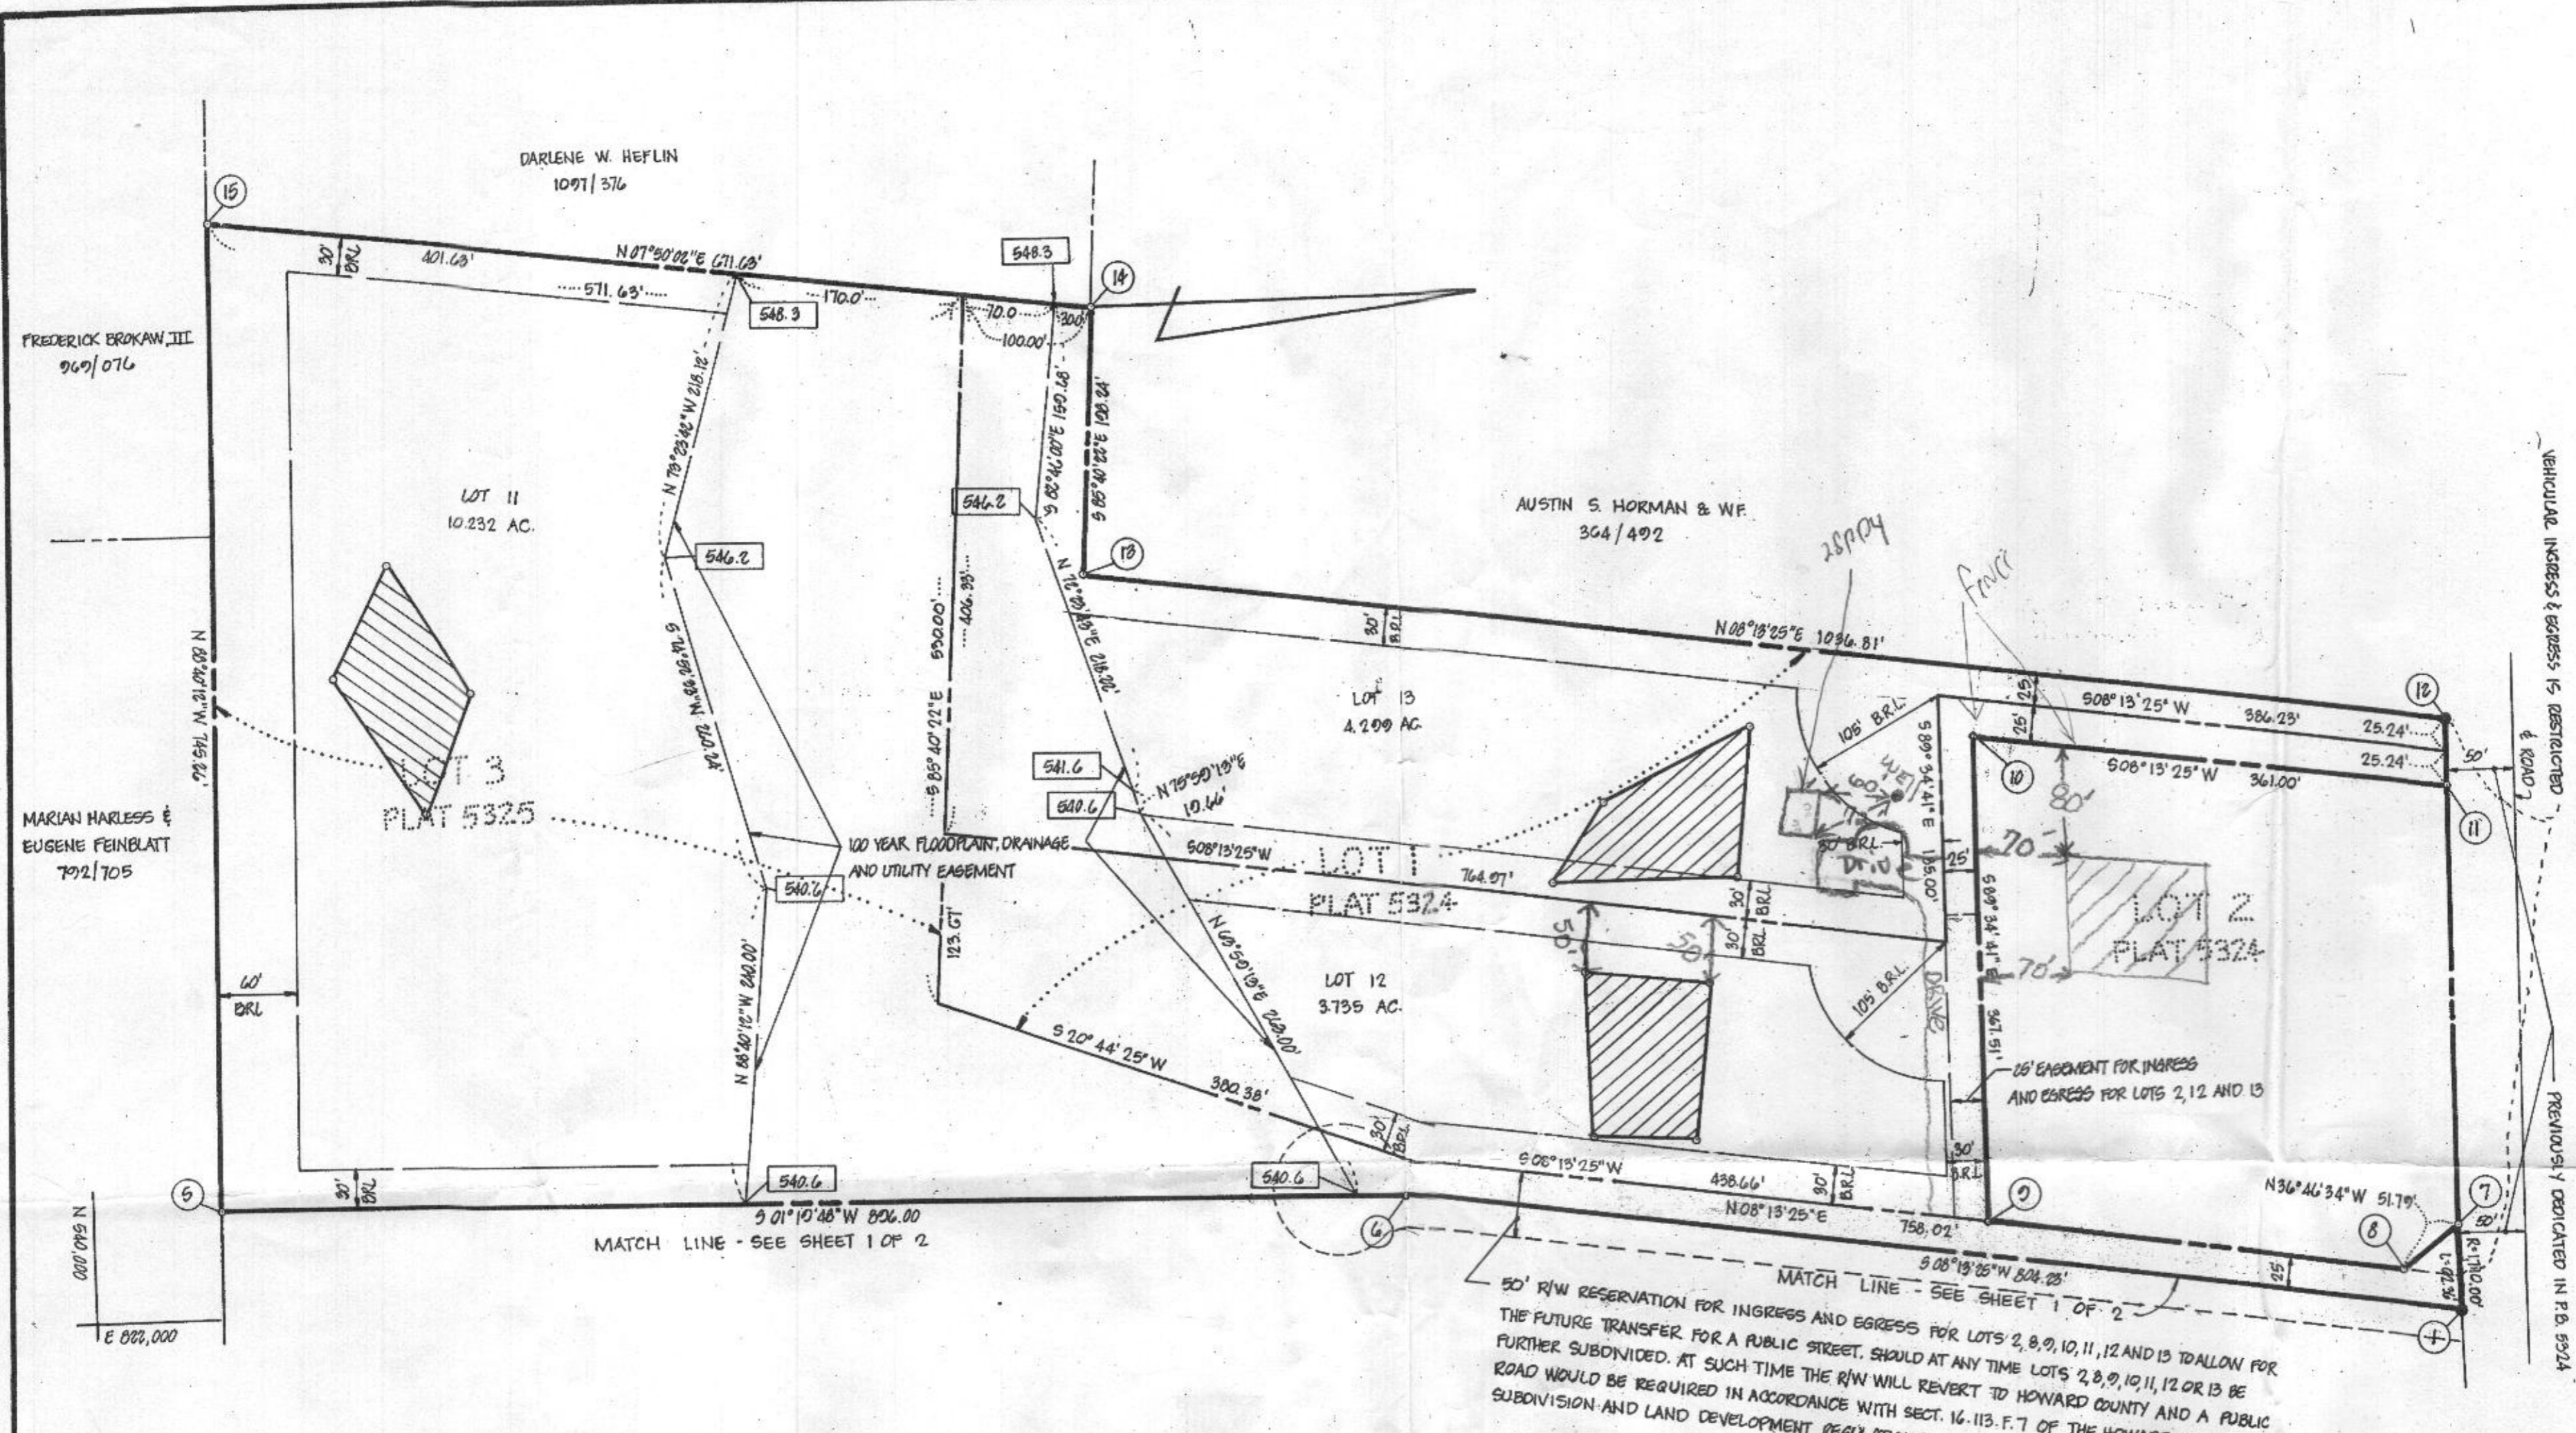

AREA TABULATIONS

TOTAL NUMBER OF LOTS AND/OR PARCELS TO BE RECORDED THIS SHEET: 3
 TOTAL AREA OF LOTS AND/OR PARCELS THIS SHEET: 18.266 AC
 TOTAL AREA OF ROADWAYS TO BE RECORDED THIS SHEET: NONE
 TOTAL AREA OF SUBDIVISION TO BE RECORDED THIS SHEET: 18.266 AC

OWNER / DEVELOPER

MIKE BOSWELL
 11805 ROUTE 00
 MARRIOTTVILLE, MD. 21104

APPROVED: FOR PRIVATE WATER AND PRIVATE SEWERAGE SYSTEMS, HOWARD COUNTY HEALTH DEPARTMENT.
[Signature]
 HOWARD COUNTY HEALTH OFFICER DATE

APPROVED: HOWARD COUNTY OFFICE OF PLANNING AND ZONING.
[Signature] 6-7-85
 PLANNING DIRECTOR DATE

APPROVED: FOR STORM DRAINAGE SYSTEMS AND PUBLIC ROADS, HOWARD COUNTY DEPARTMENT OF PUBLIC WORKS.
[Signature] 6-6-85
 DIRECTOR DATE

OWNERS STATEMENT

I, MICHAEL D. BOSWELL, OWNERS OF THE PROPERTY SHOWN AND DESCRIBED HEREON, HEREBY ADOPT THIS PLAN OF SUBDIVISION, AND IN CONSIDERATION OF THE APPROVAL OF THIS FINAL PLAT BY THE OFFICE OF PLANNING AND ZONING, ESTABLISH THE MINIMUM BUILDING RESTRICTION LINES. ALL EASEMENTS OR RIGHT-OF-WAYS AFFECTING THE PROPERTY ARE INCLUDED IN THIS PLAN OF SUBDIVISION.

WITNESS MY HANDS THIS 26th DAY OF APRIL 1985
[Signature]
 WITNESS
[Signature]

SURVEYORS CERTIFICATE

I HEREBY CERTIFY THAT THE FINAL PLAT SHOWN HEREON IS CORRECT, THAT IT IS A RESUBDIVISION OF PART OF THE LANDS CONVEYED BY AVA S. RAMBOURG, JR. AND H. LEE RAMBOURG TO MICHAEL D. BOSWELL BY DEED DATED DECEMBER 21, 1980 AND RECORDED IN THE LAND RECORDS OF HOWARD COUNTY, MARYLAND IN LIBER 1041 AT FOLIO 100, SAID PARCEL ALSO BEING A RESUBDIVISION OF LOTS 1, 3, 4 AND 5 AS SHOWN ON A PLAT OF SUBDIVISION ENTITLED 'LOTS 1 THRU 5, BOSWELL PROPERTY' RECORDED AMONG THE AFORESAID LAND RECORDS IN PLATBOOK 5324 AND 5325, AND THAT ALL MONUMENTS ARE IN PLACE, AS SHOWN IN ACCORDANCE WITH THE ANNOTATED CODE OF MARYLAND, AS AMENDED.

[Signature] 5-2-85
 WILLIAM G. HARTEL, P.L.S. NO. 9436 DATE

RECORDED AS PLAT _____ ON _____ AMONG THE LAND RECORDS OF HOWARD COUNTY, MARYLAND

BOSWELL PROPERTY
LOTS 8-13
 A RESUBDIVISION OF LOTS 1, 3, 4 & 5

OLD FILE NOS.: VP-82-60, VP-85-49-A1, F-82-142 SHEET 2 OF 2
 TAX MAP: 10 EX. ZONING: R
 3 RD ELECTION DISTRICT HOWARD COUNTY, MARYLAND
 SCALE: 1"=100' DATE: APRIL, 1985

boender associates engineers/surveyors/planners
 9805 ELLICOTT MILLS DRIVE
 ELLICOTT CITY, MARYLAND 21104
 BALTIMORE 301-465-7777