

VICINITY MAP
SCALE: 1" = 2000'

- GENERAL NOTES:**
- THIS AREA DESIGNATES A PRIVATE SEWERAGE EASEMENT OF AT LEAST 10,000 SQUARE FEET AS REQUIRED BY THE MARYLAND STATE DEPARTMENT OF THE ENVIRONMENT FOR INDIVIDUAL SEWERAGE DISPOSAL IMPROVEMENTS OF ANY NATURE IN THIS AREA ARE RESTRICTED UNTIL PUBLIC SEWERAGE IS AVAILABLE. THESE EASEMENTS SHALL BECOME NULL AND VOID UPON CONNECTION TO A PUBLIC SEWERAGE SYSTEM. THE COUNTY HEALTH OFFICER SHALL HAVE THE AUTHORITY TO GRANT ADJUSTMENTS TO THE PRIVATE SEWERAGE EASEMENT. RECORDATION OF A MODIFIED SEWERAGE EASEMENT SHALL NOT BE NECESSARY.
 - ADJUSTMENTS TO SEPTIC EASEMENT AREA IS NOT PERMITTED WITHOUT ADDITIONAL TESTING.
 - THE LOT SHOWN HEREON COMPLIES WITH THE MINIMUM OWNERSHIP WIDTH AND LOT AREA AS REQUIRED BY THE MARYLAND STATE DEPARTMENT OF THE ENVIRONMENT.
 - EXISTING WELLS AND/OR SEWERAGE EASEMENTS WITHIN 100 FEET OF THE PROPERTY HAVE BEEN SHOWN FROM THE BEST AVAILABLE INFORMATION.
 - ALL HOUSE SITES SHOWN COMPLY WITH MINIMUM BUILDING RESTRICTION REGULATIONS.
 - TOPOGRAPHY SHOWN IS FIELD RUN BY FISHER COLLINS & CARTER, INC.
 - BOUNDARY OUTLINE BASED ON AVAILABLE DEED OF RECORD WITHOUT THE BENEFIT OF A FIELD SURVEY AT THIS TIME.
 - ANY CHANGES TO A PRIVATE SEWERAGE EASEMENT SHALL REQUIRE A REVISED PERC CERTIFICATION PLAN.
 - DEED REFERENCE LIBER 1055 FOLIO 729.
 - LOW PRESSURE DOSE SYSTEM WILL BE REQUIRED ON LOT 3. DETAILED DESIGN FOR THIS DISTRIBUTION SYSTEM MUST BE AVAILABLE TO THE HEALTH DEPARTMENT WHEN THE RESPECTIVE BUILDING PERMIT PLANS ARE SUBMITTED TO HOWARD COUNTY DIVISION OF INSPECTIONS LICENSES AND PERMITS.
 - AN ADVANCED PRE-TREATMENT SYSTEM, WHICH UTILIZES BEST AVAILABLE TECHNOLOGY TO PERFORM NITROGEN REDUCTION, MUST BE INSTALLED ON THE SEPTIC SYSTEMS LOCATED ON LOT 3. DUE TO ITS LOCATION UPGRADIENT OF SEVERAL EXISTING OR PROPOSED POTABLE WATER WELLS, A SUPPLEMENTAL SITE PLAN WITH ALL OF THE NECESSARY DETAILS FOR INSTALLATION OF THE SYSTEM WILL BE REQUIRED PRIOR TO THE RELEASE OF THE BUILDING PERMIT AND SEPTIC SYSTEM INSTALLATION PERMIT. IN ADDITION, AN OPERATION AND MAINTENANCE CONTRACT AGREEMENT MUST BE FILED WITH HOWARD COUNTY LAND RECORDS PRIOR TO RELEASE OF THE SEPTIC SYSTEM INSTALLATION PERMIT.

LEGEND

- - - EXISTING 2' CONTOURS
- - - EXISTING 10' CONTOURS
- - - EXISTING TREE LINE
- SOIL LINES AND TYPES
- DENOTES PROPOSED WELL
- DENOTES FAILED PERC
- DENOTES PASSED PERC
- DENOTES PROPOSED HOUSE
- DENOTES 1500 Sq.Ft. ALTERNATE WELL SITE
- EXISTING APPROVED PERC AREAS ON 7/19/07
- DENOTES PROPOSED SEPTIC EASEMENT
- DENOTES AN EXISTING SHARED SEPTIC AREA

OWNER

JOSEPH A MARILLEY JR.
MARGARET H MARILLEY
10109 WILLOWOOD RD
KENSINGTON, MD 20895

SOILS LEGEND

SOIL	NAME	CLASS
BeB	Benevolat silt loam, 3 to 8 percent slopes	S
MaC	Manor loam, 8 to 15 percent slopes	S
GgB	Glenelg loam, 3 to 8 percent slopes	S

- NOTES:**
- Hydric soils and/or contains hydric inclusions
 - May contain hydric inclusions
 - † Generally only within 100-year floodplain areas

PLAN
SCALE: 1" = 50'

PERC CERTIFICATION

I certify that the locations shown on this plan are field locations done under my direct supervision and are correct to the best of my professional knowledge and belief.

Signature of Professional Land Surveyor: *Terrell A. Fisher*
Terrell A. Fisher, Professional Land Surveyor No. 30882 EXP. 12/13/15

Date: 7/15/14



APPROVED FOR PRIVATE WATER AND PRIVATE SEWERAGE SYSTEMS,
HOWARD COUNTY HEALTH DEPARTMENT.

Signature of County Health Officer: *Barton B. Moore*
Barton B. Moore, County Health Officer

Date: 8/1/2014

PERC RECERTIFICATION PLAT
MARILLEY PROPERTY

LOT 3
ZONED: RC-DEO
TAX MAP No. 28 GRID No. 18 PARCEL No. 416
FIFTH ELECTION DISTRICT
HOWARD COUNTY, MARYLAND
DATE: July 15, 2014
SHEET 1 OF 1

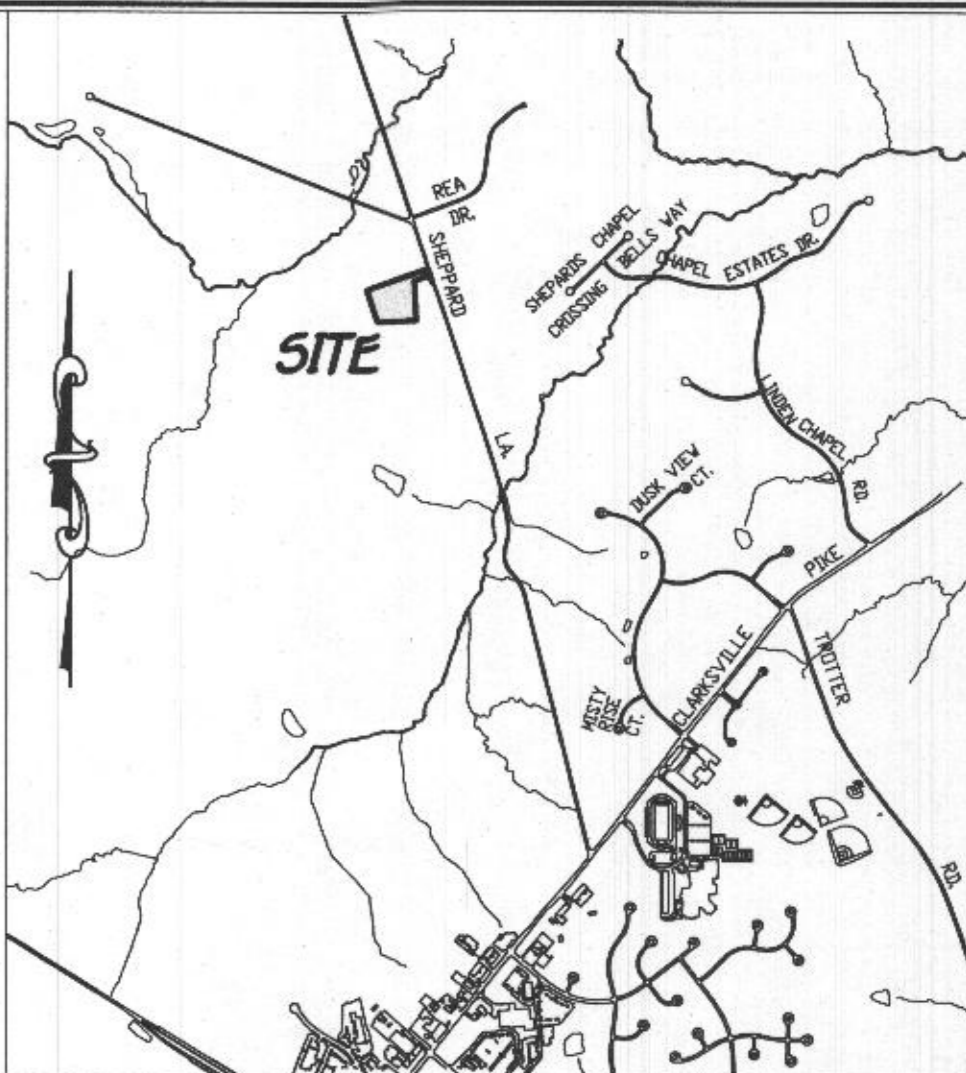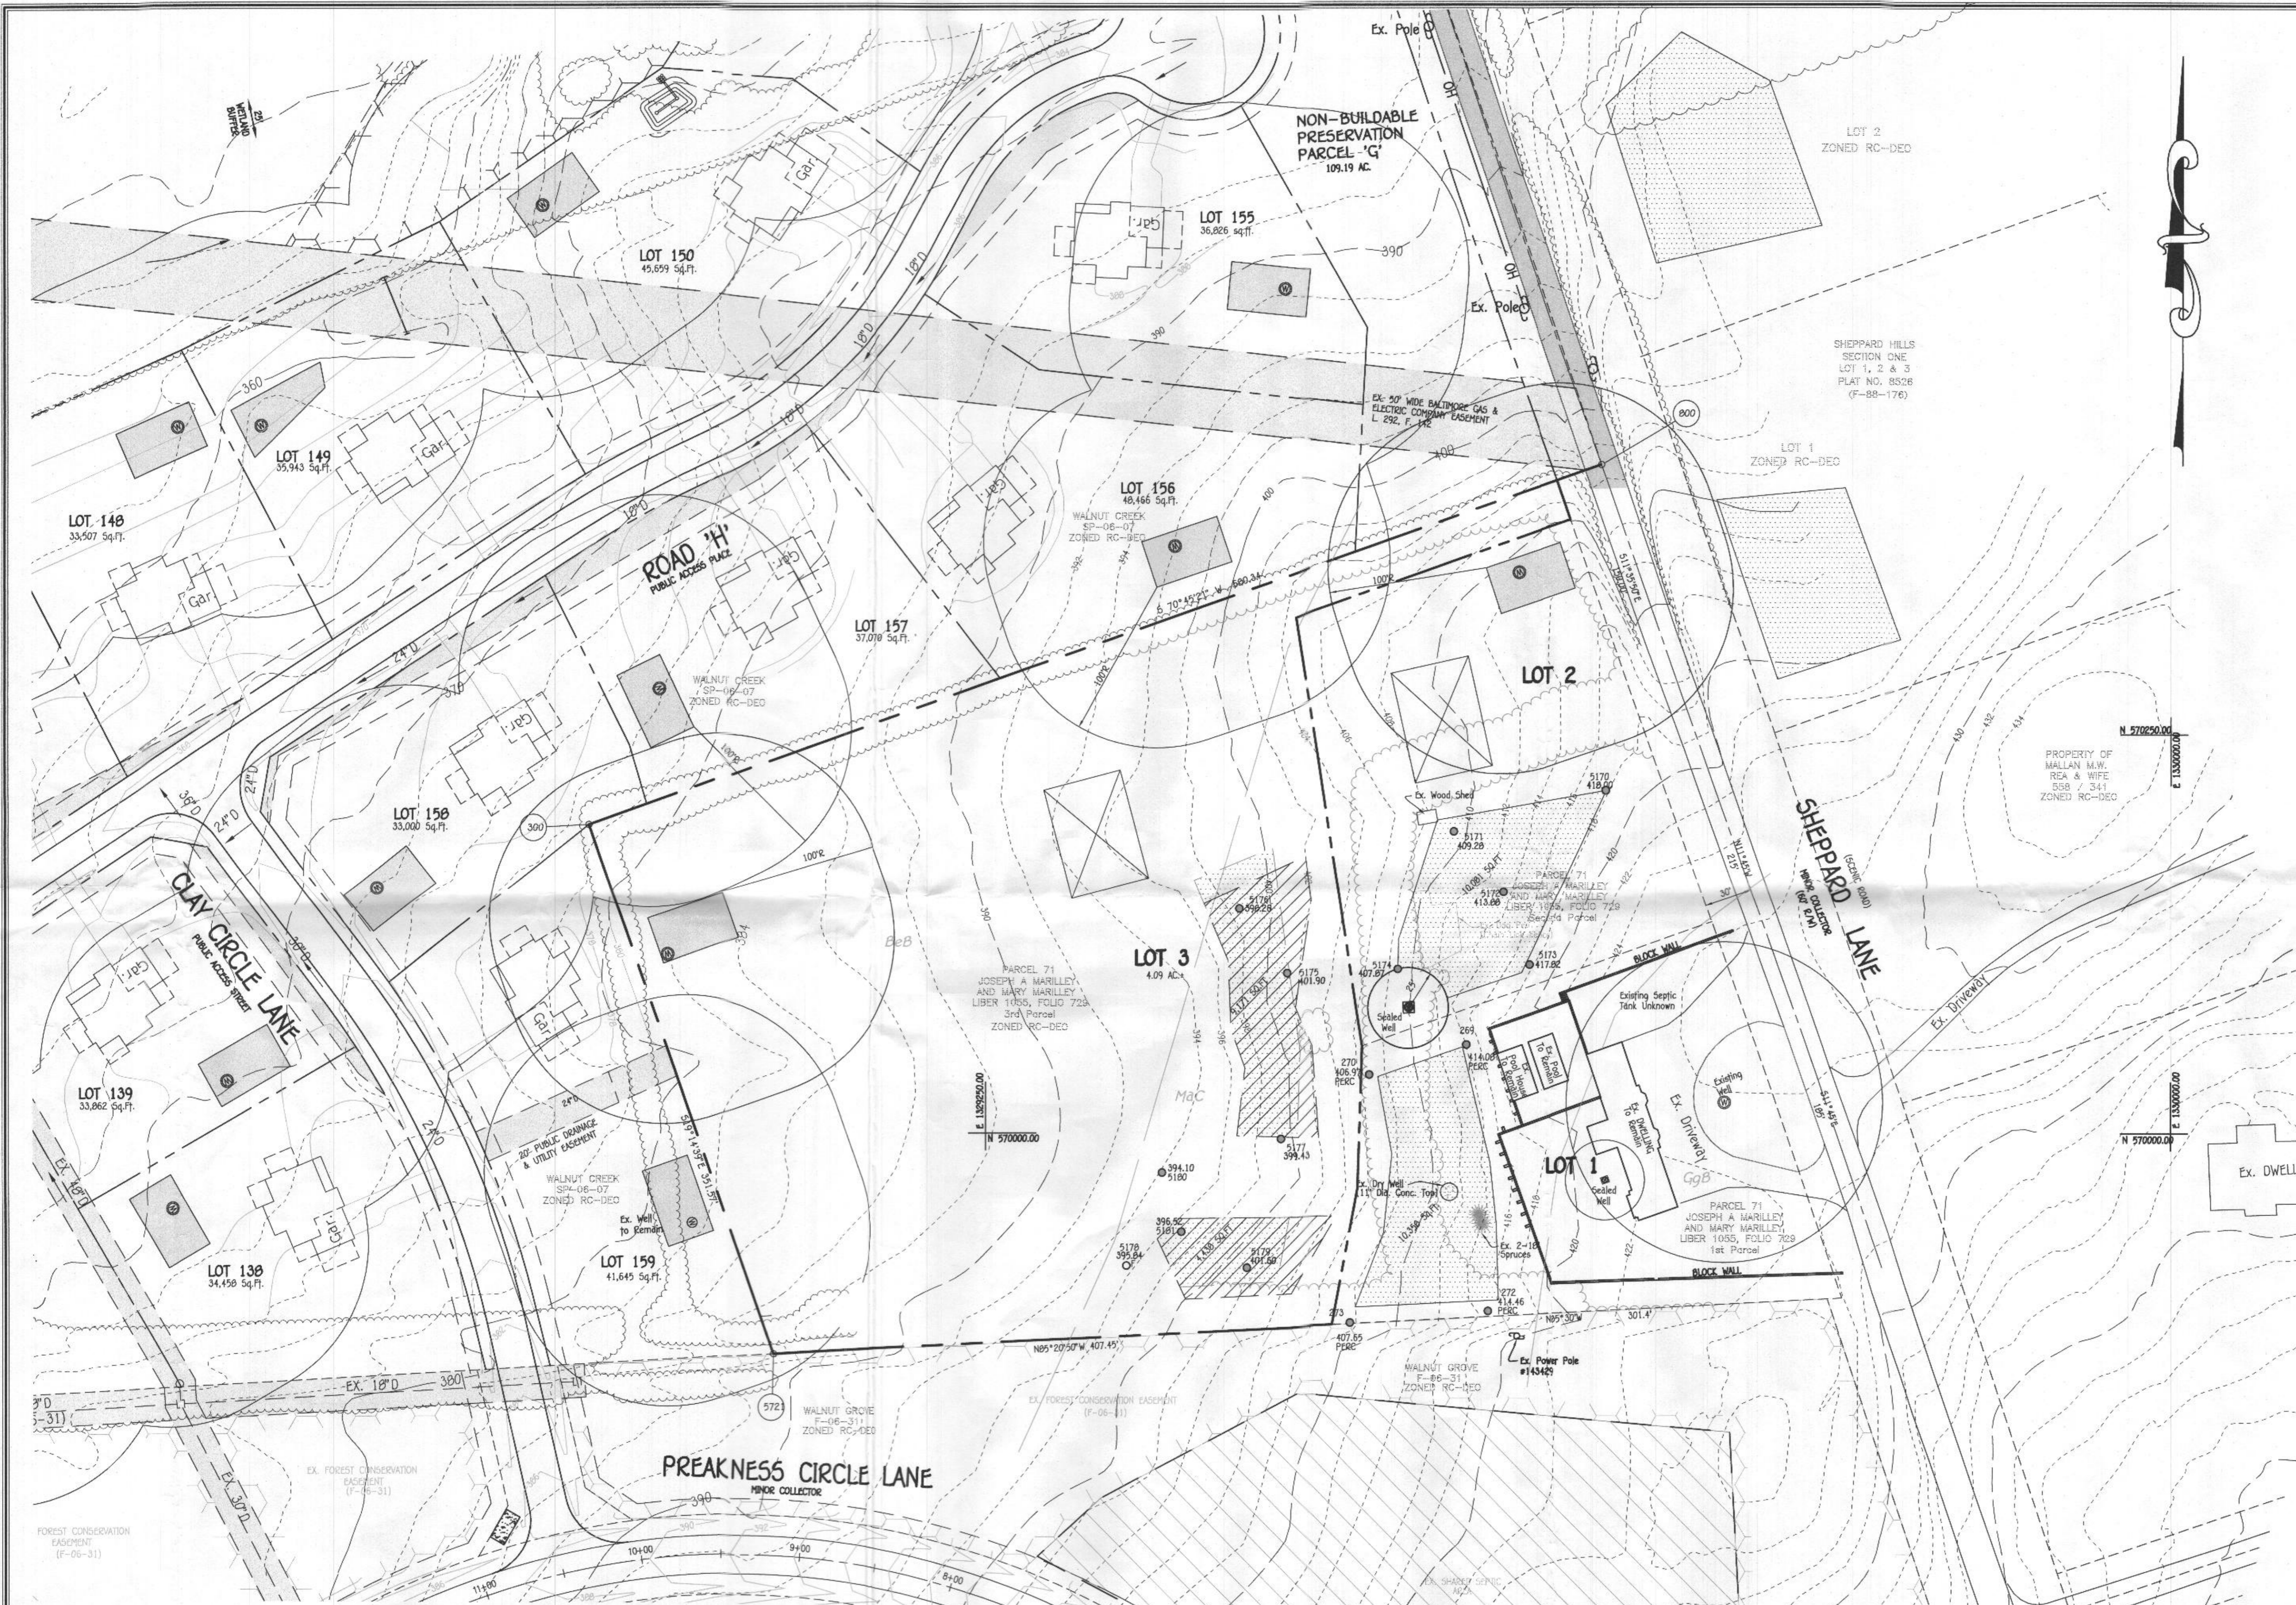

VICINITY MAP
SCALE: 1" = 2000'

- GENERAL NOTES:**
- THIS AREA DESIGNATES A PRIVATE SEWERAGE EASEMENT OF AT LEAST 10,000 SQUARE FEET AS REQUIRED BY THE MARYLAND STATE DEPARTMENT OF THE ENVIRONMENT FOR INDIVIDUAL SEWERAGE DISPOSAL IMPROVEMENTS OF ANY NATURE IN THIS AREA RESTRICTED UNTIL PUBLIC SEWERAGE IS AVAILABLE. THESE EASEMENTS SHALL BECOME NULL AND VOID UPON CONNECTION TO A PUBLIC SEWERAGE SYSTEM. THE COUNTY HEALTH OFFICER SHALL HAVE THE AUTHORITY TO GRANT ADJUSTMENTS TO THE PRIVATE SEWERAGE EASEMENT. RECORDATION OF A MODIFIED SEWERAGE EASEMENT SHALL NOT BE NECESSARY.
 - ADJUSTMENTS TO SEPTIC EASEMENT AREA IS NOT PERMITTED WITHOUT ADDITIONAL TESTING.
 - THE LOT SHOWN HEREON COMPLIES WITH THE MINIMUM OWNERSHIP WIDTH AND LOT AREA AS REQUIRED BY THE MARYLAND STATE DEPARTMENT OF THE ENVIRONMENT.
 - EXISTING WELLS AND/OR SEWERAGE EASEMENTS WITHIN 100 FEET OF THE PROPERTY HAVE BEEN SHOWN FROM THE BEST AVAILABLE INFORMATION.
 - ALL HOUSE SITES SHOWN COMPLY WITH MINIMUM BUILDING RESTRICTION REGULATIONS.
 - TOPOGRAPHY SHOWN IS FIELD RUN BY FISHER COLLINS & CARTER, INC.
 - BOUNDARY OUTLINE BASED ON AVAILABLE DEED OF RECORD WITHOUT THE BENEFIT OF A FIELD SURVEY AT THIS TIME.
 - ANY CHANGES TO A PRIVATE SEWERAGE EASEMENT SHALL REQUIRE A REVISED PERC CERTIFICATION PLAN.
 - DEED REFERENCE LIBER 1095 FOLIO 729.
 - LOW PRESSURE DOSE SYSTEM WILL BE REQUIRED ON LOT 3. DETAILED DESIGN FOR THIS DISTRIBUTION SYSTEM MUST BE AVAILABLE TO THE HEALTH DEPARTMENT WHEN THE RESPECTIVE BUILDING PERMIT PLANS ARE SUBMITTED TO HOWARD COUNTY DIVISION OF INSPECTIONS LICENSES AND PERMITS.
 - AN ADVANCED PRE-TREATMENT SYSTEM WHICH UTILIZES BEST AVAILABLE TECHNOLOGY TO PERFORM NITROGEN REDUCTION, MUST BE INSTALLED ON THE SEPTIC SYSTEMS LOCATED ON LOT 3, DUE TO ITS LOCATION UPGRADIENT OF SEVERAL EXISTING OR PROPOSED POTABLE WATER WELLS. A SUPPLEMENTAL SITE PLAN WITH ALL OF THE NECESSARY DETAILS FOR INSTALLATION OF THE SYSTEM WILL BE REQUIRED PRIOR TO THE RELEASE OF THE BUILDING PERMIT AND SEPTIC SYSTEM INSTALLATION PERMIT. IN ADDITION, AN OPERATION AND MAINTENANCE CONTRACT AGREEMENT MUST BE FILED WITH HOWARD COUNTY LAND RECORDS PRIOR TO RELEASE OF THE SEPTIC SYSTEM INSTALLATION PERMIT.

LEGEND

- EXISTING 2' CONTOURS
- EXISTING 10' CONTOURS
- EXISTING TREE LINE
- SOIL LINES AND TYPES
- PROPOSED WELL
- PROPOSED PERC
- PROPOSED PERC
- PROPOSED HOUSE
- PROPOSED 1500 SQ.FT. ALTERNATE WELL SITE
- EXISTING APPROVED PERC AREAS ON 7/9/07
- PROPOSED SEPTIC EASEMENT
- EXISTING SHARED SEPTIC AREA

OWNER

JOSEPH A MARILLEY JR.
MARGARET M MARILLEY
10109 WILDWOOD RD
KENSINGTON, MD 20895

The Purpose For this Percolation Recertification Plan is to Enlarge the Septic Easement on Lot 3.

SOILS LEGEND

SOIL	NAME	CLASS
BeB	Benevol ailt loam, 3 to 8 percent slopes	B
MaC	Manor loam, 8 to 15 percent slopes	B
GgB	Glenelg loam, 3 to 8 percent slopes	B

NOTES:
 * Hydric soils and/or contains hydric inclusions
 ** May contain hydric inclusions
 † Generally only within 100-year floodplain areas

PLAN
SCALE: 1" = 50'

PERC CERTIFICATION
I certify that the locations shown on this plan are the field locations done under my direct supervision and are correct to the best of my professional knowledge and belief.


Signature of Professional Land Surveyor: *Terrell A. Fisher*
 Terrell A. Fisher, Professional Land Surveyor No. 30882 EXP. 12/15/15
 Date: 7/15/14

APPROVED FOR PRIVATE WATER AND PRIVATE SEWERAGE SYSTEMS,
HOWARD COUNTY HEALTH DEPARTMENT.

Signature of County Health Officer: *Robert M. ...*
 COUNTY HEALTH OFFICER
 Date: 8/1/2014

**PERC RECERTIFICATION PLAT
MARILLEY PROPERTY**

LOT 3
ZONED: RC-DEO
TAX MAP No. 28 GRID No. 19 PARCEL No. 416
FIFTH ELECTION DISTRICT
HOWARD COUNTY, MARYLAND
DATE: July 15, 2014
SHEET 1 OF 1

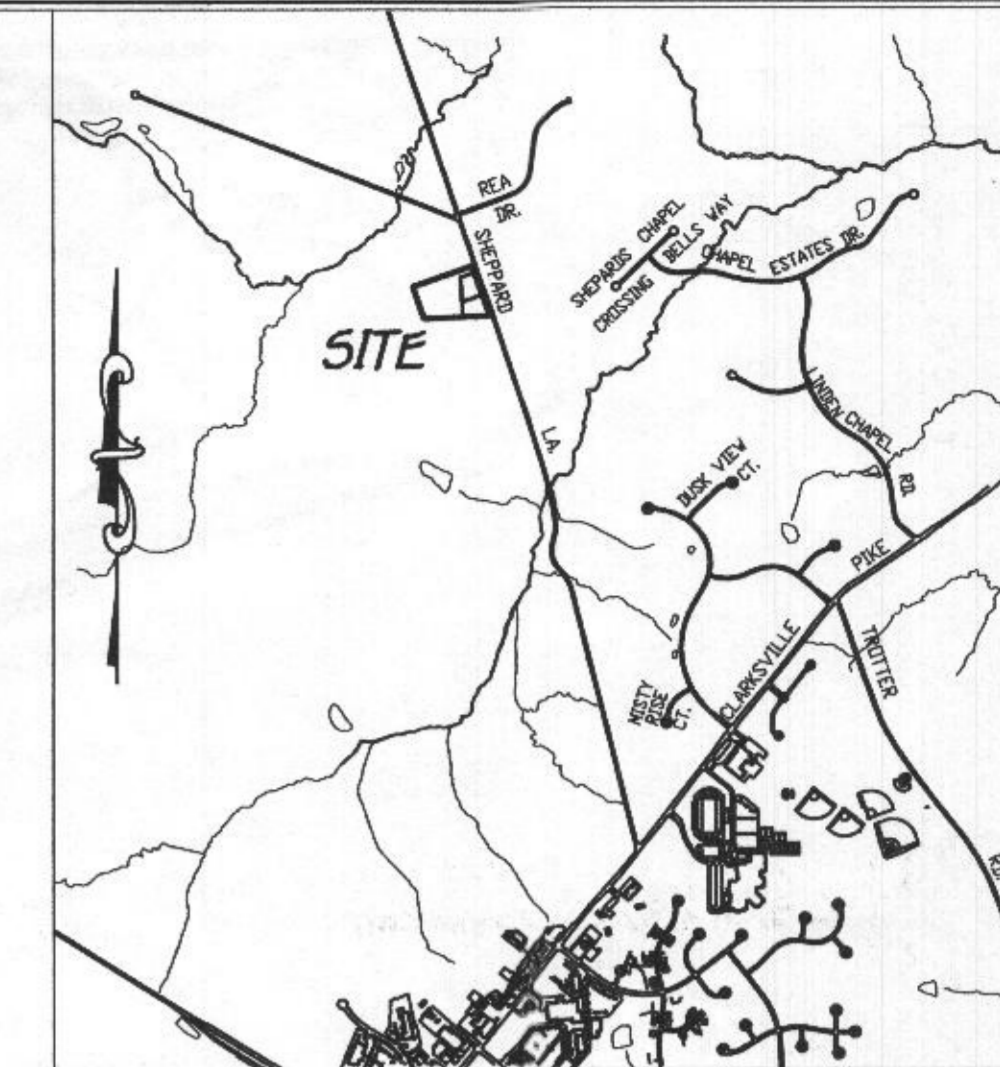

VICINITY MAP
SCALE: 1" = 200'

GENERAL NOTES:

- THIS AREA DESIGNATES A PRIVATE SEWERAGE EASEMENT OF AT LEAST 10,000 SQUARE FEET AS REQUIRED BY THE MARYLAND STATE DEPARTMENT OF THE ENVIRONMENT FOR INDIVIDUAL SEWERAGE DISPOSAL IMPROVEMENTS OF ANY NATURE IN THIS AREA AND RESTRICTED UNTIL PUBLIC SEWERAGE IS AVAILABLE. THESE EASEMENTS SHALL BECOME NULL AND VOID UPON CONNECTION TO A PUBLIC SEWERAGE SYSTEM. THE COUNTY HEALTH OFFICER SHALL HAVE THE AUTHORITY TO GRANT ADJUSTMENTS TO THE PRIVATE SEWERAGE EASEMENT. RECONSTRUCTION OF A MODIFIED SEWERAGE EASEMENT SHALL NOT BE NECESSARY.
- ADJUSTMENTS TO SEPTIC EASEMENT AREA IS NOT PERMITTED WITHOUT ADDITIONAL TESTING.
- THE LOT SHOWN HEREON COMPLIES WITH THE MINIMUM OWNERSHIP WIDTH AND LOT AREA AS REQUIRED BY THE MARYLAND STATE DEPARTMENT OF THE ENVIRONMENT.
- EXISTING WELLS AND/OR SEWERAGE EASEMENTS WITHIN 100 FEET OF THE PROPERTY HAVE BEEN SHOWN FROM THE BEST AVAILABLE INFORMATION.
- ALL HOUSE SITES SHOWN COMPLY WITH MINIMUM BUILDING RESTRICTION REGULATIONS.
- TOPOGRAPHY SHOWN IS FIELD RUN BY FISHER COLLINS & CARTER, INC.
- BOUNDARY OUTLINE BASED ON AVAILABLE DEED OF RECORD WITHOUT THE BENEFIT OF A FIELD SURVEY AT THIS TIME.
- ANY CHANGES TO A PRIVATE SEWERAGE EASEMENT SHALL REQUIRE A REVISED PERC CERTIFICATION PLAN.
- DEED REFERENCE LIBER 1055 FOLIO 729.
- LOW PRESSURE DOSE SYSTEMS WILL BE REQUIRED ON LOTS 2 AND 3, RESPECTIVELY. DETAILED DESIGNS FOR THESE DISTRIBUTION SYSTEMS MUST BE AVAILABLE TO THE HEALTH DEPARTMENT WHEN THE RESPECTIVE BUILDING PERMIT PLANS ARE SUBMITTED TO HOWARD COUNTY DIVISION OF INSPECTIONS LICENSES AND PERMITS.
- AN ADVANCED PRE-TREATMENT SYSTEM, WHICH UTILIZES BEST AVAILABLE TECHNOLOGY TO PERFORM NITROGEN REDUCTION MUST BE INSTALLED ON THE SEPTIC SYSTEMS LOCATED ON LOTS 2 AND 3 RESPECTIVELY, DUE TO THEIR LOCATION UPGRADMENT OF SEVERAL EXISTING OR PROPOSED POTABLE WATER WELLS. A SUPPLEMENTAL SITE PLAN WITH ALL OF THE NECESSARY DETAILS FOR INSTALLATION OF THE SYSTEM WILL BE REQUIRED PRIOR TO THE RELEASE OF THE BUILDING PERMIT AND SEPTIC SYSTEM INSTALLATION PERMIT. IN ADDITION, AN OPERATION AND MAINTENANCE CONTRACT AGREEMENT MUST BE FILED WITH HOWARD COUNTY LAND RECORDS PRIOR TO RELEASE OF THE SEPTIC SYSTEM INSTALLATION PERMIT.
- THE EXISTING SEPTIC TANK ON LOT 1 MUST BE SHOWN TO MEET CURRENT CODE REQUIREMENTS PRIOR TO ANY BUILDING PERMIT APPROVAL FOR LOT 1. THE LOCATION, DEPTH AND CAPACITY OF THE EXISTING SEPTIC TANK MUST BE OBSERVED BY AN ENVIRONMENTAL SANITARIAN. IF IT DOES NOT MEET CODE REQUIREMENTS, THE EXISTING SEPTIC TANK WILL BE REPLACED AND PROPERLY ABANDONED.

LEGEND

- EXISTING 2' CONTOURS
- EXISTING 10' CONTOURS
- EXISTING TREE LINE
- SOIL LINES AND TYPES
- DENOTES PROPOSED WELL
- DENOTES FAILED PERC
- DENOTES PASSED PERC
- DENOTES PROPOSED HOUSE
- DENOTES 15%-24.9% SLOPES
- DENOTES 25% AND GREATER SLOPE
- DENOTES 1500 SQ.FT. ALTERNATE WELL SITE
- PROPOSED PERC TESTS
- APPROVED PERC AREA ON 7/19/07

OWNER

JOSEPH AND MARY MARILLEY
5084 SHEPPARD LANE
ELLCOTT CITY, MD 21042

DEVELOPER

THI PEAGA
HERITAGE LAND DEVELOPMENT
P.O. BOX 482
LISBON, MD 21765
(410) 489-7900

The Purpose for this Percussion Certification Plan is to Identify and Plot the Area to Reserve as a Septic Easement. The Septic Easement Can Not be Utilized Until the Existing Wells Have been Abandoned and the Replacement Well Drilled.

PERC CERTIFICATION PLAT
MARILLEY PROPERTY

LOTS 1 THRU 3
ZONED RC-DEO
TAX MAP No. 2B GRID No. 19 PARCEL No. 71
FIFTH ELECTION DISTRICT
HOWARD COUNTY, MARYLAND
DATE: July 27, 2009
SHEET 1 OF 1



SOIL	NAME	CLASS
BeB	Benevolat silt loam, 3 to 8 percent slopes	B
MaC	Minor loam, 8 to 15 percent slopes	
GgB	Glenely loam, 3 to 8 percent slopes	


- NOTES:
- Hydric soils and/or contains hydric inclusions
 - May contain hydric inclusions
 - Generally only within 100-year floodplain areas

PLAN

SCALE: 1" = 50'

PERC CERTIFICATION
I certify that the location shown hereon are based on field locations done under my direct supervision and are correct to the best of my professional knowledge and belief.
Signature of Professional Land Surveyor: Terrell A. Fisher, Professional Land Surveyor No. 10692
Date: 7/27/09

APPROVED FOR PRIVATE WATER AND PRIVATE SEWERAGE SYSTEMS,
HOWARD COUNTY HEALTH DEPARTMENT.
Signature of County Health Officer: Peter Bealenson
Date: 7/29/2009

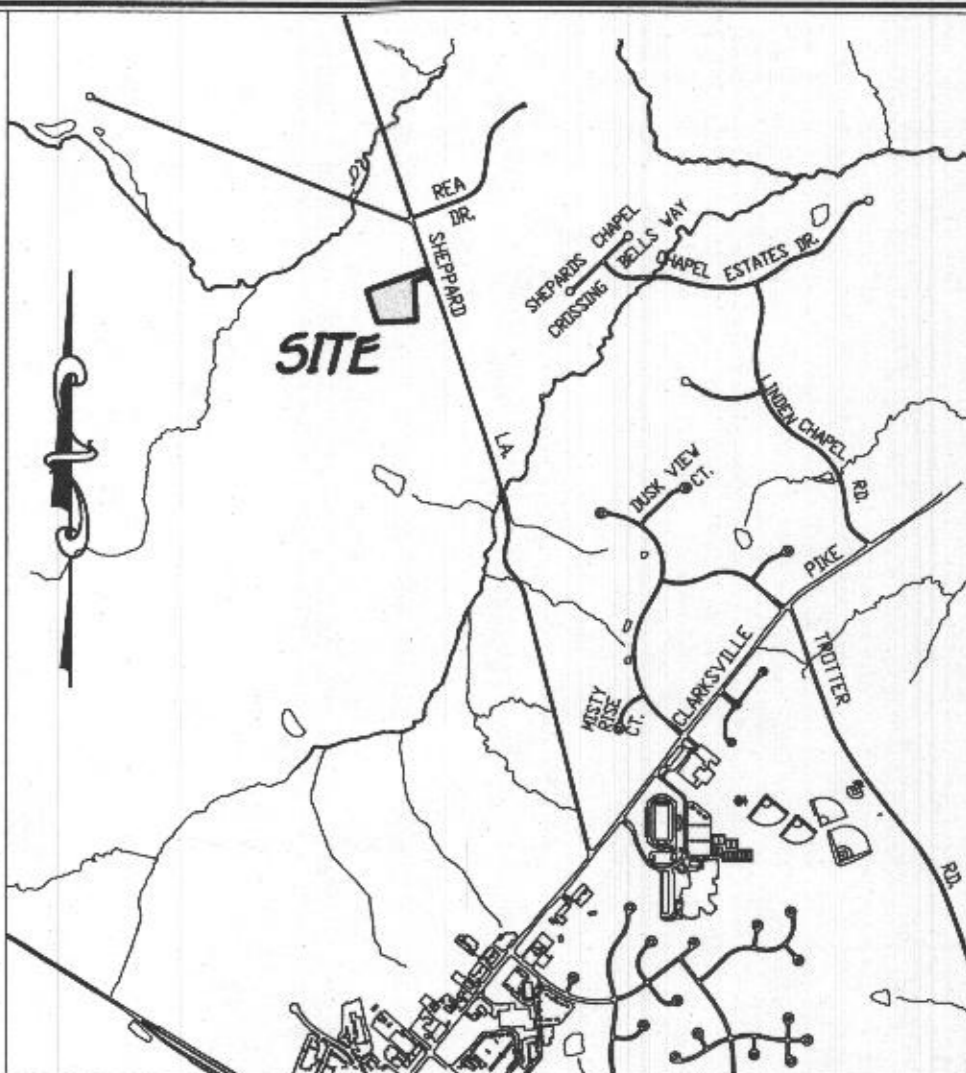

VICINITY MAP
SCALE: 1" = 2000'

- GENERAL NOTES:**
- THIS AREA DESIGNATES A PRIVATE SEWERAGE EASEMENT OF AT LEAST 10,000 SQUARE FEET AS REQUIRED BY THE MARYLAND STATE DEPARTMENT OF THE ENVIRONMENT FOR INDIVIDUAL SEWERAGE DISPOSAL IMPROVEMENTS OF ANY NATURE IN THIS AREA RESTRICTED UNTIL PUBLIC SEWERAGE IS AVAILABLE. THESE EASEMENTS SHALL BECOME NULL AND VOID UPON CONNECTION TO A PUBLIC SEWERAGE SYSTEM. THE COUNTY HEALTH OFFICER SHALL HAVE THE AUTHORITY TO GRANT ADJUSTMENTS TO THE PRIVATE SEWERAGE EASEMENT. RECORDATION OF A MODIFIED SEWERAGE EASEMENT SHALL NOT BE NECESSARY.
 - ADJUSTMENTS TO SEPTIC EASEMENT AREA IS NOT PERMITTED WITHOUT ADDITIONAL TESTING.
 - THE LOT SHOWN HEREON COMPLIES WITH THE MINIMUM OWNERSHIP WIDTH AND LOT AREA AS REQUIRED BY THE MARYLAND STATE DEPARTMENT OF THE ENVIRONMENT.
 - EXISTING WELLS AND/OR SEWERAGE EASEMENTS WITHIN 100 FEET OF THE PROPERTY HAVE BEEN SHOWN FROM THE BEST AVAILABLE INFORMATION.
 - ALL HOUSE SITES SHOWN COMPLY WITH MINIMUM BUILDING RESTRICTION REGULATIONS.
 - TOPOGRAPHY SHOWN IS FIELD RUN BY FISHER COLLINS & CARTER, INC.
 - BOUNDARY OUTLINE BASED ON AVAILABLE DEED OF RECORD WITHOUT THE BENEFIT OF A FIELD SURVEY AT THIS TIME.
 - ANY CHANGES TO A PRIVATE SEWERAGE EASEMENT SHALL REQUIRE A REVISED PERC CERTIFICATION PLAN.
 - DEED REFERENCE LIBER 1095 FOLIO 729.
 - LOW PRESSURE DOSE SYSTEM WILL BE REQUIRED ON LOT 3. DETAILED DESIGN FOR THIS DISTRIBUTION SYSTEM MUST BE AVAILABLE TO THE HEALTH DEPARTMENT WHEN THE RESPECTIVE BUILDING PERMIT PLANS ARE SUBMITTED TO HOWARD COUNTY DIVISION OF INSPECTIONS LICENSES AND PERMITS.
 - AN ADVANCED PRE-TREATMENT SYSTEM WHICH UTILIZES BEST AVAILABLE TECHNOLOGY TO PERFORM NITROGEN REDUCTION, MUST BE INSTALLED ON THE SEPTIC SYSTEMS LOCATED ON LOT 3, DUE TO ITS LOCATION UPGRADIENT OF SEVERAL EXISTING OR PROPOSED POTABLE WATER WELLS. A SUPPLEMENTAL SITE PLAN WITH ALL OF THE NECESSARY DETAILS FOR INSTALLATION OF THE SYSTEM WILL BE REQUIRED PRIOR TO THE RELEASE OF THE BUILDING PERMIT AND SEPTIC SYSTEM INSTALLATION PERMIT. IN ADDITION, AN OPERATION AND MAINTENANCE CONTRACT AGREEMENT MUST BE FILED WITH HOWARD COUNTY LAND RECORDS PRIOR TO RELEASE OF THE SEPTIC SYSTEM INSTALLATION PERMIT.

LEGEND

- EXISTING 2' CONTOURS
- EXISTING 10' CONTOURS
- EXISTING TREE LINE
- SOIL LINES AND TYPES
- PROPOSED WELL
- PROPOSED PERC
- PROPOSED PERC
- PROPOSED HOUSE
- PROPOSED 1500 SQ.FT. ALTERNATE WELL SITE
- EXISTING APPROVED PERC AREAS ON 7/9/07
- PROPOSED SEPTIC EASEMENT
- EXISTING SHARED SEPTIC AREA

OWNER

JOSEPH A MARILLEY JR.
MARGARET M MARILLEY
10109 WILDWOOD RD
KENSINGTON, MD 20895

The Purpose For this Percolation Recertification Plan is to Enlarge the Septic Easement On Lot 3.

SOILS LEGEND

SOIL	NAME	CLASS
BeB	Benevol silt loam, 3 to 8 percent slopes	B
MaC	Manor loam, 8 to 15 percent slopes	B
GgB	Glenelg loam, 3 to 8 percent slopes	B

NOTES:
 * Hydric soils and/or contains hydric inclusions
 ** May contain hydric inclusions
 † Generally only within 100-year floodplain areas

PLAN
SCALE: 1" = 50'

PERC CERTIFICATION
I certify that the locations shown on this plan are the field locations done under my direct supervision and are correct to the best of my professional knowledge and belief.


Signature of Professional Land Surveyor: *Terrell A. Fisher*
 Terrell A. Fisher, Professional Land Surveyor No. 30882 EXP. 12/15/15
 Date: 7/15/14

APPROVED FOR PRIVATE WATER AND PRIVATE SEWERAGE SYSTEMS,
HOWARD COUNTY HEALTH DEPARTMENT.

Signature of County Health Officer: *Robert M. ...*
 COUNTY HEALTH OFFICER
 Date: 8/1/2014

**PERC RECERTIFICATION PLAT
MARILLEY PROPERTY**

LOT 3
ZONED: RC-DEO
 TAX MAP No. 28 GRID No. 19 PARCEL No. 416
 FIFTH ELECTION DISTRICT
 HOWARD COUNTY, MARYLAND
 DATE: July 15, 2014
 SHEET 1 OF 1

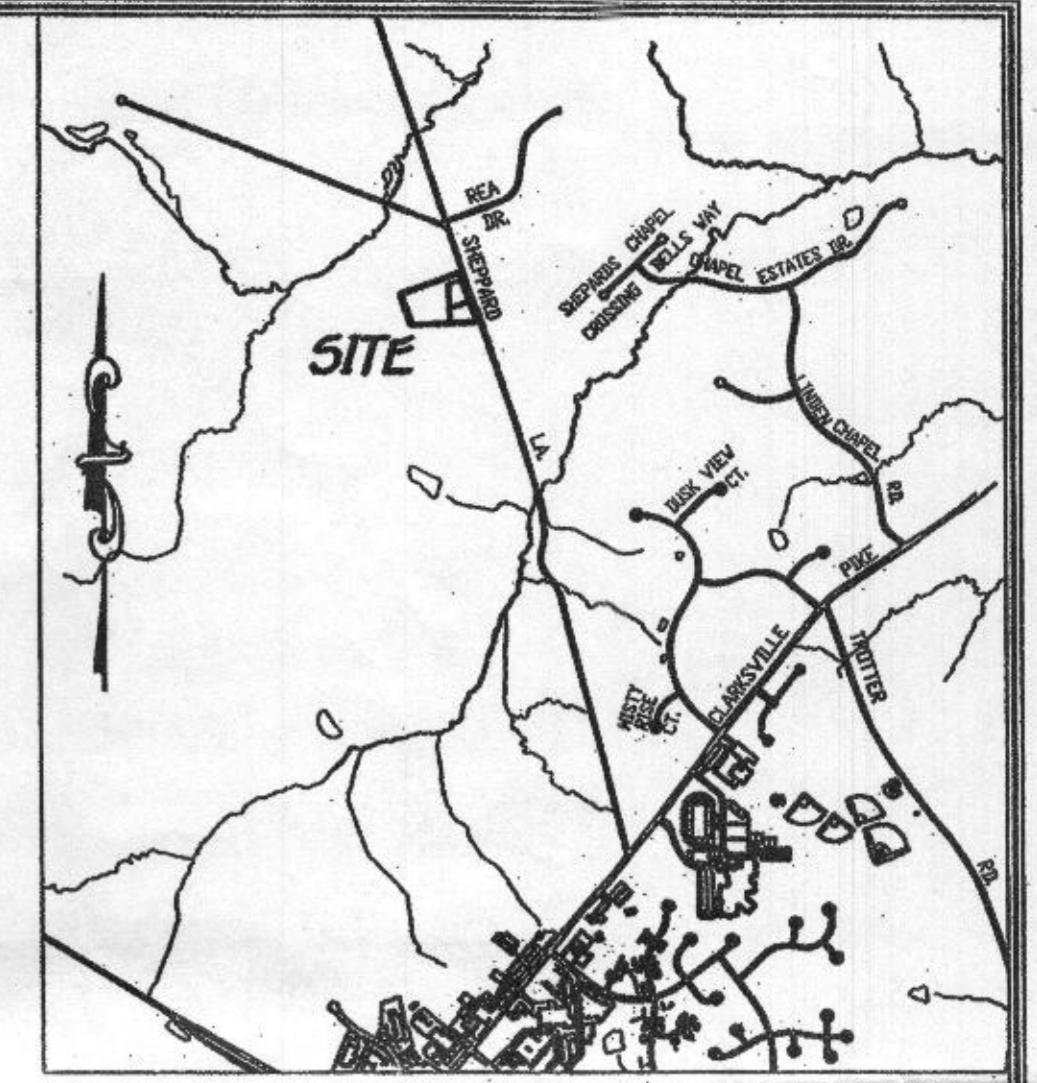

VICINITY MAP
SCALE: 1" = 200'

GENERAL NOTES:

- THIS AREA DESIGNATES A PRIVATE SEWERAGE EASEMENT OF AT LEAST 1000 SQUARE FEET AS REQUIRED BY THE MARYLAND STATE DEPARTMENT OF THE ENVIRONMENT FOR INDIVIDUAL SEWERAGE DISPOSAL. IMPROVEMENTS OF ANY NATURE IN THIS AREA ARE RESTRICTED UNTIL PUBLIC SEWERAGE IS AVAILABLE. THESE EASEMENTS SHALL BECOME NULL AND VOID UPON CONNECTION TO A PUBLIC SEWERAGE SYSTEMS. THE COUNTY HEALTH OFFICER SHALL HAVE THE AUTHORITY TO GRANT ADJUSTMENTS TO THE PRIVATE SEWERAGE EASEMENT. RECORDATION OF A MODIFIED SEWERAGE EASEMENT SHALL NOT BE NECESSARY.
- ADJUSTMENTS TO SEPTIC EASEMENT AREA IS NOT PERMITTED WITHOUT ADDITIONAL TESTING.
- THE LOT SHOWN HEREON COMPLIES WITH THE MINIMUM OWNERSHIP WIDTH AND LOT AREA AS REQUIRED BY THE MARYLAND STATE DEPARTMENT OF THE ENVIRONMENT.
- EXISTING WELLS AND/OR SEWERAGE EASEMENTS WITHIN 100 FEET OF THE PROPERTY HAVE BEEN SHOWN FROM THE BEST AVAILABLE INFORMATION.
- ALL HOUSE SITES SHOWN COMPLY WITH MINIMUM BUILDING RESTRICTION REGULATIONS.
- TOPOGRAPHY SHOWN IS FIELD RUN BY FISHER COLLINS & CARTER, INC.
- BOUNDARY OUTLINE BASED ON AVAILABLE DEEDS OF RECORD WITHOUT THE BENEFIT OF A FIELD SURVEY AT THIS TIME.
- ANY CHANGES TO A PRIVATE SEWERAGE EASEMENT SHALL REQUIRE A REVISED PERC CERTIFICATION PLAN.
- DEED REFERENCE LIBER 1055 FOLIO 729.

LEGEND

- EXISTING 2' CONTOURS
- EXISTING 10' CONTOURS
- EXISTING TREE LINE
- CL B2 MISC SOIL LINES AND TYPES
- ⊕ DENOTES PROPOSED WELL
- ⊖ DENOTES FAILED PERC
- ⊙ DENOTES PASSED PERC
- ⊠ DENOTES PROPOSED HOUSE
- ▨ DENOTES 15%-24.5% SLOPES
- ▩ DENOTES 25% AND GREATER SLOPE
- ⊞ DENOTES 1500 Sq.Ft. ALTERNATE WELL SITE

OWNER

JOSEPH AND MARY MARILLEY
5024 SHEPPARD LANE
ELLCOTT CITY, MD 21042

DEVELOPER

TIM FEAGA
HERITAGE LAND DEVELOPMENT
P.O. BOX 466
LISBON, MD 21765
(410) 469-7900

The Purpose For This Perc Certification Plan is To Identify And PVI The Area To Reserve As A Septic Easement. The Septic Easement Can Not Be Utilized Until The 2 Existing Wells Have Been Abandoned And The Replacement Well Drilled.

**PERC CERTIFICATION PLAT
MARILLEY PROPERTY**

LOT 1
ZONED RC-DEO
TAX MAP No. 29 GRID No. 19 PARCEL No. 71
FIFTH ELECTION DISTRICT
HOWARD COUNTY, MARYLAND
DATE: July 5, 2007
A# 520699
SHEET 1 OF 1

*Superseded
7/29/2009*



SOILS LEGEND



SOIL	NAME	CLASS
BeB	Benevolia silt loam, 3 to 8 percent slopes	B
M3C	Minor loam, 0 to 15 percent slopes	
GgB	Glenns loam, 3 to 8 percent slopes	

- NOTES:**
- Hydric soils and/or contains hydric inclusions
 - Hydric soils and/or contains hydric inclusions
 - Generally only within 100-year floodplain areas

PLAN
SCALE: 1" = 50'

PERC CERTIFICATION
I certify that the locations shown on this plan are based on field locations done under my direct supervision and are true to the best of my professional knowledge and belief.
Signature of Professional Surveyor: Terrell A. Fisher, Professional Surveyor No. 10892
Date: 7/6/07

APPROVED FOR PRIVATE WATER AND PRIVATE SEWERAGE SYSTEMS,
HOWARD COUNTY HEALTH DEPARTMENT.
Signature of County Health Officer: [Signature]
Date: 7/9/07

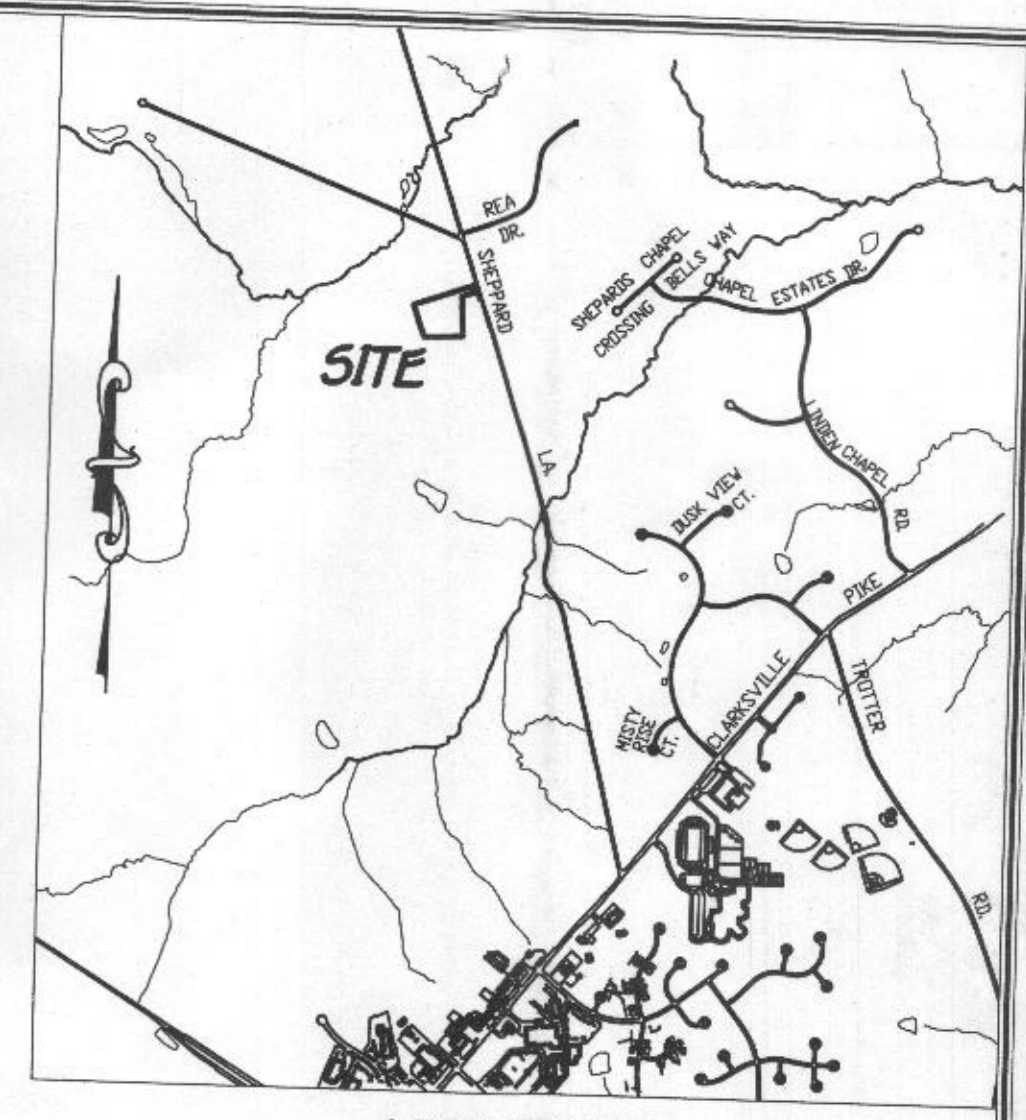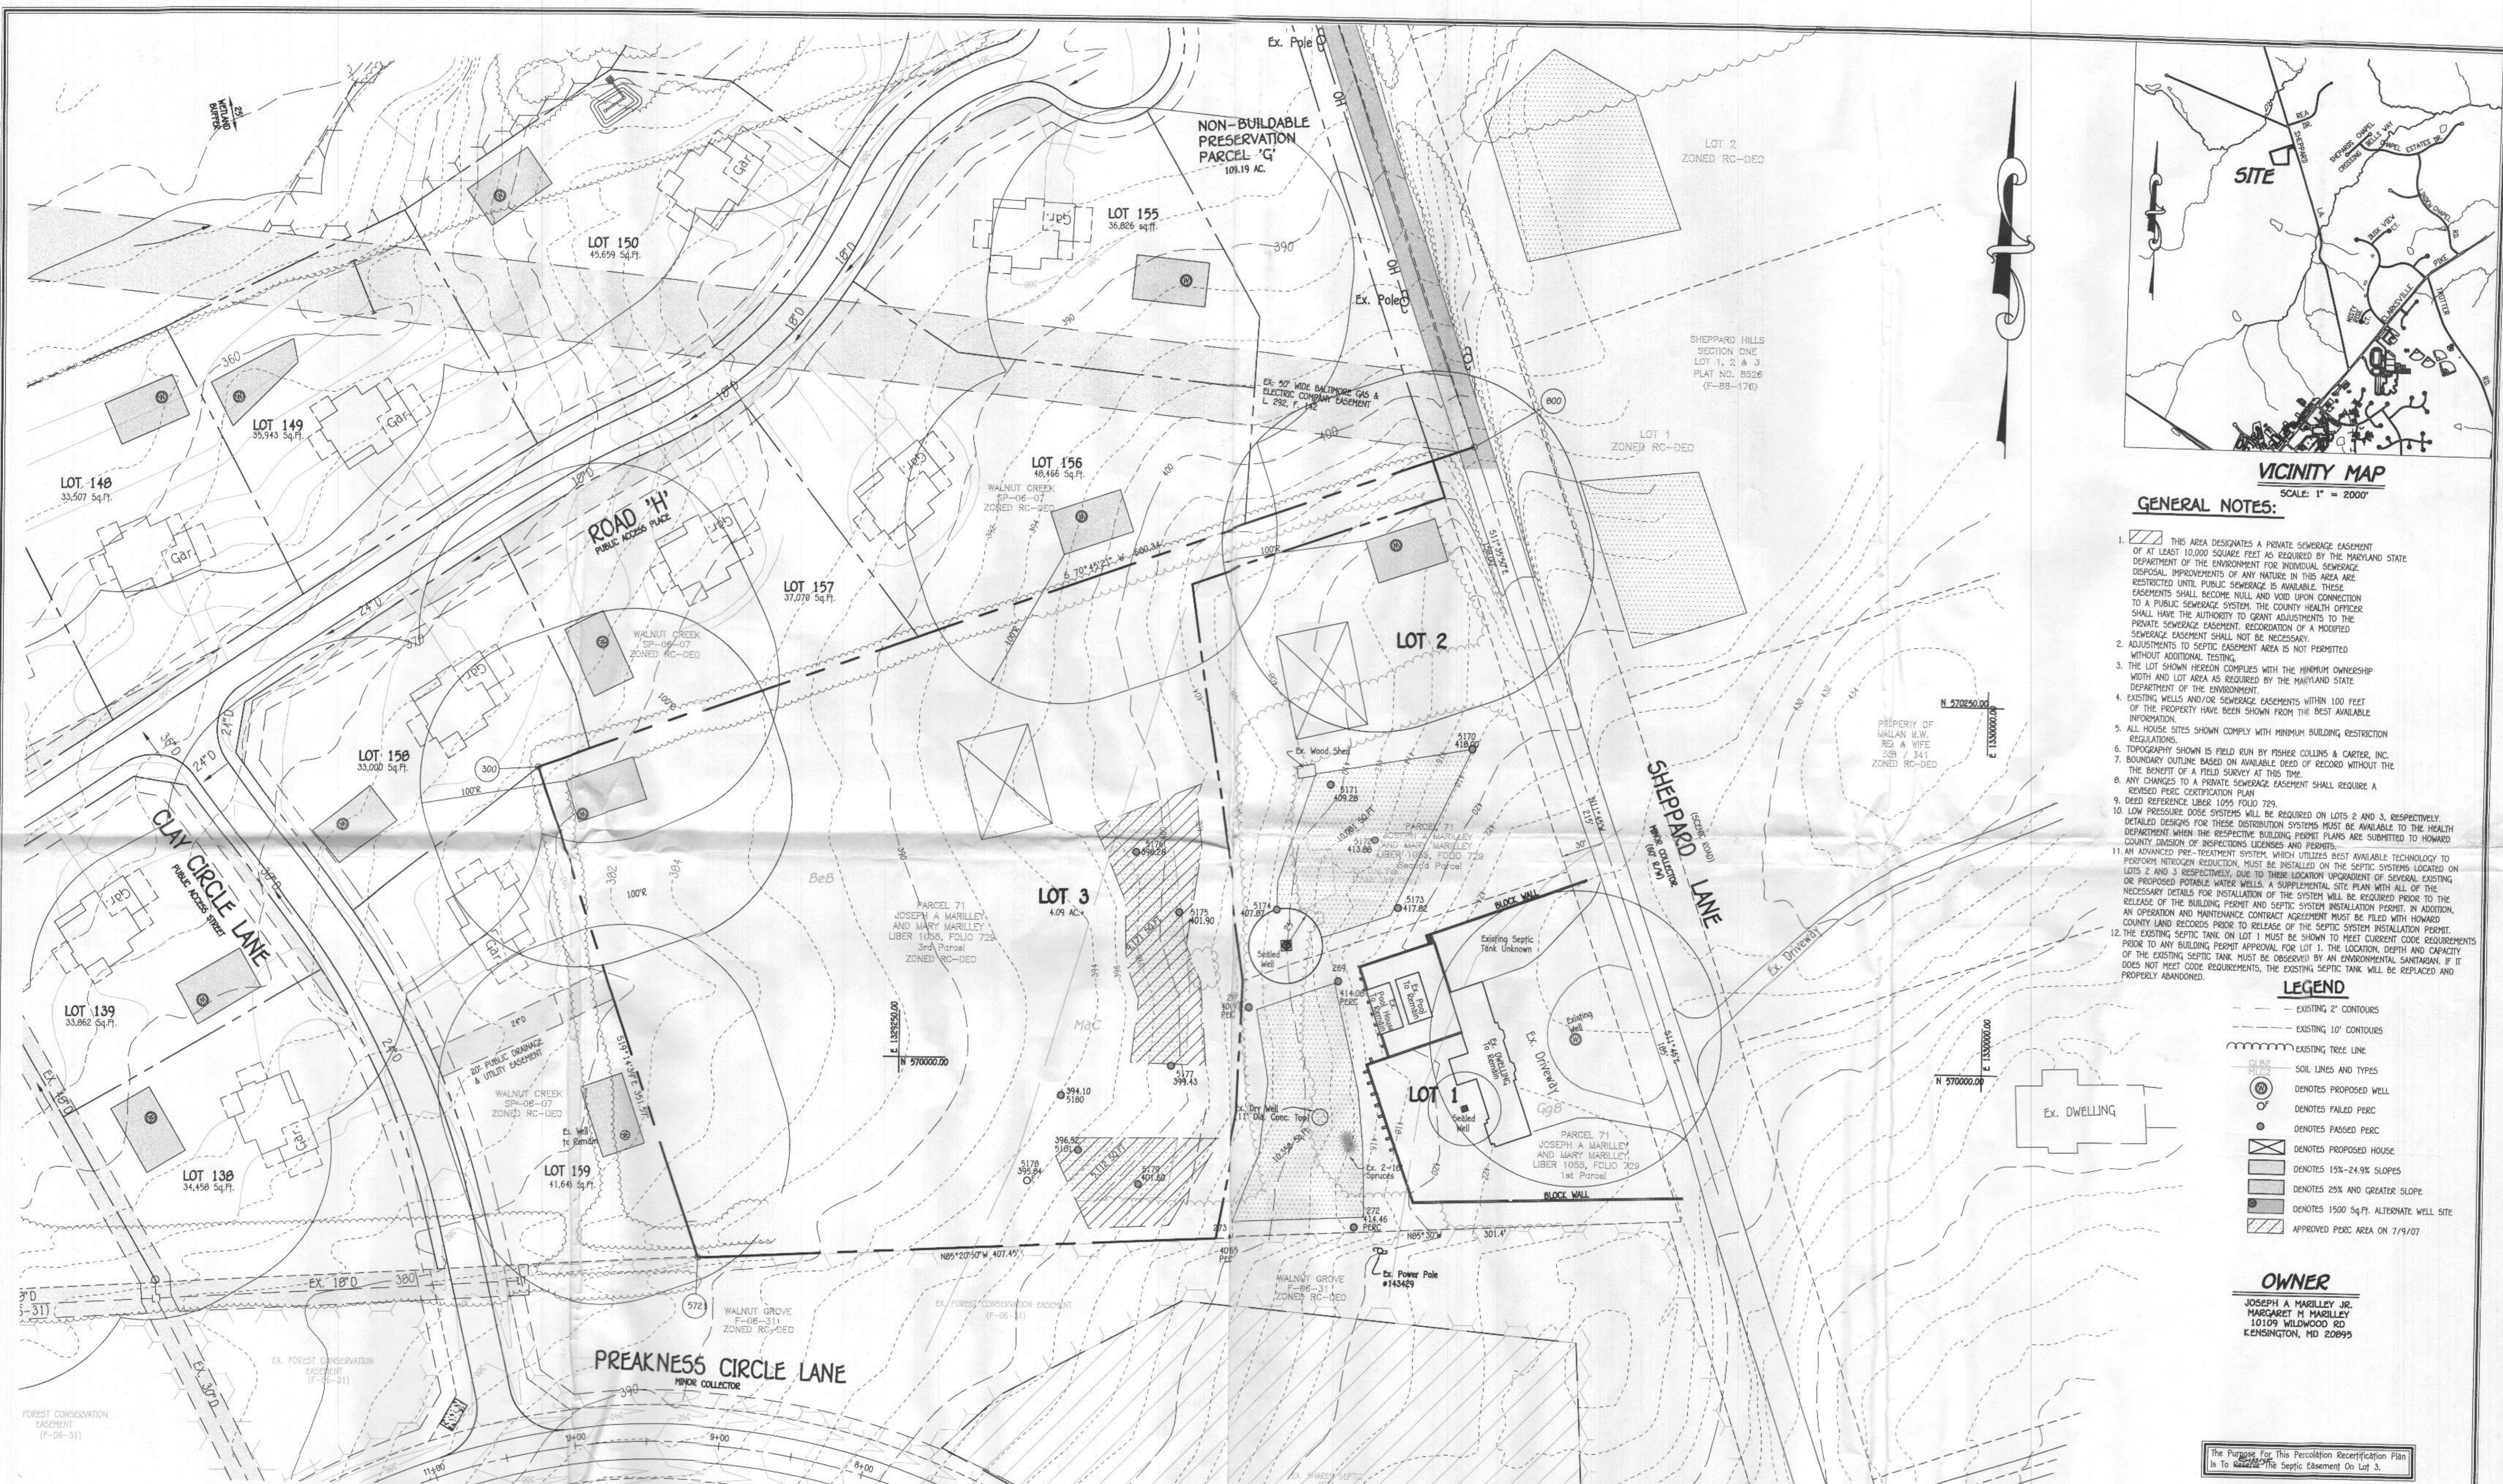

VICINITY MAP
SCALE: 1" = 2000'

- GENERAL NOTES:**
- THIS AREA DESIGNATES A PRIVATE SEWERAGE EASEMENT OF AT LEAST 10,000 SQUARE FEET AS REQUIRED BY THE MARYLAND STATE DEPARTMENT OF THE ENVIRONMENT FOR INDIVIDUAL SEWERAGE DISPOSAL IMPROVEMENTS OF ANY NATURE IN THIS AREA ARE RESTRICTED UNTIL PUBLIC SEWERAGE IS AVAILABLE. THESE EASEMENTS SHALL BECOME NULL AND VOID UPON CONNECTION TO A PUBLIC SEWERAGE SYSTEM. THE COUNTY HEALTH OFFICER SHALL HAVE THE AUTHORITY TO GRANT ADJUSTMENTS TO THE PRIVATE SEWERAGE EASEMENT. RECOGNITION OF A MODIFIED SEWERAGE EASEMENT SHALL NOT BE NECESSARY.
 - ADJUSTMENTS TO SEPTIC EASEMENT AREA IS NOT PERMITTED WITHOUT ADDITIONAL TESTING.
 - THE LOT SHOWN HEREON COMPLIES WITH THE MINIMUM OWNERSHIP WIDTH AND LOT AREA AS REQUIRED BY THE MARYLAND STATE DEPARTMENT OF THE ENVIRONMENT.
 - EXISTING WELLS AND/OR SEWERAGE EASEMENTS WITHIN 100 FEET OF THE PROPERTY HAVE BEEN SHOWN FROM THE BEST AVAILABLE INFORMATION.
 - ALL HOUSE SITES SHOWN COMPLY WITH MINIMUM BUILDING RESTRICTION REGULATIONS.
 - TOPOGRAPHY SHOWN IS FIELD RUN BY FISHER COLLINS & CARTER, INC.
 - BOUNDARY OUTLINE BASED ON AVAILABLE DEED OF RECORD WITHOUT THE BENEFIT OF A FIELD SURVEY AT THIS TIME.
 - ANY CHANGES TO A PRIVATE SEWERAGE EASEMENT SHALL REQUIRE A REVISED PERC CERTIFICATION PLAN.
 - DEED REFERENCE LIBER 1095 FOLIO 729.
 - LOW PRESSURE DOSE SYSTEMS WILL BE REQUIRED ON LOTS 2 AND 3, RESPECTIVELY. DETAILED DESIGNS FOR THESE DISTRIBUTION SYSTEMS MUST BE AVAILABLE TO THE HEALTH DEPARTMENT WHEN THE RESPECTIVE BUILDING PERMIT PLANS ARE SUBMITTED TO HOWARD COUNTY DIVISION OF INSPECTIONS LICENSES AND PERMITS.
 - AN ADVANCED PRE-TREATMENT SYSTEM, WHICH UTILIZES BEST AVAILABLE TECHNOLOGY TO PERFORM NITROGEN REDUCTION, MUST BE INSTALLED ON THE SEPTIC SYSTEMS LOCATED ON LOTS 2 AND 3 RESPECTIVELY. DUE TO THEIR LOCATION UPGRADENT OF SEVERAL EXISTING OR PROPOSED POTABLE WATER WELLS, A SUPPLEMENTAL SITE PLAN WITH ALL OF THE NECESSARY DETAILS FOR INSTALLATION OF THE SYSTEM WILL BE REQUIRED PRIOR TO THE RELEASE OF THE BUILDING PERMIT AND SEPTIC SYSTEM INSTALLATION PERMIT. IN ADDITION, AN OPERATION AND MAINTENANCE CONTRACT AGREEMENT MUST BE FILED WITH HOWARD COUNTY LAND RECORDS PRIOR TO RELEASE OF THE SEPTIC SYSTEM INSTALLATION PERMIT.
 - THE EXISTING SEPTIC TANK ON LOT 1 MUST BE SHOWN TO MEET CURRENT CODE REQUIREMENTS PRIOR TO ANY BUILDING PERMIT APPROVAL FOR LOT 1. THE LOCATION, DEPTH AND CAPACITY OF THE EXISTING SEPTIC TANK MUST BE OBSERVED BY AN ENVIRONMENTAL SANITARIAN. IF IT DOES NOT MEET CODE REQUIREMENTS, THE EXISTING SEPTIC TANK WILL BE REPLACED AND PROPERLY ABANDONED.

- LEGEND**
- EXISTING 2' CONTOURS
 - EXISTING 10' CONTOURS
 - EXISTING TREE LINE
 - SOIL LINES AND TYPES
 - ⊙ DENOTES PROPOSED WELL
 - ⊙ DENOTES FAILED PERC
 - ⊙ DENOTES PASSED PERC
 - ⊙ DENOTES PROPOSED HOUSE
 - ▨ DENOTES 15%-24.9% SLOPES
 - ▨ DENOTES 25% AND GREATER SLOPE
 - ▨ DENOTES 1500 SQ.FT. ALTERNATE WELL SITE
 - ▨ APPROVED PERC AREA ON 7/9/07

OWNER
JOSEPH A MARILLEY JR.
MARGARET M MARILLEY
10109 WILDWOOD RD
KENSINGTON, MD 20895

SOILS LEGEND

SOIL	NAME	CLASS
BeB	Benevola silt loam, 3 to 8 percent slopes	B
MaC	Minor loam, 0 to 15 percent slopes	B
GgB	Gleneig loam, 3 to 8 percent slopes	B

NOTES:

- Hydric soils and/or contains hydric inclusions
- ** May contain hydric inclusions
- † Generally only within 100-year floodplain areas

PLAN
SCALE: 1" = 50'

PERC CERTIFICATION

I certify that the locations shown on this plan are based on field locations done under my direct supervision and are correct to the best of my professional knowledge and belief.


Signature of Professional Land Surveyor: *Terrell A. Fisher* Date: 6/19/14
Terrell A. Fisher, Professional Land Surveyor, No. 145469, EXP. 12/13/15

APPROVED FOR PRIVATE WATER AND PRIVATE SEWERAGE SYSTEMS,
HOWARD COUNTY HEALTH DEPARTMENT.

COUNTY HEALTH OFFICER: _____ DATE: _____

**PERC RECERTIFICATION PLAT
MARILLEY PROPERTY**

LOT 3
ZONED: RC-DEO
TAX MAP No. 20 GRID No. 10 PARCEL No. 416
FIFTH ELECTION DISTRICT
HOWARD COUNTY, MARYLAND
DATE: June 19, 2014
SHEET 1 OF 1

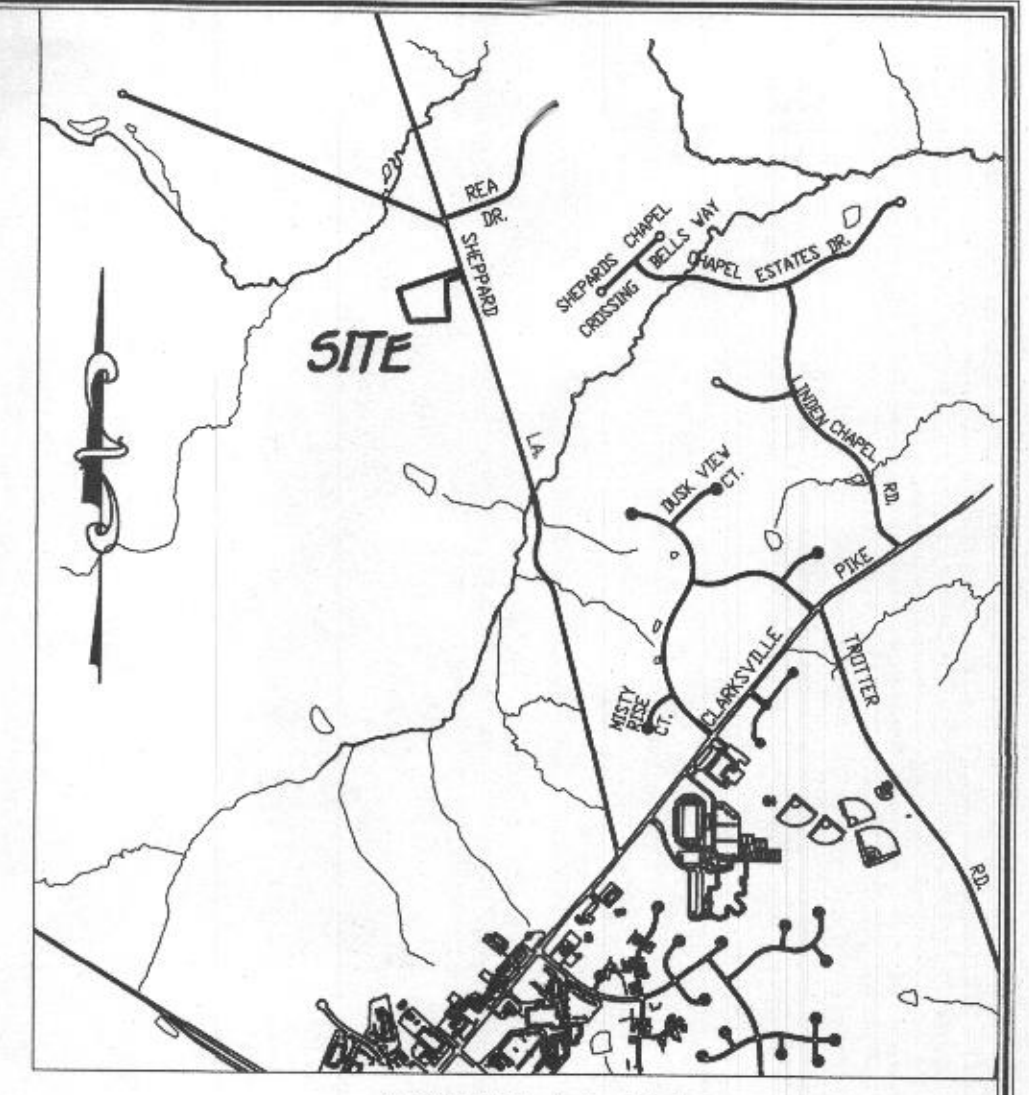

- GENERAL NOTES:**
- THIS AREA DESIGNATES A PRIVATE SEWERAGE EASEMENT OF AT LEAST 10,000 SQUARE FEET AS REQUIRED BY THE MARYLAND STATE DEPARTMENT OF THE ENVIRONMENT FOR INDIVIDUAL SEWERAGE DISPOSAL IMPROVEMENTS OF ANY NATURE IN THIS AREA ARE RESTRICTED UNTIL PUBLIC SEWERAGE IS AVAILABLE. THESE EASEMENTS SHALL BECOME NULL AND VOID UPON CONNECTION TO A PUBLIC SEWERAGE SYSTEM. THE COUNTY HEALTH OFFICER SHALL HAVE THE AUTHORITY TO GRANT ADJUSTMENTS TO THE PRIVATE SEWERAGE EASEMENT. RECONSTRUCTION OF A MODIFIED SEWERAGE EASEMENT SHALL NOT BE NECESSARY.
 - ADJUSTMENTS TO SEPTIC EASEMENT AREA IS NOT PERMITTED WITHOUT ADDITIONAL TESTING.
 - THE LOT SHOWN HEREON COMPLIES WITH THE MINIMUM OWNERSHIP WIDTH AND LOT AREA AS REQUIRED BY THE MARYLAND STATE DEPARTMENT OF THE ENVIRONMENT.
 - EXISTING WELLS AND/OR SEWERAGE EASEMENTS WITHIN 100 FEET OF THE PROPERTY HAVE BEEN SHOWN FROM THE BEST AVAILABLE INFORMATION.
 - ALL HOUSE SITES SHOWN COMPLY WITH MINIMUM BUILDING RESTRICTION REGULATIONS.
 - TOPOGRAPHY SHOWN IS FIELD RUN BY FISHER COLLINS & CARTER, INC. BOUNDARY OUTLINE BASED ON AVAILABLE DEED OF RECORD WITHOUT THE BENEFIT OF A FIELD SURVEY AT THIS TIME.
 - ANY CHANGES TO A PRIVATE SEWERAGE EASEMENT SHALL REQUIRE A REVISED PERC CERTIFICATION PLAN.
 - DEED REFERENCE LIBER 1095 FOLIO 729.
 - LOW PRESSURE DOSE SYSTEMS WILL BE REQUIRED ON LOTS 2 AND 3, RESPECTIVELY. DETAILED DESIGNS FOR THESE DISTRIBUTION SYSTEMS MUST BE AVAILABLE TO THE HEALTH DEPARTMENT WHEN THE RESPECTIVE BUILDING PERMIT PLANS ARE SUBMITTED TO HOWARD COUNTY DIVISION OF INSPECTIONS LICENSES AND PERMITS.
 - AN ADVANCED PRE-TREATMENT SYSTEM, WHICH UTILIZES BEST AVAILABLE TECHNOLOGY TO PERFORM NITROGEN REDUCTION, MUST BE INSTALLED ON THE SEPTIC SYSTEMS LOCATED ON LOTS 2 AND 3 RESPECTIVELY, DUE TO THEIR LOCATION UPSTREAM OF SEVERAL EXISTING OR PROPOSED POTABLE WATER WELLS. A SUPPLEMENTAL SITE PLAN WITH ALL OF THE NECESSARY DETAILS FOR INSTALLATION OF THE SYSTEM WILL BE REQUIRED PRIOR TO THE RELEASE OF THE BUILDING PERMIT AND SEPTIC SYSTEM INSTALLATION PERMIT. IN ADDITION, AN OPERATION AND MAINTENANCE CONTRACT AGREEMENT MUST BE FILED WITH HOWARD COUNTY LAND RECORDS PRIOR TO RELEASE OF THE SEPTIC SYSTEM INSTALLATION PERMIT.
 - THE EXISTING SEPTIC TANK ON LOT 1 MUST BE SHOWN TO MEET CURRENT CODE REQUIREMENTS PRIOR TO ANY BUILDING PERMIT APPROVAL FOR LOT 1. THE LOCATION, DEPTH AND CAPACITY OF THE EXISTING SEPTIC TANK MUST BE OBSERVED BY AN ENVIRONMENTAL SANITARIAN. IF IT DOES NOT MEET CODE REQUIREMENTS, THE EXISTING SEPTIC TANK WILL BE REPLACED AND PROPERLY ABANDONED.


- LEGEND**
- EXISTING 2' CONTOURS
 - EXISTING 10' CONTOURS
 - EXISTING TREE LINE
 - SOIL LINES AND TYPES
 - ⊙ DENOTES PROPOSED WELL
 - ⊙ DENOTES FAILED PERC
 - ⊙ DENOTES PASSED PERC
 - ⊙ DENOTES PROPOSED HOUSE
 - ⊙ DENOTES 15%-24.9% SLOPES
 - ⊙ DENOTES 25% AND GREATER SLOPE
 - ⊙ DENOTES 1500 SQ.FT. ALTERNATE WELL SITE
 - ⊙ APPROVED PERC AREA ON 7/9/07

OWNER
JOSEPH A MARILLEY JR.
MARGARET M MARILLEY
10109 WILWOOD RD
KENSINGTON, MD 20895

The Purpose For This Percalation Recertification Plan Is To Reverify The Septic Easement On Lot 3.

**PERC RECERTIFICATION PLAT
MARILLEY PROPERTY**

LOT 3
ZONED: RC-DEO
TAX MAP No. 28 GRID No. 18 PARCEL No. 416
FIFTH ELECTION DISTRICT
HOWARD COUNTY, MARYLAND
DATE: June 19, 2014
SHEET 1 OF 1

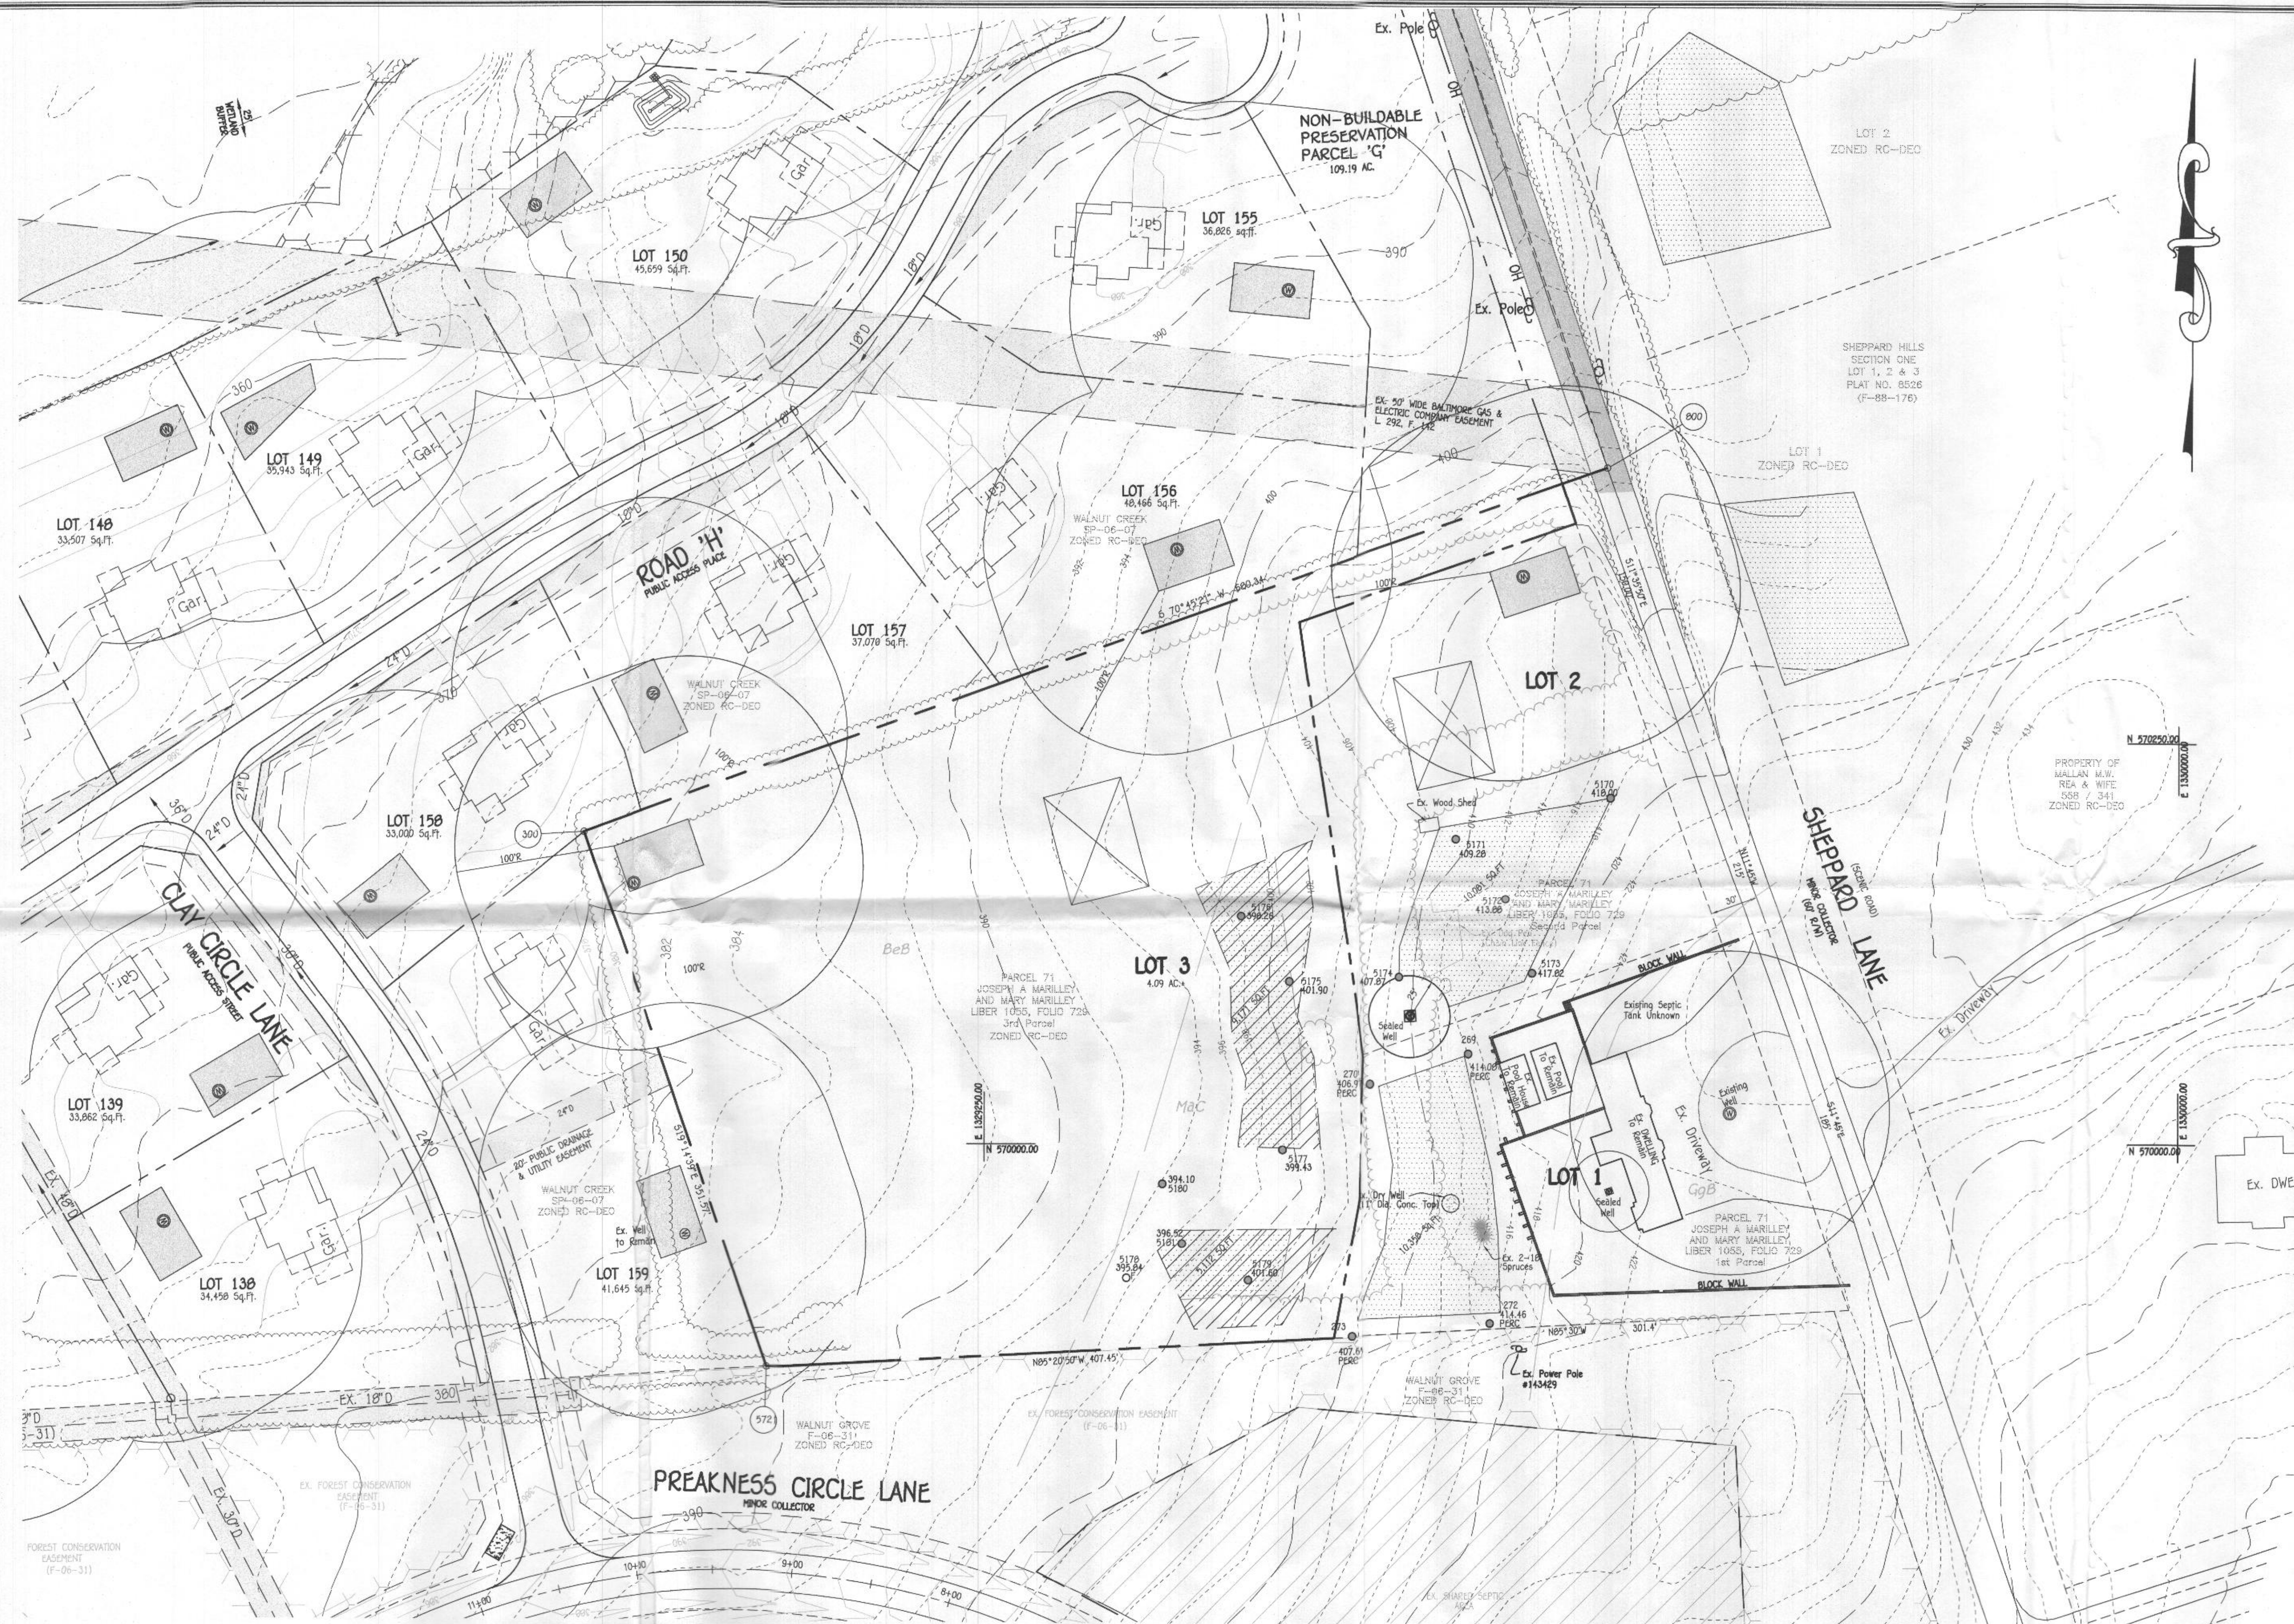

SOILS LEGEND

SOIL	NAME	CLASS
BeB	Benevola silt loam, 3 to 8 percent slopes	B
MaC	Manor loam, 0 to 15 percent slopes	B
GgB	Glensig loam, 3 to 8 percent slopes	B

NOTES:
• Hydric soils and/or contains hydric inclusions
•• May contain hydric inclusions
† Generally only within 100-year floodplain areas



PLAN
SCALE: 1" = 50'

PERC CERTIFICATION
I certify that the locations shown on this plan are the field locations done under my direct supervision and are correct to the best of my professional knowledge and belief.
Signature of Professional Land Surveyor: Terrell A. Fisher, Professional Land Surveyor, No. 3082 EXP. 12/13/15
Date: 6/19/14

APPROVED FOR PRIVATE WATER AND PRIVATE SEWERAGE SYSTEMS,
HOWARD COUNTY HEALTH DEPARTMENT.
COUNTY HEALTH OFFICER _____ DATE _____

E:\2006\06075\dwg\06075-Revise Prec Cert 6-20-14.dwg, Layout1, 6/19/2014 11:58:20 AM, 1:1

FISHER, COLLINS & CARTER, INC.
CIVIL ENGINEERING CONSULTANTS & LAND SURVEYORS
CONTINENTAL SQUARE OFFICE PARK - 10272 BALTIMORE NATIONAL PIKE
CLARKE CITY, MARYLAND 21784
(410) 461-1200

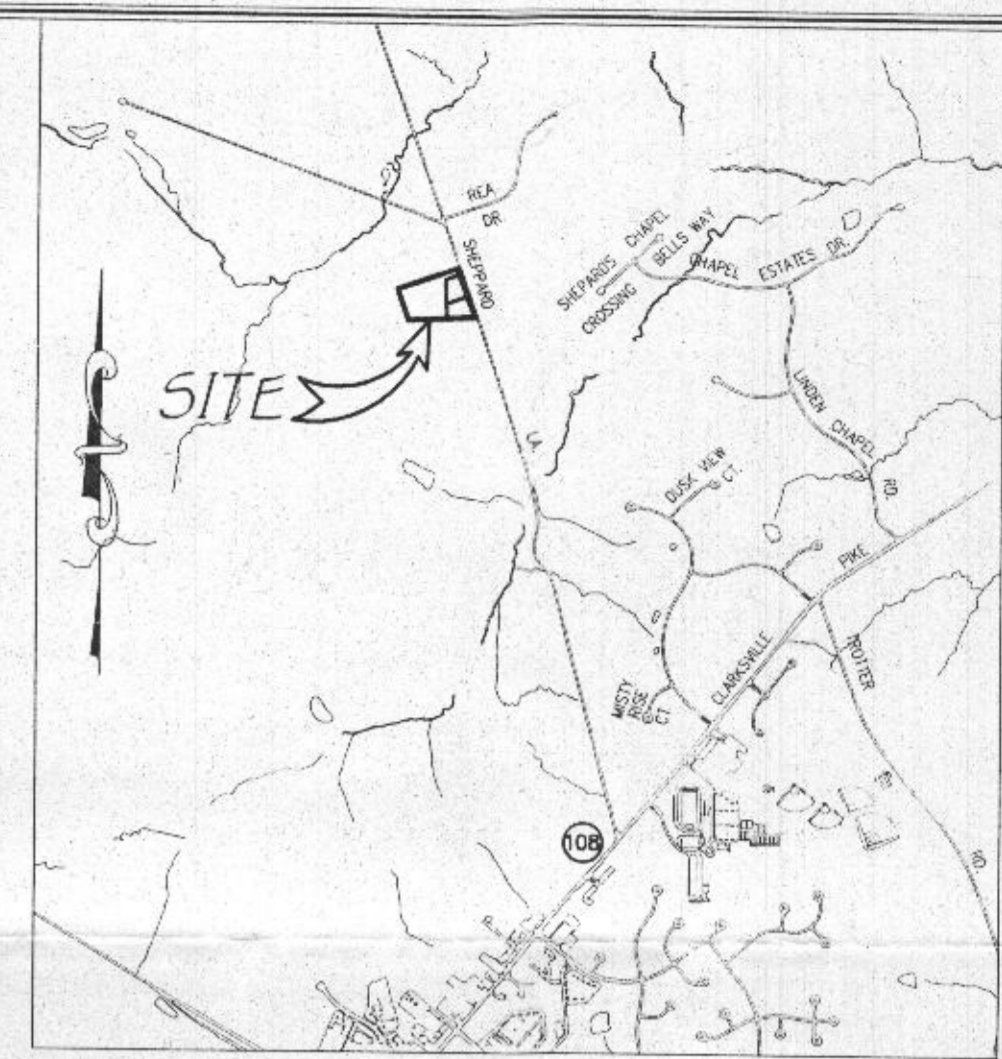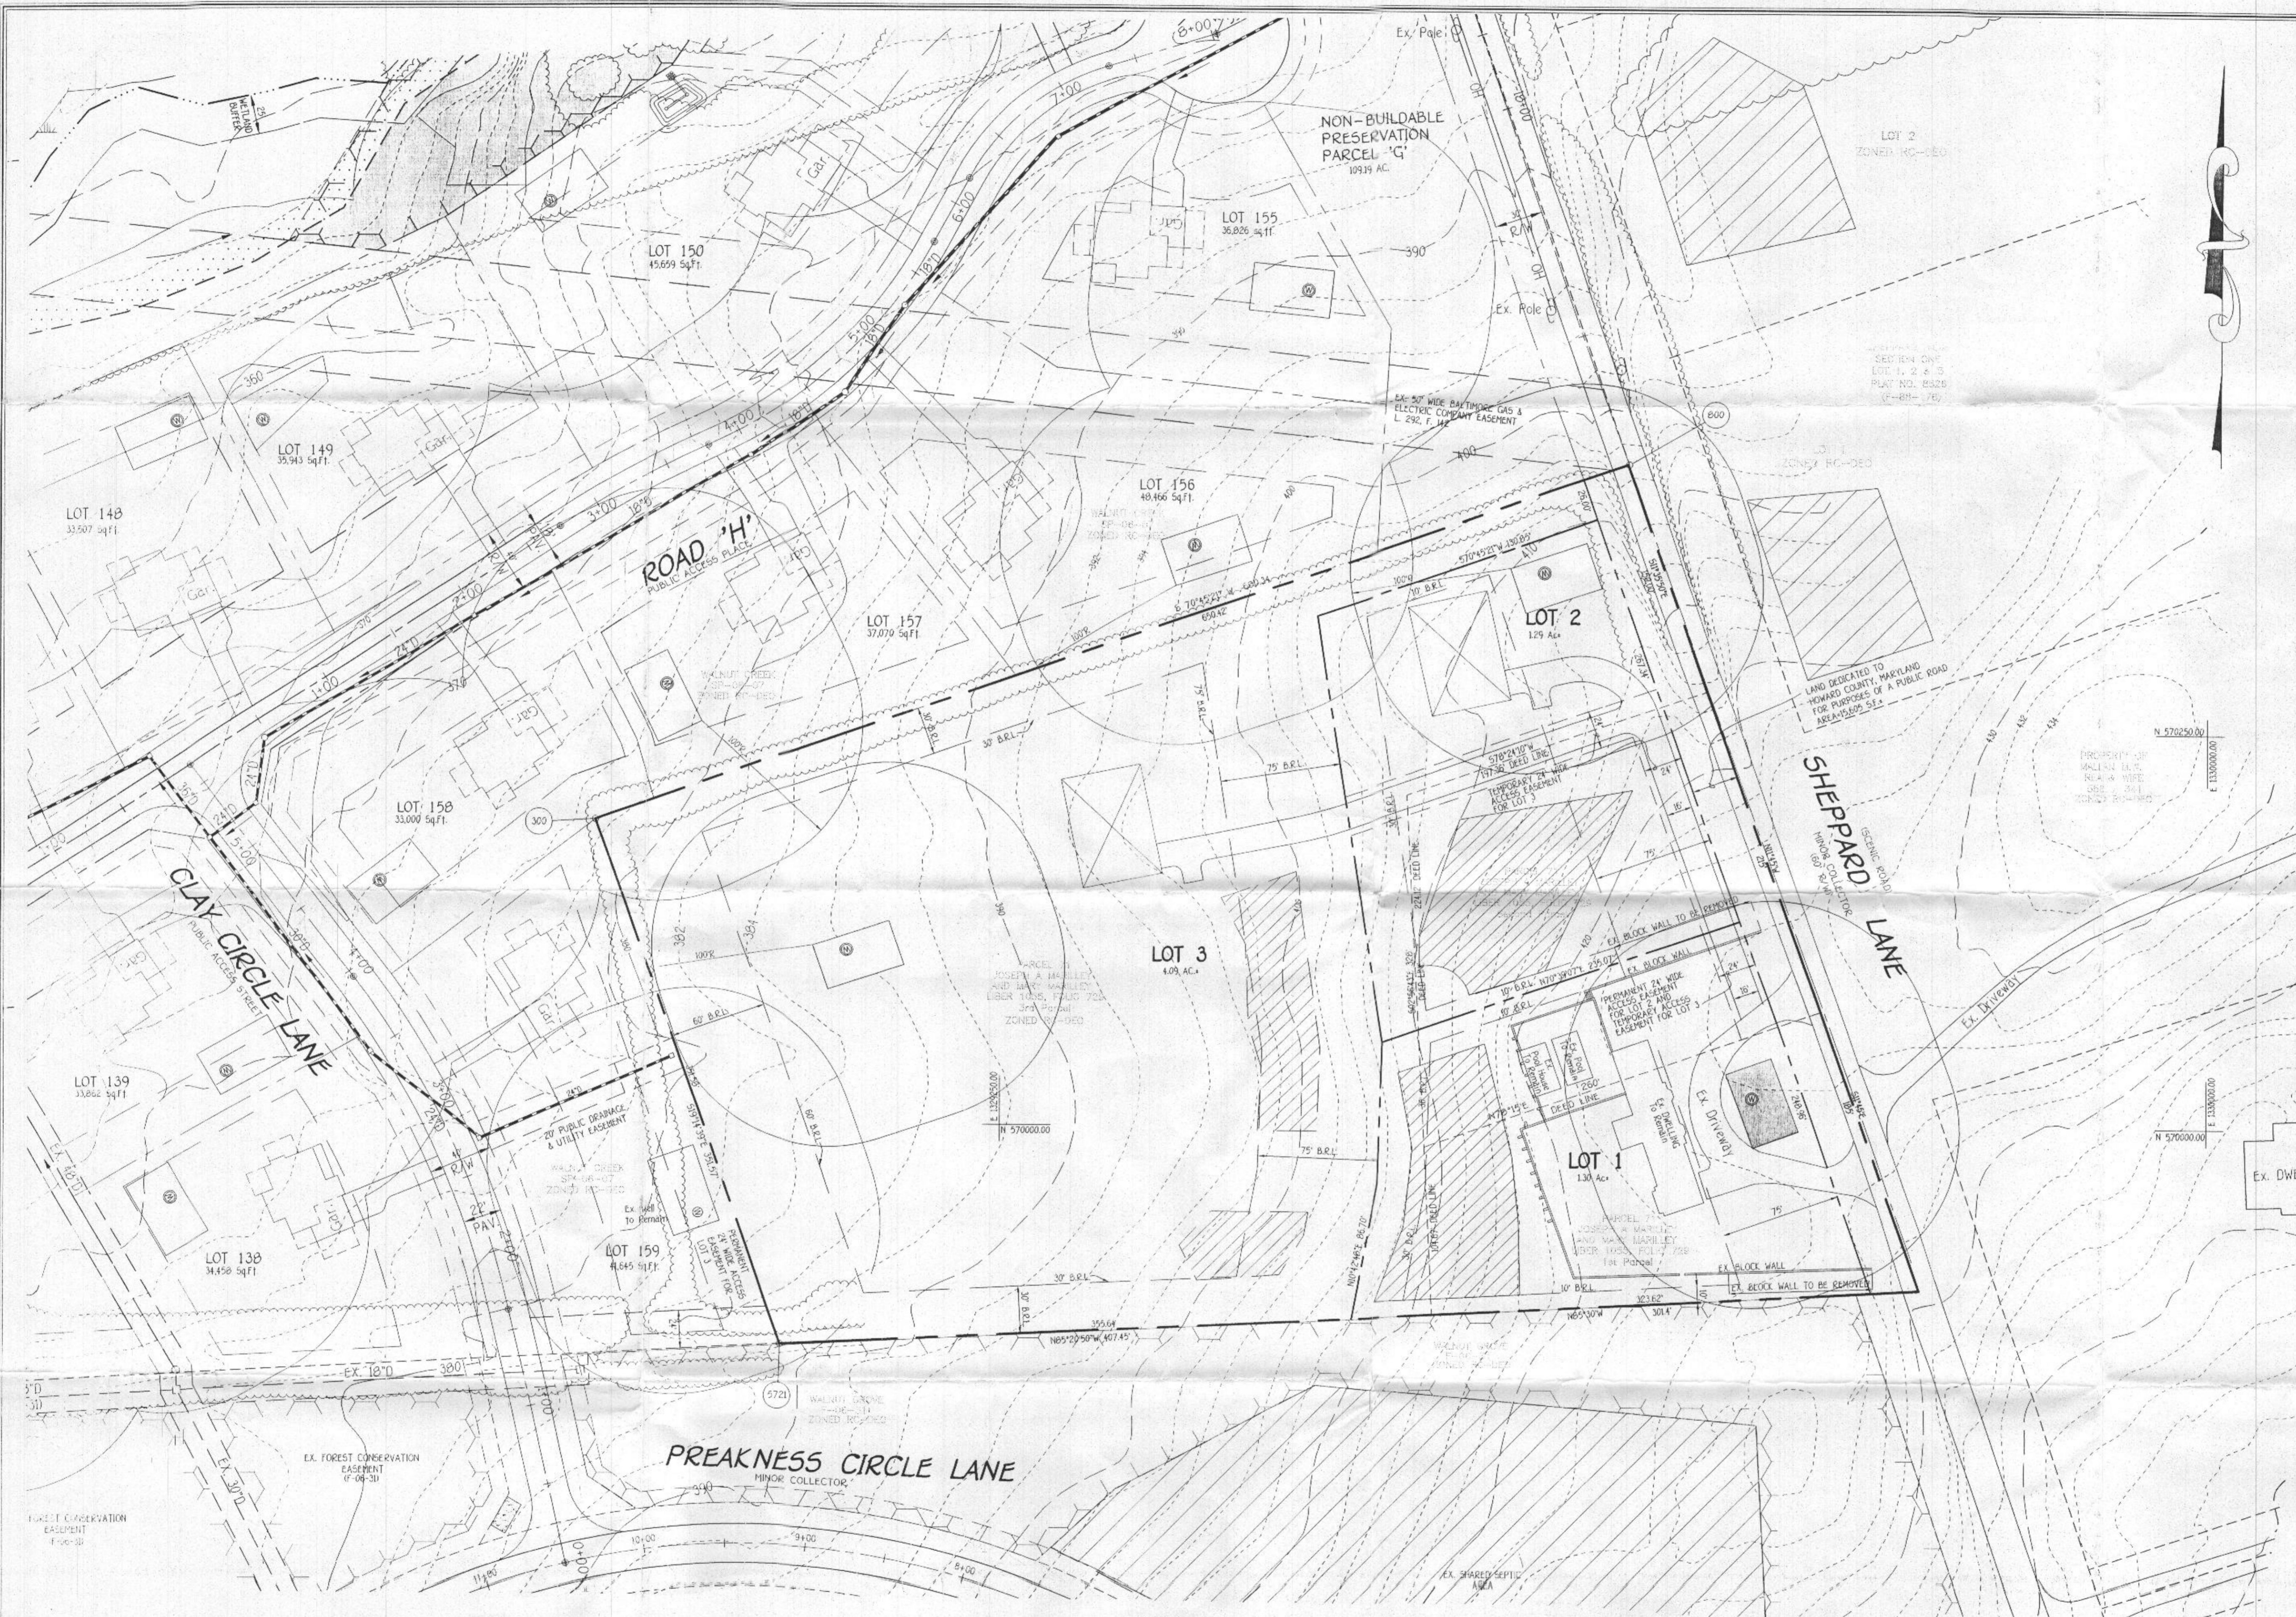

VICINITY MAP
SCALE: 1" = 200'

GENERAL NOTES:

- THE SUBJECT PROPERTY IS ZONED RC-DEO PER THE 02-02-04 COMPREHENSIVE ZONING PLAN AND THE "COMP LITE" ZONING AMENDMENTS EFFECTIVE 07-28-06.
- DRIVEWAYS SHALL BE PROVIDED PRIOR TO ISSUANCE OF A USE AND OCCUPANCY PERMIT FOR ANY NEW DWELLINGS TO INSURE SAFE ACCESS FOR FIRE AND EMERGENCY VEHICLES PER THE FOLLOWING REQUIREMENTS:
 - WIDTH - 12' (15' SERVING MORE THAN ONE RESIDENCE).
 - SURFACE - 6" OF COMPACTED CRUSHER RUN BASE W/TAR AND CHIP COATING (1-1/2" MIN.).
 - GEOMETRY - MAX. 14% GRADE, MAX. 10% GRADE CHANGE AND MIN. 45' TURNING RADIUS.
 - STRUCTURES (CULVERTS/BRIDGES) - CAPABLE OF SUPPORTING 25 GROSS TONS (25 TONS LOADING).
 - DRAINAGE ELEMENTS - CAPABLE OF SAFELY PASSING 100-YEAR FLOOD WITH NO MORE THAN 1 FOOT DEPTH OVER DRIVEWAY SURFACE.
 - MAINTENANCE - SUFFICIENT TO INSURE ALL WEATHER USE.
- NO GRADING, REMOVAL OF VEGETATIVE COVER OR TREES, PAVING AND NEW STRUCTURES SHALL BE PERMITTED WITHIN THE LIMITS OF WETLANDS, STREAMS, OR THEIR REQUIRED BUFFERS, FLOODPLAIN AND FOREST CONSERVATION EASEMENT AREAS.
- FOR FLAG OR PIPESTEM LOTS, REFUSE COLLECTION, SNOW REMOVAL AND ROAD MAINTENANCE ARE PROVIDED TO THE JUNCTION OF THE FLAG OR PIPESTEM AND ROAD RIGHT-OF-WAY LINE AND NOT ONTO THE PIPESTEM LOT DRIVEWAY.
- THERE IS AN EXISTING DWELLING AND STRUCTURES LOCATED ON LOT 1 TO REMAIN. NO NEW BUILDINGS, EXTENSIONS OR ADDITIONS TO THE EXISTING DWELLING ARE TO BE CONSTRUCTED AT A DISTANCE LESS THAN THE ZONING REGULATION REQUIREMENTS.
- LANDSCAPING FOR LOTS 1 THRU 3 IS NOT REQUIRED IN ACCORDANCE WITH SECTION 16.124 OF THE HOWARD COUNTY CODE AND THE LANDSCAPE MANUAL BECAUSE NO NEW LOTS HAVE BEEN CREATED.
- THIS SUBDIVISION IS EXEMPT FROM THE REQUIREMENTS OF SECTION 16.1209 OF THE HOWARD COUNTY CODE FOR FOREST CONSERVATION BECAUSE NO ADDITIONAL LOTS HAVE BEEN CREATED (SECTION 16.1202(b)(ix)(v)).

MINIMUM LOT SIZE CHART			
LOT NO.	GROSS AREA	PIPESTEM AREA	MINIMUM LOT SIZE
3	4.09 AC.	0.11 AC.	3.98 AC.

PLAN
SCALE: 1" = 50'

PLAN TO ACCOMPANY APPLICATION
FOR WAIVER PETITION
MARILLEY PROPERTY
LOTS 1 THRU 3
ZONED RC-DEO
TAX MAP No. 28 GRID No. 1B PARCEL No. 71
FIFTH ELECTION DISTRICT
HOWARD COUNTY, MARYLAND
DATE: JULY 13, 2009
SHEET 1 OF 1

11/20/09/08/075/04/08/075-PLAN TO ACCOMPANY WAIVER PETITION.dwg, 11/13/2009 10:27:24 AM, 13