14'x14' PAVILION WITH 4 10" SUPPORT COLUMNS

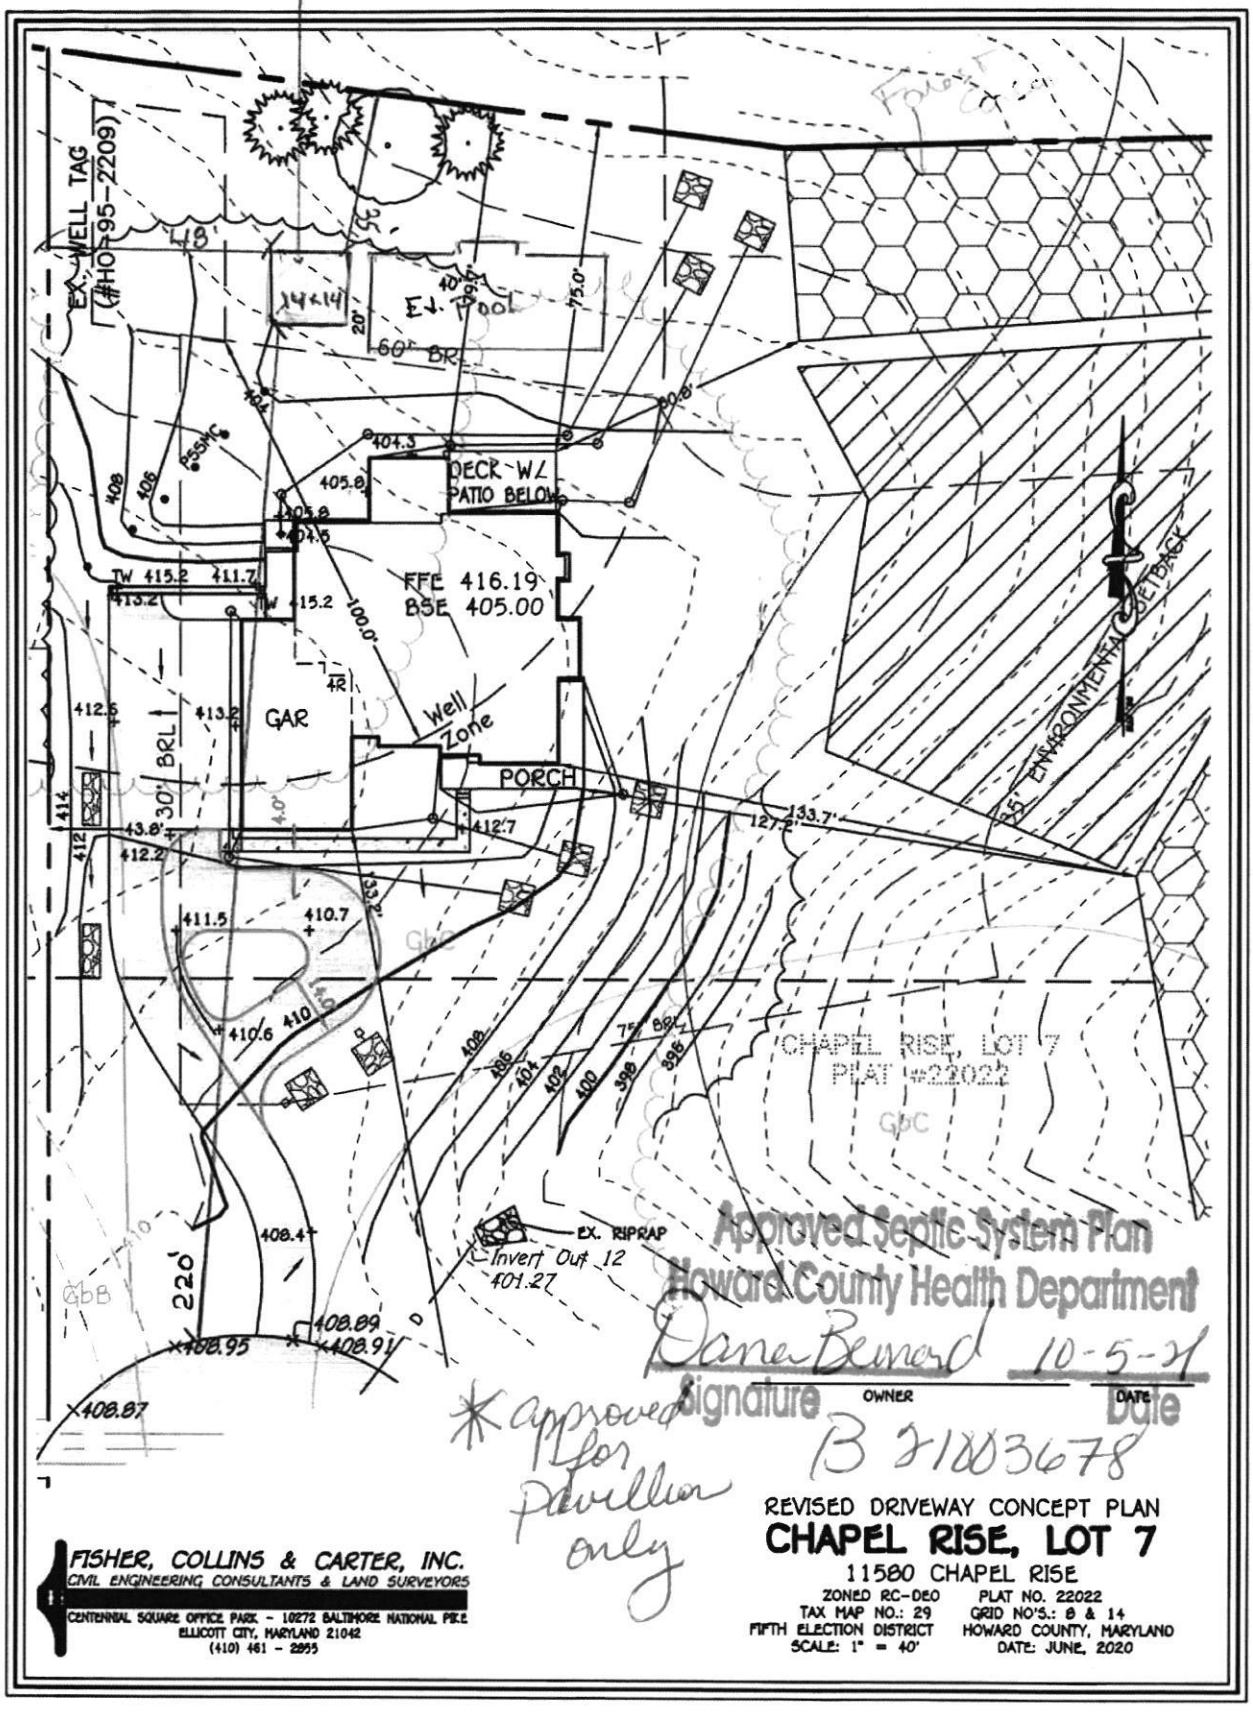

On-line Permit.

I:\2012\12060\Engineering\Dwgs\12060-6009 Chapel Rise Lot 7\12060 Lot 7 Base 090718.dwg, 6/3/2020 10:16:03 AM, DWG To PDF.pc3