(A) P# 545079

HOWARD COUNTY PERC TEST REPORT

Lot # 1

Hole # 7

0"	bm l
	bm scl 2msbk
4'	bm/yellow sl saprolite
8'	bm fsl saprolite ↓
1.5'	bm fsl 20% rx

Hole # 10

8"	bm l sbk
3'	yorn scl 1msbk
	red brn sl
5'	yellow brn fsl saprolite
8'	yellow vfsl ↓
12.5'	beige ls w/saprolite

Hole # 9

1'	bm l
	brn scl 1csbk
1.5'	brn ch sl
1'	yellow bm fsl saprolite
1'	brn vfsl ↓
3'	bm sst ls

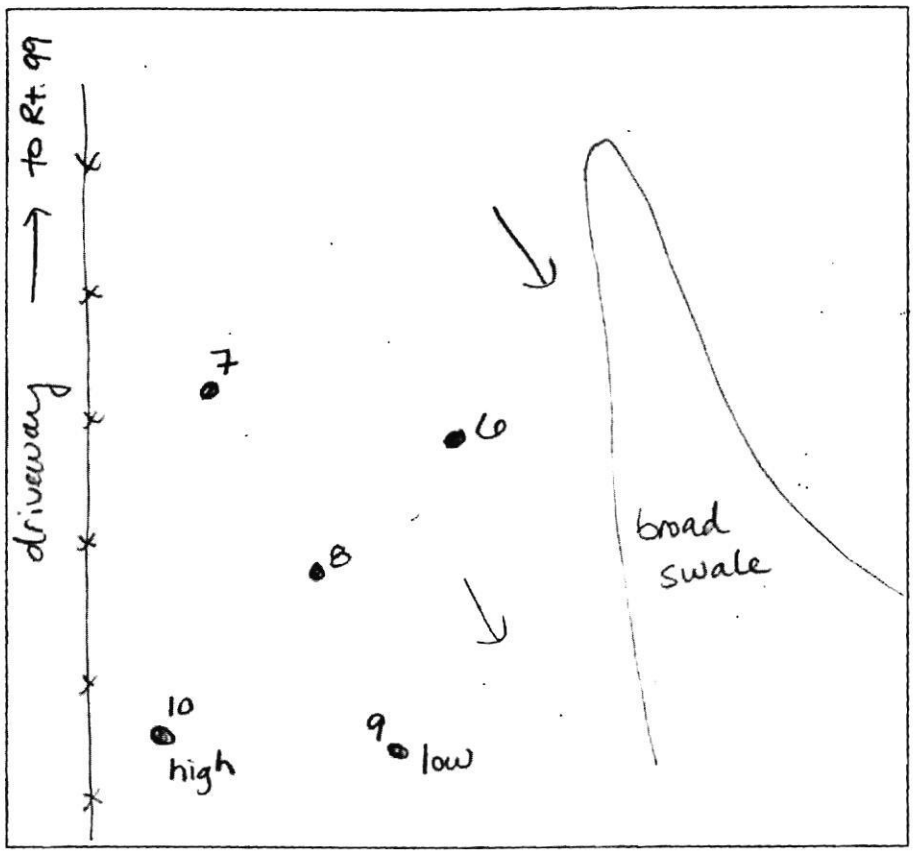

Hole # 6

bm l	6"
org brn grscl	4.5'
red brn scl 1msbk	6.5'
bm sl ↓	
bm fsl saprolite 15% rx	
beige ch v fsl	13'

Hole # 8

red brn scl 1msbk	4.5'
bm sl	6'
brn sl saprolite	8'
brn ch fsl few flags ↓	
beige ch ls	12.5'

Hole #

DATE	TEST #	DEPTH	START	BREAK 1" DROP	STOP 2" DROP	TIME OF 2ND INCH	P/F/H
12-3-13	7	4'12" / 11.5'	10:26	10:29	10:37	6	P
	10	4' / 12.5'	10:40	10:42	10:44	2	P
	9	4.5' / 12.5'	10:48	10:50	10:54	4	P
	6	5.5' / 13'	11:05	11:11	11:20	9	P
	8	12.5'	VISUAL				P

REMARKS holes dug per stakes

SANITARIAN HS — BACKHOE Jeff Allen

OTHERS owner/RTF — SQ. FT/BR

TEST HOLES USED IN SDA 5 — AVG PERC TIME 5

TRENCH WIDTH 3' — INLET DEPTH 4'

MAX BOT DEPTH 6'-7' — EFFECTIVE SDW 2'-3'

nickc.rtf@gmail.com