Menu Refine Search GIS Help My Filters --Select-- Modul

Showing 1 of 1

Permit #	Status	Record Type Alias	Street #	Street Name	Type	Unit Type	Unit #	City
B22002825	Review In Process	Residential Pool or Spa Permit	14846	OLD FREDERICK	RD			WOODB

Page 1 of 1

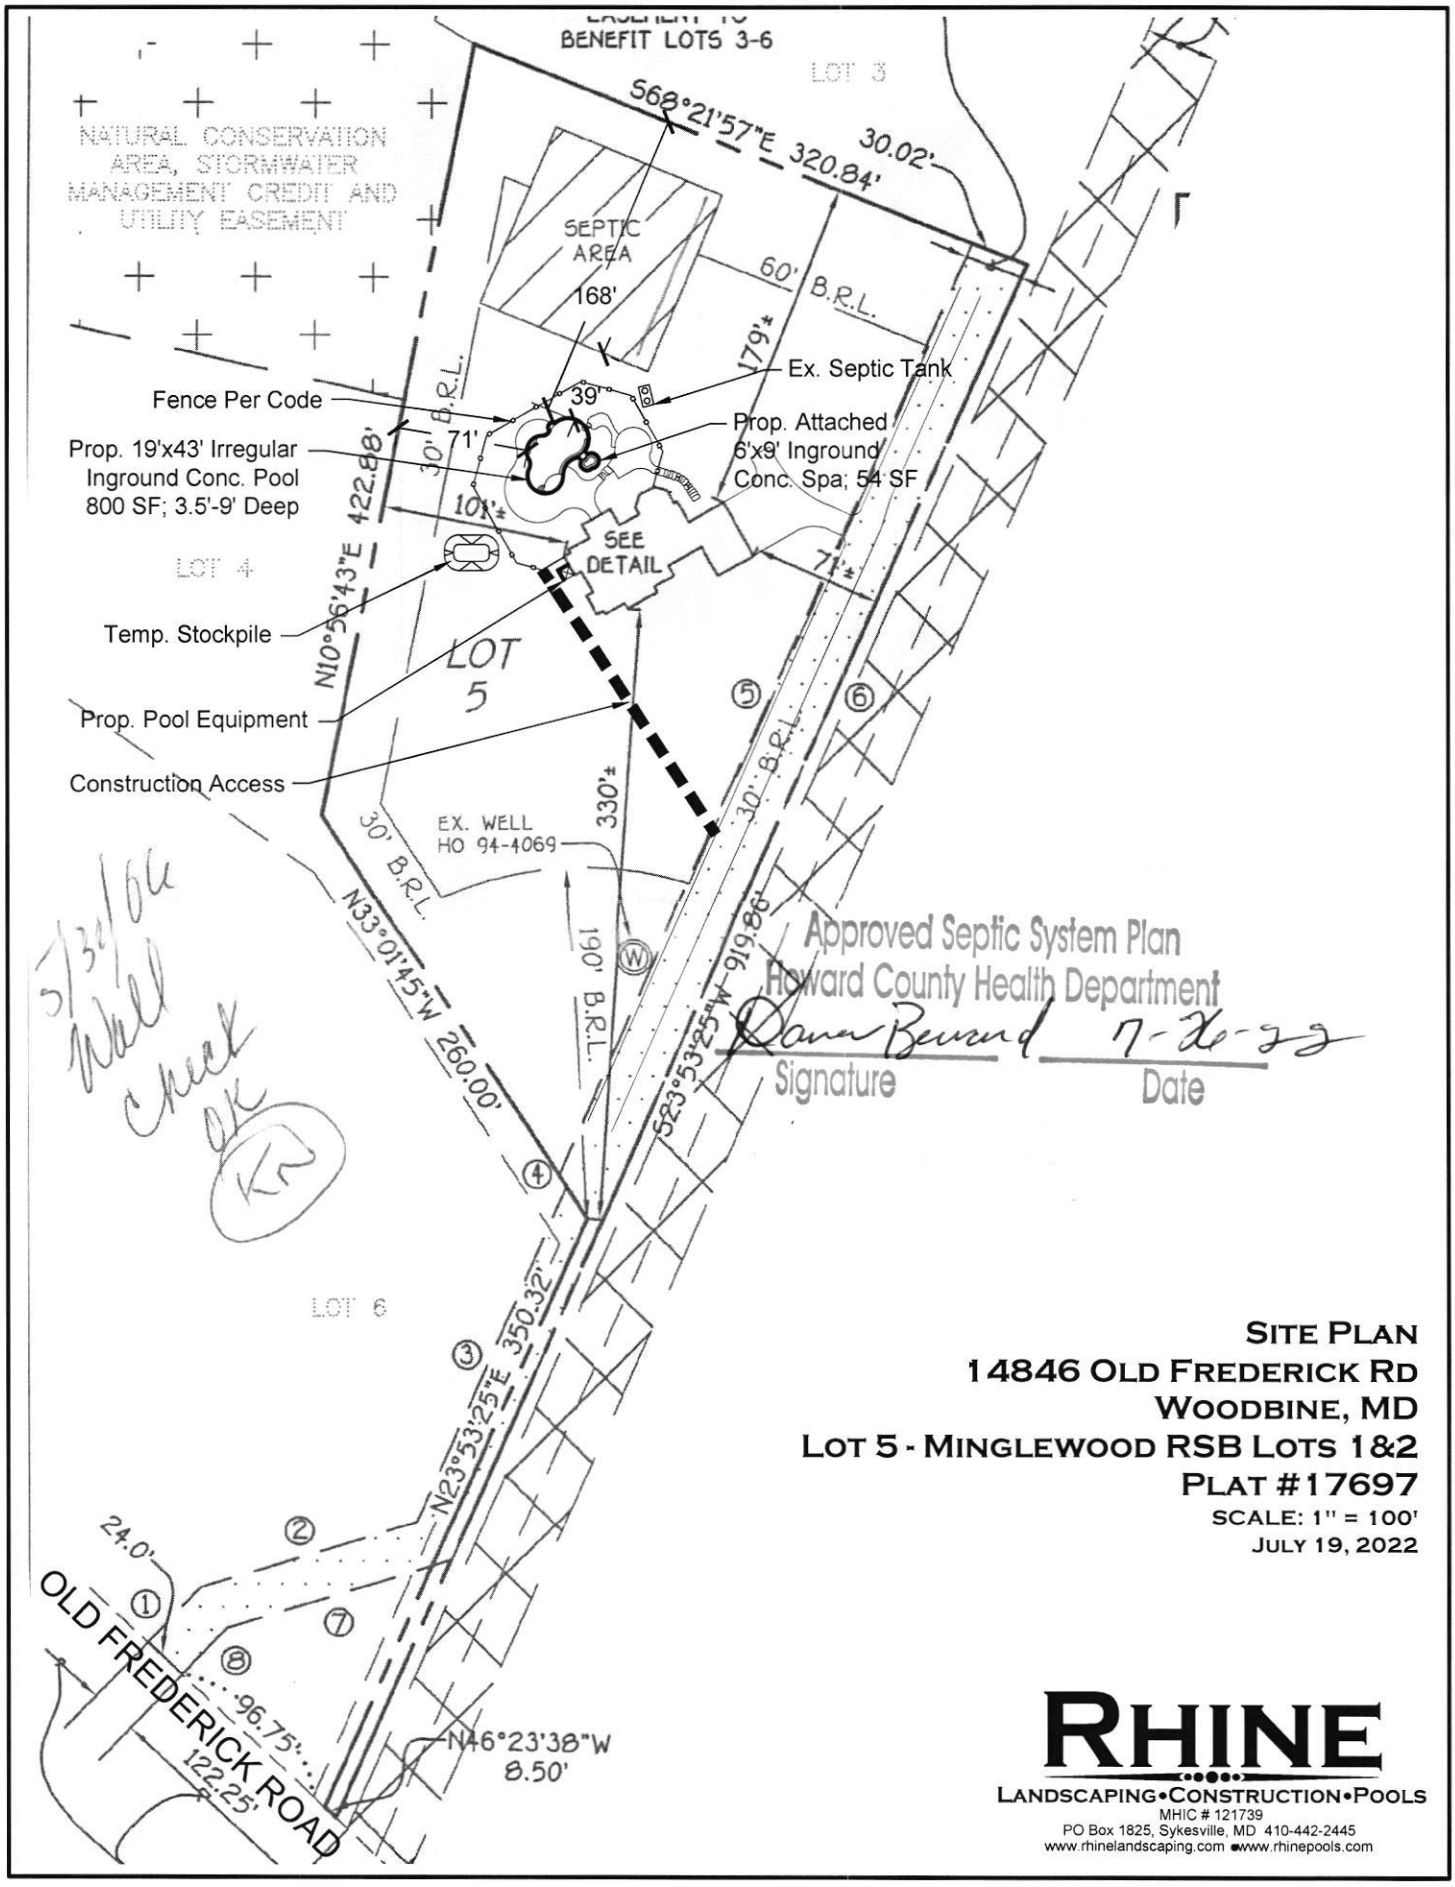

SITE PLAN
14846 OLD FREDERICK RD
WOODBINE, MD
LOT 5 - MINGLEWOOD RSB LOTS 1&2
PLAT #17697
SCALE: 1" = 100'
JULY 19, 2022

RHINE
LANDSCAPING•CONSTRUCTION•POOLS
MHIC # 121739
PO Box 1825, Sykesville, MD 410-442-2445
www.rhinelandscaping.com •www.rhinepools.com