



1325 Hoods Mill Rd (Ref 97)

Effective date: December 4, 1986

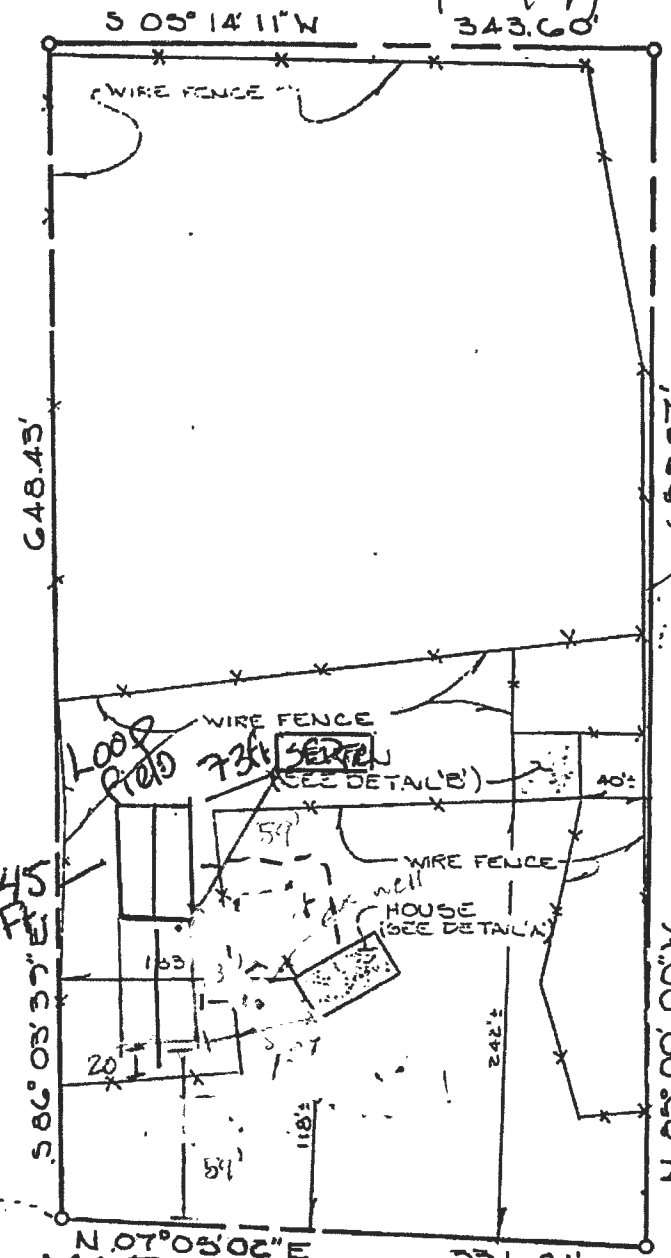


Approved Horizontal
Geothermal Field
Site Plan
8/27/2024

MARYLAND ROUTE 97

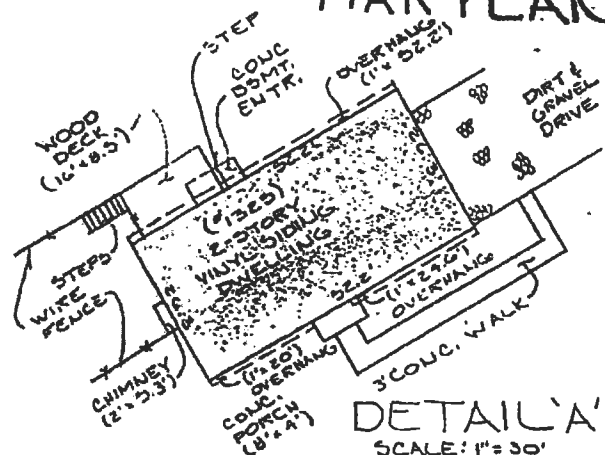

DETAIL 'A'
SCALE: 1" = 30'

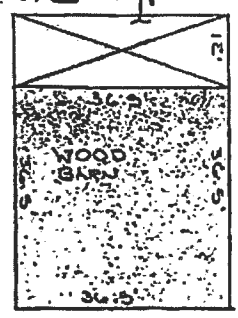

DETAIL 'B'
SCALE: 1" = 30'

This is to certify that I have surveyed the property known as: 1325 HOODS MILL ROAD RECORDED AS DEED LIBER # 1161 FOLIO # 722 AMONG THE LAND RECORDS OF HOWARD CO. for the purpose of locating the improvements thereon, and the improvements are located as shown, MARYLAND

Signed this 1 day of SEPTEMBER, 1994

FISHER COLLINS & CARTER, INC.



[Signature]

Page, Shepsura

From: caitlin@groundloop.com
Sent: Tuesday, August 27, 2024 10:15 AM
To: Page, Shepsura; 'Justin Coleman'
Cc: Burns, Matthew; Wolf, Kevin
Subject: RE: Permit M24000837 - Homeowner has NO A/C

[Note: This email originated from outside of the organization. Please only click on links or attachments if you know the sender.]

Good Morning Ms. Page,

Thank you for your call this morning explaining things. I talked with Justin and we are okay with the changes on the attached plot from your email.

If anything else is needed please feel free to reach out and let us know.

Thanks and have a great day!

***Best Regards,
Caitlin Bechtel
Customer Coordinator***

Ground Loop Heating & Air, Inc.

Office: 410-836-1706

Direct: 410-937-8718

caitlin@groundloop.com

From: Page, Shepsura <spage@howardcountymd.gov>
Sent: Thursday, August 22, 2024 4:34 PM
To: caitlin@groundloop.com
Cc: Burns, Matthew <mburns@howardcountymd.gov>; Wolf, Kevin <KWolf@howardcountymd.gov>
Subject: RE: Permit M24000837 - Homeowner has NO A/C

Caitlin,

During the site visit, conditions differed from the plan but all measurements meets setbacks. Are you ok with these changes (see attached plan).

Thanks,

Shepsura Page, EH Specialist
Well & Septic Program
Howard County Health Department
8930 Stanford Blvd.
Columbia, MD 21045
410-313-1789 (Office)
410-313-2648 (Fax)
www.hchealth.org
spage@howardcountymd.gov



twitter.com/HoCoHealth



facebook.com/HoCoHealth



instagram.com/hocohealth

CONFIDENTIALITY NOTICE

This message and the accompanying documents are intended only for the use of the individual or entity to which they are addressed and may contain information that is privileged, confidential, or exempt from disclosure under applicable law. If the reader of this email is not the intended recipient, you are hereby notified that you are strictly prohibited from reading, disseminating, distributing, or copying this communication. If you have received this email in error, please notify the sender immediately and destroy the original transmission.

From: Page, Shepsura
Sent: Thursday, August 22, 2024 11:51 AM
To: caitlin@groundloop.com
Subject: RE: Permit M24000837 - Homeowner has NO A/C

Okay, I'll be heading out today for a quick site visit.

Thanks,

Shepsura Page, EH Specialist
Well & Septic Program
Howard County Health Department
8930 Stanford Blvd.
Columbia, MD 21045
410-313-1789 (Office)
410-313-2648 (Fax)
www.hchealth.org
spage@howardcountymd.gov



twitter.com/HoCoHealth



facebook.com/HoCoHealth



instagram.com/hocohealth

CONFIDENTIALITY NOTICE

This message and the accompanying documents are intended only for the use of the individual or entity to which they are addressed and may contain information that is privileged, confidential, or exempt from disclosure under applicable law. If the reader of this email is not the intended recipient, you are hereby notified that you are strictly prohibited from reading, disseminating, distributing, or copying this communication. If you have received this email in error, please notify the sender immediately and destroy the original transmission.

From: caitlin@groundloop.com <caitlin@groundloop.com>
Sent: Thursday, August 22, 2024 11:46 AM
To: Page, Shepsura <spage@howardcountymd.gov>
Subject: RE: Permit M24000837 - Homeowner has NO A/C

[Note: This email originated from outside of the organization. Please only click on links or attachments if you know the sender.]

Hi Ms. Page,

That's not necessary, I just would like to let them know someone is coming out to look at things.

Thanks and have a great day!

Best Regards,
Caitlin Bechtel
Customer Coordinator
Ground Loop Heating & Air, Inc.
Office: 410-836-1706
Direct: 410-937-8718
caitlin@groundloop.com

From: Page, Shepsura <spage@howardcountymd.gov>
Sent: Thursday, August 22, 2024 11:44 AM
To: caitlin@groundloop.com; Wolf, Kevin <KWolf@howardcountymd.gov>
Cc: Wolf, Kevin <KWolf@howardcountymd.gov>; 'Justin Coleman' <justin@groundloop.com>; Burns, Matthew <mburns@howardcountymd.gov>
Subject: RE: Permit M24000837 - Homeowner has NO A/C

Caitlin, I can head out today. If you need more time to give the homeowner a heads up, I can do tomorrow.

Thanks,

Shepsura Page, EH Specialist
Well & Septic Program
Howard County Health Department
8930 Stanford Blvd.
Columbia, MD 21045
410-313-1789 (Office)

410-313-2648 (Fax)
www.hchealth.org
spage@howardcountymd.gov



twitter.com/HoCoHealth



facebook.com/HoCoHealth



instagram.com/hocohealth

CONFIDENTIALITY NOTICE

This message and the accompanying documents are intended only for the use of the individual or entity to which they are addressed and may contain information that is privileged, confidential, or exempt from disclosure under applicable law. If the reader of this email is not the intended recipient, you are hereby notified that you are strictly prohibited from reading, disseminating, distributing, or copying this communication. If you have received this email in error, please notify the sender immediately and destroy the original transmission.

From: caitlin@groundloop.com <caitlin@groundloop.com>
Sent: Thursday, August 22, 2024 11:39 AM
To: Page, Shepsura <spage@howardcountymd.gov>; Wolf, Kevin <KWolf@howardcountymd.gov>
Cc: Wolf, Kevin <KWolf@howardcountymd.gov>; 'Justin Coleman' <justin@groundloop.com>; Burns, Matthew <mburns@howardcountymd.gov>
Subject: RE: Permit M24000837 - Homeowner has NO A/C

[Note: This email originated from outside of the organization. Please only click on links or attachments if you know the sender.]

Good Morning Ms. Page,

Please see attached plat with all markings. Please let me know when you are planning to head out for a site visit so I can give the homeowner a heads up. If you have any questions please feel free to reach out.

Thanks and have a great day!

Best Regards,
Caitlin Bechtel
Customer Coordinator
Ground Loop Heating & Air, Inc.
Office: 410-836-1706
Direct: 410-937-8718
caitlin@groundloop.com

From: Page, Shepsura <spage@howardcountymd.gov>
Sent: Wednesday, August 21, 2024 11:18 AM
To: caitlin@groundloop.com; Wolf, Kevin <KWolf@howardcountymd.gov>
Cc: Wolf, Kevin <KWolf@howardcountymd.gov>; 'Justin Coleman' <justin@groundloop.com>; Burns, Matthew <mburns@howardcountymd.gov>
Subject: RE: Permit M24000837 - Homeowner has NO A/C

Good Morning Caitlin,
Pardon the delay in response. I understand the homeowner is eagerly awaiting. I will do my best to expedite the process and ensure full compliance with County's regulations.

Upon closer inspection, the provided plat is missing distances to the properties well and septic features. Can you provide a new plan with measurements from the field to the closest well and septic features? If all setbacks are met, I'll visit the site to confirm that the stakeout aligns with your plan.

Thanks,

Shepsura Page, EH Specialist
Well & Septic Program
Howard County Health Department
8930 Stanford Blvd.
Columbia, MD 21045
410-313-1789 (Office)
410-313-2648 (Fax)
www.hchealth.org
spage@howardcountymd.gov



twitter.com/HoCoHealth



facebook.com/HoCoHealth



instagram.com/hocohealth

CONFIDENTIALITY NOTICE

This message and the accompanying documents are intended only for the use of the individual or entity to which they are addressed and may contain information that is privileged, confidential, or exempt from disclosure under applicable law. If the reader of this email is not the intended recipient, you are hereby notified that you are strictly prohibited from reading, disseminating, distributing, or copying this communication. If you have received this email in error, please notify the sender immediately and destroy the original transmission.

From: caitlin@groundloop.com <caitlin@groundloop.com>
Sent: Monday, August 19, 2024 12:40 PM

To: Page, Shepsura <spage@howardcountymd.gov>

Cc: Wolf, Kevin <KWolf@howardcountymd.gov>; 'Justin Coleman' <justin@groundloop.com>

Subject: RE: Permit M24000837 - Homeowner has NO A/C

[Note: This email originated from outside of the organization. Please only click on links or attachments if you know the sender.]

Good Afternoon Mrs. Page,

Can you please provide an update on the permit status of this project? The homeowner is eagerly awaiting when we can get started. Any information you can provide is appreciated. Thanks!

Best Regards,

Caitlin Bechtel

Customer Coordinator

Ground Loop Heating & Air, Inc.

Office: 410-836-1706

Direct: 410-937-8718

caitlin@groundloop.com

From: Justin Coleman <justin@groundloop.com>

Sent: Monday, August 5, 2024 9:17 AM

To: caitlin@groundloop.com

Cc: Page, Shepsura <spage@howardcountymd.gov>; Wolf, Kevin <KWolf@howardcountymd.gov>

Subject: Re: Permit M24000837 - Homeowner has NO A/C

Here is the plat and everything is staked out!

SCALE.

Justin Coleman
Sales Consultant
Ground Loop Heating and Air
1701 Whiteford Road
Darlington, MD 21034
Justin@groundloop.com
410-777-0034

On Aug 5, 2024, at 9:14 AM, caitlin@groundloop.com wrote:

Hi Ms. Page,

The homeowner does not currently have geothermal heating/cooling. I understand that this is not a direct replacement of an existing system, however anyone without A/C in this current heat we consider a high priority.

I have looped in Justin Coleman who is working with Mr. Trovillion to provide answers to your other requests. Thanks and have a great day!

Best Regards,
Caitlin Bechtel
Customer Coordinator
Ground Loop Heating & Air, Inc.
Office: 410-836-1706
Direct: 410-937-8718
caitlin@groundloop.com

From: Page, Shepsura <spage@howardcountymd.gov>
Sent: Monday, August 5, 2024 8:52 AM
To: caitlin@groundloop.com; Wolf, Kevin <KWolf@howardcountymd.gov>
Subject: RE: Permit M24000837 - Homeowner has NO A/C

Good Morning Caitlin,
A few questions prior to expediting your permit.
Is the homeowner currently on geothermal heating/cooling? If they are, this would be considered an emergency.
Are the proposed loops staked yet?
Could you send a scanned copy of the plat via email, the one you submitted is slightly difficult to read.

Thanks,

Shepsura Page, EH Specialist
Well & Septic Program
Howard County Health Department
8930 Stanford Blvd.
Columbia, MD 21045

410-313-1789 (Office)
410-313-2648 (Fax)
www.hchealth.org
spage@howardcountymd.gov

<image001.png>

<image002.png>
twitter.com/HoCoHealth

<image003.png>
facebook.com/HoCoHealth

<image004.png>
instagram.com/hocohealth

CONFIDENTIALITY NOTICE

This message and the accompanying documents are intended only for the use of the individual or entity to which they are addressed and may contain information that is privileged, confidential, or exempt from disclosure under applicable law. If the reader of this email is not the intended recipient, you are hereby notified that you are strictly prohibited from reading, disseminating, distributing, or copying this communication. If you have received this email in error, please notify the sender immediately and destroy the original transmission.

From: caitlin@groundloop.com <caitlin@groundloop.com>
Sent: Friday, August 2, 2024 9:05 AM
To: Page, Shepsura <spage@howardcountymd.gov>; Wolf, Kevin <KWolf@howardcountymd.gov>
Subject: Permit M24000837 - Homeowner has NO A/C
Importance: High




[Note: This email originated from outside of the organization. Please only click on links or attachments if you know the sender.]

Good Morning,

I've just submitted the permit #M24000837 through Howard County. Attached is the plat for the proposed loop field. This is a horizontal loop field. Any assistance you can provide in streamlining this application would be greatly appreciated. The current homeowner does not have any A/C. Please let me know if you have any questions. Thanks and have a great day!

Best Regards,
Caitlin Bechtel
Customer Coordinator
Ground Loop Heating & Air, Inc.
Office: 410-836-1706
Direct: 410-937-8718
caitlin@groundloop.com

8/22/2024 -
New Plan w/
distances to
well & Septic
Features (SP)

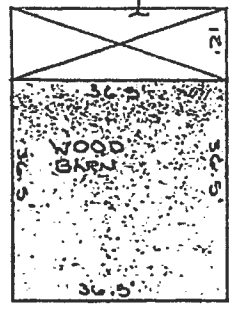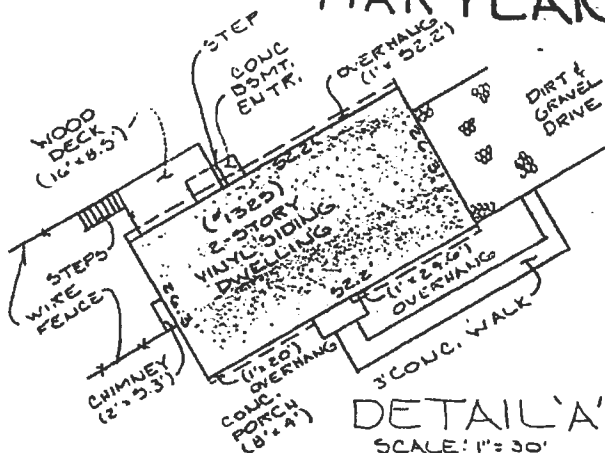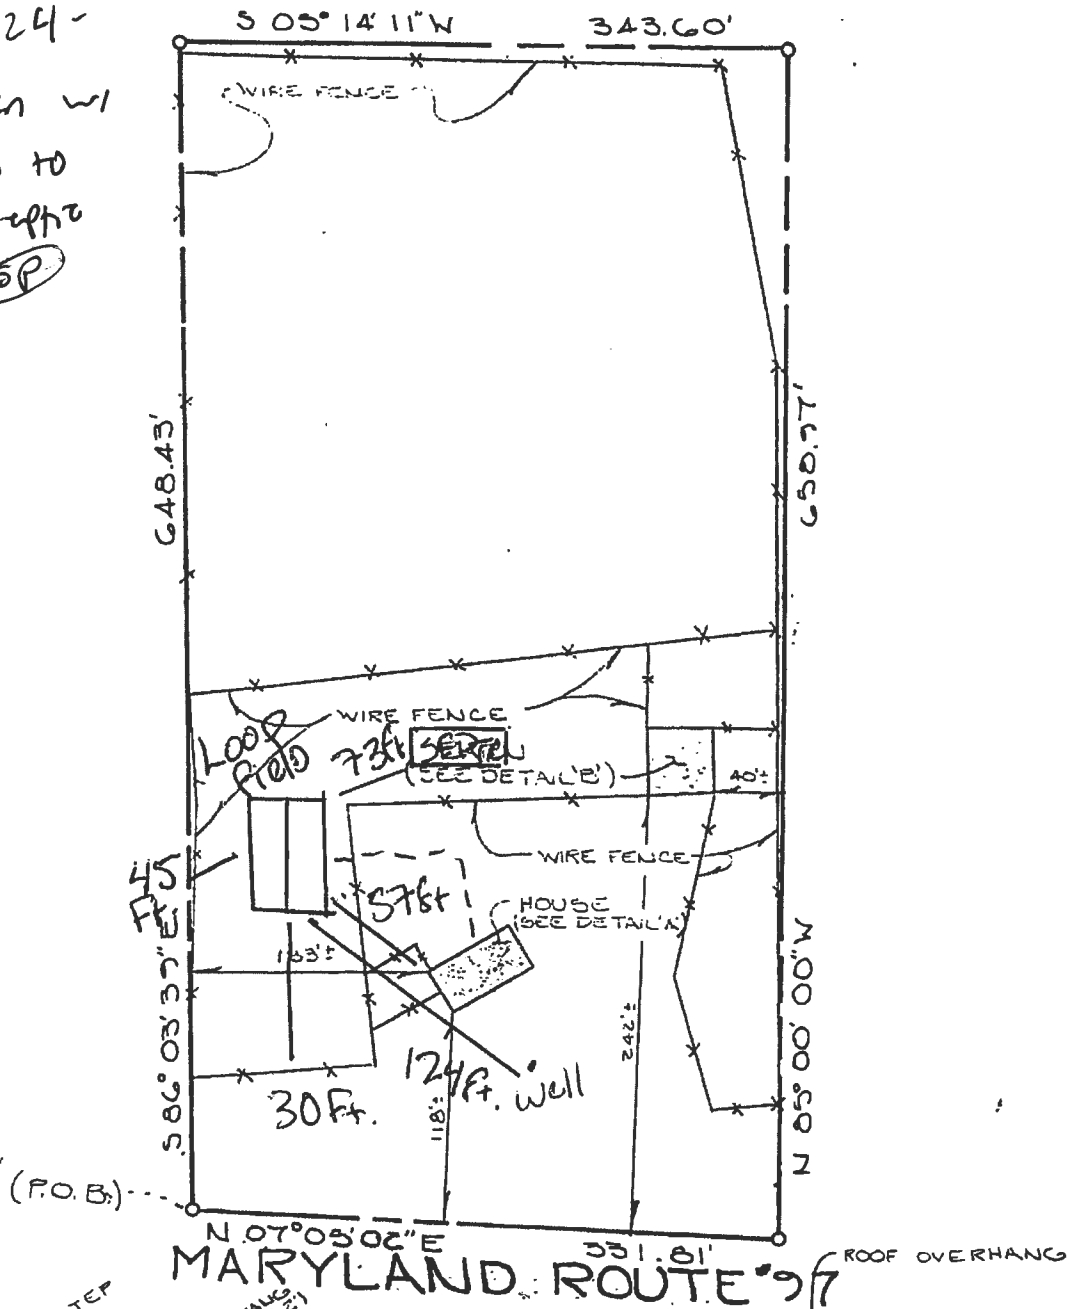

DETAIL 'A'
SCALE: 1" = 30'


DETAIL 'B'
SCALE: 1" = 30'

This is to certify that I have surveyed the property known as: 1325 HOODS MILL ROAD RECORDED AS DEED LIBER# 1161 FOLIO# 722 AMONG THE LAND RECORDS OF HOWARD CO.

for the purpose of locating the improvements thereon, and the improvements are located as shown. MARYLAND

Signed this 1 day of SEPTEMBER, 19 94

[Handwritten Signature]

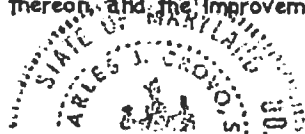


1325 RT 97


SCALE: 1" = 30'

Effective date: December 4, 1986

Initial
Site Plan
Rec. 8/2/84

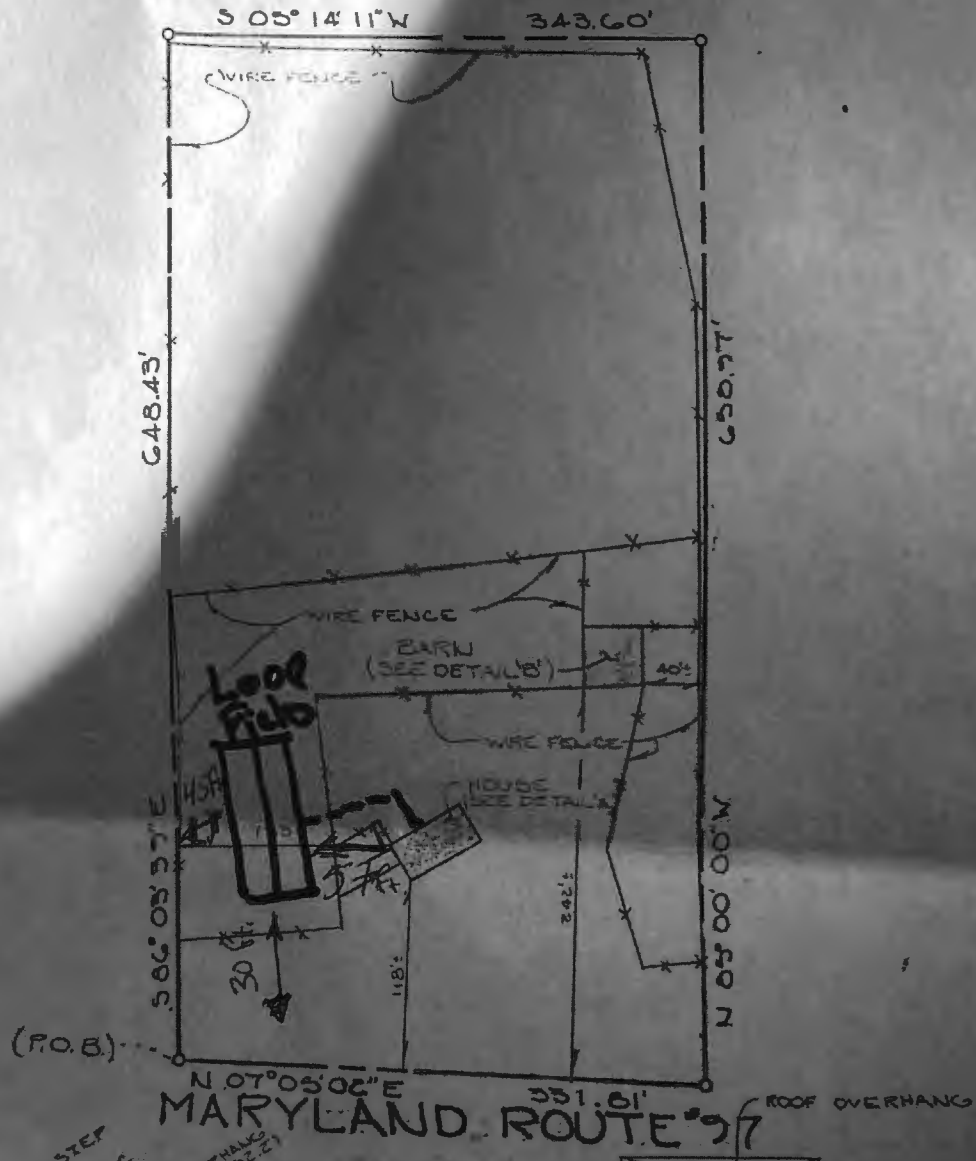

DETAIL 'A'
SCALE: 1" = 30'

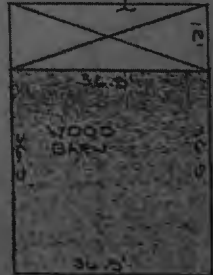

DETAIL 'B'
SCALE: 1" = 30'






[Signature]

