Menu Save Reset Cancel Help

Record Detail * *(This section is required.)*

Permit Type	Permit Number	Opened Date
Building/Residential/Misc/Deck	B23003624	09/05/2023

Description of Work

SFD/ CONSTRUCT AN IRREGULAR SHAPED 46'8" X 15' OPEN DECK WITH STEPS TO GRADE

check spelling

Address * *(This section is required.)*

Search Reset Clear Get Parcel & Owner

Street #	Street Name	Street Type
14717	MCCANN FARM	RD

Unit Type	Unit #	X Coordinate	Y Coordinate
--Select--		-77.02603	39.333

City	State	Zip Code	Primary
WOODBINE	MD	21797	Yes

Parcel * *(This section is required.)*

Search Reset Clear Get Address & Owner

GIS ID *	Parcel	Parcel Area	Land Value	Improved Value	Exemption Value	Plan Area
905273	78	1	185000	889800	704800	RURAL

Legal Description

IMPSLOT 5 1.007 A[ ]14717 MCCANN FARM RD[ ]MCCANN PROPERTY

check spelling

Block	Lot	Census Tract	Council Dist	Inspection Dist	Supervisor Dist	Map #	DAP Zone
9999	5	604001	5				

Plan Area	State Tax Id	Subdivision Name
	1404366875	

Section	Area	Tax Map
		8

Grid	Zoning District	ADC Map
8-10	RC-DEO	4692-F7

SDP No.	Final Plan No.	WP File No.	Primary
	F-01-105		Yes

Record Plat No.	WS Contract No.	FDP No.
15472		

Owner Occupied	Year Built	Historic District
○ Yes ○ No	2003	○ Yes ◉ No

Historic District Registry No.	Stat Area	Flood Plain
	4-02	○ Yes ◉ No

Building No

Owner *(This section is required.)*

Search Reset Clear

Name
SINHA DHIRENDRA KUMAR

Address Line 1
14717 MCCANN FARM RD

Address Line 2

Address Line 3

Mail City	Mail State	Mail Zip Code
WOODBINE	MD	21797

Phone	Primary
410-969-4444	Yes

E-mail
PERMITS@FENCEDECKCONNECT.COM

Cell Number **Fax Number**

Professionals *(This section is not required.)*

License # *
08050045780
License Type *
MHIC Co
Primary
Yes

Business Name
FENCE & DECK CONNECTION
First Name **Middle Name** **Last Name**
JAMES W RUBUSH
Address Line 1
8057 VETERANS HIGHWAY
Address Line 2
8057 VETERANS HIGHWAY
City **State** **ZIP Code**
MILLERSVILLE MD 21108-0000
Phone 1 **Phone 2** **Fax**
4109694444 4109694448
E-mail
DFISH@FENCEDECKCONNECT.COM

Applicant *(This section is not required.)*

Search **As Owner** **As Lic. Prof** **As Contact**

Type *
Applicant
Relationship
Applicant
Primary
Yes

First Name **MI** **Last Name**
JESSICA OWENBY
Full Name
JOSH SIMPSON
Organization Name
FENCE & DECK CONNECTION
Street Address
8057 VETERANS HIGHWAY
Address Line 2
City **State** **Zip Code**
MILLERSVILLE MD 21108
Phone **Cell** **Fax**
410-969-4444
E-mail *
permits@fencedeckconnect.com

Addtl Info

Est Construction Cost **Housing Units** **Number of Buildings** * **Public Owned**
24333 0 0 No
Construction Type
434 - Additions, Alterations and Conversions - Residential

MISC PERMIT INFO

MISCELLANEOUS PERMIT INFORMATION

Capital Project-No Fee **Capital Project Number** **Fee Exempt** **Roadside Tree Project Permit** **Roadside Tree Project Permit #**
○ Yes ◉ No ○ Yes ◉ No ○ Yes ◉ No

Existing Use * **Water** **Sewage** **Expiration Date**
SFD Private Private 3/4/2024

Submit **Cancel**

2
RAWING
OUNTY

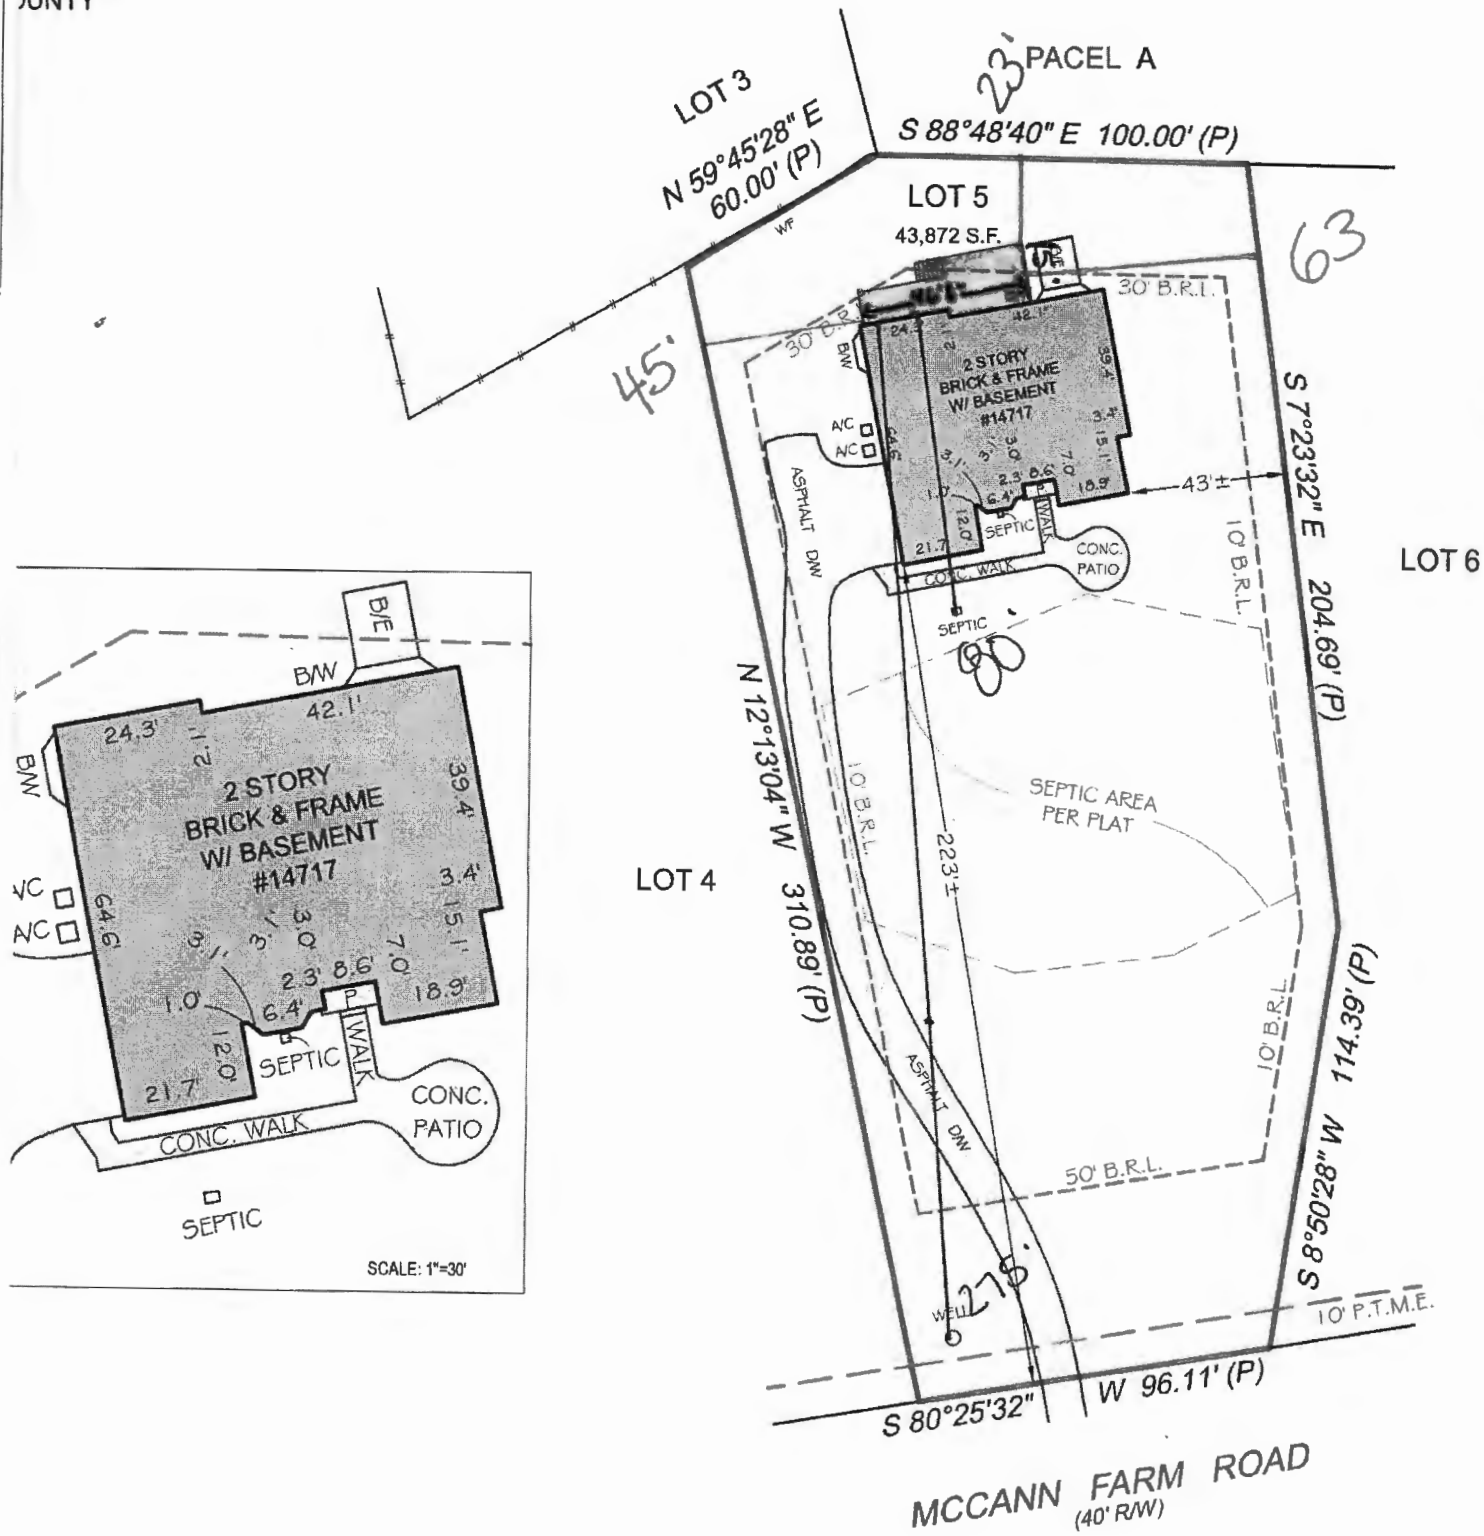

LEGAL DESCRIPTION
ALID WITHOUT ALL PAGES

202-848
8275
ICOP Akin
Ajuwon

AAJUWON
@gmail.com