Menu **Refine Search** **GIS** **Help** My Filters --Select-- Module Building

Showing 1 of 1

Permit #	Status	Record Type Alias	Street #	Street Name	Type	Unit Type	Unit #	City	Description	Opened
B23002378	Review In Process	Residential Pool or Spa Permit	12205	MAYAPPLE	DR			MARRIOTTSVILLE	SFD/ CONSTRUCT 17' X 34' RECTANGUL...	06/26/2023

Page 1 of 1

Approved Septic System Plan
Howard County Health Department

PBenard
Signature

7-26-23
Date

Lot 23 Feasibility 2020-07-29.pdf

NO GRADING IN SEWAGE DISPOSAL AREA. LOD SHOWN IS FOR THE INSTALLATION OF THE INITIAL SEPTIC SYSTEM ONLY

A PUMP WILL BE REQUIRED TO SEWER THE BASEMENT

STORMWATER MANAGEMENT ON LOT 23 WILL BE PROVIDED THROUGH THE USE OF NON-ROOFTOP DISCONNECT & SHEET FLOW TO CONSERVATION

DRAWING LEGEND

- LIMIT OF DISTURBANCE
- PROPOSED SILT FENCE
- PROPOSED SUPER SILT FENCE
- STABILIZED CONSTRUCTION ENTRANCE
- NEW AREA RELOCATION
- TRANSFORMER
- SEPTIC RESERVE AREA
- DRY WELL
- TEMPORARY STOCKPILE

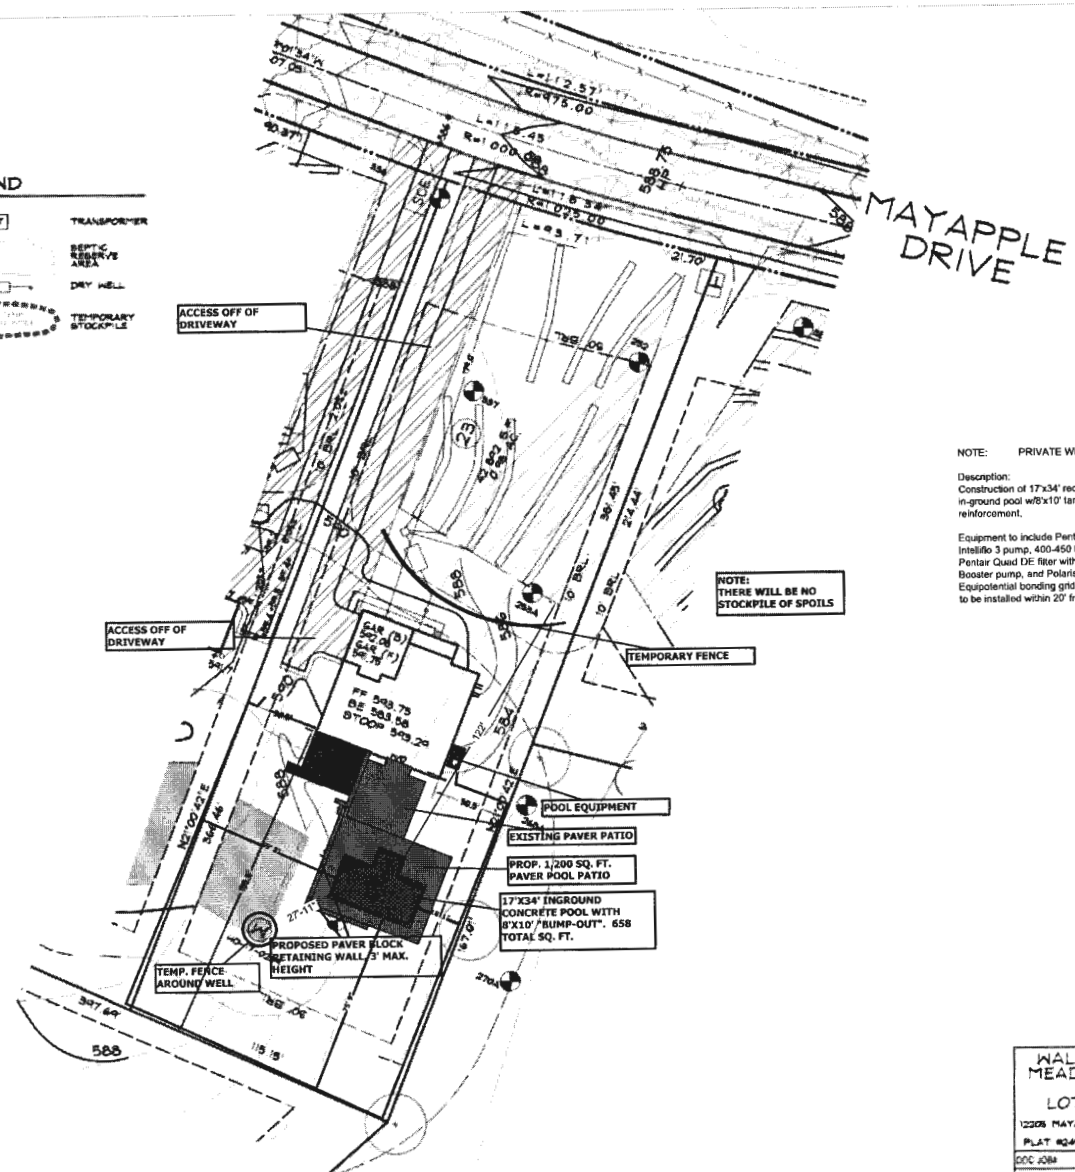

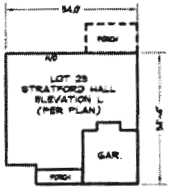

NOTE: PRIVATE WELL & SEPTIC

Description:
Construction of 17'x34' rectangular concrete in-ground pool w/8'x10' tanning ledge w/steel reinforcement.

Equipment to include Pentair Intelliflow VSF or Intelliflo 3 pump, 400-450 K Pentair gas heater, Pentair Quad DE filter with multi-port, Polaris PB-460 Booster pump, and Polaris Quattro Sport deaner. Equipotential bonding grid. GFCI outlet/receptacle to be installed within 20' from pool, per code.

LOT 23
FEASIBILITY STUDY

WALKER MEADOWS	
LOT 23	
12205 MAYAPPLE DR	
PLAT #24974-24979	
DDC JOB#	13064.3
DATE	07-29-2020
SCALE	1" = 30'
CHK. BY	WRD
DRN. BY	LKO/AJK

DDC
Development Design Consultants