

MARYLAND DEPARTMENT OF THE ENVIRONMENT, WATER MANAGEMENT ADMINISTRATION
1800 Washington Blvd., Baltimore, Maryland 21230 (410) 537-3784

WATER WELL ABANDONMENT-SEALING REPORT FORM

SUBMIT COPIES OF COMPLETED FORM TO:

- * COUNTY ENVIRONMENTAL AGENCY (contact MDE, WMA if address needed)
- * WELL OWNER
- * MDE, WATER MANAGEMENT ADMINISTRATION, WELL PROGRAM

Complete 8/2/2024
(MB)


DATE WELL ABANDONED: 3/13/24 (month/day/year)

* PERMIT NUMBER OF ABANDONED WELL (if any) _____
* PERMIT NUMBER OF REPLACEMENT WELL: _____

* PERSON ABANDONING WELL: Robert Copsey WELL DRILLER'S LICENSE NUMBER: 161
* OWNER'S NAME: Rao Govind CIRCLE: MWD MSD MGD

* WELL LOCATION:
COUNTY: Howard County
NEAREST TOWN: Columbia
TAX MAP 0036 BLOCK _____ PARCEL 0226
SUBDIVISION: 3003
SECTION: _____ LOT: 2
STREET ADDRESS: 1040 Northdale Rd.

SITE LOCATION MAP

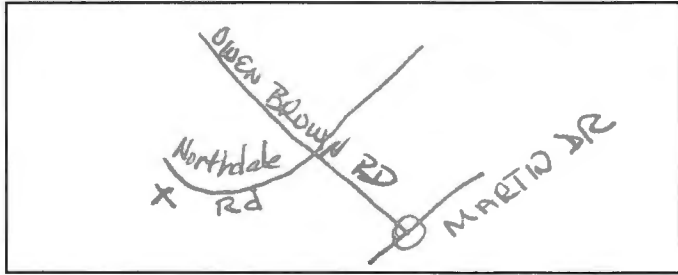

LATITUDE 3 9.115618
LONGITUDE 7 6.522038

LOG OF SEALING MATERIAL

MATERIAL	FEET	
	FROM	TO
<u>Bentonite Clay</u>	<u>32</u>	<u>5</u>
<u>clean fill</u>	<u>5</u>	<u>0</u>

* TYPE OF WELL BEING ABANDONED:
 DRILLED _____ JETTED
 BORED _____ HAND DUG
 OTHER (specify) _____

* USE CODE:
 DOMESTIC _____ MUNICIPAL/PUBLIC
 IRRIGATION _____ INDUSTRIAL
 TEST/OBSERVATION _____ GEOTHERMAL

* TYPE OF CASING:
 STEEL _____ PLASTIC
 CONCRETE _____ OTHER (specify) _____

VOLUME OF MATERIAL USED

385 #13 3/8 Bentonite Pellets.

SIZE OF CASING: 6" INCHES IN DIAMETER

DEPTH OF WELL: 32 FEET DEEP

WAS ANY CASING REMOVED? YES _____ NO
If yes, length removed, in feet: 5

WAS CASING RIPPED OR PERFORATED? _____ YES NO

SIGNATURE-MASTER WELL DRILLER OR SUPERVISING SANITARIAN Robert P. Copsey LICENSE# 161

MWD / MSD / MGS 3/13/24
CIRCLE ONE DATE

Pursuant to § 10-624 of the State Govt. Article of the Maryland Code, personal info requested on this form is used in processing this form pursuant to COMAR 26.04.04. Failure to provide the info may result in this form not being processed. You have the right to inspect, amend, or correct this form. The Maryland Department of the Environment is subject to the Maryland Public Information Act. This form may be made available on the Internet via MDE's website and is subject to inspection or copying, in whole or in part, by the public and other governmental agencies, if not protected by federal or State Law.