
 WATER WELL ABANDONMENT-SEALING REPORT FORM

SUBMIT COPIES OF COMPLETED FORM TO:

- * COUNTY ENVIRONMENTAL AGENCY (contact MDE, WMA if address needed)
- * WELL OWNER
- * MDE, WATER MANAGEMENT ADMINISTRATION, WELL PROGRAM

OK
 6117124
 (SP)

DATE WELL ABANDONED: 6-19-23 (month/day/year)

HO-95-1214

* PERMIT NUMBER OF ABANDONED WELL (if any)


* PERMIT NUMBER OF REPLACEMENT WELL:

* PERSON ABANDONING WELL: Andrew Houseman WELL DRILLER'S LICENSE NUMBER: 224

CIRCLE: MWD / MSD / MGD

* OWNER'S NAME: Keystone Custom Homes

SITE LOCATION MAP

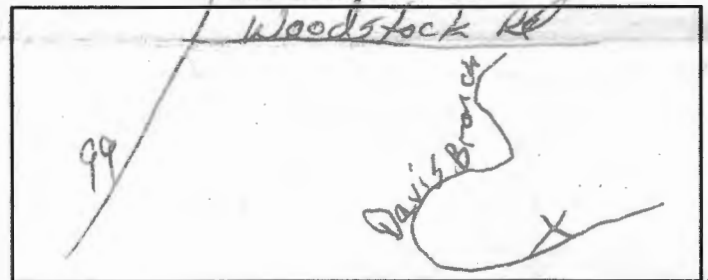

* WELL LOCATION:
 COUNTY: Howard
 NEAREST TOWN: Woodstock
 TAX MAP BLOCK PARCEL
 SUBDIVISION: Myrtue Property, 8
 SECTION: LOT:
 STREET ADDRESS: 1921 Davis Branch Rd

LATITUDE 39.318446

LONGITUDE -76.866933

LOG OF SEALING MATERIAL

MATERIAL	FEET	
	FROM	TO
<u>Stone</u>	<u>400</u>	<u>80</u>
<u>Bentonite</u>	<u>80</u>	<u>0</u>
VOLUME OF MATERIAL USED		
<u>Bentonite 800 lbs stone 4 yds</u>		

* TYPE OF WELL BEING ABANDONED:
 DRILLED JETTED
 BORED HAND DUG
 OTHER (specify) _____

* USE CODE:
 DOMESTIC MUNICIPAL/PUBLIC
 IRRIGATION INDUSTRIAL
 TEST/OBSERVATION GEOTHERMAL

* TYPE OF CASING:
 STEEL PLASTIC
 CONCRETE OTHER (specify) _____

SIZE OF CASING: 6 INCHES IN DIAMETER

DEPTH OF WELL: 325 FEET DEEP

WAS ANY CASING REMOVED? YES NO
 If yes, length removed, in feet: _____

WAS CASING RIPPED OR PERFORATED? YES NO

SIGNATURE-MASTER WELL DRILLER OR SUPERVISING SANITARIAN LICENSE#

224 MWD / MSD / MGS
 CIRCLE ONE

6-19-23 DATE

COUNTY

Pursuant to § 10-624 of the State Govt. Article of the Maryland Code, personal info requested on this form is used in processing this form pursuant to COMAR 26.04.04. Failure to provide the info may result in this form not being processed. You have the right to inspect, amend, or correct this form. The Maryland Department of the Environment is subject to the Maryland Public Information Act. This form may be made available on the Internet via MDE's website and is subject to inspection or copying, in whole or in part, by the public and other governmental agencies, if not protected by federal or State Law.