PERMIT

P 19470

A 14309

SEWAGE DISPOSAL SYSTEM

MARYLAND STATE DEPARTMENT OF HEALTH

HOWARD COUNTY

ELLICOTT CITY

DISTRICT 5

INDEXED

DATE 1/20/74

Al Stastny IS PERMITTED TO INSTALL X ALTER

ADDRESS P. O. Box 1946, Annpolid, Maryland 21404 PHONE 268-1731

A SEWAGE DISPOSAL SYSTEM LOCATED AT

SUBDIVISION Hemlock Hills ROAD Byefield Rd. LOT 21

PROPERTY OWNER William & Norma Limkow

ADDRESS

SPECIFICATIONS - 4 bedrooms

DRAIN FIELD ____ DEPTH ____ FEET, BOTTOM AREA ____ SQ. FT.

SEEPAGE PITS ____ ABSORBENT SIDE-WALL AREA ____ SQ. FT.

SEPTIC TANK CAPACITY 1250 GALLONS

FOR GARBAGE GRINDER, INCREASE DISPOSAL AREA 22% & TANK CAPACITY 50%.

OTHER Dry well - 400 sq. ft. absorbent sidewall area to begin below the first 4½ ft. of non-porous soil. Maximum depth permitted for dry well is 11 ft. below original grade. Locate dry well 70 ft. from right side line and 60 ft. from front property line as seen from Byefield Road.

NOTE: ALL PIPE FROM HOUSE TO DRY WELL MUST BE CAST IRON.

PERMIT VOID AFTER THREE YEARS.

NOTE: INSTALL STAND PIPE ON SEPTIC TANK AND DRY WELL.

PLANS APPROVED BY Robert V. Torre DATE 2/2/71

FILL SEPTIC TANK AND DISTRIBUTION BOX WITH WATER BEFORE CALLING FOR AN INSPECTION. COVER NO WORK UNTIL INSPECTED AND APPROVED.

NEITHER THE HOWARD COUNTY COMMISSIONERS NOR THE HEALTH DEPARTMENT IS RESPONSIBLE FOR THE SUCCESSFUL OPERATION OF ANY SYSTEM.

A 14309

DATE SYSTEM APPROVED ____ INSPECTOR ____

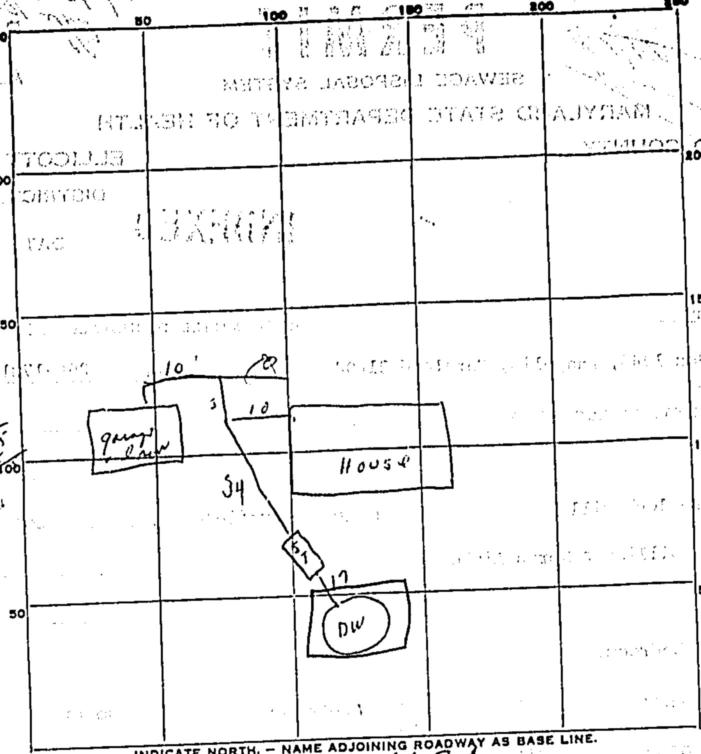

INDICATE NORTH. – NAME ADJOINING ROADWAY AS BASE LINE.

Byfield Rd.

PERMIT CARD NR

SEPTIC TANK, LEVEL OK CLEANOUTS OK

DISTRIBUTION BOX, LEVEL

TILE FIELD, DEPTH ____ FT. TRENCH WIDTH ____ FT.

GRAVEL DEPTH ____ IN. TOTAL LENGTH ____ FT.

NUMBER OF TRENCHES ____ TOTAL BOTTOM AREA ____

SEEPAGE PITS, INSIDE ~~DIAMETER~~ Perimeter ~~ft~~ 38 ft+ FT. DEPTH BELOW INLET 10½ effective depth FT.

ABSORBENT AREA ~~332~~ 390+ SQ. FT.

REMARKS ~~System~~ Inlet pipe 8" below lid - lid about 1½' below orig grade - ground at 1½'
needs trench off DW Trench to be 10' long - 9½ to 10' deep - 5' gravel under pipe
to check trench before gravel is installed - gravel must be brought up to inlet pipe
depth of D.W. OK to cover line [illegible] to DW - garage conn. [illegible]
[illegible] 1/31/74 OK to cover DW. lines
2/1/74 Entire systems covered; [illegible] DWM & FF. WWZ.

DATE SYSTEM APPROVED ____ INSPECTOR ____

2-5-74 Nothing due [illegible]