

APPLICATION

PERCOLATION TESTING

A 511343 B

P _____

HOWARD COUNTY HEALTH DEPARTMENT
BUREAU OF ENVIRONMENTAL HEALTH
3525-H ELLICOTT MILLS DRIVE/ELLICOTT CITY, MARYLAND 21043
TELEPHONE: 313-2640

DISTRICT 3RD

DATE ~~10-8-98~~
1/11/99

TO: THE COUNTY HEALTH OFFICER
ELLICOTT CITY, MARYLAND

I HEREBY APPLY FOR THE NECESSARY TEST PRIOR TO APPLICATION FOR PERMIT TO CONSTRUCT (OR RECONSTRUCT) A SEWAGE DISPOSAL SYSTEM.

PROPERTY OWNER LARRY SAMES

ADDRESS 3218 DANMARK DR.
WEST FRIENDSHIP, MD 21794 PHONE (410) 442-5788

AGENT OR PROSPECTIVE BUYER MILDENBERG, BOENDER & ASSOC.

ADDRESS 1072 DORSEY HALL DR. SUITE 202
ELLICOTT CITY, MD 21042 PHONE (301) 997-0296

PROPERTY LOCATION:

SUBDIVISION "BURNTWOOD" LOT NO. 5

ROAD AND DESCRIPTION CASTLEBAR DRIVE

TAX MAP 21 PARCEL # 110

SIZE OF LOT 40,345 SF TYPE BLDG. SFD
(SINGLE FAMILY DWELLING OR COMMERCIAL)

THE SYSTEM INSTALLED UNDER THIS APPLICATION IS ACCEPTABLE ONLY UNTIL PUBLIC FACILITIES BECOME AVAILABLE. I FULLY UNDERSTAND THE FEE CONNECTED WITH THE FILING OF THIS PERC TEST APPLICATION IS NON-REFUNDABLE UNDER ANY CIRCUMSTANCES. I ALSO AGREE TO

COMPLY WITH ALL M.O.S.H.A. REQUIREMENTS IN TESTING THIS LOT. [Signature]
(SIGNATURE OF APPLICANT)

APPROVED BY _____ FOR _____ DATE _____

DISAPPROVED BY _____ FOR _____ DATE _____

HOLD PENDING FURTHER TESTS _____

REASONS FOR REJECTION OR HOLDING PERC OK, HOLD FOR PLAT MR 2/8/99

PERCOLATION TEST PLAT/PRELIMINARY PLAT - TITLE OR I.D. # _____ DATE _____

SITE DEVELOPMENT PLAN/FINAL PLAT - TITLE OR I.D. # _____ DATE _____

THIS IS NOT A PERMIT

511343B

COUNTY #


SOIL PROFILE

0' (9)
brn
orge
sa cl m
6
tan
sa lm
10-15%
frags

13
R
orge
sa
cl lm
4
tan
sa lm
5% frags

7
tan sa lm
20% frags
11 1/2
SEMI-HARB

4
red
cl lm
5
tan
sa lm
20-25%
frags
12 1/2

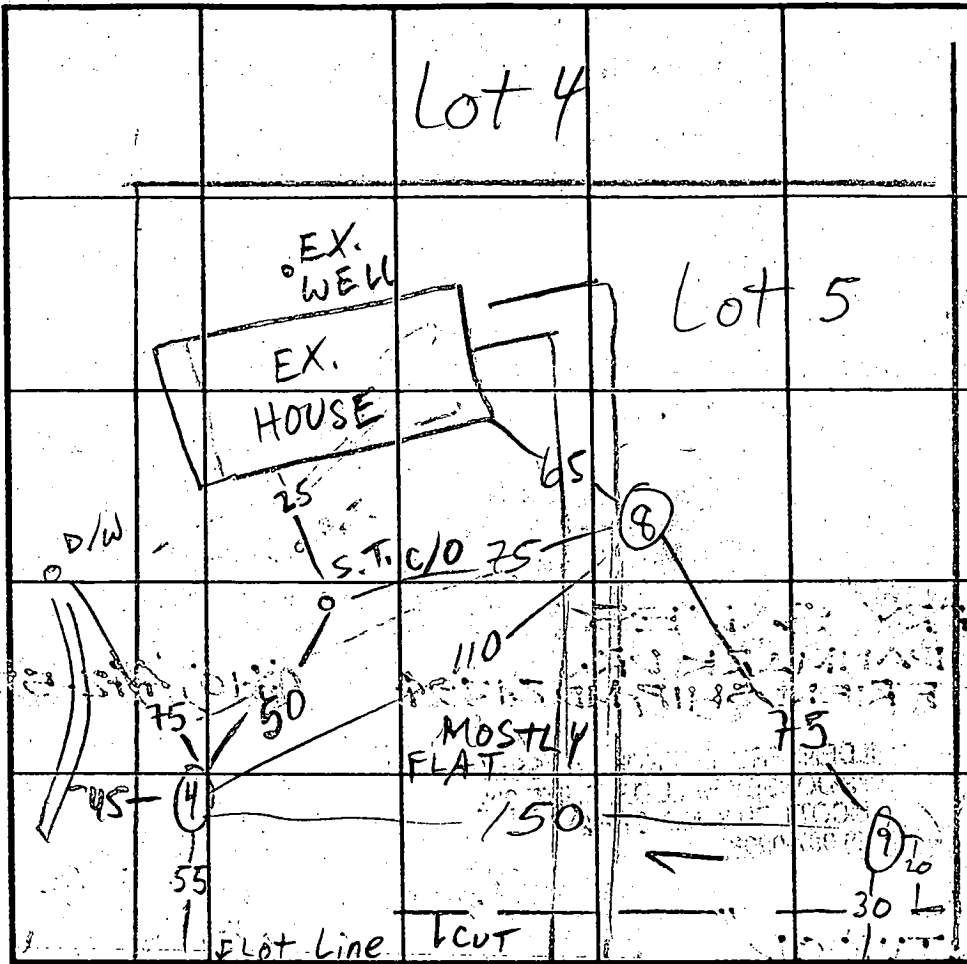

SOIL PROFILE

0'
NO
WELLS
W/IN
100'

INDICATE NORTH - NAME ADJOINING ROADWAY AS BASE LINE.

CASTLEBAR DR

DATE	TEST NO.	DEPTH	PRE-WET		TEST - 1" DROP		TIME
			START	STOP	START	STOP	
2/1/99	9 S	6	10:15	10:17	10:17	10:21	4
	9 V	13					
	8 S	5 1/2	11:07	11:09	11:09	11:12	3
	8 V	11 1/2					
	4 S	5 1/2	11:15	11:21	11:21	11:35	14
	4 V	12' 3"					

REMARKS HOLES (9) PER PLAN, HOLE (8) ADJUSTED

TYPE OF SOIL

TESTED BY M. Rifkin

ALSO PRESENT owner, Corky (Choe)

TRENCH DESIGN DATA: AVERAGE PERCOLATION TIME

(4) (8) (9)

7

TRENCH WIDTH

3

INLET DEPTH

5 1/2


MAXIMUM BOTTOM DEPTH

7

SQ. FT./BEDROOM

180

S 80°09'00" E Signed Perc Cert

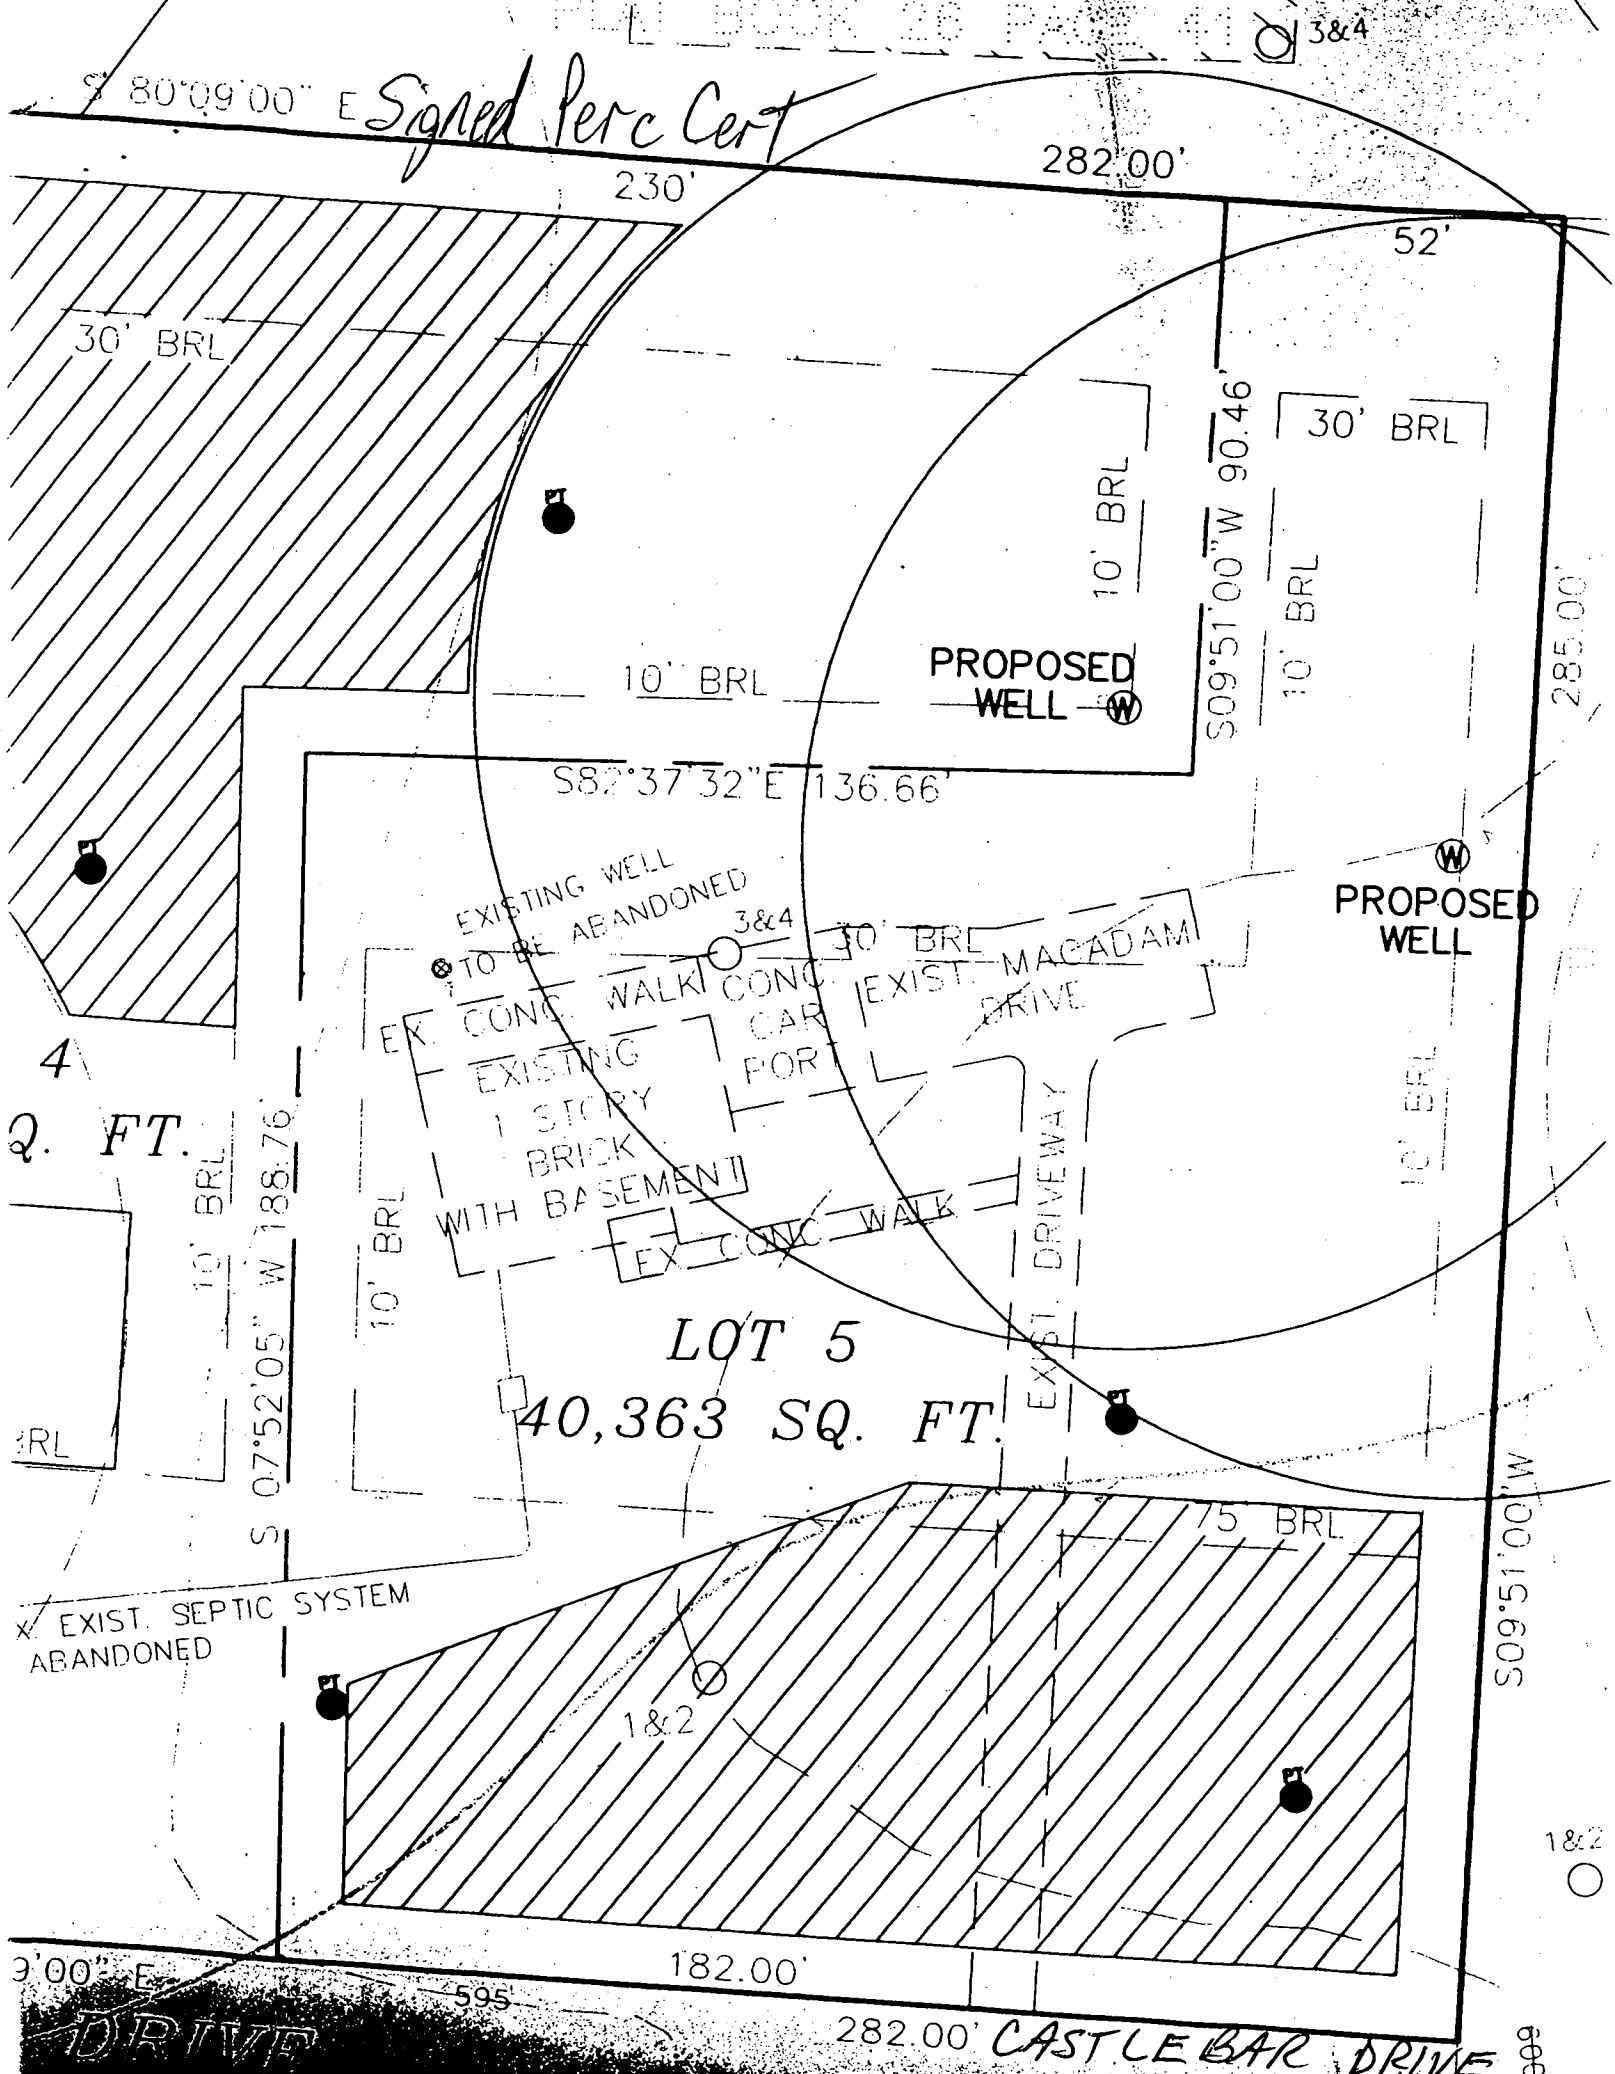

282.00'

230'

52'

30' BRL

S09°51'00" W 90.46'

30' BRL

10' BRL

10' BRL

285.00'

10' BRL

PROPOSED WELL

S82°37'32" E 136.66'

PROPOSED WELL

EXISTING WELL TO BE ABANDONED

3&4

EXIST. CONC. WALK EXIST. CONC. CAR PORT EXIST. DRIVEWAY

EXISTING 1 STORY BRICK WITH BASEMENT

EXIST. CONC. WALK EXIST. DRIVEWAY

LOT 5

40,363 SQ. FT.

4 Q. FT.

S 07°52'05" W 188.76'

10' BRL

10' BRL

10' BRL

EXIST. DRIVEWAY

S09°51'00" W

EXIST. SEPTIC SYSTEM ABANDONED

1&2

15 BRL

1&2

3'00" E


182.00'

282.00' CASTLEBAR DRIVE

595

000

11/12/99 NO WELL STAKES (MR)

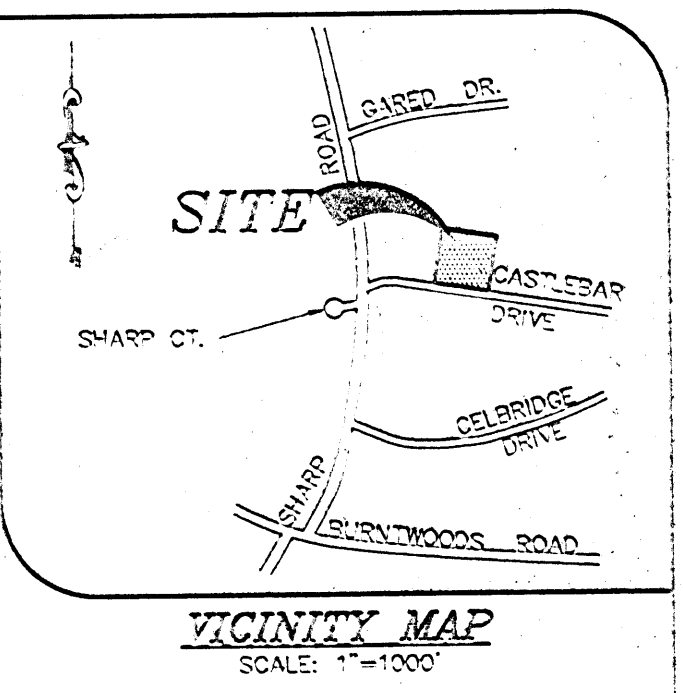

Date	MARCH 99	SA	approval
Project	990086	SA	scale
Illustration		SA	1"=30'

description	519
revision	10

BURNTWOODS
 LOTS 4 & 5
 TAX MAP 21 - SECTION 3 - PART 2 - BLOCK B
 HOWARD COUNTY, MARYLAND
 THIRD ELECTION DISTRICT
PERCOLATION CERTIFICATION PLAT



LEGEND

- PASSED PERC TEST HOLES (1999)
- PASSED EXISTING PERC TEST HOLES (1984)
- ⊙ EXISTING WELL
- ⊕ PROPOSED WELL
- ▨ EXISTING SEPTIC RESERVE AREA

GENERAL NOTES:


1. SITE DATA:
 TAX MAP 21 - PART 2 - BLOCK B
 DEED REFERENCE: 437/182
 GROSS AREA: 1.845 ACRES ±
 ZONE: RC-350 (ZONING MAP DATED OCTOBER 18, 1993)
 AREA OF STEEP SLOPES: 0 ACRES
 AREA OF WETLANDS: 0 ACRES
 AREA IN ROW AND ROAD: 0 ACRES
 NET AREA OF SITE: 1.845 ACRES ±
2. TOPOGRAPHIC DATA BASED ON HOWARD COUNTY'S 200 SCALE MAPS. BOUNDARY BASED ON DEED DESCRIPTION.
3. BASED ON AVAILABLE COUNTY DATA, NO HISTORIC STRUCTURES OR BURIAL GROUNDS EXIST ON SITE.
4. SOILS DATA BASED ON HOWARD COUNTY SOIL SURVEY DATED JULY 1968, SHEET 13.
5. EXISTING WELL AND SEPTIC AREAS/SYSTEMS FOR GWENLEE PROPERTY SECTION ONE LOT 5 ARE LOCATED MORE THAN 100' FROM THE PROPERTY LINE.
6. PRIVATE WATER AND PRIVATE SEWERAGE WILL BE UTILIZED.
7. THE LOCATION OF THE EXISTING HOUSE, DRIVEWAY, AND WELL ON THE LOT IS APPROXIMATE.
8. ▨ THIS AREA DESIGNATES A PRIVATE SEWERAGE EASEMENT OF AT LEAST 10,000 SQ. FT., AS REQUIRED BY THE MARYLAND STATE DEPARTMENT OF ENVIRONMENT FOR INDIVIDUAL SEWERAGE DISPOSAL IMPROVEMENTS OF ANY NATURE IN THIS AREA ARE RESTRICTED UNTIL PUBLIC SEWERAGE IS AVAILABLE. THIS EASEMENT SHALL BECOME VOID UPON CONNECTION TO A PUBLIC SEWERAGE SYSTEM. THE COUNTY HEALTH OFFICER SHALL HAVE THE AUTHORITY TO GRANT VARIANCES FOR ENCROACHMENTS INTO THE PRIVATE SEWERAGE EASEMENT. RECORDATION OF A MODIFIED EASEMENT SHALL NOT BE NECESSARY.
9. ALL NEW WELLS ARE TO BE DRILLED AND EXISTING WELL AND SEPTIC SYSTEM ON LOT 5 PROPERLY ABANDONED PRIOR TO SIGNATURE OF ORIGINAL SUBMISSION OF RECORD PLAT.
10. ALL EXISTING WELLS AND SEPTIC AREAS WITHIN 100 FEET OF PROPERTY BOUNDARIES ARE SHOWN.
11. ADJOINING WELLS ARE FIELD LOCATED BY MILDENBERG, BOENDER & ASSOCIATES, ON MARCH, 1999.

SOILS DESCRIPTION

SYMBOL	DESCRIPTION
CH1	CHESTER SILT LOAM, 0% TO 3% SLOPES
CH2	CHESTER SILT LOAM, 3% TO 8% SLOPES, MODERATELY ERODED
CH3	CHESTER SILT LOAM, 3% TO 8% SLOPES, MODERATELY ERODED


OWNER
 LARRY JAMES
 3218 DANMARK DRIVE
 WEST FRIENDSHIP, MD 21794
 (410) 642-5788

Signed
 Perc Cert

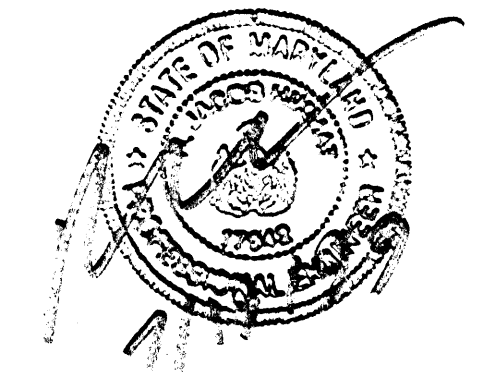

APPROVED FOR PRIVATE WATER AND SEWERAGE SYSTEM
 HOWARD COUNTY HEALTH DEPARTMENT
Dir. Walsh 3/2/00
 HOWARD COUNTY HEALTH OFFICER HA DATE

MILDENBERG, BOENDER & ASSOC., INC.
 Engineers Planners Surveyors
 5072 Dorsey Hall Drive, Suite 202, Beltsville, Maryland 21042
 (410) 997-0296 Balt. (301) 621-5521 Wash. (410) 997-0298 Ftc.

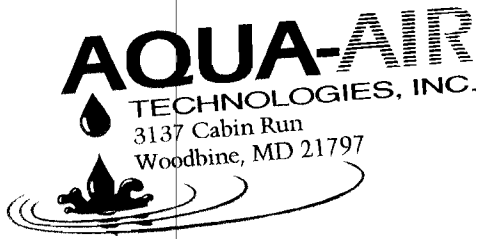

Michael G. Putro
President

410-489-5288
fax 410-489-4183

File:
Mike Kay of C&L called requesting
relief from the well before final
plat approval requirement. ~~As~~ I
consulted w/ d/w and he agreed
that it should be drilled prior to
final because of the location in
the pipestem. In addition, the
owners were informed that
this would be a requirement
of the S/D at the time of
percolation testing

AW

1/8/16

5072 Dorsey Hall Drive, Suite 202, Ellicott City, Maryland 21042 (410) 997-0296 Balt. (301) 621-5521 Wash. (410) 997-0298 Fax
October 8, 1998

Mr. Craig Williams
Howard County Health Department
3525 Ellicott Mills Drive, Suite H
Ellicott City, MD 21043

WET SEASON
\$250
~~\$250~~ TEST FEES
EX. RECORDED LOTS
(1 NEW, 1 REPAIR)

RE: Burntwood, Lots 4 and 5
Perc Test Plat

Dear Mr. Williams:

On behalf of our client, Larry Sames, we are submitting the following perc test plat package for your review:

- 1) Two (2) blueprint copies of the Perc Test Plat.
- 2) Two (2) applications for perc testing for the two new proposed lots.

The following should be noted concerning this plat:

1. A grid system is proposed to allow our client the flexibility of configuring the lot layout without the need to use additional per days. The location of the wells will be determined after the per results are established. Specific septic areas and wells locations will shown on the perc certification plat.
2. The two lots already exist. The purpose of this plat is to create two (2) septic and well locations to allow for the reconfiguration of the 2 lots.

Thank you for your time and effort. Should you have any questions or comments concerning this matter, please feel free to contact our office.

Very truly yours
Mildenberg, Boender & Associates, Inc.


R. Jacob Hikmat, P.E.
Vice President

cc: Larry Sames. W/enc.

rjh

98086.2

5072 Dorsey Hall Drive, Suite 202, Ellicott City, Maryland 21042 (410) 997-0296 Balt. (301) 621-5521 Wash. (410) 997-0298 Fax

November 17, 1998

Mr. Craig Williams
Howard County Health Department
3525 Ellicott Mills Drive, Suite H
Ellicott City, MD 21043

RE: Burntwood, Lots 4 and 5
Perc Test Plat

Dear Mr. Williams:

On behalf of our client, Larry Sames, we are submitting the following perc test plat package for your review:


- 1) TWO (2) blueprint copies of the Perc Test Plat.
- 2) Two (2) applications for perc testing for the two new proposed lots.

The following should be noted concerning this plat:

1. A grid system is proposed to allow our client the flexibility of configuring the lot layout without the need to use additional per days. The location of the wells will be determined after the per results are established. Specific septic areas and wells locations will shown on the perc certification plat.
2. The two lots already exist. The purpose of this plat is to create two (2) septic and well locations to allow for the reconfiguration of the 2 lots.

Thank you for your time and effort. Should you have any questions or comments concerning this matter, please feel free to contact our office.

Very truly yours
Mildenberg, Boender & Associates, Inc.

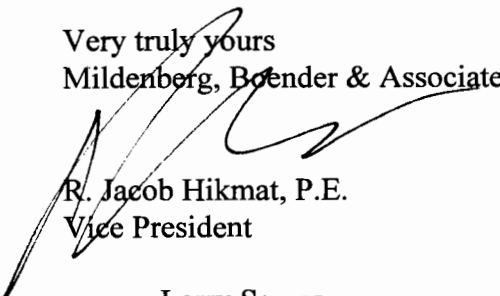
R. Jacob Hikmat, P.E.
Vice President

cc: Larry Sames
Cindy Hamilton, DPZ

rjh

98086.2

November 17, 1998

Mr. Craig Williams
Howard County Health Department
3525 Ellicott Mills Drive, Suite H
Ellicott City, MD 21043

RE: Burntwood, Lots 4 and 5
Perc Test Plat

Dear Mr. Williams:

On behalf of our client, Larry Sames, we are submitting the following perc test plat package for your review:

- 1) TWO (2) blueprint copies of the Perc Test Plat.
- 2) Two (2) applications for perc testing for the two new proposed lots.

The following should be noted concerning this plat:

1. A grid system is proposed to allow our client the flexibility of configuring the lot layout without the need to use additional per days. The location of the wells will be determined after the per results are established. Specific septic areas and wells locations will shown on the perc certification plat.
2. The two lots already exist. The purpose of this plat is to create two (2) septic and well locations to allow for the reconfiguration of the 2 lots.

Thank you for your time and effort. Should you have any questions or comments concerning this matter, please feel free to contact our office.

Very truly yours
Mildenberg, Boender & Associates, Inc.

R. Jacob Hikmat, P.E.
Vice President

cc: Larry Sames
Cindy Hamilton, DPZ

rjh

98086.2

~~DEAR MR. HIKMAT,
PROPOSAL IS UNACCEPTABLE
IN ITS CURRENT FORMAT.
NO PROPOSED SEPTIC AREAS/WELL SITES
ARE SHOWN. NONE WELLS & SEPTICS ON
SURROUNDING PROPERTIES -~~

December 9, 1998

Mr. Craig Williams
Howard County Health Department
3525 Ellicott Mills Drive, Suite H
Ellicott City, MD 21043

RE: Burntwood, Lots 4 and 5
Resubmission Perc Test Plat

Dear Mr. Williams:

On behalf of our client, Larry Sames, we are resubmitting the following perc test plat package for your review:


- 1) Two (2) blueprint copies of the Perc Test Plat.
- 2) Two (2) applications for perc testing for the two new proposed lots.
- 3) One (1) copy of the location survey of the project.

The following should be noted concerning this plat:

4. A grid system is proposed to allow our client the flexibility of configuring the lot layout without the need to use additional per days.
5. The two lots already exist. The purpose of this plat is to create two (2) septic and well locations to allow for the reconfiguration of the 2 lots.

Thank you for your time and effort. Should you have any questions or comments concerning this matter, please feel free to contact our office.

Very truly yours
Mildenberg, Boender & Associates, Inc.

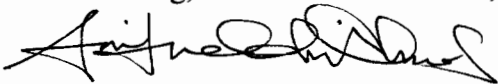

Saifuddin Ahmed, EIT
Project Manager

cc: Larry Sames, w/enc.
Cindy Hamilton, DPZ

sa
98086.3



HOWARD COUNTY HEALTH DEPARTMENT

Joyce M. Boyd, M.D., County Health Officer

December 9, 1998

Mr. R. Jacob Hikmat
c/o Mildenberg Boender Associates
5072 Dorsey Hall Drive
Suite 202
Ellicott City, MD 21043

RE: Application for Perc Testing
Burntwood, Sec. 3, Block B
Lots 4 and 5
Castlebar Drive

Dear Mr. Hikmat:


This office is in receipt of the referenced percolation test application and site plan.

The submitted plan is insufficient for scheduling due to the following:
--proposed septic reserve areas are not shown
--proposed well site(s) are not shown
--wells and septic systems on adjacent lots are not shown.

In addition, wet season scheduling is anticipated for this property due to the history of water table problems in the neighborhood and the proximity of these lots to depicted zones of wet season soils.

Once a plan acceptable for scheduling has been received, test fees of \$250 (\$225 and \$25 repair fee) are due in this office thirty days before the assigned test date.

Thank you for your attention to this matter. If you have any questions, please contact this office at (410)313-2640.

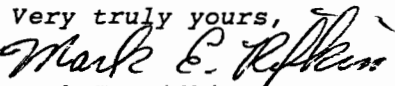Very truly yours,

Mark E. Rifkin, R.S.
Water and Sewerage Program

MR
cc: Larry Sames
File



HOWARD COUNTY HEALTH DEPARTMENT

Joyce M. Boyd, M.D., County Health Officer

January 7, 1999

Mr. Saifuddin Ahmed
Mildenburg Boender & Associates
5072 Dorsey Hall Drive, Suite 202
Ellicott City, MD 21042

RE: Percolation Testing
Burntwoods, Sec. 3, Block B
Lots 4 and 5
Castlebar Drive

Dear Mr. Ahmed:

A percolation test date has been reserved for Friday, January 22, 1999 at 10:00 a.m.

You will be responsible for having a contractor on-site to excavate test holes at the locations depicted on the plan submitted December 9, 1998. It is suggested that excavation of test locations 6 and 7 is neither necessary nor useful for the purposes of this project. It is also suggested that test location 8 be adjusted to a location to the right of the existing driveway and at the northern edge of the proposed reserve area.

Percolation testing is contingent upon receipt of the test fees (\$225 and \$25 repair fee) by January 8, 1999. Please call this office at (410) 313-2640 to confirm this test date.

1/11/99 A511343
CONFIRMED

Thank you for your cooperation in this matter.

Very truly yours,

Mark E. Rifkin, R.S.

Water and Sewerage Program

MR

cc: Larry Sames
File



HOWARD COUNTY HEALTH DEPARTMENT

Joyce M. Boyd, M.D., County Health Officer

February 19, 1999

Larry Sames
3218 Danmark Drive
West Friendship, MD 21794

RE: PERCOLATION TEST RESULTS
A 511343 A&B
Burntwoods, Lots 4 and 5
Map 21, Parcel 110
Castlebar Drive

Dear Mr. Sames:

Percolation testing conducted February 1, 1999 at the referenced property indicated satisfactory soil conditions, but the sufficiency of available area for a sewage easement on lot 4 is uncertain. Copies of the test results are enclosed.

Further review is contingent upon submission by a registered engineer of a percolation certification plan showing actual locations and elevations of all excavated test holes and a suitable house and well site. The plat should also include the locations of all existing wells and septic systems on the property as well as the locations of any other relevant features such as streams, swales, or existing structures. A note must be included certifying that all existing wells and septic systems within 100 feet of property boundaries have been shown.

The combination of limited acreage and a well on adjacent lot 3 reduces the likelihood that adequate area is available area for a sewage easement on lot 4. Please be certain that precise locations of all existing wells and septic systems within 100 feet of property boundaries are shown.

The plan should include a note that all new wells will be drilled and the existing well on lot 5 properly abandoned prior to submittal of the record plat for review.

The percolation certification plat should be submitted within 60 days to allow field verification if necessary. If you have any questions regarding this matter, please feel free to contact me at the above address or by calling (410) 313-2640.

Very truly yours,

Mark E. Rifkin, R.S.
Water and Sewerage Program

MR
Enclosures
cc: Mildenberg Boender Associates
File

March 8, 1999

Mr. Craig Williams
Howard County Health Department
3525 Ellicott Mills Drive, Suite H
Ellicott City, MD 21043

RE: Burtntwoods Lots 4 & 5, Section 3, Tax map 21
Percolation Plat for lots 4 & 5
Castlebar Drive

Dear Mr. Williams:

On behalf of our client, Larry Sames, we are submitting the following Percolation Plat package for your approval:

1. Two (2) prints of the Percolation Plat.

Please note the following items regarding this project:

1. Percolation testing has already been performed for the new septic easements for these lots.
2. The original mylar will be submitted upon Health Department approval.

Thank you for your time and effort. Should you have any questions or comments concerning this matter, please feel free to contact our office at your earliest convenience.

Very truly yours
Mildenberg, Boender & Associates, Inc.



Saifuddin Ahmed
Project Manager

cc: Larry Sames, w/encl.
sa

h:\98086\wp\086-4.hth.wpd



HOWARD COUNTY HEALTH DEPARTMENT

Mary Sue Baker, MBA, Acting County Health Officer

April 19, 1999

Larry Sames
3218 Danmark Drive
West Friendship, MD 21794

RE: Plan Review Comments
A 511343 A&B
Burntwoods, Lots 4 and 5
Map 21, Parcel 110
Castlebar Drive

Dear Mr. Sames:

This office has received the referenced percolation certification plan, but is not able to approve it at this time. Serious concerns remain about proposed well locations downhill of proposed sewage easement locations, as well as other issues.

The sufficiency of available area for a sewage easement and a well on lot 4 are uncertain due to limited acreage, a well on adjacent lot 3, a proposed uphill sewage easement on lot 5, and an existing sewage area to the rear.

Because of these concerns it is recommended that the proposal be withdrawn, rather than continue to develop the property under what would be marginal conditions at best.

If you want to pursue these issues, a meeting in this office is suggested. To schedule this meeting or if you have any questions regarding this matter, please contact me at the address below or by calling (410) 313-2640.

Very truly yours,

Mark E. Rifkin, R.S.
Water and Sewerage Program

MR
Enclosures
cc: Mildenberg Boender Associates
File

4/27/99
MTG w/ J. Hikmat
& ASSOC
CONSIDER
ALTERNATIVE
PROPOSAL
WITH BOTH WELLS
TO TOP
RIGHT
CORNER
MR/CW

May 6, 1999

Mr. Mark E. Rifkin, R.S.
Howard County Health Department
3525 Ellicott Mills Drive, Suite H
Ellicott City, MD 21043

RE: Burtntwoods Lots 4 & 5, Section 3, Tax map 21
Percolation Plat for lots 4 & 5
Castlebar Drive

Dear Mr. Rifkin:


On behalf of our client, Larry Sames, we are submitting the following Revised Percolation Plat package for your approval:

1. Two (2) prints of the Percolation Plat.

This revision is in response to your letter dated April 19, 1999, a meeting was held between Mr. Jacob Hikmat and Mr. Craig Willams on April 27, 1999. As per the meeting proposed wells on lot 4 and 5 have been relocated and sufficient septic easements have been provided.

Thank you for your time and effort. Should you have any questions or comments concerning this matter, please feel free to contact our office at your earliest convenience.

Very truly yours
Mildenberg, Boender & Associates, Inc.

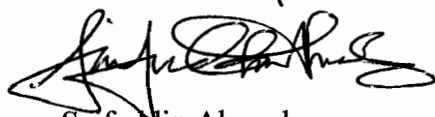

Saifuddin Ahmed
Project Manager

cc: Larry Sames, w/encl.

h:\98086\wp\086-5.hth.wpd

July 19, 1999

Mr. Mark E. Rifkin, R.S.
Howard County Health Department
3525 Ellicott Mills Drive, Suite H
Ellicott City, MD 21043

RE: Burtntwoods Lots 4 & 5, Section 3, Tax map 21
Percolation Plat for lots 4 & 5
Castlebar Drive
Original Submission

Dear Mr. Rifkin:

On behalf of our client, Larry Sames, we are submitting the original Percolation Plat package for your signature:


1. One (1) original mylar of the Percolation Plat.
2. Two (2) prints of the Percolation Plat.

As per our conversation in your office on 7/19/99, the following changes are made on the plan:

1. Revising general note #9.
2. Adding date on the Passed Percolation test legend.

Thank you for your time and effort. Should you have any questions or comments concerning this matter, please feel free to contact our office at your earliest convenience.

Very truly yours
Mildenberg, Boender & Associates, Inc.

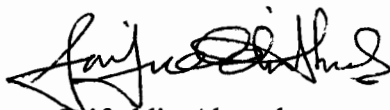

Saifuddin Ahmed
Project Manager

cc: Larry Sames, w/encl.
sa

h:\98086\wp\086-6.hth.wpd


Burntwoods F-00-028

Review 1. Ex. well not abandoned

2. Wells not drilled

3. Ex. septic
not abandoned

MR 2/9/08

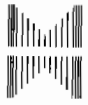

**MILDENBERG,
BOENDER & ASSOC., INC.**

Engineers

Planners

Surveyors

5072 Dorsey Hall Drive, Suite 202, Ellicott City, Maryland 21042 (410) 997-0296 Balt. (301) 621-5521 Wash. (410) 997-0298 Fax

July 13, 2000

Mr. Mark E. Rifkin
Howard County Health Department
3525-H Ellicott Miles Drive
Ellicott City, MD 21043

RE: Burntwood, Sec. 3, part 2
F-00-28

Dear Mr. Rifkin :

410-627
3441

We have been informed by our client, Lawrence A. Sames and Freda J. Sames, the wells have been dug and that the septic has been installed/abandoned per your requirements.

Please forward a written approval for this plat to the Department of Planning and Zoning in order for the plat to be further processed for signature.

Thank you for your time and effort. Should you have any questions or comments, please do not hesitate to call.

Very truly yours
MILDENBERG, BOENDER & ASSOCIATES, INC.

R. Jacob Hikmat, P.E.
Vice President

cc: Brenda Barth. DPZ
Lawrence Sames

98086.4




HOWARD COUNTY HEALTH DEPARTMENT

Diane L. Matuszak, M.D., M.P.H., County Health Officer

August 4, 2000

TO: Brenda Barth
Division of Land Development

FROM: Mark Rifkin 
Water and Sewerage Program

RE: File Number: F-00-028
Title: Burntwoods, Sec. 3, Part 2

The following comments apply to the referenced document:

The Health Department has no objections to further processing of the referenced originals.

All of the requirements specified on the approved percolation certification plan have been completed. These include: septic system replacement for the existing dwelling on lot 5, proper abandonment of the existing septic system, drilling of the well for each lot, and proper abandonment of the existing well.

MR

Bureau of Environmental Health

3525-H Ellicott Mills Drive • Ellicott City, Maryland 21043-4544

Water and Sewerage, Permits (410) 313-1771 Community Environmental Health Program (410) 313-1773
Director (410) 313-2640 TDD(410) 313-2323 TOLL FREE - 1-877-4MD-DHMH


PROPERTY KNOWN AS: LOTS 4 & 5, BLOCK B

THIS PLAT CAN NOT BE USED TO ESTABLISH PROPERTY LINES OR CORNERS.

BURNTWOOD
SECTION 3 (PART 2)
3RD ELECTION DISTRICT
HOWARD COUNTY
MARYLAND
PLAT BOOK 10 PAGE 21



Lot 6 (SECTION 3 PART 1) PLAT BOOK 10 PAGE 20

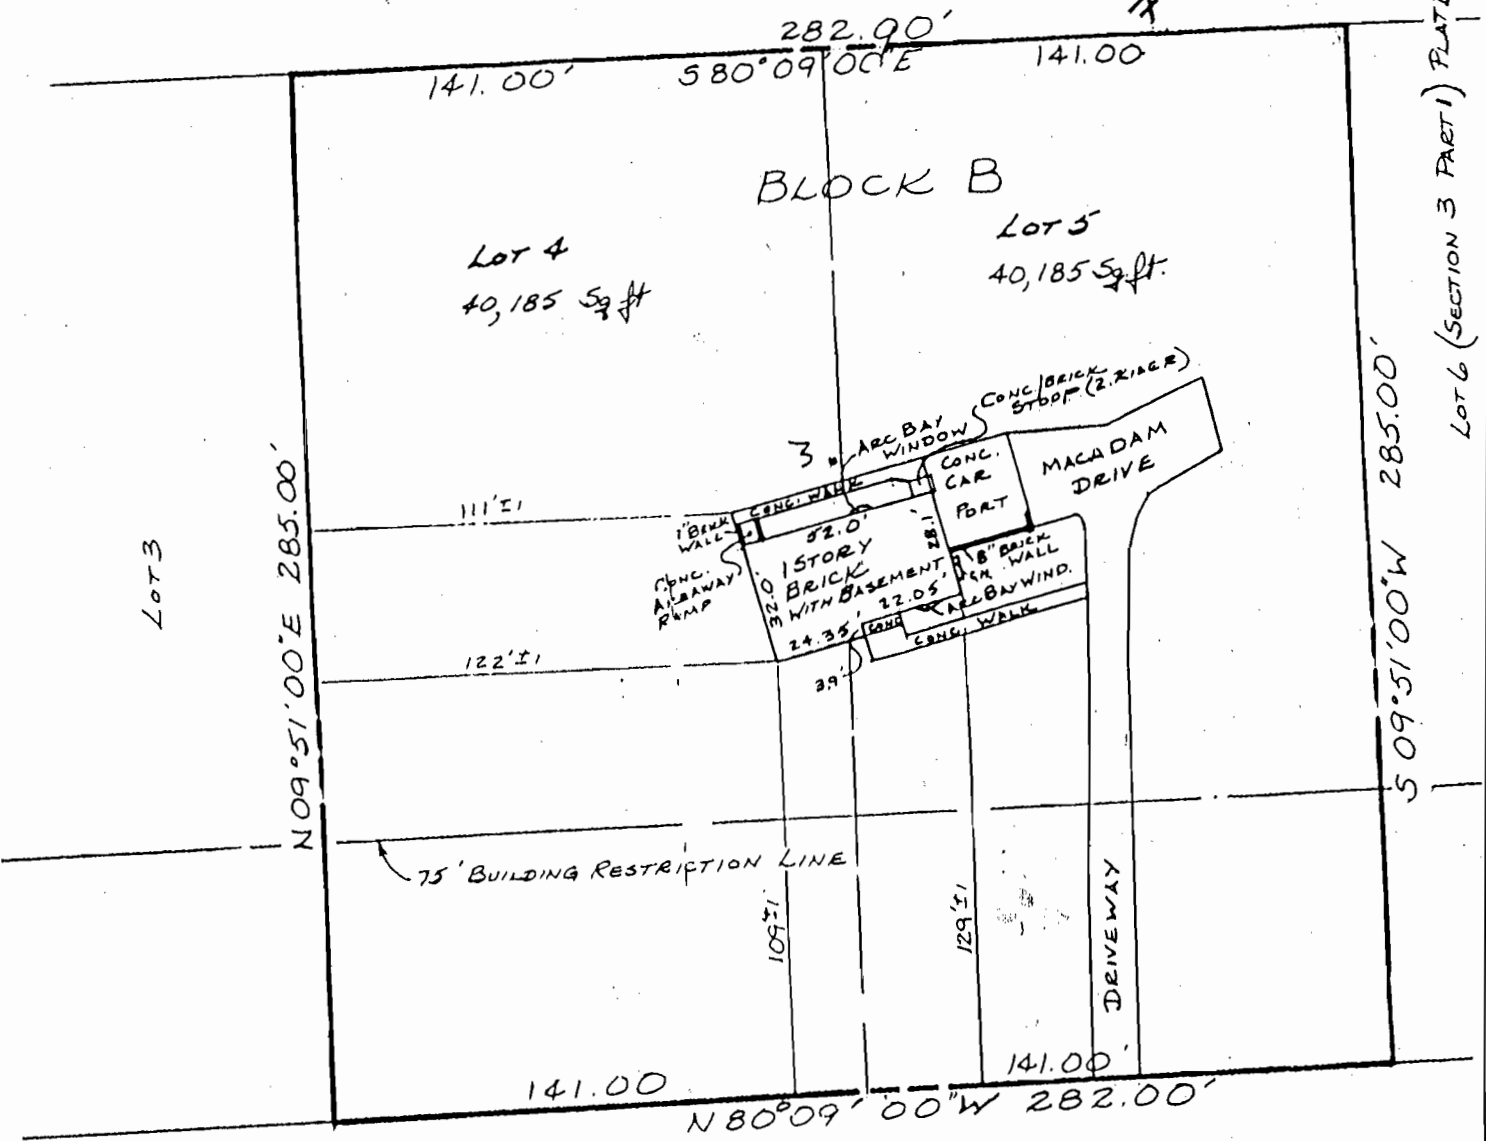

50' R/W
CASTLEBAR DRIVE