


NOTES:

1. BOUNDARY SHOWN HEREON BASED ON A DEED PLOTTING.
2. TOPOGRAPHY SHOWN HEREON BASED ON HOWARD COUNTY PHOTOGRAMMETRIC MAPS.
3. TAX MAP: 29
4. PARCEL: 36
5. EX. STREAM HAS BEEN FIELD LOCATED BY BOENDER ASSOCIATES.

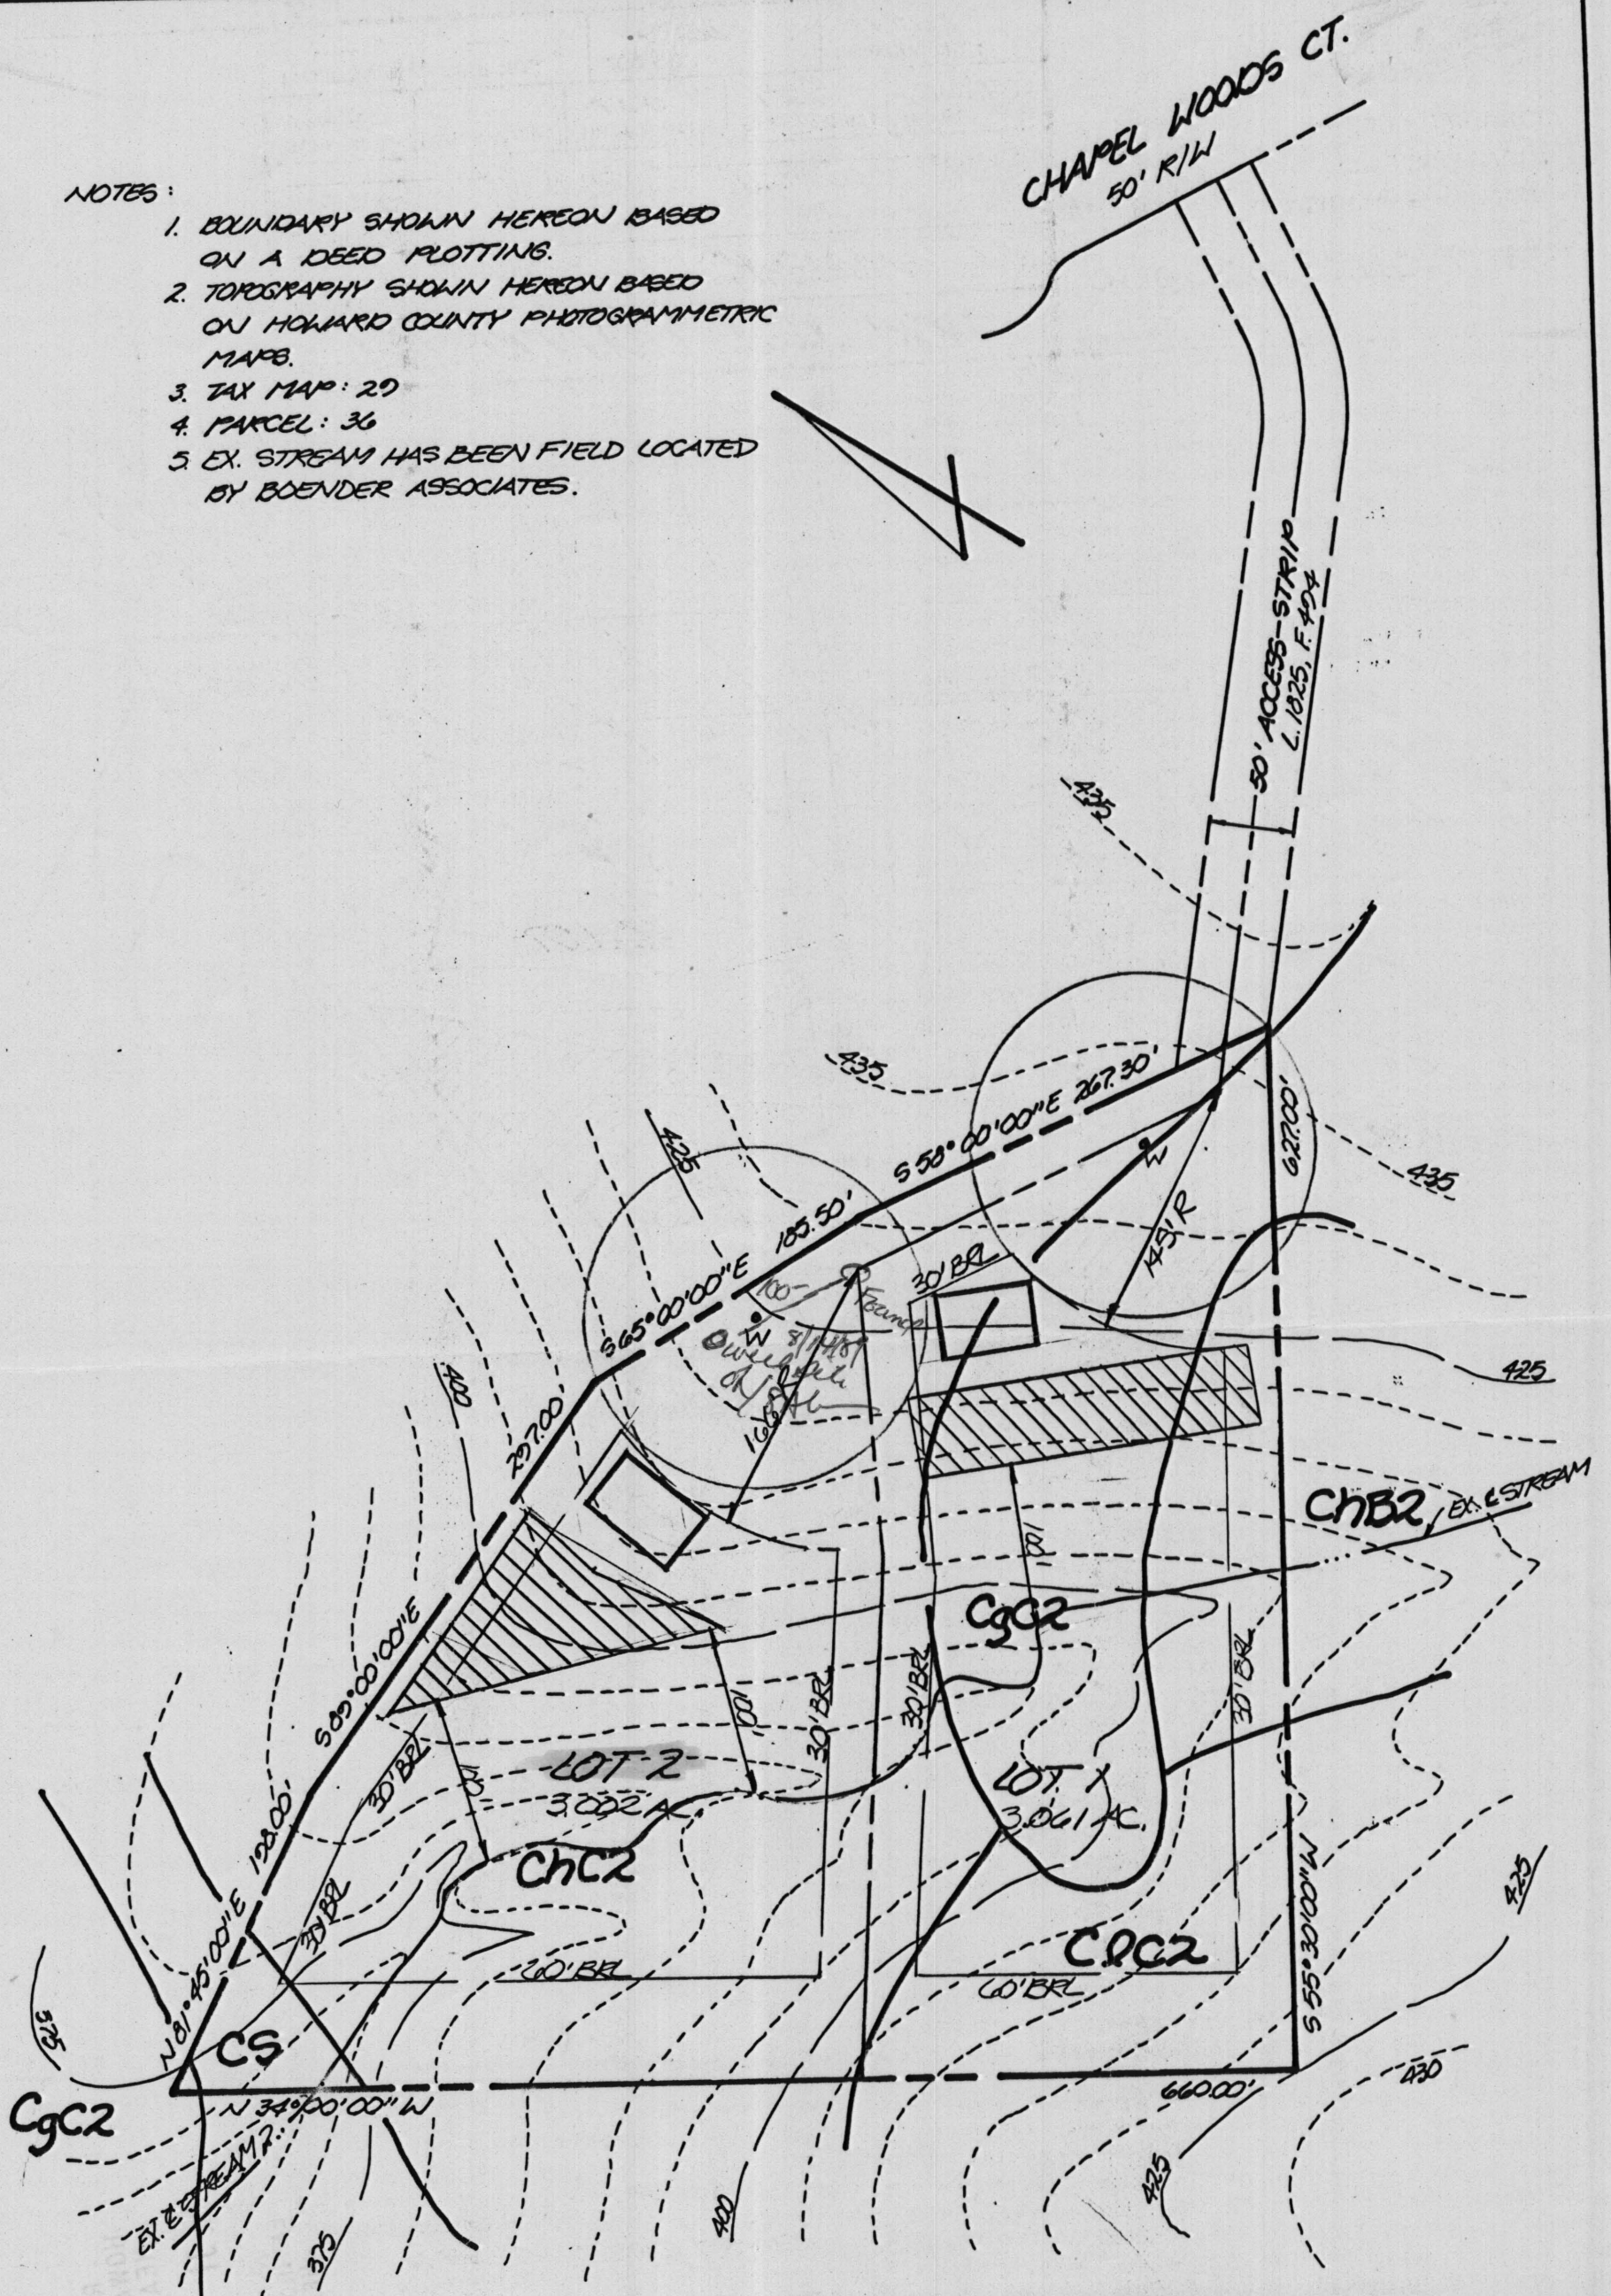

TITLE: <b>PERCOLATION TEST PLAT</b>				
PROJECT: <b>REA PROPERTY</b>				
LOCATION: <b>5 TH</b> ELECTION DISTRICT <b>HOWARD</b> CO., MD.				
SCALE: 1" = 100'	DESIGNED BY: —	DRAWN BY: J.C.O.	CHECKED BY: L.E.B.	DATE: SEPT., 1968
FIELD BOOK: —	PAGE NO.: —	JOB NO.: 06927	DRAWING NO.: 1 OF 1	

**boender associates**  
inc.  
consulting engineers  
land surveyors  
land planners

COURTHOUSE SQUARE  
3565 ELLICOTT MILLS DRIVE  
ELLICOTT CITY, MD. 21043  
13011 465-7777