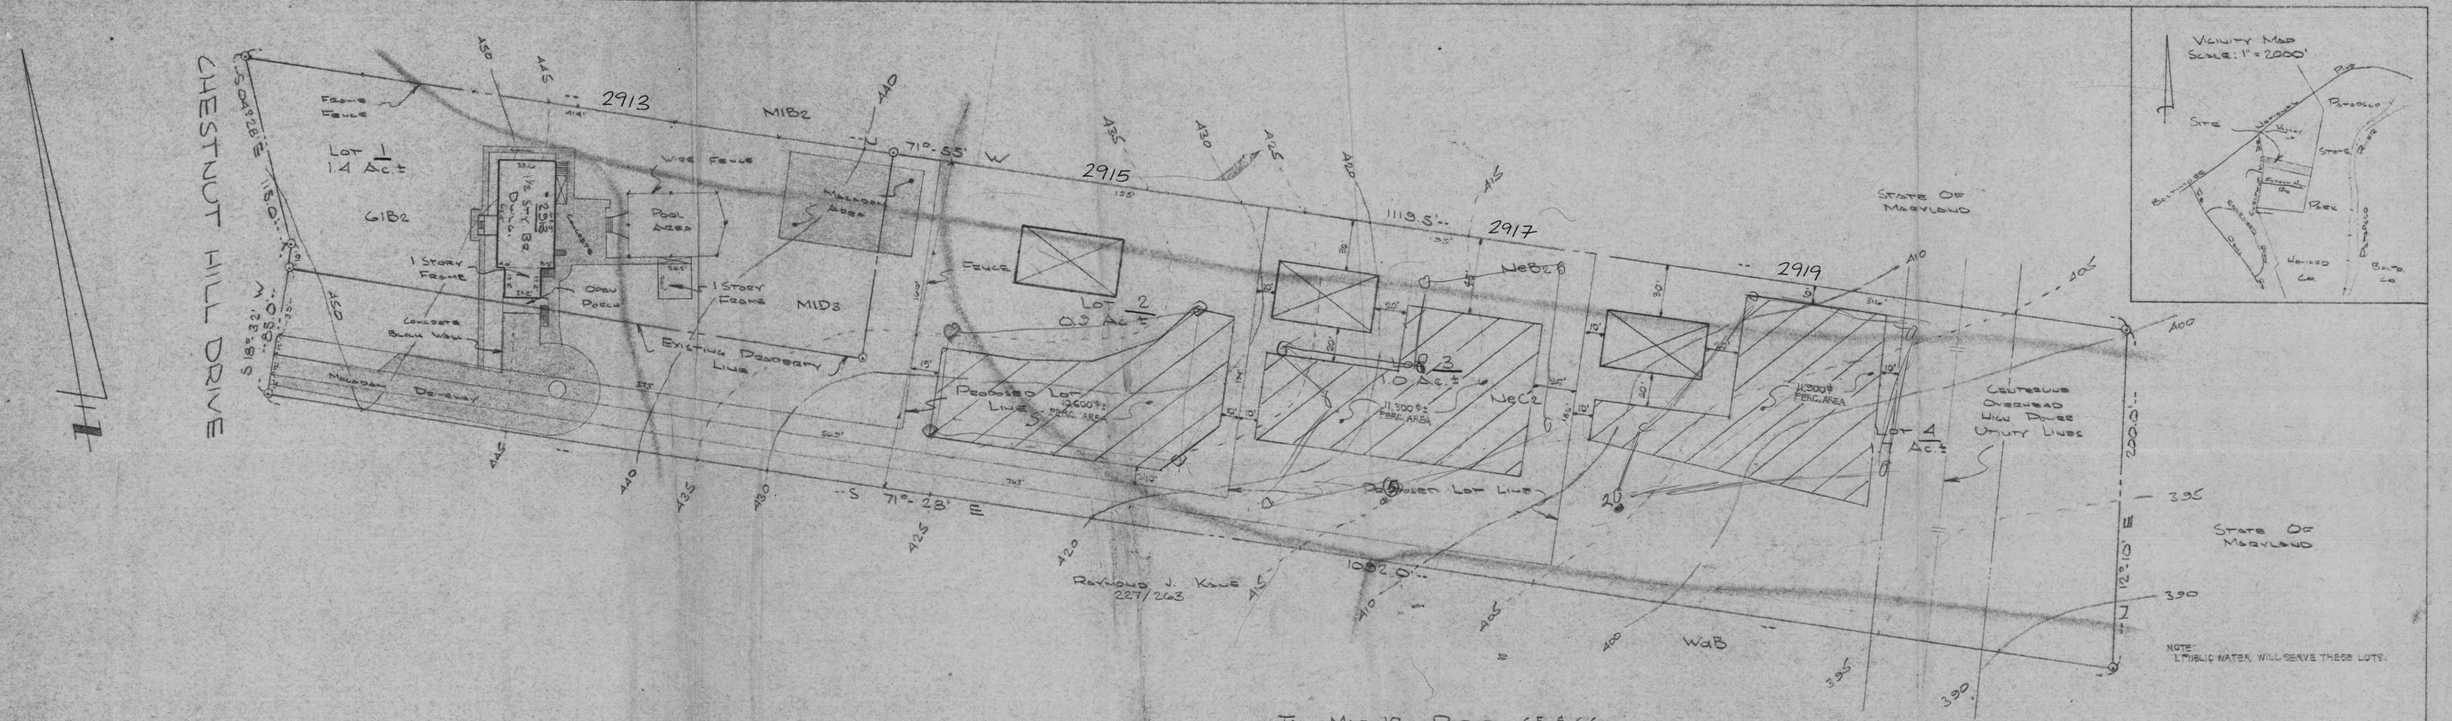

SKETCH PLAN
GOLDBERG PROPERTY
2ND ELECTION DISTRICT
HOWARD COUNTY, MARYLAND
SCALE: 1" = 50' APRIL 28, 1980
REVISED APRIL 1, 1981 : REVISE PERC. AREAS

PREPARED BY:
JOHN C. MELLEMA SR. INC.
LAND SURVEYORS
11 WARREN ROAD
BALTIMORE, MARYLAND 21208
PHONE: 653-0066

OWNER:
BERNARD F. GOLDBERG
2913 CHESTNUT HILL DR.
PHONE: 465-2772