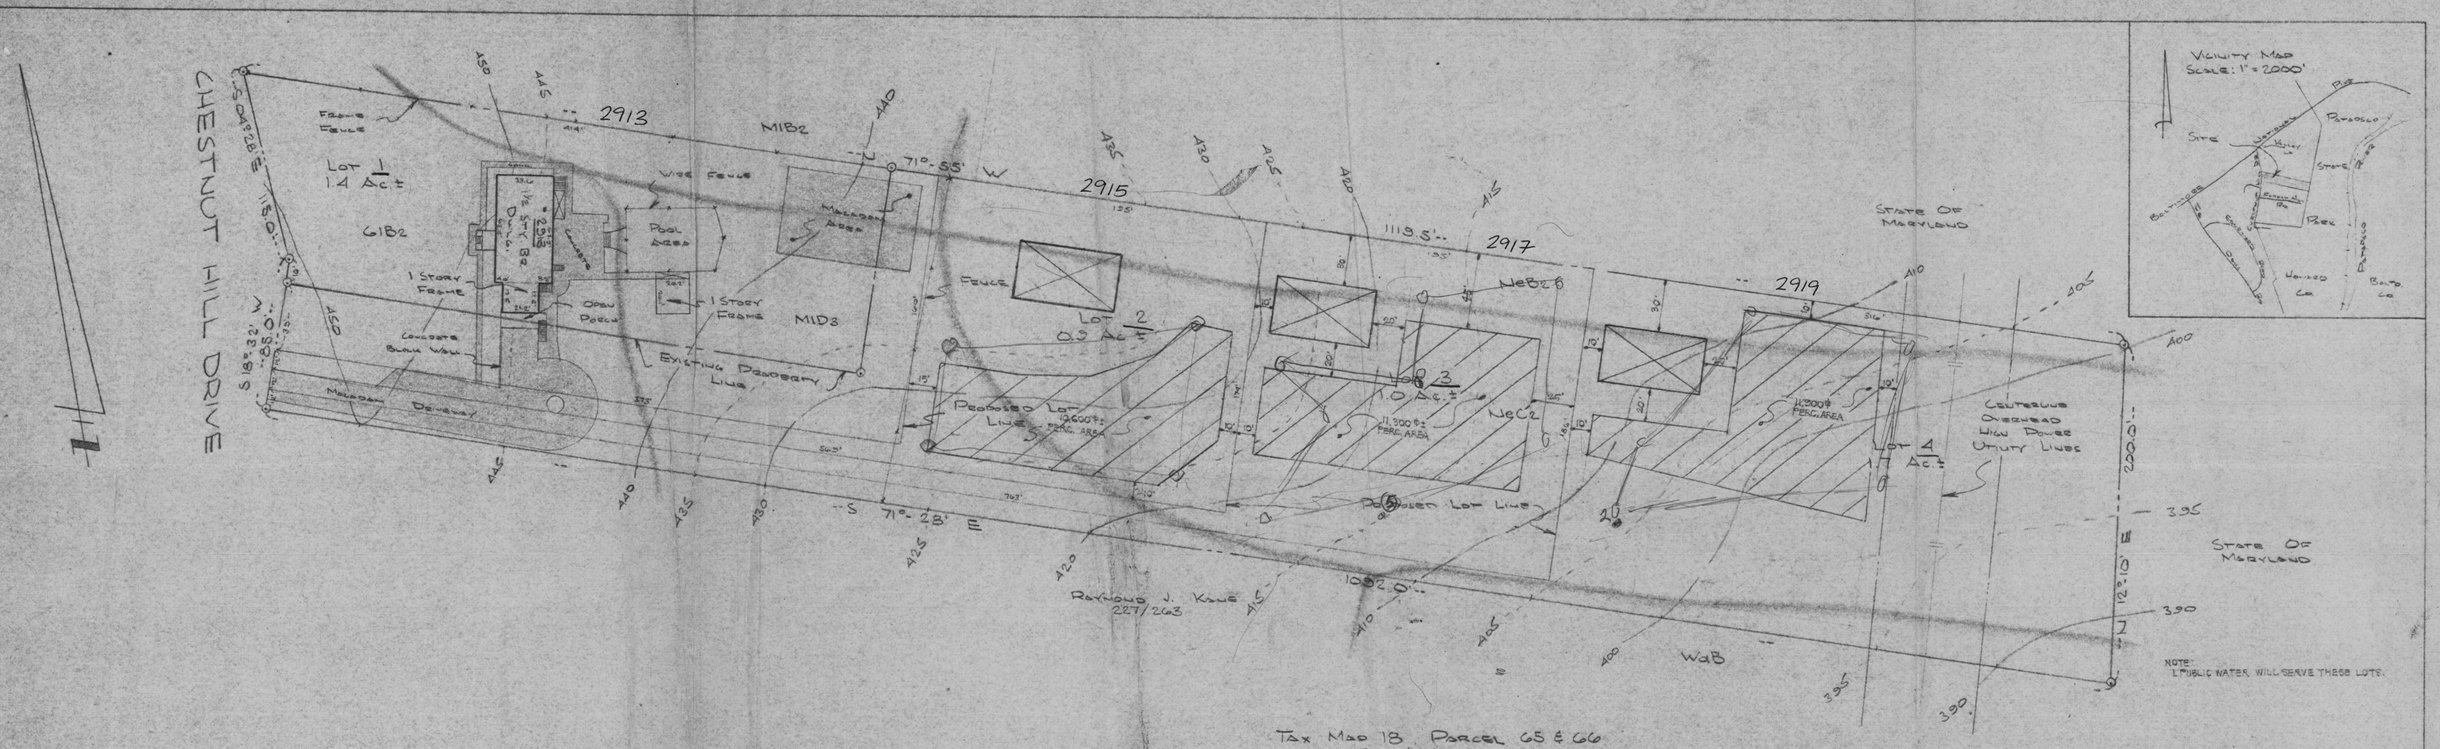

NOTE:
1. PUBLIC WATER WILL SERVE THESE LOTS.

Tax Map 18 Parcel 65 & 66
300/411

Prepared By:
John C. Mellema Sr. Inc.
Land Surveyors
11 Warren Road
Baltimore, Maryland 21208
Phone: 653-0066

Owner:
Bernard F. Goldberg
2913 Chestnut Hill Dr.

Phone: 465-2772

SKETCH PLAN
GOLDBERG PROPERTY

2nd Election District

Howard County, Maryland

Scale: 1" = 50' April 28, 1980

REVISED APRIL 1, 1981 : REVISE PERC. AREAS