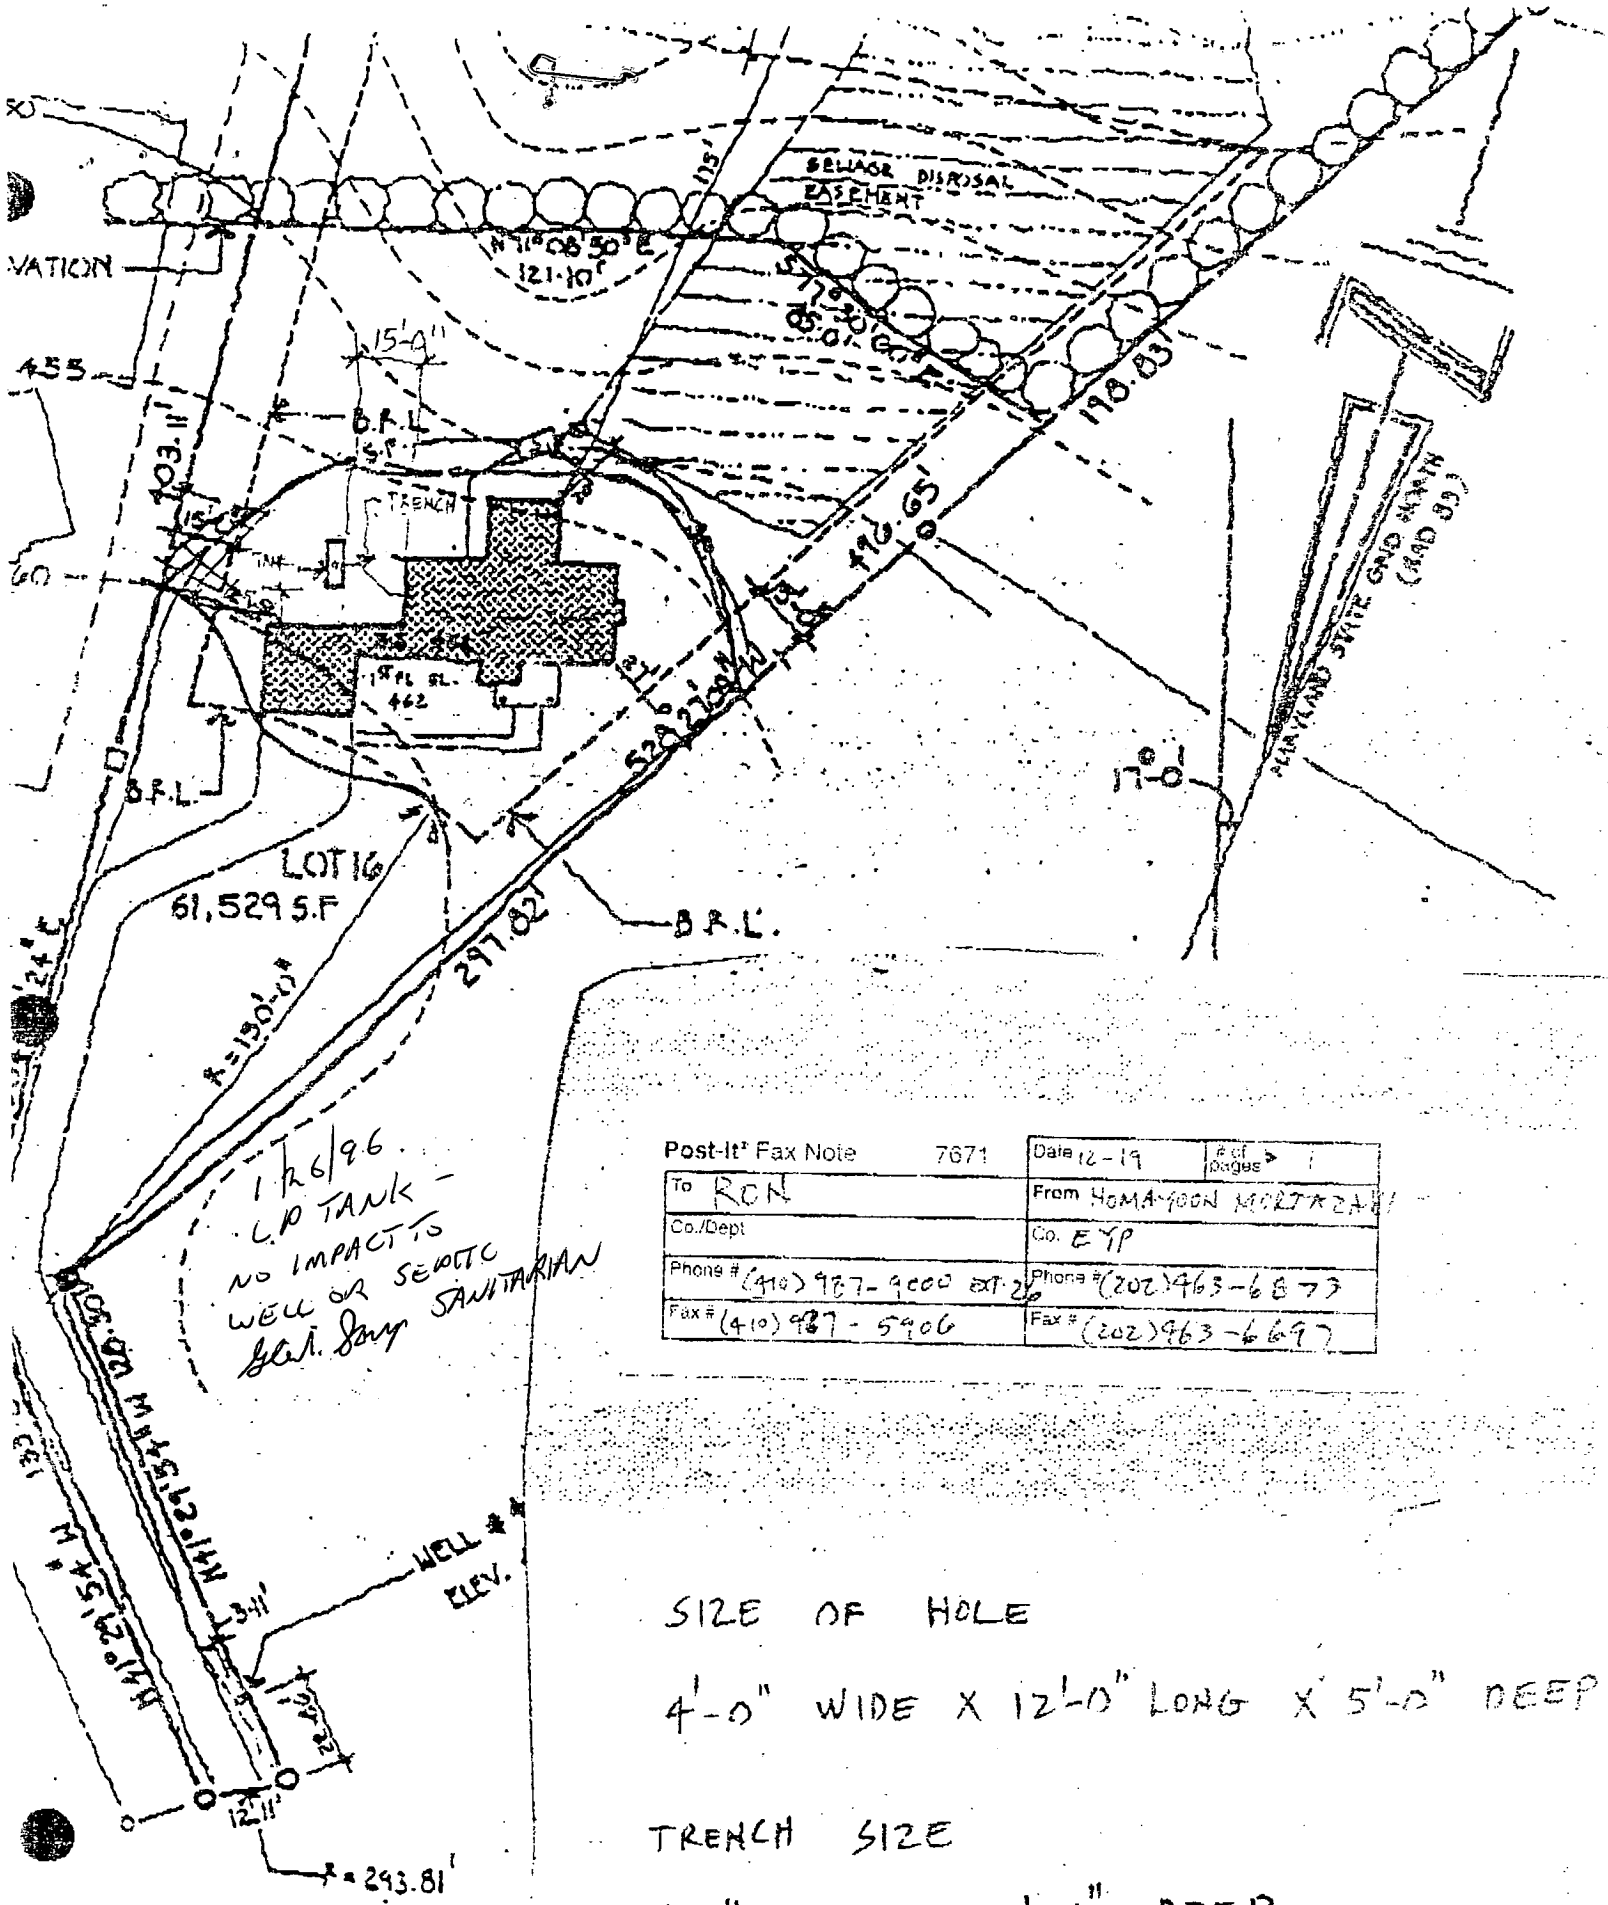

Post-It® Fax Note 7671	Date 12-19	# of pages > 1
To RON	From HOMAYOON MORTAZAVI	
Co./Dept	Co. EYP	
Phone # (410) 987-9000 ext. 26	Phone # (202) 463-6873	
Fax # (410) 987-5906	Fax # (202) 463-6697	

SIZE OF HOLE

4'-0" WIDE X 12'-0" LONG X 5'-0" DEEP

TRENCH SIZE

1'-0" WIDE X 1'-6" DEEP