A# 00 971

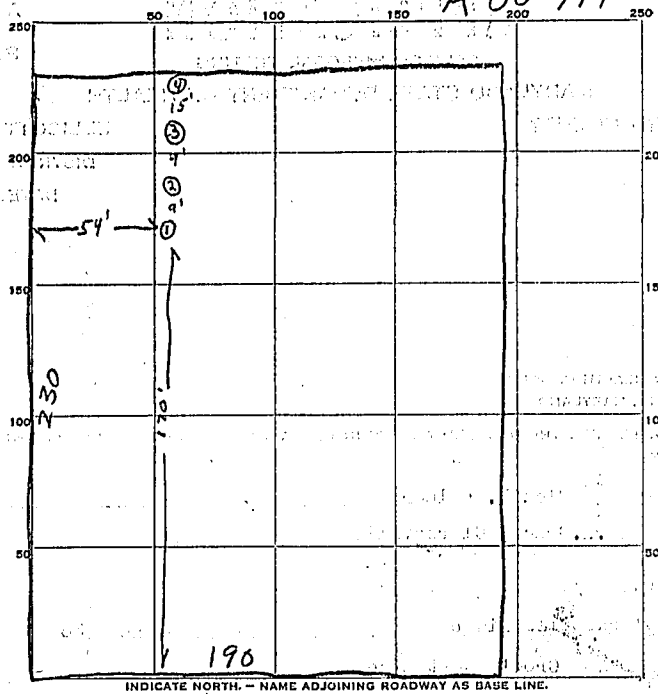

INDICATE NORTH. – NAME ADJOINING ROADWAY AS BASE LINE.

CROW'S NEST ROAD

DATE	TEST NO.	DEPTH	PRE-WET START	PRE-WET STOP	TEST - 1" DROP START	TEST - 1" DROP STOP	TIME
5/5/59	1	3	133	149	149	216	3/4 23 min
	2	3	134	142	142	155	12 min
	3	3	135	140	146	149	9 min
	4	2	143	149	149	157	8 min

$\frac{3}{4}x = 23$

$3x = 92$

$x = 30\frac{2}{3}$

$\begin{array}{r} 31 \\ 129 \\ 8 \\ \hline 3)60 \end{array}$

$\begin{array}{r} 28 \\ 12 \\ 9 \\ 8 \\ \hline 11)58 \end{array}$

SOIL AUGER FINDING

TESTED BY Raymond Hodges

REMARKS

ALSO PRESENT Reluscomb LOT NO. 38